

STATE OF FLORIDA DEPARTMENT OF TRANSPORTATION
TECHNICAL REPORT COVERSHEET

650-050-38
ENVIRONMENTAL
MANAGEMENT
08/22

DRAFT UTILITY ASSESSMENT PACKAGE

Florida Department of Transportation

District 1

S.R. 70 PD&E Study

Limits of Project: From C.R. 721 S to C.R. 599/128th Avenue

Highlands and Okeechobee Counties, Florida

Financial Management Number: 450334-1-22-01

ETDM Number: 14491

Date: November 2025

The environmental review, consultation, and other actions required by applicable federal environmental laws for this project are being, or have been, carried out by the Florida Department of Transportation (FDOT) pursuant to 23 U.S.C. § 327 and a Memorandum of Understanding dated May 26, 2022 and executed by the Federal Highway Administration and FDOT.

TABLE OF CONTENTS

1.0	INTRODUCTION	1
1.1	PURPOSE OF UTILITY ASSESSMENT PACKAGE	1
1.2	EXISTING ROADWAY FACILITY	2
2.0	PURPOSE AND NEED	3
3.0	PREFERRED ALTERNATIVE	3
4.0	EXISTING UTILITIES	4
4.1	UTILITY OWNERS/ LOCATIONS.....	4
5.0	PREFERRED ALTERNATIVE COSTS.....	17
5.1	RELOCATION ESTIMATES.....	17
6.0	UTILITY EASEMENTS.....	17
7.0	UTILITY MITIGATION.....	17

LIST OF FIGURES

Figure 1-1: Project Location Map.....	1
Figure 1-2: Existing Typical Section.....	2
Figure 3-1: Preferred Alternative.....	3

LIST OF TABLES

Table 4 1: Summary of Existing Utility Information.....	4
Table 4-2: Existing Utilities Relocation Cost.....	10
Table 5-1: Total Relocation Cost.....	17

APPENDICES

Appendix A: Utility Contact Letters	
Appendix B: Utility Responses	
Appendix C: Cost Estimates Backup Documentation	
Appendix D: FP&L Transmission Proposed 230kV	
Appendix E: Preferred Alternative Concept Plans	


1.0 INTRODUCTION

The Florida Department of Transportation (FDOT), District One, is conducting a Project Development and Environment (PD&E) Study to evaluate the proposed widening of State Road (S.R.) 70 from County Road (C.R.) 721 South to C.R. 599/128th Avenue in Highlands and Okeechobee Counties. The total project length is approximately 8.6 miles, and the project limits are shown in **Figure 1-1**. The project proposes the widening of the two-lane facility to a four-lane, divided facility and the inclusion of multi-modal improvements. The Preferred Alternative is a four-lane divided road with 12-foot wide travel lanes, paved shoulders and turn lanes, and multi-modal improvements (i.e. shared use path) along the corridor. Additional right-of-way (ROW) is needed to accommodate the proposed improvements. Design and posted speeds of 65 mph are proposed. The purpose of the PD&E Study is to document and evaluate engineering and environmental data that will aid FDOT District One, and the FDOT Environmental Management Office (EMO) in reaching a decision on the type, preliminary design, and location of the proposed improvements. The study was conducted to meet the requirements of the National Environmental Policy Act (NEPA) and other related federal and state laws, rules, and regulations.

1.1 PURPOSE OF UTILITY ASSESSMENT PACKAGE

This utility assessment package has been assembled to provide information for existing and planned utilities on S.R. 70 from C.R. 721 South to C.R. 599/128th Avenue in Highlands and Okeechobee Counties. This package contains information on the names of utility companies, contacts for the Utility Agency Owners (UAOs), utility plans denoting the location of major existing and proposed facilities, the description of each utility identified, project coordination efforts, and information on the cost of relocation, if necessary. This package also includes information on the utility coordination performed during the PD&E phase of the project.


Figure 1-1: Project Location Map

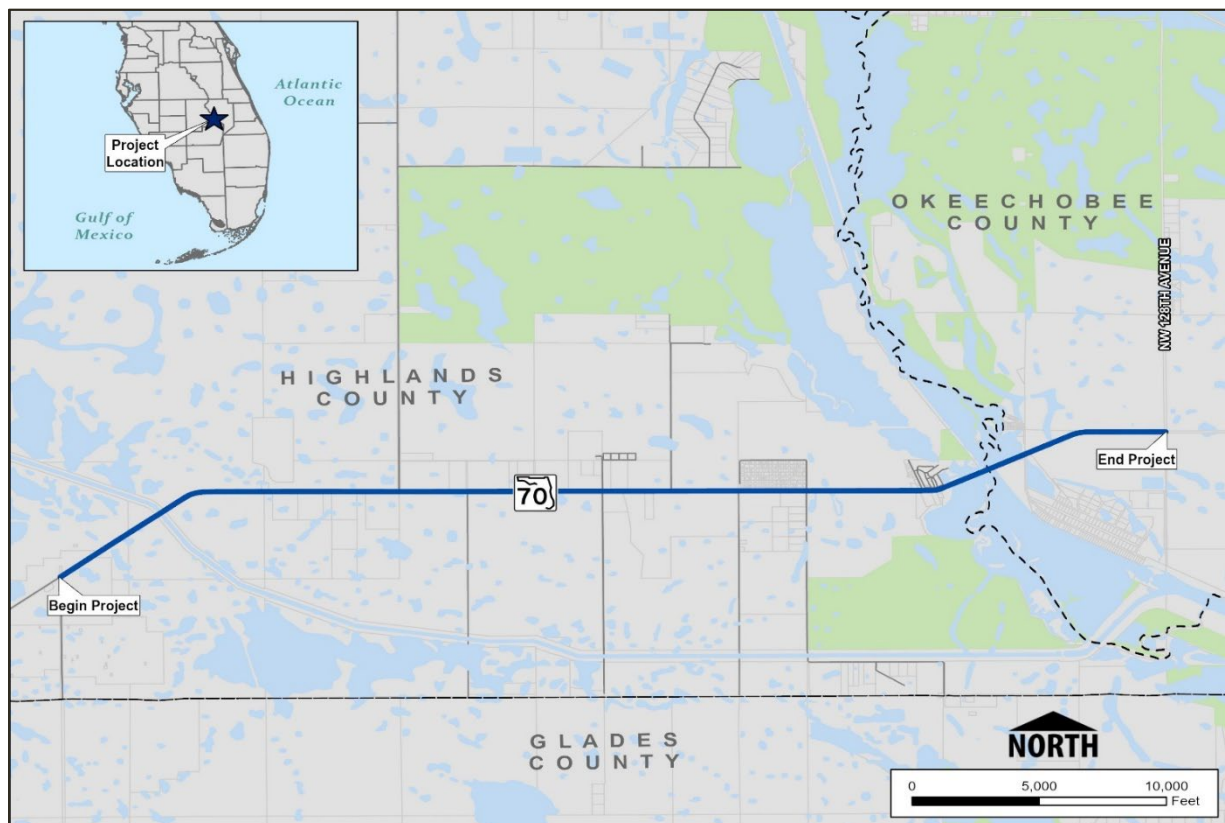

1.2 EXISTING ROADWAY FACILITY

Within the majority of the project limits, S.R. 70 is a two-lane, undivided facility with 10-foot travel lanes (one in each direction), with 6-foot shoulders (4-foot paved), and no pedestrian or bicycle facilities. The roadway is classified as an “Rural Principal Arterial - Other” throughout the project study limits. The context classification is C2 – Rural. The posted speed limit is 60 MPH. Based on the as-built plans, the design speed is 65 MPH. Stormwater runoff is collected in roadside ditches, swales, and ultimately conveyed to the Kissimmee River. There are two bridge crossings along the corridor. One is located at the Slough Ditch (C-41A) Canal and the other is at the Kissimmee River (C-38 Canal). There are no signalized intersections along the corridor. The intersection of S.R. 70 and C.R. 721 South has a flashing yellow on S.R. 70 and a flashing red with STOP-control on the side street approach to S.R. 70. Overhead and buried utilities vary in location along the corridor. This includes the FPL high voltage transmission lines along the north side of S.R. 70 and the FGT line which runs parallel to and outside the existing ROW. The FGT line varies in location north and south of S.R. 70 and crosses the corridor at four (4) locations. There are agricultural lands along both sides of the project corridor. The existing typical section is shown in **Figure 1-2**.

Figure 1-2: Existing Typical Section

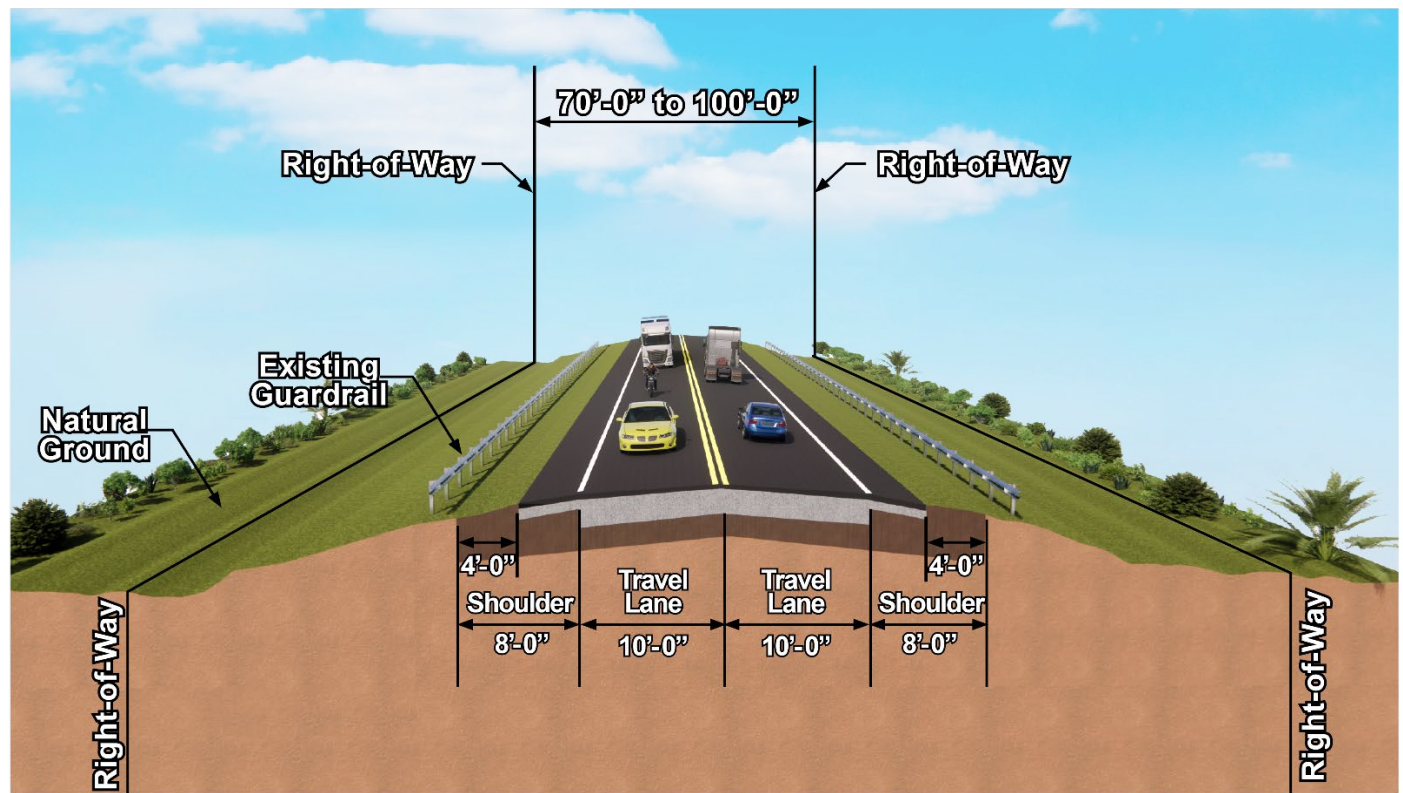

The ROW information was obtained from FDOT as-built plans for S.R. 70, Florida Department of Environmental Protection (FDEP) certified corner records, and property appraiser maps from Highlands and Okeechobee Counties. Generally, the ROW along the corridor is 100 feet within the project limits but reduces to approximately 70 feet on the west side of the project limits. Within the existing 100-foot ROW, the current S.R. 70 horizontal alignment is centered between the north and south ROW boundary.


2.0 PURPOSE AND NEED

The purpose of this project is to address traffic safety conditions on S.R. 70 from C.R. 721 South to C.R. 599/128th Avenue in Highlands and Okeechobee Counties. Other goals of the project include maintaining important east-west connectivity within the regional transportation network and to accommodate freight activity within the area. The need for the project is based on safety, area wide network/system linkage, transportation demands, emergency evacuation, traffic safety conditions, and incident response times. Area wide network/ system linkage will aid in maintaining the important east-west connectivity within the regional transportation network and transportation demands will accommodate freight activity.

3.0 PREFERRED ALTERNATIVE

The Preferred Alternative has a rural typical section with an open roadway drainage system for the four-lane construction. The typical section includes: two 12-foot travel lanes in each direction; a 40-foot median with 8-foot inside shoulders, 4-foot paved; 12-foot outside shoulders, 5-foot paved; and a 12-foot shared use path on the south side of S.R. 70 adjacent to the eastbound travel lanes. The total ROW needed is 260 feet. The proposed ROW need is mainly along the south side of S.R. 70; however, in a couple locations ROW is needed on the north side of S.R. 70. The Kissimmee River bridge will be replaced with two new bridges, and a second bridge will be added to the Slough Ditch (C-41A) Canal roadway crossing. A new stormwater management system will be constructed. The target, design and posted speed are 65 miles per hour (MPH). **Figure 3-1** depicts the Preferred Alternative typical section.

Figure 3-1: Preferred Alternative

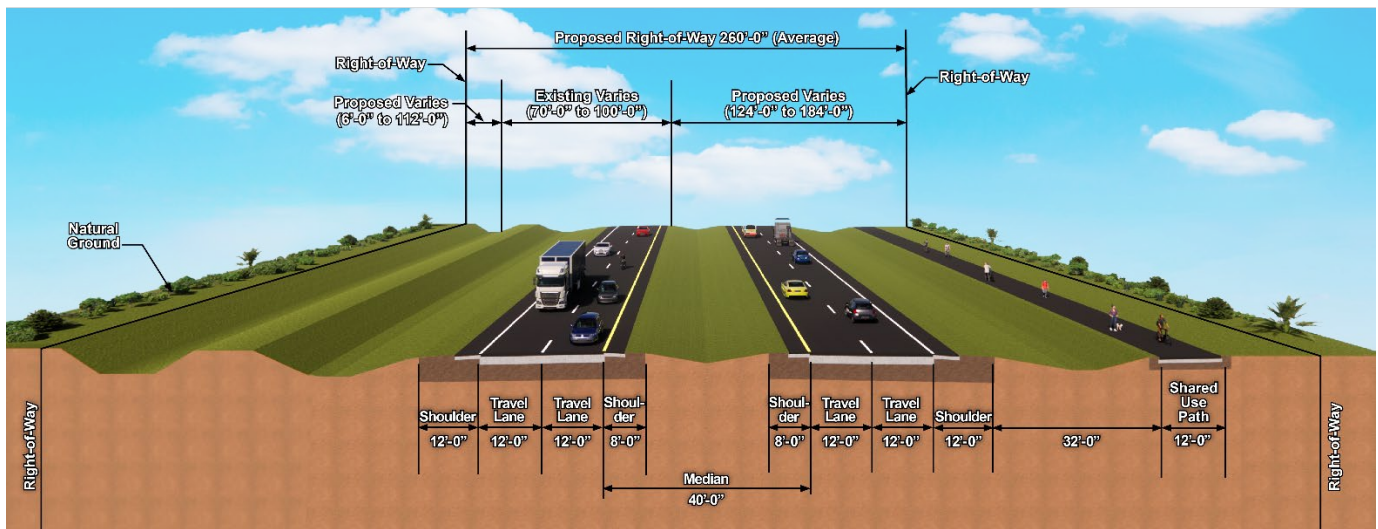

4.0 EXISTING UTILITIES

The Utility Agency/Owners (UAOs) were determined using a variety of sources. A Sunshine 811 Design Ticket was requested, the project was visited, and field investigations and observations were made. Above ground utility features were noted and verified with the utility providers and operators during the coordination process for the project. The final source of data collection was from As-built plans along or adjacent to the study area. A list of the UAOs identified on the project are summarized in **Table 4-1**.

Table 4-1: Summary of Utility Contact Information

Company	Contact	Address	Phone Number/ Email	Utilities in Corridor
Comcast	Wesley Vaughn	3010 Herring Drive Sebring, FL 33870	(863) 265-9084 Wesley_vaughn@comcast.com	CATV
Florida Gas Transmission	Joseph E. Sanchez	2405 Lucien Way Suite 200 Maitland, FL 32751	(407) 808-4607 Joseph.e.sanchez@energytransfer.com	Gas
Florida Power & Light Distribution	Chris McJunkin	15430 Endeavor Drive Jupiter, FL 33478	(941) 267-7474 Chris.mcjunkin@fpl.com	Electric
Florida Power & Light Transmission	Craig B. Ledbetter	15430 Endeavor Drive Jupiter, FL 33478	(561) 532-7082 Craig.ledbetter@fpl.com	Electric
Lumen/ Centurylink	Kenneth R. Lutz	924 Memorial Drive Avon Park, FL 33825	(863) 214-1490	Telephone/ Fiber

4.1 UTILITY OWNERS/PROVIDERS AND LOCATIONS

All of the utility providers and operators were contacted on August 14, 2023 and were provided corridor aerial base maps of S.R. 70 for review. Copies of these coordination letters can be found in **Appendix A**. Based on the aerial maps, they were asked to assist in locating and identifying their existing and planned facilities within the area of study and asked to provide information of any known utility easements and provide an estimated cost for relocation of their facilities, if that were required. Through plan mark-ups and/or verbal descriptions, utility providers or operators provided information on the location and type of existing and planned facilities. At the time of utility contact efforts, none of the UAOs indicated any future planned facilities or upgrades to existing facilities within the project limits, and none indicated there are existing utility easements.

The responses from the utility providers are found in **Appendix B**. A description of the existing facilities and any associated relocation costs, if relocation were required, are outlined below and in **Table 4-2**. For UAOs that did not provide approximate relocation costs, an estimate was calculated using current estimates for that utility type.

Provided below is a summary of the existing facilities within the project corridor. All stations provided are approximate.

Comcast owns the following facilities within the project's study area.

- Buried CATV facilities on the west side of SW 144th Parkway running northwest and crossing S.R. 70 at around Sta. 802+20 and turning east for about 200 feet and then north outside of the ROW to a power pole.
- Overhead CATV facilities on a power pole on the north side of S.R. 70 from Sta. 813+00 to Sta. 824+00.
- Overhead CATV facilities on a power pole on the north side of S.R. 70 from Sta. 829+50 to Sta. 855+50.
- Overhead CATV facilities crossing S.R. 70 from a power pole on the north side of S.R. 70 at Sta. 860+80 going southwest across SW 128th Avenue intersection to a pole at Sta. 859+80.

Florida Gas Transmission owns the following facilities within the project's study area.

- 30" OD. X 0.249" W.T., grade X-605 natural Gas Transmission pipeline on the north side of S.R. 70 outside of the ROW on a private easement around Sta. 448+00 going east to Sta. 453+50.
- 30" OD. X 0.249" W.T., grade X-605 natural Gas Transmission pipeline on the north side of S.R. 70 outside of the ROW on a private easement around Sta. 466+00 going east to Sta. 468+00.
- 30" OD. X 0.249" W.T., grade X-605 natural Gas Transmission pipeline on the north side of S.R. 70 outside of the ROW on a private easement around Sta. 528+00 going east to Sta. 529+00.
- 30" OD. X 0.249" W.T., grade X-605 natural Gas Transmission pipeline on the north side of S.R. 70 outside of the ROW on a private easement around Sta. 623+00 going east to Sta. 629+50.
- 30" OD. X 0.249" W.T., grade X-605 natural Gas Transmission pipeline on the north side of S.R. 70 outside of the ROW on a private easement around Sta. 642+00 going east to Sta. 645+00.
- 30" OD. X 0.249" W.T., grade X-605 natural Gas Transmission pipeline on the south side of S.R. 70 outside of the ROW on a private easement around Sta. 684+50 going east to Sta. 714+50.
- 30" OD. X 0.249" W.T., grade X-605 natural Gas Transmission pipeline going north-south crossing S.R. 70 on a private easement around Sta. 753+20.
- 30" OD. X 0.249" W.T., grade X-605 natural Gas Transmission pipeline on the south side of S.R. 70 outside of the ROW on a private easement around Sta. 753+20 going east to a point at Sta. 757+50 and turning south outside of the ROW.
- 30" OD. X 0.249" W.T., grade X-605 natural Gas Transmission pipeline on the south side of S.R. 70 outside of the ROW on a private easement around Sta. 792+00 going east to a point at Sta. 825+50.
- 30" OD. X 0.249" W.T., grade X-605 natural Gas Transmission pipeline going north-south crossing S.R. 70 on a private easement around Sta. 825+50.
- 30" OD. X 0.249" W.T., grade X-605 natural Gas Transmission pipeline on the north side of S.R. 70 outside of the ROW on a private easement around Sta. 825+50 going east to a point at Sta. 832+20 and turning northeast outside of the ROW.
- 30" OD. X 0.249" W.T., grade X-605 natural Gas Transmission pipeline on the north side of S.R. 70 outside of the ROW on a private easement around Sta. 856+00 going east to the end of the project limit at Sta. 882+50.

Florida Power & Light Distribution owns the following facilities within the project's study area.

- 13KV OE on the east side of SW C.R. 721 ROW running northeast-southwest at around Sta. 400+50 along the proposed ROW.

- 13KV OE on the north side of S.R. 70 outside the ROW on a private easement from Sta. 448+00 going east to Sta. 453+50 through the proposed pond 2A.
- 13KV OE crossing S.R. 70 north to south from power pole to power pole at around Sta. 458+20.
- 13KV OE on the north side of S.R. 70 on a private easement from Sta. 498+50 going east to Sta. 501+20.
- 13KV OE crossing S.R. 70 north to south from power pole to power pole at around Sta. 506+00.
- 13KV OE on the north side of S.R. 70 on a private easement around Sta. 516+00 going east to Sta. 638+00.
- 13KV OE crossing S.R. 70 north to south from power pole to power pole at around Sta. 527+50.
- 13KV OE crossing S.R. 70 north to south from power pole to power pole at around Sta. 548+00.
- 13KV OE crossing S.R. 70 north to south from power pole to power pole at around Sta. 598+40.
- 13KV OE crossing S.R. 70 north to south from power pole to power pole at around Sta. 632+20.
- 13KV OE crossing S.R. 70 north to south from power pole to power pole at around Sta. 635+40.
- 13KV OE on the north side of S.R. 70 on a private easement around Sta. 642+00 going east to Sta. 642+80.
- 13KV OE on the east side of NW New Pine Ridge Road ROW running north-south at around Sta. 659+80 along the proposed ROW.
- 13KV OE on the east side of SW Rucks Dairy Road ROW running north-south at around Sta. 713+00 along the proposed ROW.
- 13KV OE crossing S.R. 70 north to south from power pole to power pole at around Sta. 727+00.
- 13KV OE on the south side of S.R. 70 from a power pole at Sta. 727+00, going east to a power pole at around Sta. 741+60 and turning south outside of the ROW.
- 13KV OE on the north side of S.R. 70 outside the ROW on a private easement from Sta. 753+80 going east to Sta. 754+80.
- 13KV OE crossing S.R. 70 north to south from power pole to power pole along the east side of NW Riverside Road at around Sta. 759+00 along the proposed ROW.
- 13KV OE crossing S.R. 70 north to south from power pole to power pole at around Sta. 764+00.
- 13KV OE on the north side of S.R. 70 from a power pole at Sta. 764+00 going east to a power pole at around Sta. 766+00 and turning north outside of the ROW.
- 13KV OE crossing S.R. 70 north to south from power pole to power pole at around Sta. 804+20.
- 13KV OE on the north side of S.R. 70 outside the ROW on a private easement from Sta. 813+00 going east to Sta. 824+00 through the proposed pond 8A.
- 13KV OE on the north side of S.R. 70 outside the ROW on a private easement from Sta. 828+00 going east to the end of the project limits at around Sta. 882+50 through the proposed ROW.
- 13KV OE crossing S.R. 70 north to south from power pole to power pole at around Sta. 833+00.
- 13KV OE crossing S.R. 70 north to south from power pole to power pole at around Sta. 860+00.

Florida Power & Light Transmission owns the following facilities within the project's study area.

- 69KV OE on the north side of S.R. 70 outside the ROW on a private easement from Sta. 448+00 going east to Sta. 453+50 through the proposed pond 2A.
- 69KV OE on the north side of S.R. 70 outside the ROW on a private easement from Sta. 516+00 going east to Sta. 638+00 through the proposed ROW.
- 69KV OE on the north side of S.R. 70 outside the ROW on a private easement from Sta. 813+00 going east to Sta. 824+00 through the proposed pond 8A.

- 69KV OE on the north side of S.R. 70 outside the ROW on a private easement from Sta. 828+00 going east to the end of the project limits at around Sta. 882+50 through the proposed ROW.

Lumen/CenturyLink – Local owns the following facilities within the project's study area.

- 96-count BFOC on the east side of SW C.R. 721 ROW running northeast-southwest at around Sta. 400+50 along the proposed ROW.
- 6-count BT on the east side of SW C.R. 721 ROW running northeast-southwest at around Sta. 400+50 along the proposed ROW.
- 25-count BT on the east side of SW C.R. 721 ROW running northeast-southwest at around Sta. 400+50 along the proposed ROW.
- 100-count BT on the east side of SW C.R. 721 ROW running northeast-southwest at around Sta. 400+50 along the proposed ROW.
- 48-count BFOC on the south side of S.R. 70 from Sta. 432+50 going east to pedestal #36730 at Sta. 632+00.
- 50-count BT on the south side of S.R. 70 from Sta. 432+50 going east to pedestal #36730 at Sta. 632+00.
- 25-count BT crossing S.R. 70 north to south from pedestal #85126 to pedestal #26557 and continuing north outside the ROW at around Sta. 468+50.
- 25-count BT crossing S.R. 70 north to south from a pedestal on the south side to a pedestal on the north side at around Sta. 499+50.
- 50-count BT on the south side of S.R. 70 from pedestal #56143 at Sta. 537+00 going east for 50 feet and turning south outside of the ROW.
- 50-count BT on the south side of S.R. 70 from pedestal #56140 at Sta. 537+60 going west for 10 feet and turning south outside of the ROW.
- 48-count BFOC on the south side of S.R. 70 from Sta. 537+50 going east to Sta. 552+50 and turning north across S.R. 70 along the west side of C.R. 721.
- 48-count BFOC crossing S.R. 70 south to north from pedestal #283 at Sta. 552+50 going north along the west side of C.R. 721.
- 25-count BT crossing S.R. 70 south to north from pedestal #283 at Sta. 552+50 going east for 50 feet and turning north along the east side of C.R. 721.
- 200-count BT crossing S.R. 70 south to north from pedestal #283 at Sta. 552+50 going east for 50 feet and turning north along the east side of C.R. 721.
- 48-count BFOC crossing S.R. 70 south to north from Sta. 553+00 going north along the east side of C.R. 721.
- 100-count BT crossing S.R. 70 south to north from pedestal #283 at Sta. 552+50 going east for 50 feet and turning north along the east side of C.R. 721.
- 12-count BFOC crossing S.R. 70 south to north from a Hand Hole at Sta. 574+00 going north and turning east to Sta. 579+00 and turning north outside of the ROW.
- 25-count BT on the north side of S.R. 70 from a pedestal at Sta. 576+80 going east to Sta. 579+00 and turning south across S.R. 70 to pedestal #42606.
- 25-count BT crossing S.R. 70 south to north from pedestal #36730 at Sta. 632+00 along the west side of Fulmar Terrace/Boney Lane.
- 48-count BFOC on the south side of S.R. 70 from pedestal #36730 at Sta. 632+00 going east to Sta. 653+00.

- 100-count BT on the south side of S.R. 70 from pedestal #36730 at Sta. 632+00 going east to Sta. 653+00.
- 48-count BFOC on the south side of S.R. 70 from Sta. 686+00 going east to Sta. 686+60.
- 100-count BT on the south side of S.R. 70 from Sta. 686+00 going east to Sta. 686+60.
- 200-count BT on the south side of S.R. 70 from Sta. 712+00 going east to Sta. 713+00 and turning south along the east side of SW Rucks Dairy Road.
- 100-count BT on the south side of S.R. 70 from Sta. 712+00 going east to Sta. 713+00 and turning south along the east side of SW Rucks Dairy Road.
- 25-count BT on the south side of S.R. 70 from Sta. 712+00 going east to Sta. 713+00 and turning south along the east side of SW Rucks Dairy Road.
- 28-count BT running north-south along the east side of SW Rucks Dairy Road at Sta. 713+20.
- (3) 300-count BT running north-south along the east side of SW Rucks Dairy Road at Sta. 713+20.
- (2) 600-count BT running north-south along the east side of SW Rucks Dairy Road at Sta. 713+20.
- (2) 100-count BT running north-south along the east side of SW Rucks Dairy Road at Sta. 713+20.
- 48-count BFOC on the south side of S.R. 70 from pedestal #46037 at Sta. 725+00 going east to pedestal #67264 at Sta. 859+50.
- 300-count BFOC on the south side of S.R. 70 from pedestal #46037 at Sta. 725+00 going east to pedestal #105564 at Sta. 757+50.
- 100-count BT on the north side of S.R. 70 from Sta. 754+50 going east to Sta. 757+50 and turning south crossing S.R. 70 to pedestal #105564.
- 200-count BT crossing S.R. 70 north to south to pedestal #105564 at Sta. 757+25.
- 25-count BT crossing S.R. 70 north to south to pedestal #105564 at Sta. 757+25.
- (2) 50-count BT crossing S.R. 70 north to south to pedestal #105564 at Sta. 757+25.
- 50-count BT on the south side of S.R. 70 from pedestal #105564 at Sta. 757+25 going east to pedestal #36623 at Sta. 801+50.
- (2) 50-count BT crossing S.R. 70 south to north from pedestal #36629 at Sta. 768+50 going north out of the ROW.
- 50-count BT crossing S.R. 70 north to south from Sta. 795+00 to pedestal #36626 at Sta. 797+50.
- 200-count BT on the south side of S.R. 70 from pedestal #36623 at Sta. 801+50 going south out of the ROW along the west side of SW 144th Parkway.
- 200-count BT on the south side of S.R. 70 from pedestal #36623 at Sta. 801+50 going east to pedestal #37853 at Sta. 813+50.
- 100-count BT crossing S.R. 70 south to north from pedestal #37853 at Sta. 813+50 to pedestal #3559 going north along the west side of NW 141st Avenue.
- 50-count BT crossing S.R. 70 south to north from pedestal #37853 at Sta. 813+50 going north along the east side of NW 141st Avenue.
- 300-count BT on the south side of S.R. 70 from pedestal #37853 at Sta. 813+50 going east to pedestal #67264 at Sta. 859+50.
- (2) 300-count BT crossing S.R. 70 south to north from pedestal #37836 going east for 50 feet and turning north at Sta. 847+50 outside of ROW.

- 50-count BT on the south side of S.R. 70 from pedestal #67264 at Sta. 859+50 going east and turning north crossing S.R. 70 at Sta. 860+50 and continuing north along the east side of NW 128th Avenue.
- 100-count BT on the south side of S.R. 70 from pedestal #67264 at Sta. 859+50 going east and turning north crossing S.R. 70 at Sta. 860+50 and continuing north along the east side of NW 128th Avenue.
- 600-count BT on the south side of S.R. 70 from pedestal #67264 at Sta. 859+50 going east and turning north crossing S.R. 70 at Sta. 860+50 and continuing north along the east side of NW 128th Avenue.
- 50-count BT crossing S.R. 70 north-south at Sta. 860+50 along the east side of SW 128th Avenue.
- 50-count BT on the south side of S.R. 70 from pedestal #67264 at Sta. 859+50 going east to the end of the project limit at around Sta. 882+50.
- 48-count BFOC on the south side of S.R. 70 along the east side of NW 128th Avenue turning east at Sta. 860+40 and continuing east to the end of the project limit at around Sta. 882+50.

4-2: Existing Utilities Summary

Utility Type	Transverse or Adjacent	General Location	Size	Approx. Conflict Length	Impacts	Cost Estimate
COMCAST						
BTV	Transverse	Sta. 802+20 Potential Reimbursement	Unknown	437'	S.R. 70 Roadway Construction	\$ 21,413.26
OTV	Adjacent	Sta. 813+00 to 824+00	Unknown	1,100'	Pond 8A	\$ 7,261.62
OTV	Adjacent	Sta. 829+50 to 855+50	Unknown	2,600'	Proposed ROW	\$ 16,996.62
OTV	Transverse	Sta. 859+80 to 860+80	Unknown	355'	S.R. 70 Roadway Construction	\$ 2,426.57
FLORIDA GAS TRANSMISSION						
Gas	Adjacent	Sta. 448+00 to 453+50	30" O.D. x 0.249" W.T.	550'	Pond 2A	\$1,562,500.00
Gas	Adjacent	Sta. 466+00 to 468+00	30" O.D. x 0.249" W.T.	200'	Driveway and Outfall Easement	\$568,181.82
Gas	Adjacent	Sta. 528+00 to 529+00	30" O.D. x 0.249" W.T.	100'	Outfall Easement	\$284,090.91
Gas	Adjacent	Sta. 623+00 to 629+50	30" O.D. x 0.249" W.T.	650'	Pond 5A	\$1,846,590.91
Gas	Adjacent	Sta. 642+00 to 645+00	30" O.D. x 0.249" W.T.	300'	Outfall Easement and Proposed ROW	\$852,272.73
Gas	Adjacent	Sta. 684+50 to 714+50	30" O.D. x 0.249" W.T.	3,000'	Roadway and Proposed ROW	\$8,522,727.27
Gas	Transverse	Sta. 753+20	30" O.D. x 0.249" W.T.	206'	S.R. 70 Roadway Construction	\$585,227.27
Gas	Adjacent	Sta. 753+20 to 757+50	30" O.D. x 0.249" W.T.	430'	S.R. 70 Roadway Construction	\$1,221,590.91

Gas	Adjacent	Sta. 792+00 to 825+50	30" O.D. x 0.249" W.T.	3,350'	S.R. 70 Roadway Construction	\$9,517,045.45
Gas	Transverse	Sta. 825+50	30" O.D. x 0.249" W.T.	215'	S.R. 70 Roadway Construction	\$610,795.45
Gas	Adjacent	Sta. 825+50 to 832+20	30" O.D. x 0.249" W.T.	670'	S.R. 70 Roadway Construction	\$1,903,409.09
Gas	Adjacent	Sta. 856+00 to 882+50	30" O.D. x 0.249" W.T.	2,650'	S.R. 70 Roadway Construction	\$7,528,409.09

FLORIDA POWER & LIGHT DISTRIBUTION

OE	Transverse	Sta. 400+50	13 KV	275'	S.R. 70 Roadway Construction	\$52,083.33
OE	Adjacent	Sta. 448+00 to 453+50	13 KV	550'	Pond 2A	\$104,66.67
OE	Transverse	Sta. 458+20	13 KV	285'	S.R. 70 Roadway Construction	\$53,977.27
OE	Adjacent	Sta. 498+50 to 501+20	13 KV	270'	Proposed ROW	\$51,136.36
OE	Transverse	Sta. 506+00	13 KV	260'	S.R. 70 Roadway Construction	\$49,242.42
OE	Adjacent	Sta. 516+00 to 638+00	13 KV	12,200'	Proposed ROW	\$2,310,606.06
OE	Transverse	Sta. 527+50	13 KV	259'	S.R. 70 Roadway Construction	\$49,053.03
OE	Transverse	Sta. 548+00	13 KV	259'	S.R. 70 Roadway Construction	\$49,053.03
OE	Transverse	Sta. 598+40	13 KV	257'	S.R. 70 Roadway Construction	\$48,674.24
OE	Transverse	Sta. 632+20	13 KV	255'	S.R. 70 Roadway Construction	\$48,295.45
OE	Transverse	Sta. 635+40	13 KV	255'	S.R. 70 Roadway Construction	\$48,295.45
OE	Adjacent	Sta. 642+00 to 642+80	13 KV	80'	Outfall Easement	\$15,151.52

OE	Transverse	Sta. 659+80	13 KV	255'	S.R. 70 Roadway Construction	\$48,295.45
----	------------	-------------	-------	------	---------------------------------	-------------

OE	Transverse	Sta. 713+00	13 KV	255'	S.R. 70 Roadway Construction	\$48,295.45
OE	Transverse	Sta. 727+00	13 KV	255'	S.R. 70 Roadway Construction	\$48,295.45
OE	Adjacent	Sta. 727+00 to 741+60	13 KV	1,460'	S.R. 70 Roadway Construction	\$276,515.15
OE	Adjacent	Sta. 753+80 to 754+80	13 KV	100'	Outfall Easement	\$18,939.39
OE	Transverse	Sta. 759+00	13 KV	270'	S.R. 70 Roadway Construction	\$51,136.36
OE	Transverse	Sta. 764+00	13 KV	210'	S.R. 70 Roadway Construction	\$39,772.73
OE	Adjacent	Sta. 764+00 to 766+00	13 KV	172'	Proposed ROW	\$32,575.76
OE	Transverse	Sta. 804+20	13 KV	265'	S.R. 70 Roadway Construction	\$50,189.39
OE	Adjacent	Sta. 813+00 to 824+00	13 KV	1,100'	Pond 8A	\$208,333.33
OE	Adjacent	Sta. 828+00 to 882+50	13 KV	5,450'	Proposed ROW	\$1,032,196.97
OE	Transverse	Sta. 833+00	13 KV	250'	S.R. 70 Roadway Construction	\$47,348.48
OE	Transverse	Sta. 860+00	13 KV	260'	S.R. 70 Roadway Construction	\$49,242.42
FLORIDA POWER & LIGHT TRANSMISSION						
OE	Adjacent	Sta. 448+00 to 453+50	69KV	550'	Pond 2A	\$458,333.33
OE	Adjacent	Sta. 516+00 to 638+00	69KV	12,200'	Proposed ROW	\$10,166,666.67
OE	Adjacent	Sta. 813+00 to 824+00	69KV	1,100'	Pond 8A	\$916,666.67
OE	Adjacent	Sta. 828+00 to 882+50	69KV	5,450'	Proposed ROW	\$4,541,666.67

LUMEN/CENTURYLINK - LOCAL

BFOC	Transverse	Sta. 400+50	96-count	175'	S.R. 70 Roadway Construction	\$8,648.62
BT	Transverse	Sta. 400+50	6-count	175'	S.R. 70 Roadway Construction	\$1,324.75
BT	Transverse	Sta. 400+50	25-count	175'	S.R. 70 Roadway Construction	\$1,324.75
BT	Transverse	Sta. 400+50	100-count	175'	S.R. 70 Roadway Construction	\$1,324.75
BT	Adjacent	Sta. 432+50 to 632+00	48-count	19,950'	S.R. 70 Roadway Construction	\$151,021.50
BT	Adjacent	Sta. 432+50 to 632+00	50-count	19,950'	S.R. 70 Roadway Construction	\$151,021.50
BT	Transverse	Sta. 468+50	25-count	160'	S.R. 70 Roadway Construction	\$1,211.20
BT	Transverse	Sta. 499+50	25-count	110'	S.R. 70 Roadway Construction	\$832.70
BT	Adjacent	Sta. 537+00	50-count	100'	S.R. 70 Roadway Construction	\$757.00
BT	Adjacent	Sta. 537+60	50-count	60'	S.R. 70 Roadway Construction	\$454.20
BFOC	Adjacent	Sta. 537+50 to 552+50	48-count	1,700'	S.R. 70 Roadway Construction	\$82,946.62
BFOC	Transverse	Sta. 552+50	48-count	200'	S.R. 70 Roadway Construction	\$9,866.62
BT	Transverse	Sta. 552+50	25-count	200'	S.R. 70 Roadway Construction	\$1,514.00
BT	Transverse	Sta. 552+50	200-count	200'	S.R. 70 Roadway Construction	\$1,514.00
BFOC	Transverse	Sta. 553+00	48-count	100'	S.R. 70 Roadway Construction	\$4,994.62
BT	Transverse	Sta. 552+50	100-count	200'	S.R. 70 Roadway Construction	\$1,514.00
BFOC	Adjacent	Sta. 574+00 to 579+00	12-count	700'	S.R. 70 Roadway Construction	\$33,701.62

BT	Transverse	Sta. 576+80 to 579+00	25-count	320'	S.R. 70 Roadway Construction	\$2,422.40
BT	Transverse	Sta. 632+00	25-count	155'	S.R. 70 Roadway Construction	\$1,173.35
BFOC	Adjacent	Sta. 632+00 to 653+00	48-count	2,100'	S.R. 70 Roadway Construction	\$102,434.62
BT	Adjacent	Sta. 632+00 to 653+00	100-count	2,100'	S.R. 70 Roadway Construction	\$15,897.00
BFOC	Adjacent	Sta. 686+00 to 686+60	48-count	60'	Roadway Construction	\$3,045.82
BT	Adjacent	Sta. 686+00 to 686+60	100-count	60'	Roadway Construction	\$454.20
BT	Transverse	Sta. 712+00 to 713+00	200-count	255'	S.R. 70 Roadway Construction	\$1,930.35
BT	Transverse	Sta. 712+00 to 713+00	100-count	255'	S.R. 70 Roadway Construction	\$1,930.35
BT	Transverse	Sta. 712+00 to 713+00	25-count	255'	S.R. 70 Roadway Construction	\$1,930.35
BT	Transverse	Sta. 713+20	28-count	255'	S.R. 70 Roadway Construction	\$1,930.35
BT	Transverse	Sta. 713+20	(3) 300-count	255'	S.R. 70 Roadway Construction	\$1,930.35
BT	Transverse	Sta. 713+20	(2) 600-count	255'	S.R. 70 Roadway Construction	\$1,930.35
BT	Transverse	Sta. 713+20	(2) 100-count	255'	S.R. 70 Roadway Construction	\$1,930.35
BFOC	Adjacent	Sta. 725+00 to 859+50	48-count	13,450'	S.R. 70 Roadway Construction	\$655,406.62
BFOC	Adjacent	Sta. 725+00 to 757+50	300-count	3,250'	S.R. 70 Roadway Construction	\$160,672.62
BT	Adjacent	Sta. 754+50 to 757+50	100-count	400'	S.R. 70 Roadway Construction	\$3,028.00
BT	Transverse	Sta. 757+25	200-count	120'	S.R. 70 Roadway Construction	\$908.40

BT	Transverse	Sta. 757+25	25-count	110'	S.R. 70 Roadway Construction	\$832.70
BT	Transverse	Sta. 757+25	(2) 50-count	220'	S.R. 70 Roadway Construction	\$1,665.40
BT	Adjacent	Sta. 757+25 to 801+50	50-count	4,425'	S.R. 70 Roadway Construction	\$33,497.25
BT	Transverse	Sta. 768+50	(2) 50-count	200'	S.R. 70 Roadway Construction	\$1,514.00
BT	Transverse	Sta. 795+00 to 797+50	50-count	235'	S.R. 70 Roadway Construction	\$1,778.95
BT	Transverse	Sta. 801+50	200-count	150'	S.R. 70 Roadway Construction	\$1,135.50
BT	Adjacent	Sta. 801+50 to 813+50	200-count	1,200'	S.R. 70 Roadway Construction	\$9,084.00
BT	Transverse	Sta. 813+50	100-count	200'	S.R. 70 Roadway Construction	\$1,514.00
BT	Transverse	Sta. 813+50	50-count	275'	S.R. 70 Roadway Construction	\$2,081.75
BT	Adjacent	Sta. 813+50 to 859+50	300-count	4,600'	S.R. 70 Roadway Construction	\$34,822.00
BT	Transverse	Sta. 847+50	(2) 300-count	300'	S.R. 70 Roadway Construction	\$2,271.00
BT	Transverse	Sta. 859+50 to 860+50	50-count	300'	S.R. 70 Roadway Construction	\$2,271.00
BT	Transverse	Sta. 859+50 to 860+50	100-count	300'	S.R. 70 Roadway Construction	\$2,271.00
BT	Transverse	Sta. 859+50 to 860+50	600-count	300'	S.R. 70 Roadway Construction	\$2,271.00
BT	Transverse	Sta. 860+50	50-count	260'	S.R. 70 Roadway Construction	\$1,968.20
BT	Adjacent	Sta. 859+50 to 882+50	50-count	2,300	S.R. 70 Roadway Construction	\$17,411.00
BFOC	Adjacent	Sta. 860+40 to 882+50	48-count	2,210	S.R. 70 Roadway Construction	\$107,793.82

Telephone	Adjacent	S.R. 70	Pedestal	56	S.R. 70 Roadway Construction	\$93,159.36
Telephone	Adjacent	S.R. 70	Handholes	7	S.R. 70 Roadway Construction	\$88,894.40

5.0 PREFERRED ALTERNATIVE

The estimated impacts to utility facilities resulting from the Preferred Alternative are itemized by location in **Section 4.1** and **Table 4-2**, along with estimated relocation costs. The estimated impacts are based on the data provided by the UAOs as previously summarized. Actual utility impacts will be verified during the design phase when a detailed survey and subsurface utility information are available.

5.1 RELOCATION ESTIMATES

Conservative utility relocation estimates were requested as part of the utility coordination process, and subsequent follow-up with the UAOs. The cost estimate is based on the FDOT 12-month statewide average. See **Appendix C** for details of the cost estimate. The relocation cost estimates do not include the cost for any ROW needs such as a "Suitable Replacement Easement" for FGT or a replacement easement for Florida Power & Light. See **Table 5-1** for the total relocation cost.

Table 5-1: Total Relocation Cost

#	Description	Unit	Amount
1	Comcast Relocation Cost (Non-Reimbursable)	Total	\$ 48,100.00
2	Florida Gas Transmission (within a private easement, "Potential Reimbursement")	Total	\$ 27,588,070.00
3	Florida Power & Light Distribution (13KV within a private easement, "Potential Reimbursement")	Total	\$ 1,863,636.00
4	Florida Power & Light Transmission (69KV within a private easement, "Potential Reimbursement")	Total	\$ 14,958,333.00
5	Centurylink/ Lumen (within a private easement, "Potential Reimbursement")	Total	\$ 3,900,000.00
6	HB703 Telecom reimbursement	Total	\$ 1,950,000.00

Per Department guidance; additional factors such as inflation/ tariffs (4.6%), engineering (12%), land - R/W cost (30%), and CE&I (5%) should be added to this cost bringing the grand total to:

\$77,280,841.00

6.0 UTILITY EASEMENTS

Based on information from existing, available roadway plans and responses from Florida Power & Light and Florida Gas Transmission, the existing/proposed easements can be found in **Appendix D**.

7.0 Utility Mitigation

Mitigation measures should consider the following:

- The accurate location of all aerial and underground facilities to confirm a clear or conflict determination,
- A design approach to avoid the utility facilities and minimize impacts,

- Any undocumented unknown UAOs found during design and/or construction could create additional impacts and additional delays,
- Minimizing the duration of unavoidable service disruptions,
- Allowing service disruption only during periods of no or minimum usage,
- Maintaining utility connections in temporary locations,
- Installing alternative or new facilities before disconnecting the existing facilities,
- Completion of the necessary utility work prior to the start of roadway construction, or prioritize the utility work to avoid the first phases of roadway construction,
- Removing Occupational Safety and Health Administration (OSHA) crane conflicts, utilize low overhead construction techniques.

The extent of roadway widening, ROW acquisition, and related improvements are shown on the Preferred Alternative concept plans included in **Appendix E**. Efforts to minimize impacts to existing utilities should be taken during the design phase. If impacts are unavoidable, design alternatives will be reviewed to allow for relocation that minimizes cost to the UAO and disruption to their customers.

APPENDIX A
UTILITY CONTACT LETTERS



August 14, 2023

UAO CONTACT LIST			
UAO	CONTACTS	TEL. NO.	EMAIL
Florida Gas Transmission	Joseph E. Sanchez	407-808-4607	joseph.e.sanchez@energytransfer.com
FPL - Distribution	Rob Morris	772-485-0858	rob.morris@fpl.com
FPL - Transmission	Craig B Ledbetter	561-532-7082	craig.ledbetter@fpl.com
Glades Electric CO-OP	Colin Evans	863-531-5034	Cevansgladeselectric.com
Highlands County Traffic	Edward Cardona	863-402-6536	ecardona@hcbcc.org
Lumen (CenturyLink) - Local	Kenneth R. Lutz	863-214-1490	ken.lutz@lumen.com
Lumen (CenturyLink) - National	Francisco Azuri	786-266-1713	francisco.azuri@lumen.com

RE: **ADJUSTMENT OF UTILITIES-STATE STATUTE CHAPTER 337.403 DISTRIBUTION OF EXEMPT PUBLIC DOCUMENTS – FLORIDA STATUTES SECTION 119.071 (3) (a,b)**

State Road No.: 70
County: Highlands and Okeechobee
Financial Project ID: 450334-1-22-01
Description: SR 70 from Southern leg of CR 721 to CR 599/128 Ave.

The Florida Department of Transportation proposes improvements to the above-designated road as shown by the Preliminary PD&E Study Base Map Plans provided. In accordance with **Part 2, Chapter 21** of the PD&E manual, attached are the Preliminary PD&E Study Base Map Plans for your review and handling. Please mark your existing or proposed facilities (using the color green for existing and brown for proposed facilities), designating the size, type, material, location, number of conduits, etc. tying in the location of your facilities to the baseline survey or the existing right of way line.

If you do not have any existing and/or proposed facilities within the limits of this project, please send a Utility Contact Form (UCF) of No-Involvement, advising that your agency is not involved with this project.

If you have existing and/or proposed easements along and/or across the proposed highway right of way, please mark the approximate location(s) in the plans provided, and **please provide legal recordings of said easements.**

Please return one set of marked plans, along with the Utility Contact Form (UCF) stating whether your Agency is/or is not involved, to my office on or before **Monday, September 11, 2023.**

Your input and continued cooperation on this important community project is essential to the design and utility coordination effort. Should you have any questions don't hesitate to contact me directly at 813-559-2262, or by email at Chris.Stermer@WGInc.com.

Sincerely,

A handwritten signature in blue ink, appearing to read 'C. Stermer', is positioned above the printed name.


Christopher J. Stermer
Senior Utility Coordination Manager

Enc: One set of Electronic Plans (dated 06/29/23), (1) Utility Contact Form (UCF)

cc: David Turley, FDOT Project Manager
Joe Lauk, P.E., PGA/FDOT, GEC Utility Project Manager
Gordon Mullen, RK&K, Design Project Manager
Rudy Gotmare, Scalar, Project Manager
File

APPENDIX B
UTILITY RESPONSES

COMCAST

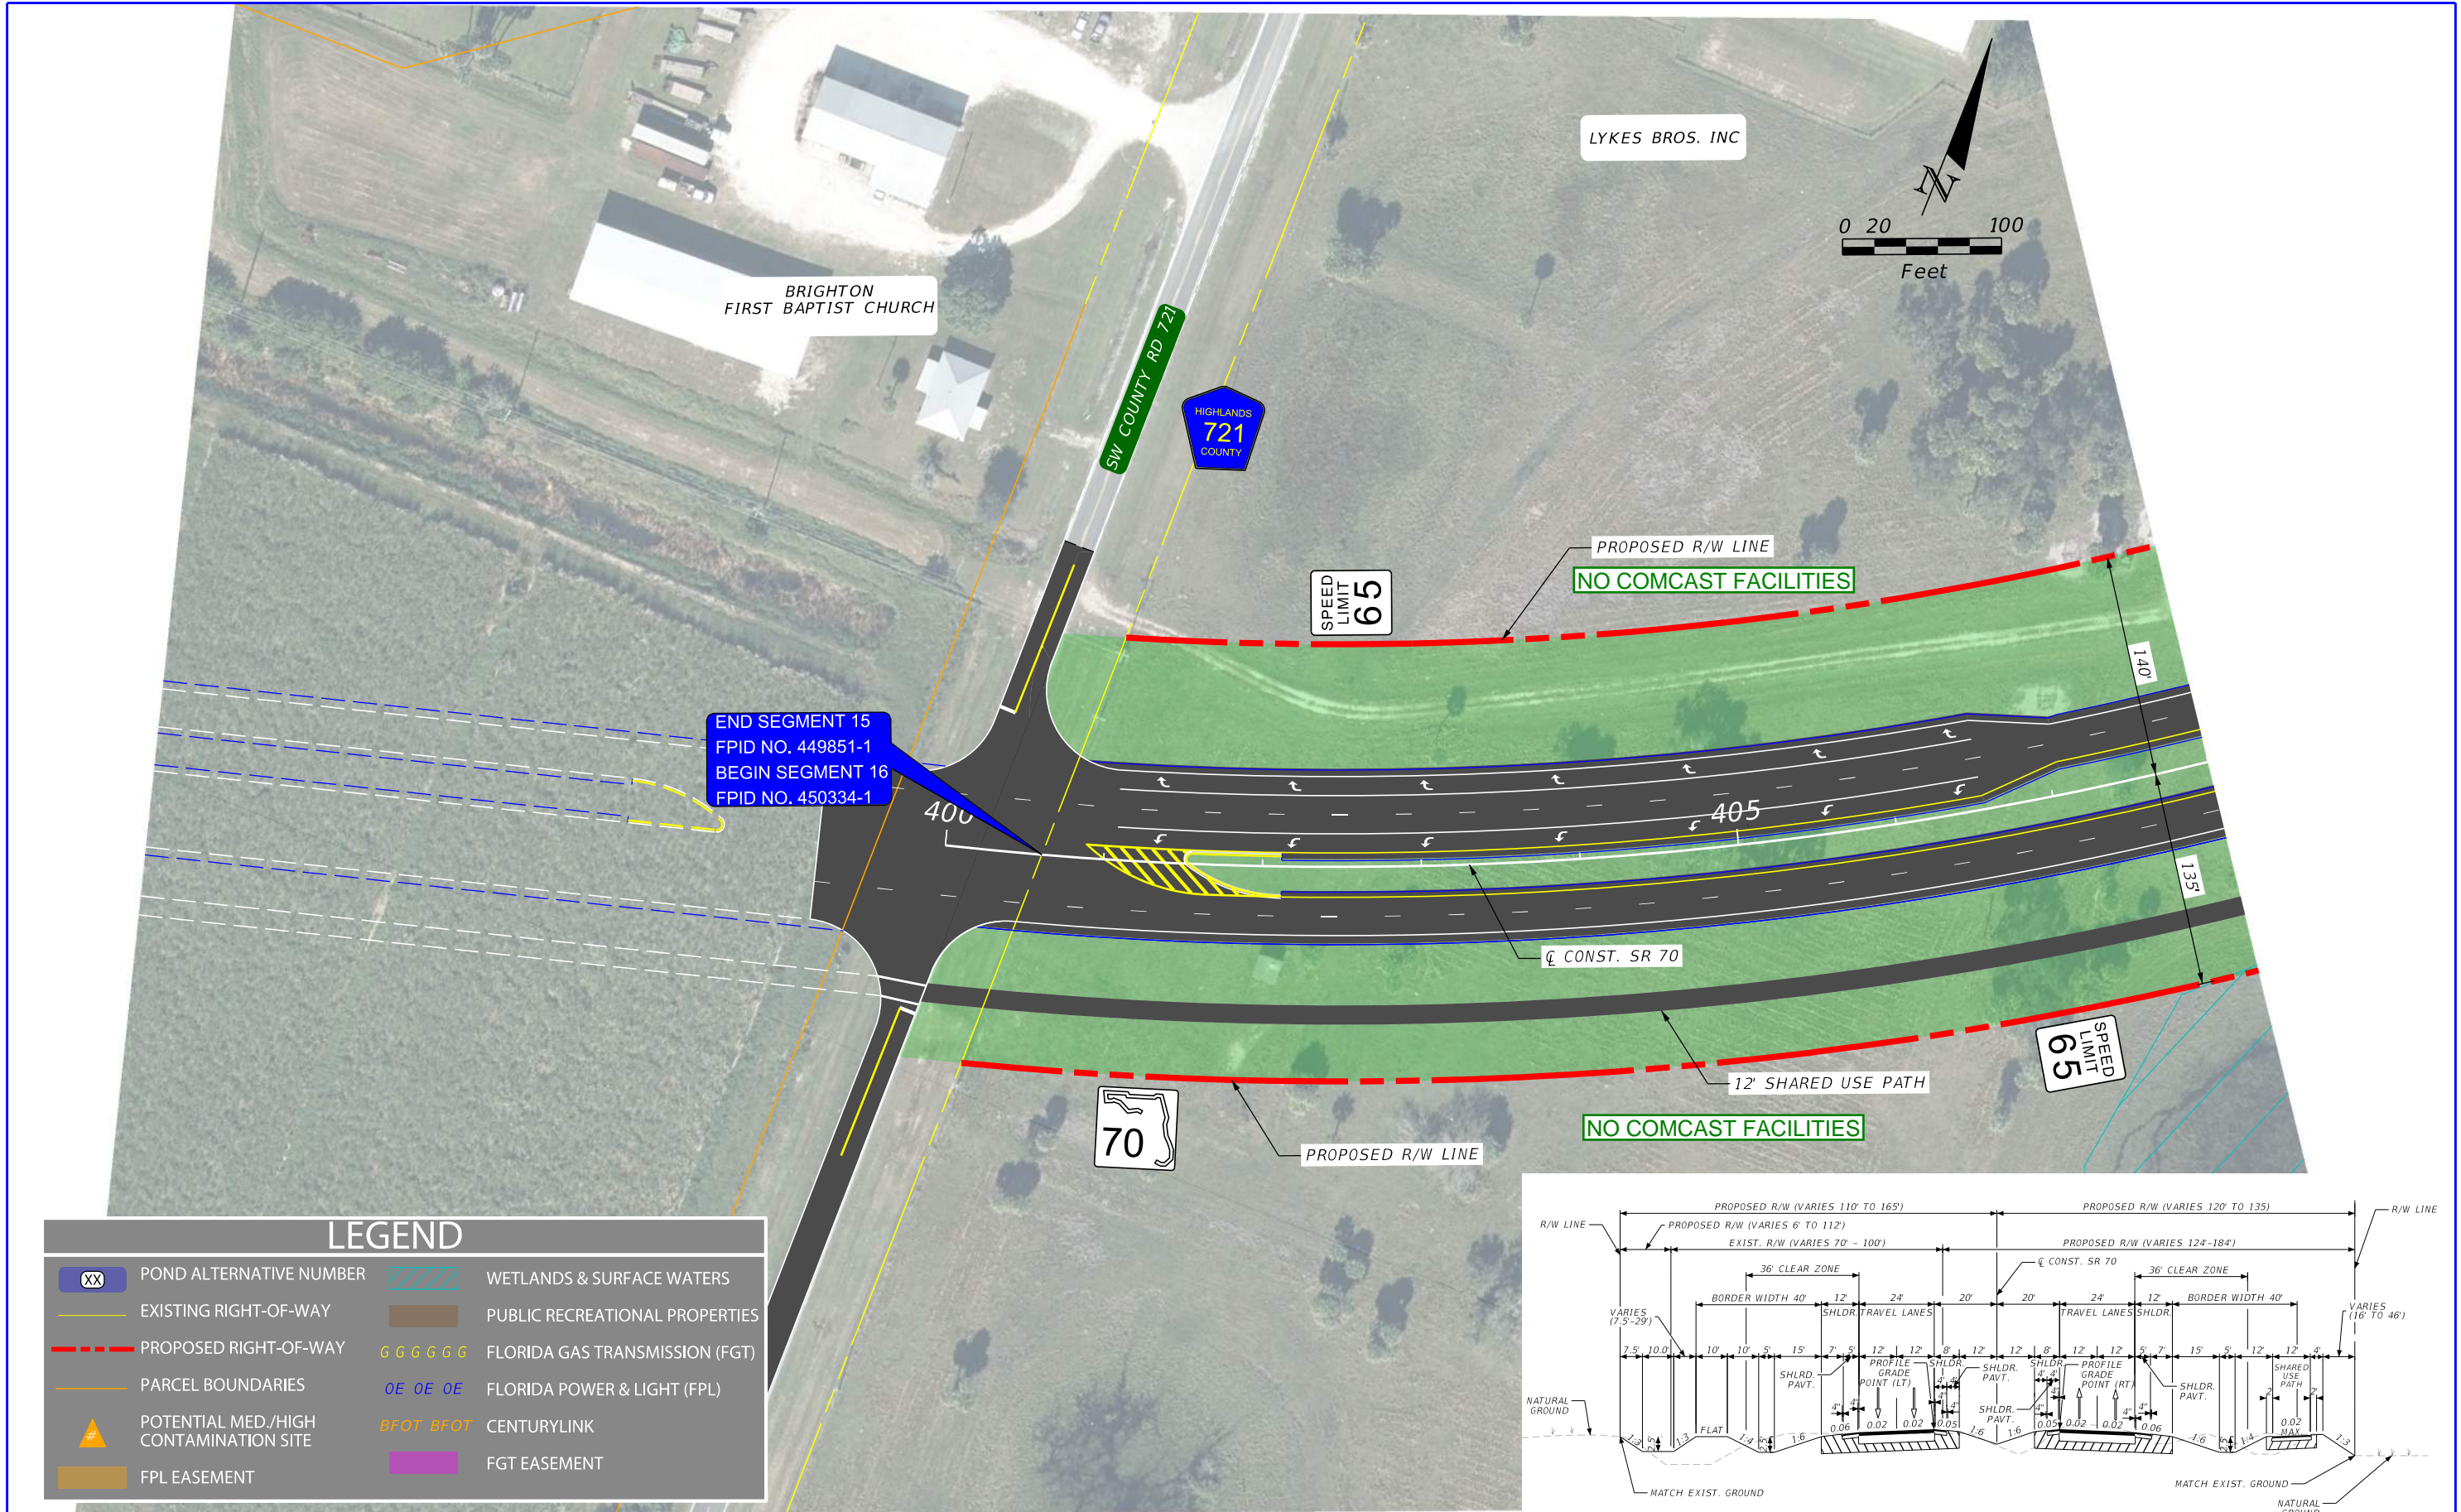

XX

POND ALTERNATIVE NUMBER

EXISTING RIGHT-OF-WAY

PROPOSED RIGHT-OF-WAY

PARCEL BOUNDARIES

#

POTENTIAL MED./HIGH CONTAMINATION SITE

FPL EASEMENT

WETLANDS & SURFACE WATERS

PUBLIC RECREATIONAL PROPERTIES

FGT

FLORIDA GAS TRANSMISSION (FGT)

FPL


FLORIDA POWER & LIGHT (FPL)

CL


CENTURYLINK

FGT

FGT EASEMENT

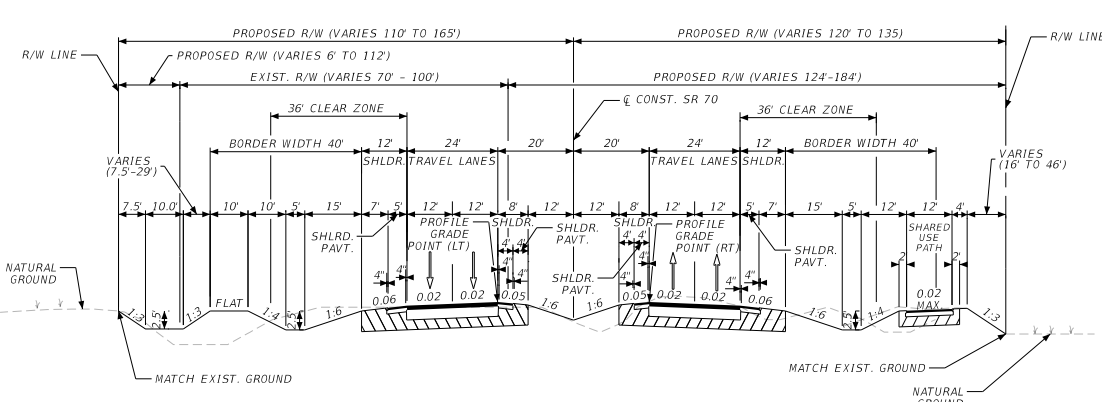


REVISIONS				ENGINEER OF RECORD			STATE OF FLORIDA DEPARTMENT OF TRANSPORTATION			SHEET NO. 1
DATE	DESCRIPTION	DATE	DESCRIPTION	NICHOLAS JOHN CLAVELO LICENSE NUMBER: 84366 SCALAR CONSULTING GROUP INC. 5713 CORPORATE WAY, SUITE 200 WEST PALM BEACH, FLORIDA 33407			ROAD NO.	COUNTY	FINANCIAL PROJECT ID	
							SR 70	HIGHLANDS OKEECHOBEE	450334-1-22-01	

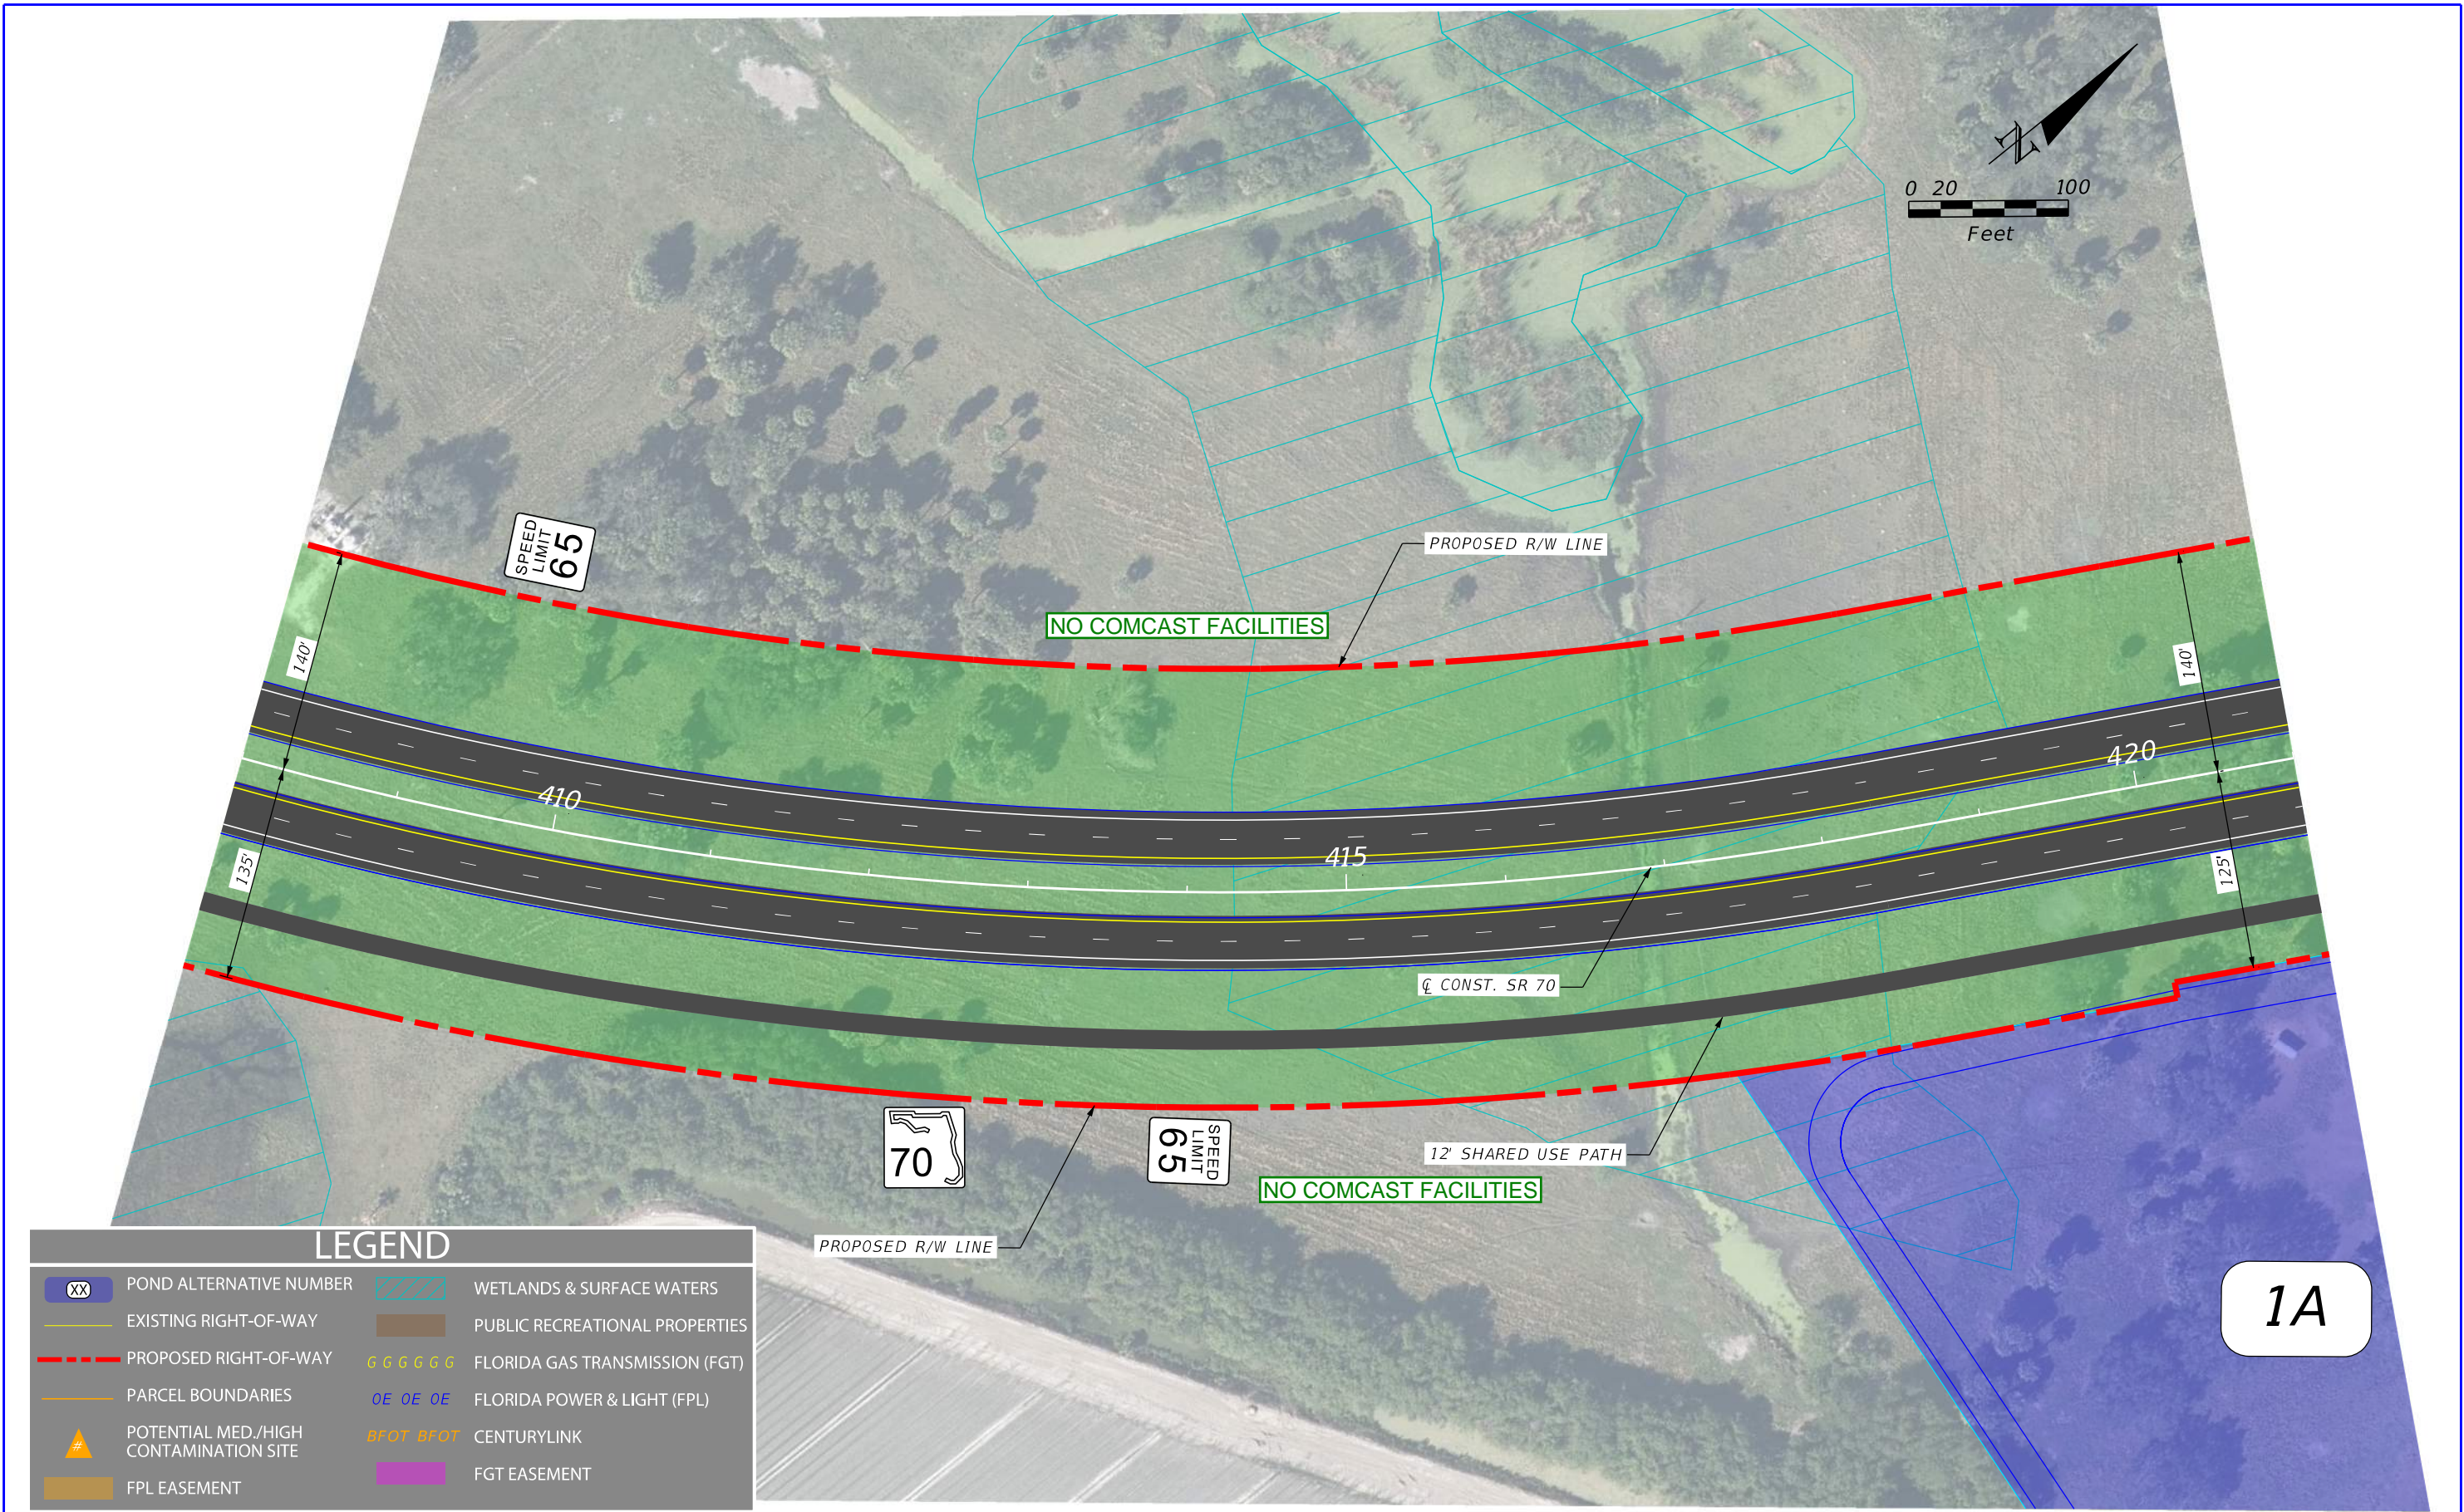

REVISIONS				ENGINEER OF RECORD		STATE OF FLORIDA DEPARTMENT OF TRANSPORTATION		SHEET NO.
DATE	DESCRIPTION	DATE	DESCRIPTION	NICHOLAS JOHN CLAVELO LICENSE NUMBER: 84366 SCALAR CONSULTING GROUP INC. 5713 CORPORATE WAY, SUITE 200 WEST PALM BEACH, FLORIDA 33407		ROAD NO.	COUNTY	
						SR 70	HIGHLANDS OKEECHOBEE	
							FINANCIAL PROJECT ID 450334-1-22-01	2

ALTERNATIVE 1
CONCEPT PLAN

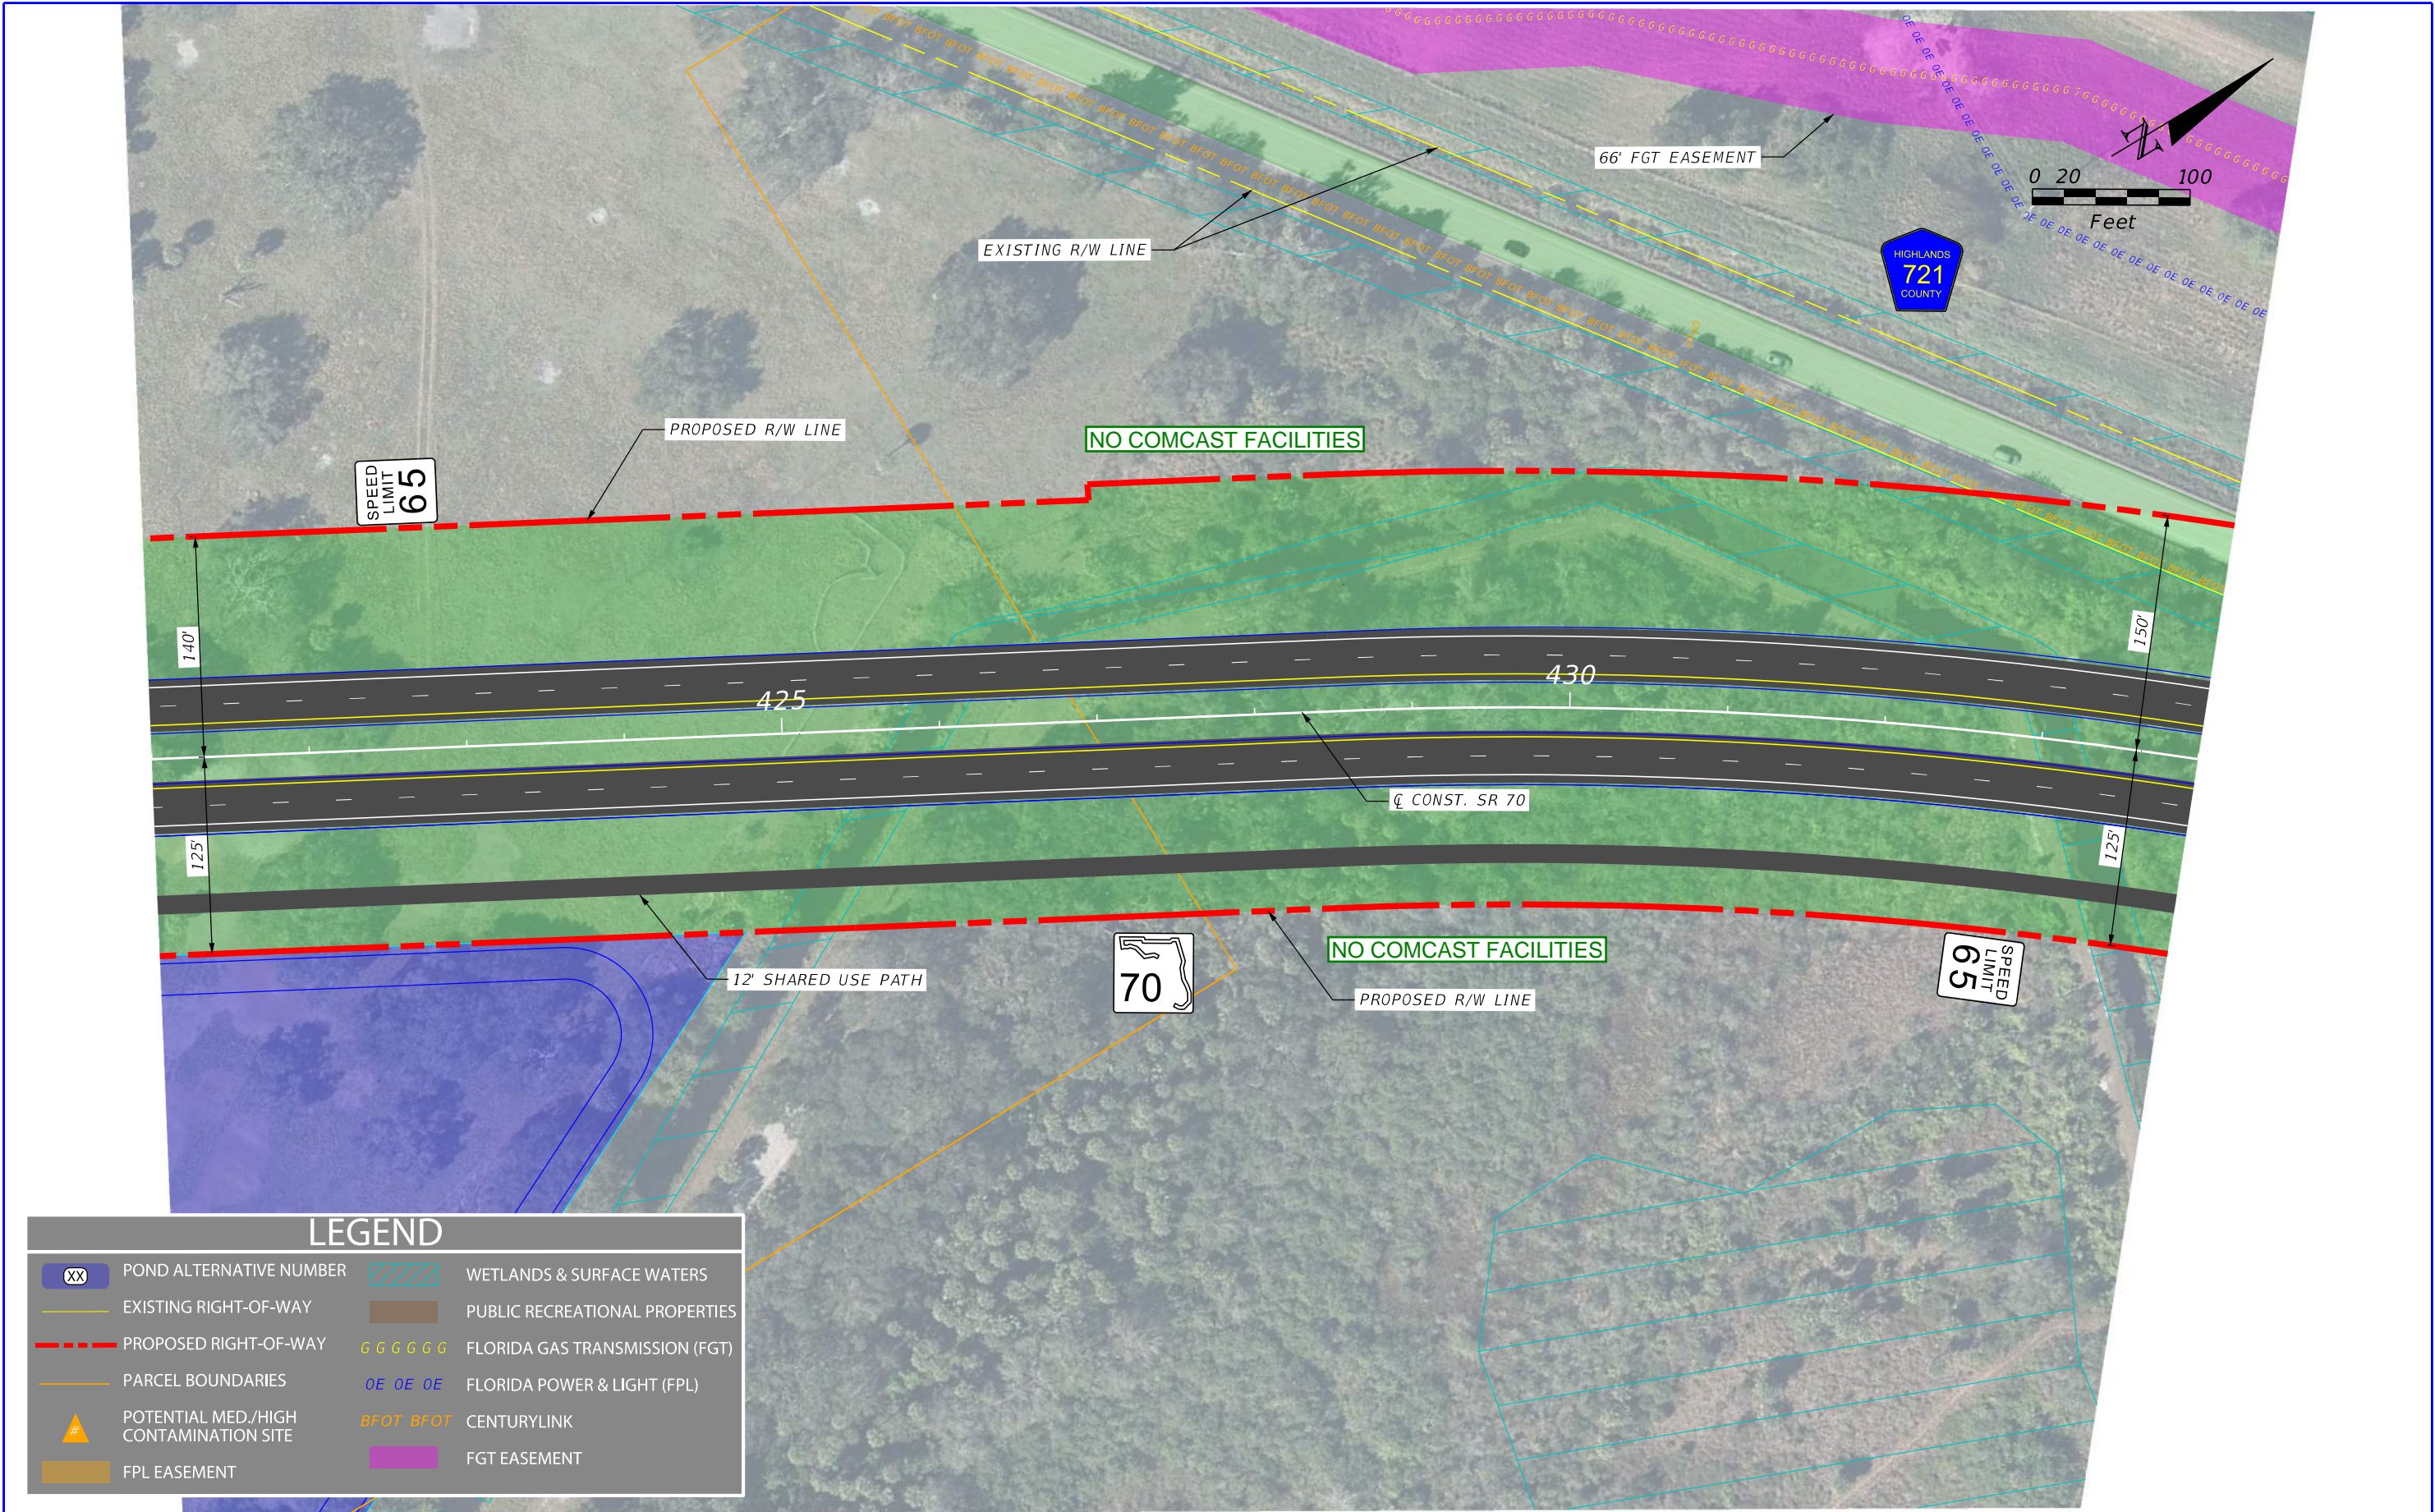

LEGEND

XX

POND ALTERNATIVE NUMBER

EXISTING RIGHT-OF-WAY

PROPOSED RIGHT-OF-WAY

PARCEL BOUNDARIES

#

POTENTIAL MED./HIGH CONTAMINATION SITE

FPL EASEMENT

WETLANDS & SURFACE WATERS

PUBLIC RECREATIONAL PROPERTIES

GGGGGG

FLORIDA GAS TRANSMISSION (FGT)

OE OE OE


FLORIDA POWER & LIGHT (FPL)

BFOT BFOT


CENTURYLINK

FGT EASEMENT

REVISIONS				ENGINEER OF RECORD		STATE OF FLORIDA DEPARTMENT OF TRANSPORTATION		ALTERNATIVE 1 CONCEPT PLAN	SHEET NO. 3
DATE	DESCRIPTION	DATE	DESCRIPTION	NICHOLAS JOHN CLAVELO LICENSE NUMBER: 84366 SCALAR CONSULTING GROUP INC. 5713 CORPORATE WAY, SUITE 200 WEST PALM BEACH, FLORIDA 33407		ROAD NO.	COUNTY		
						SR 70	HIGHLANDS OKEECHOBEE	FINANCIAL PROJECT ID 450334-1-22-01	

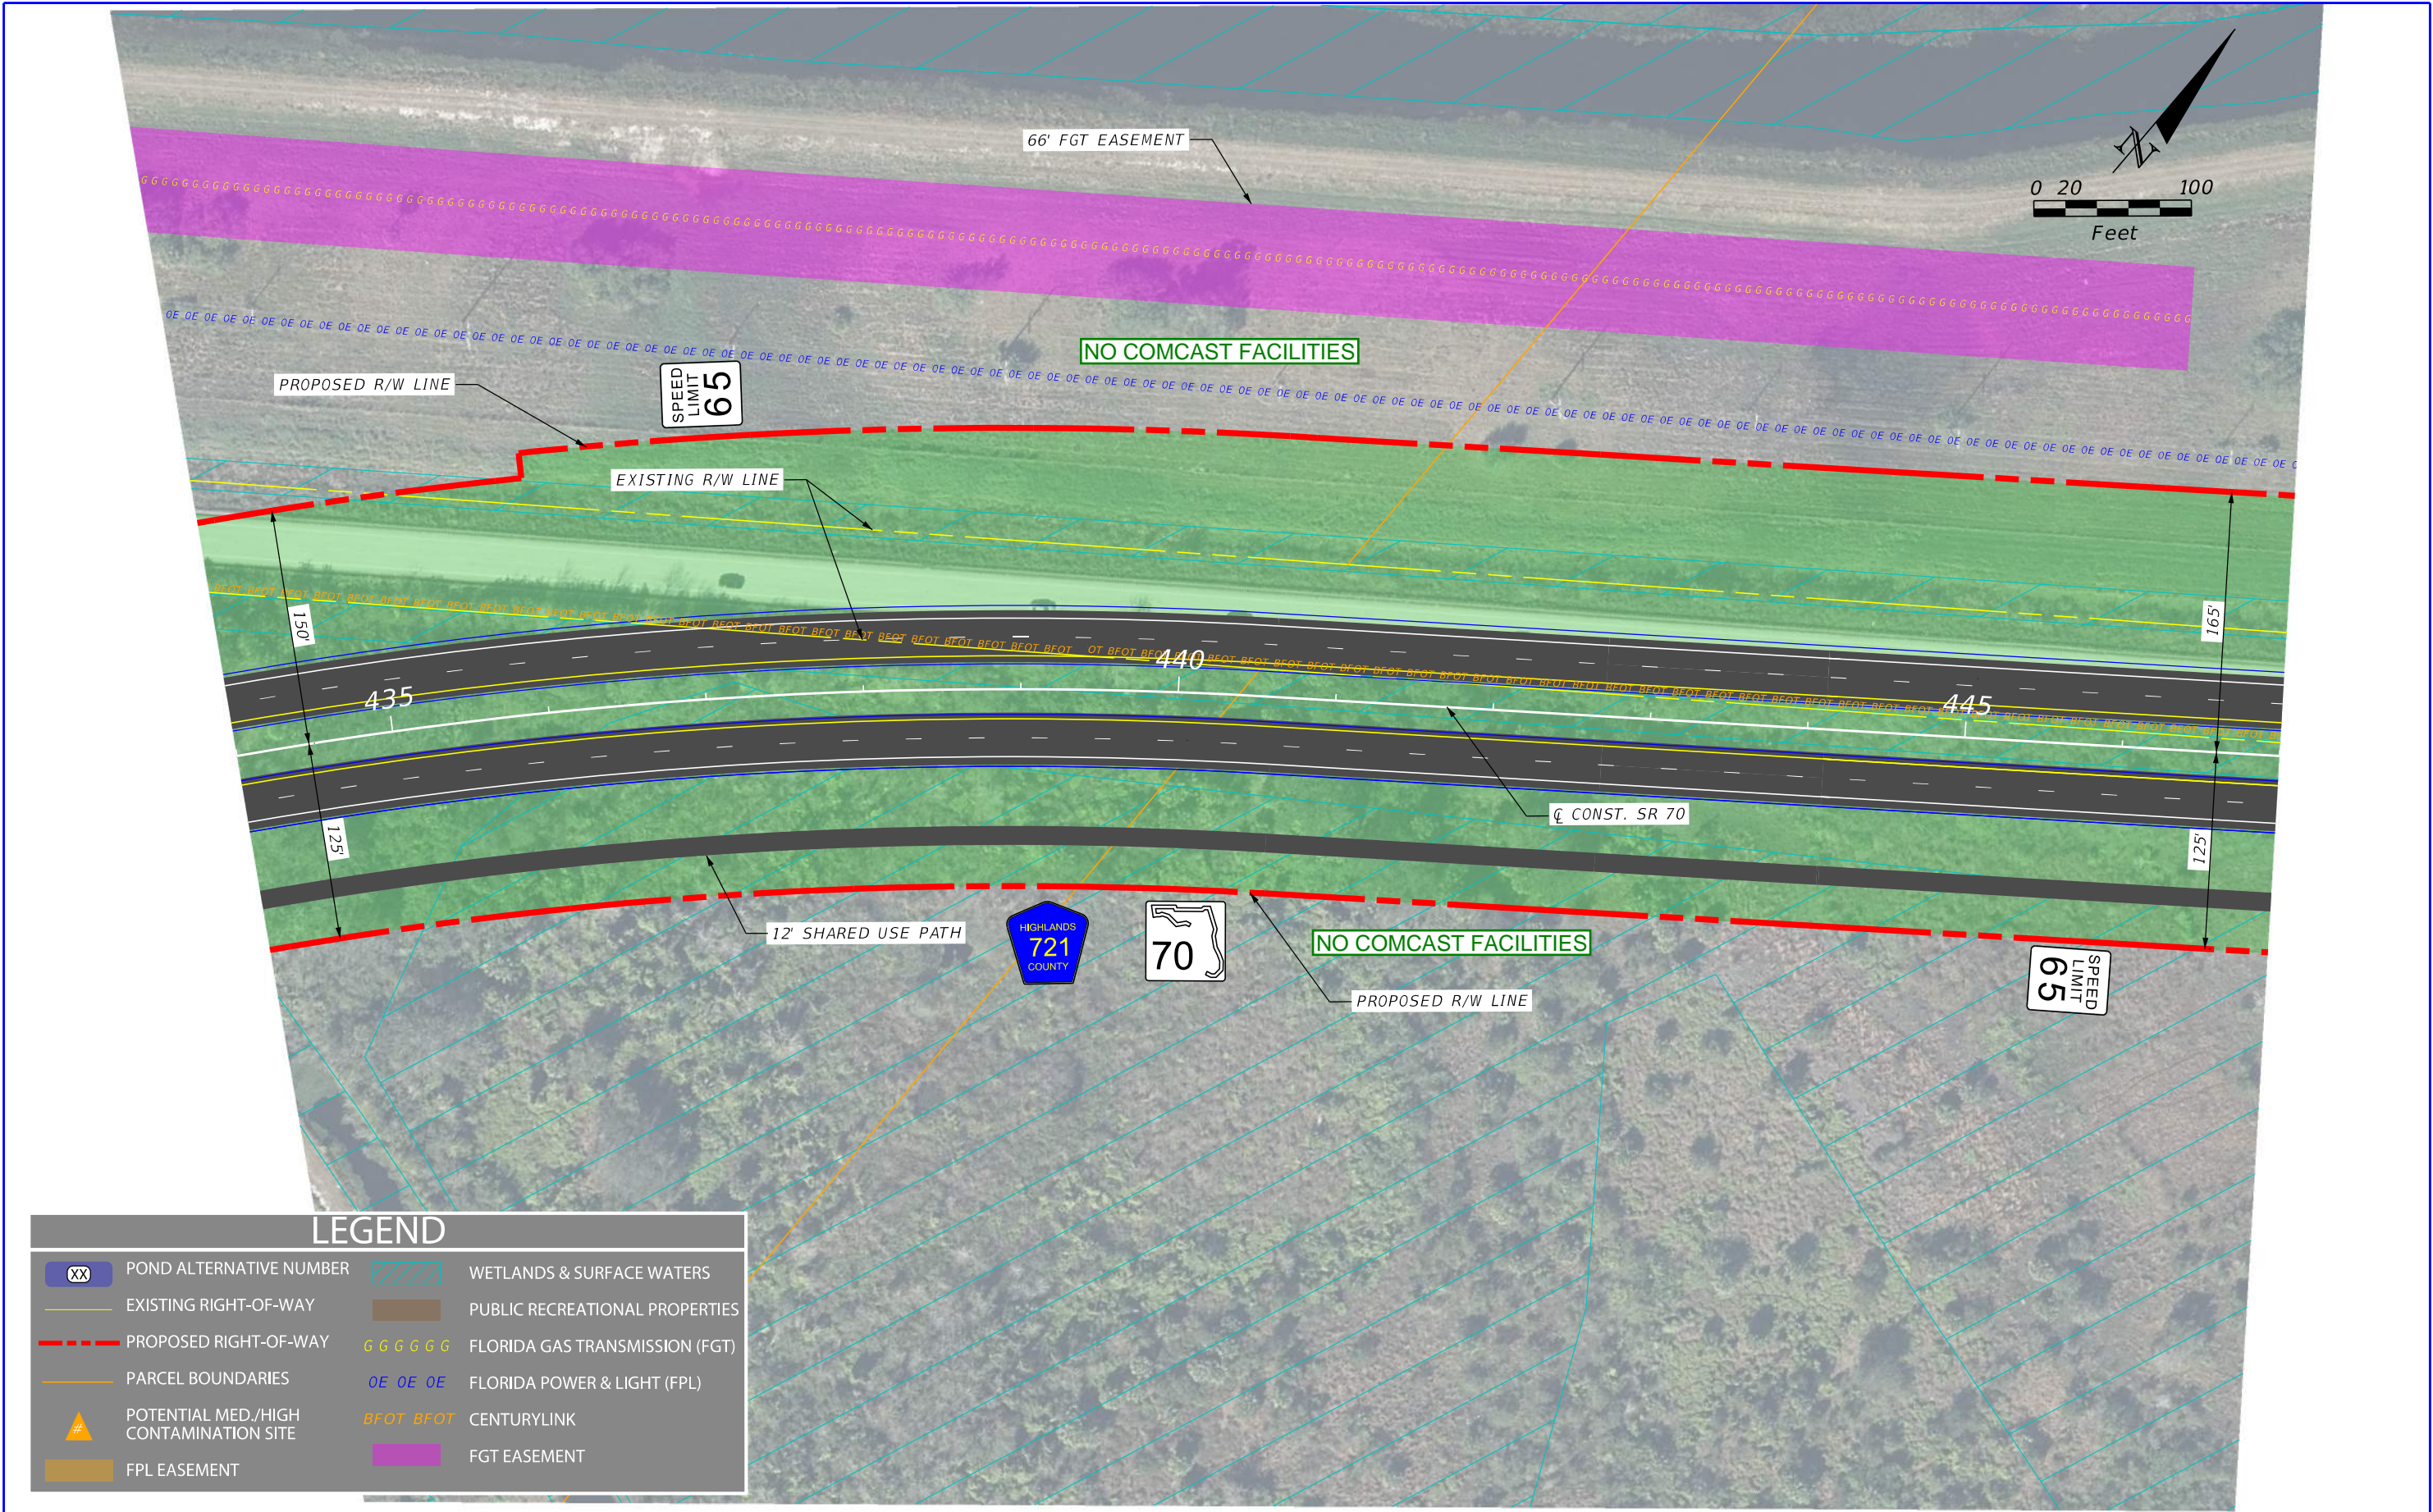

REVISIONS				ENGINEER OF RECORD		STATE OF FLORIDA DEPARTMENT OF TRANSPORTATION		ALTERNATIVE 1 CONCEPT PLAN	SHEET NO. 4
DATE	DESCRIPTION	DATE	DESCRIPTION	NICHOLAS JOHN CLAVELO LICENSE NUMBER: 84366 SCALAR CONSULTING GROUP INC. 5713 CORPORATE WAY, SUITE 200 WEST PALM BEACH, FLORIDA 33407		ROAD NO.	COUNTY		
						SR 70	HIGHLANDS OKEECHOBEE	FINANCIAL PROJECT ID 450334-1-22-01	

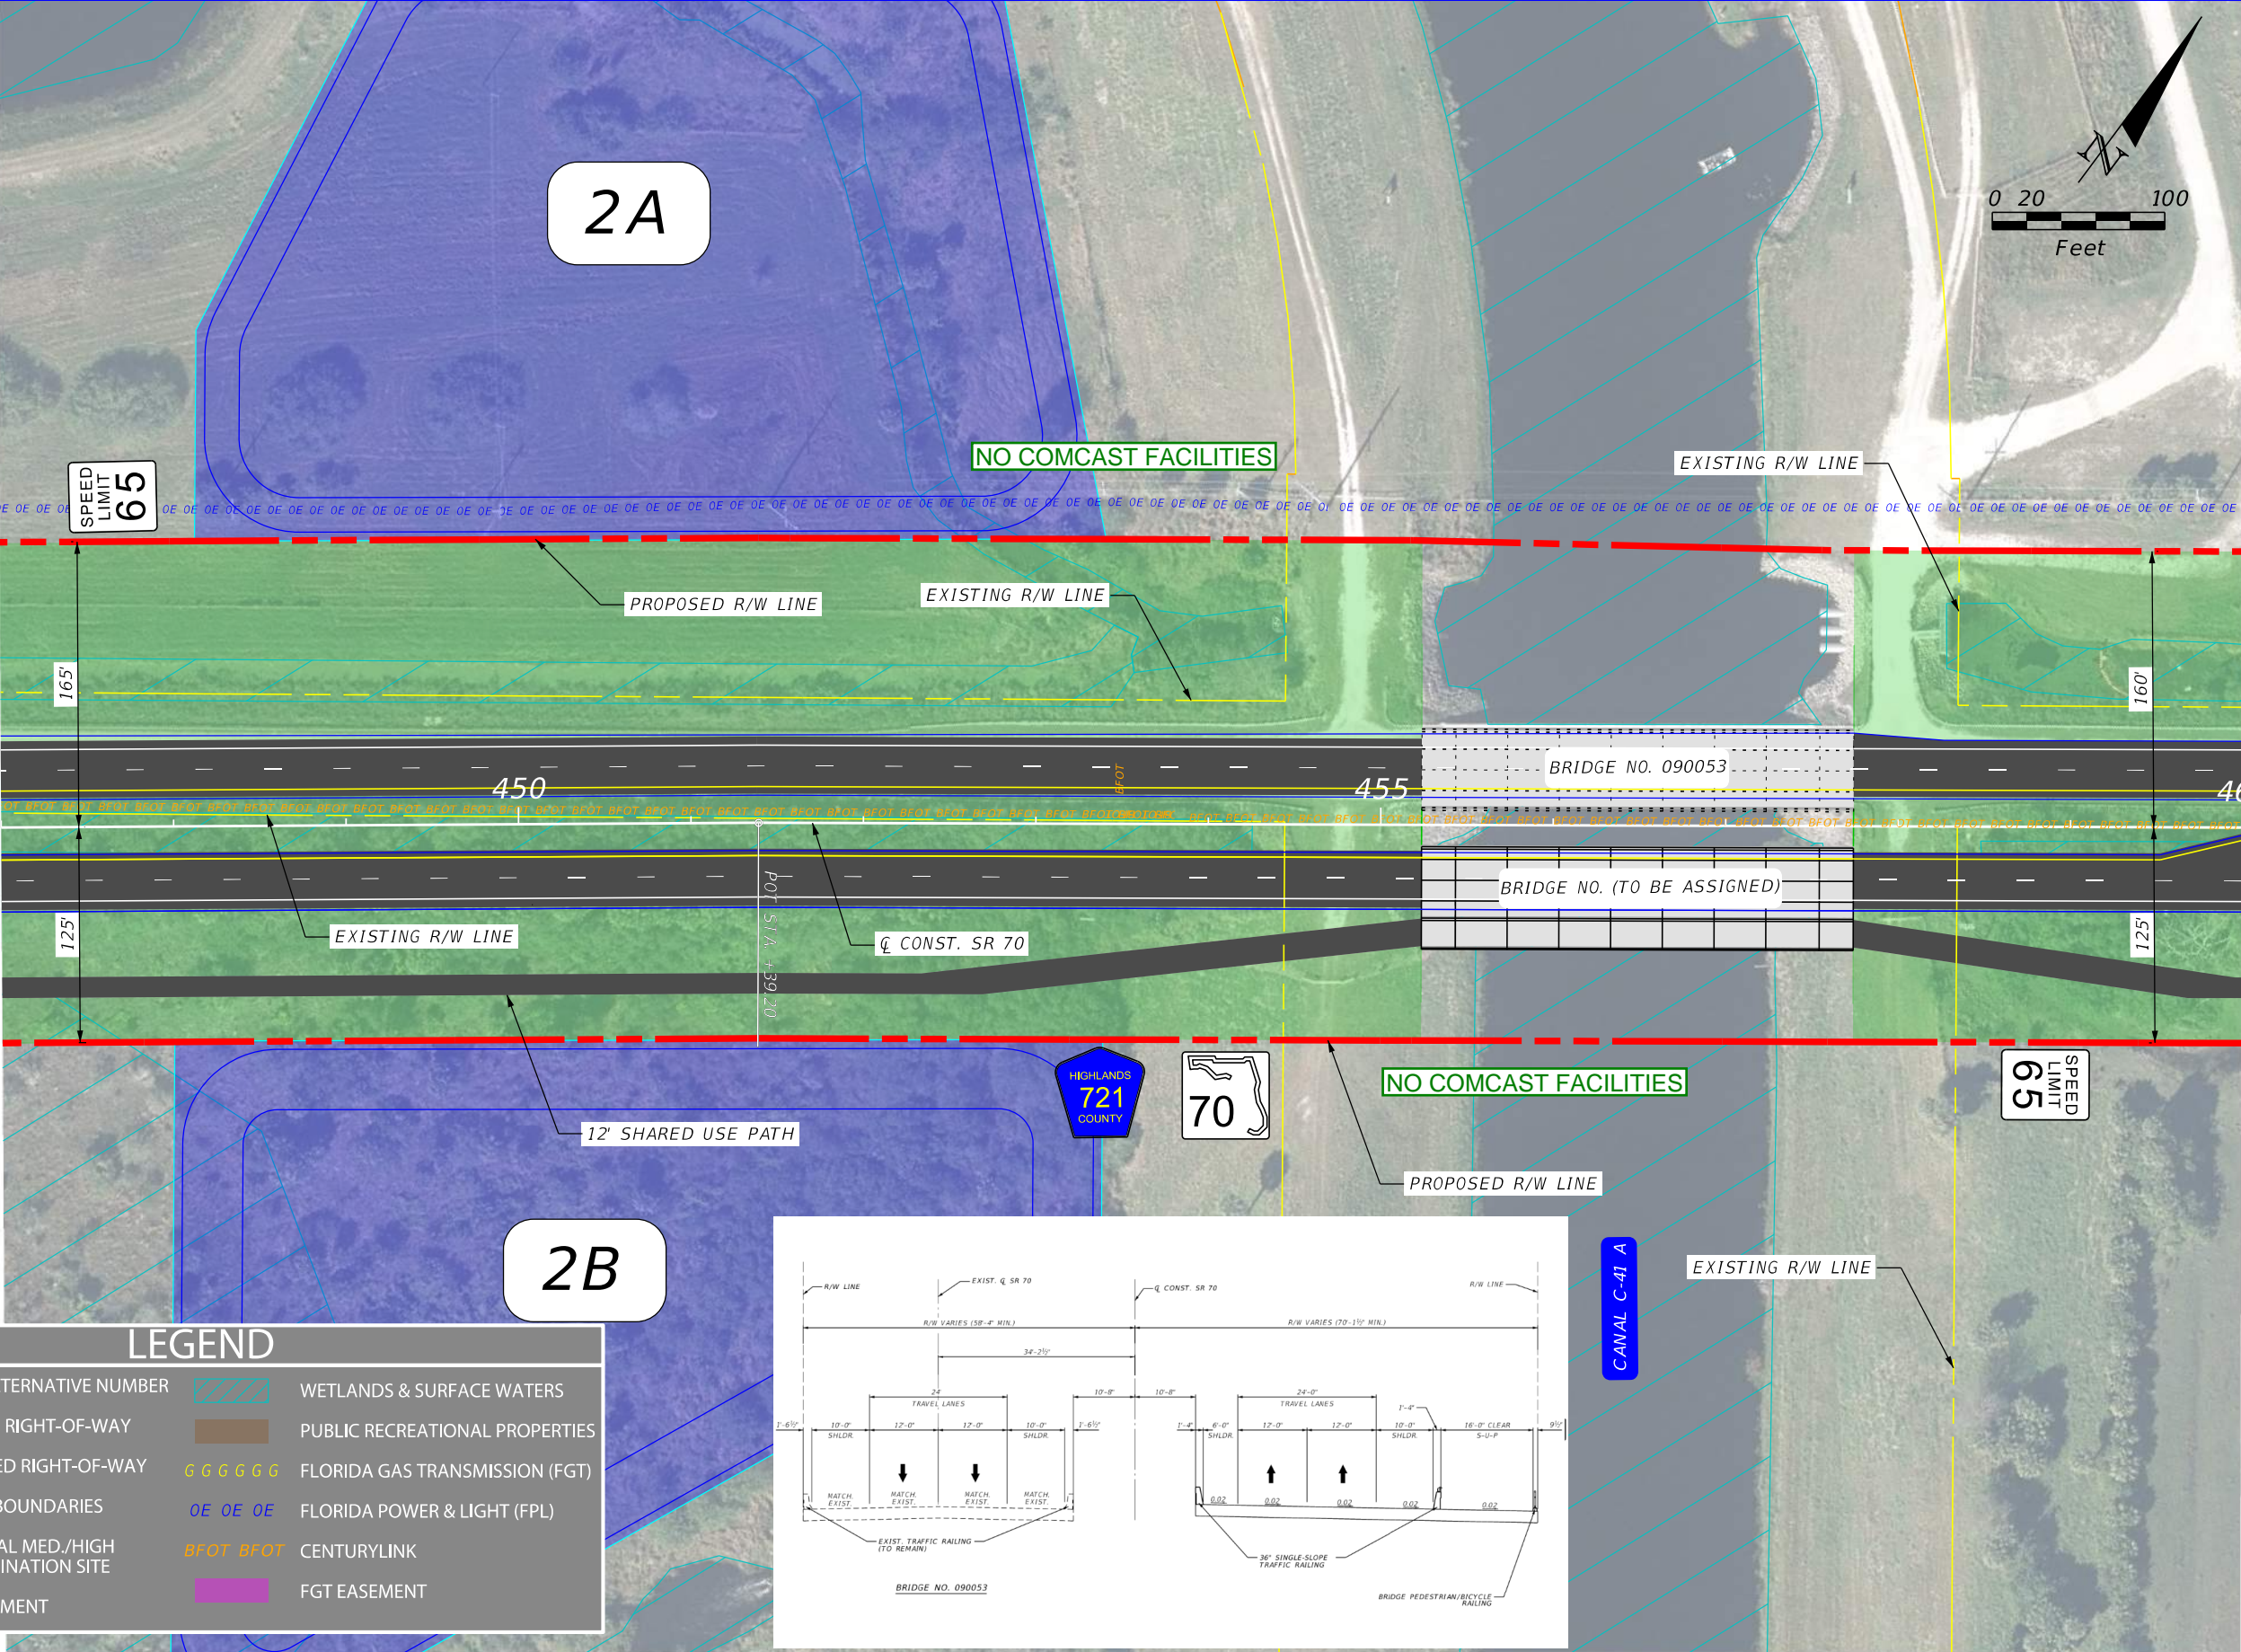

LEGEND

XX

POND ALTERNATIVE NUMBER

EXISTING RIGHT-OF-WAY

PROPOSED RIGHT-OF-WAY

PARCEL BOUNDARIES

#

POTENTIAL MED./HIGH CONTAMINATION SITE

FPL EASEMENT

WETLANDS & SURFACE WATERS

PUBLIC RECREATIONAL PROPERTIES

GGGGGG

FLORIDA GAS TRANSMISSION (FGT)


OE OE OE

FLORIDA POWER & LIGHT (FPL)


BFOT BFOT

CENTURYLINK

FGT EASEMENT

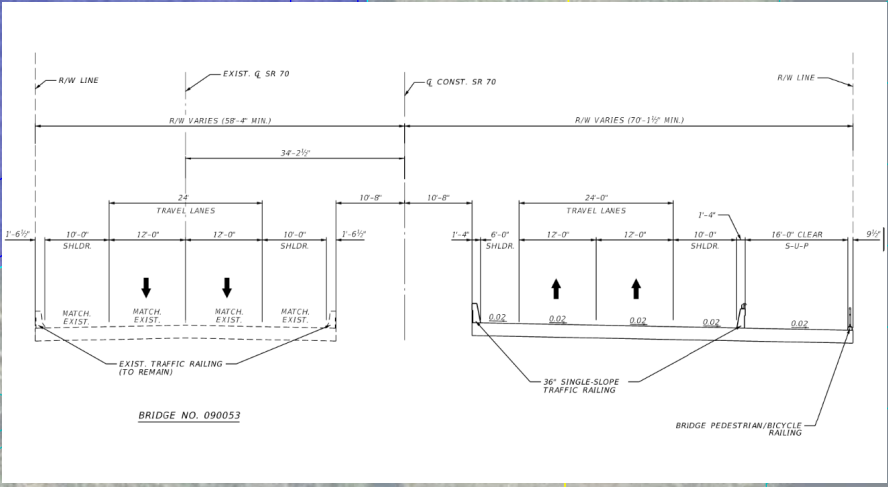

REVISIONS				ENGINEER OF RECORD		STATE OF FLORIDA DEPARTMENT OF TRANSPORTATION		ALTERNATIVE 1 CONCEPT PLAN	SHEET NO. 5
DATE	DESCRIPTION	DATE	DESCRIPTION	NICHOLAS JOHN CLAVELO LICENSE NUMBER: 84366 SCALAR CONSULTING GROUP INC. 5713 CORPORATE WAY, SUITE 200 WEST PALM BEACH, FLORIDA 33407		ROAD NO.	COUNTY		
						SR 70	HIGHLANDS OKEECHOBEE	FINANCIAL PROJECT ID 450334-1-22-01	

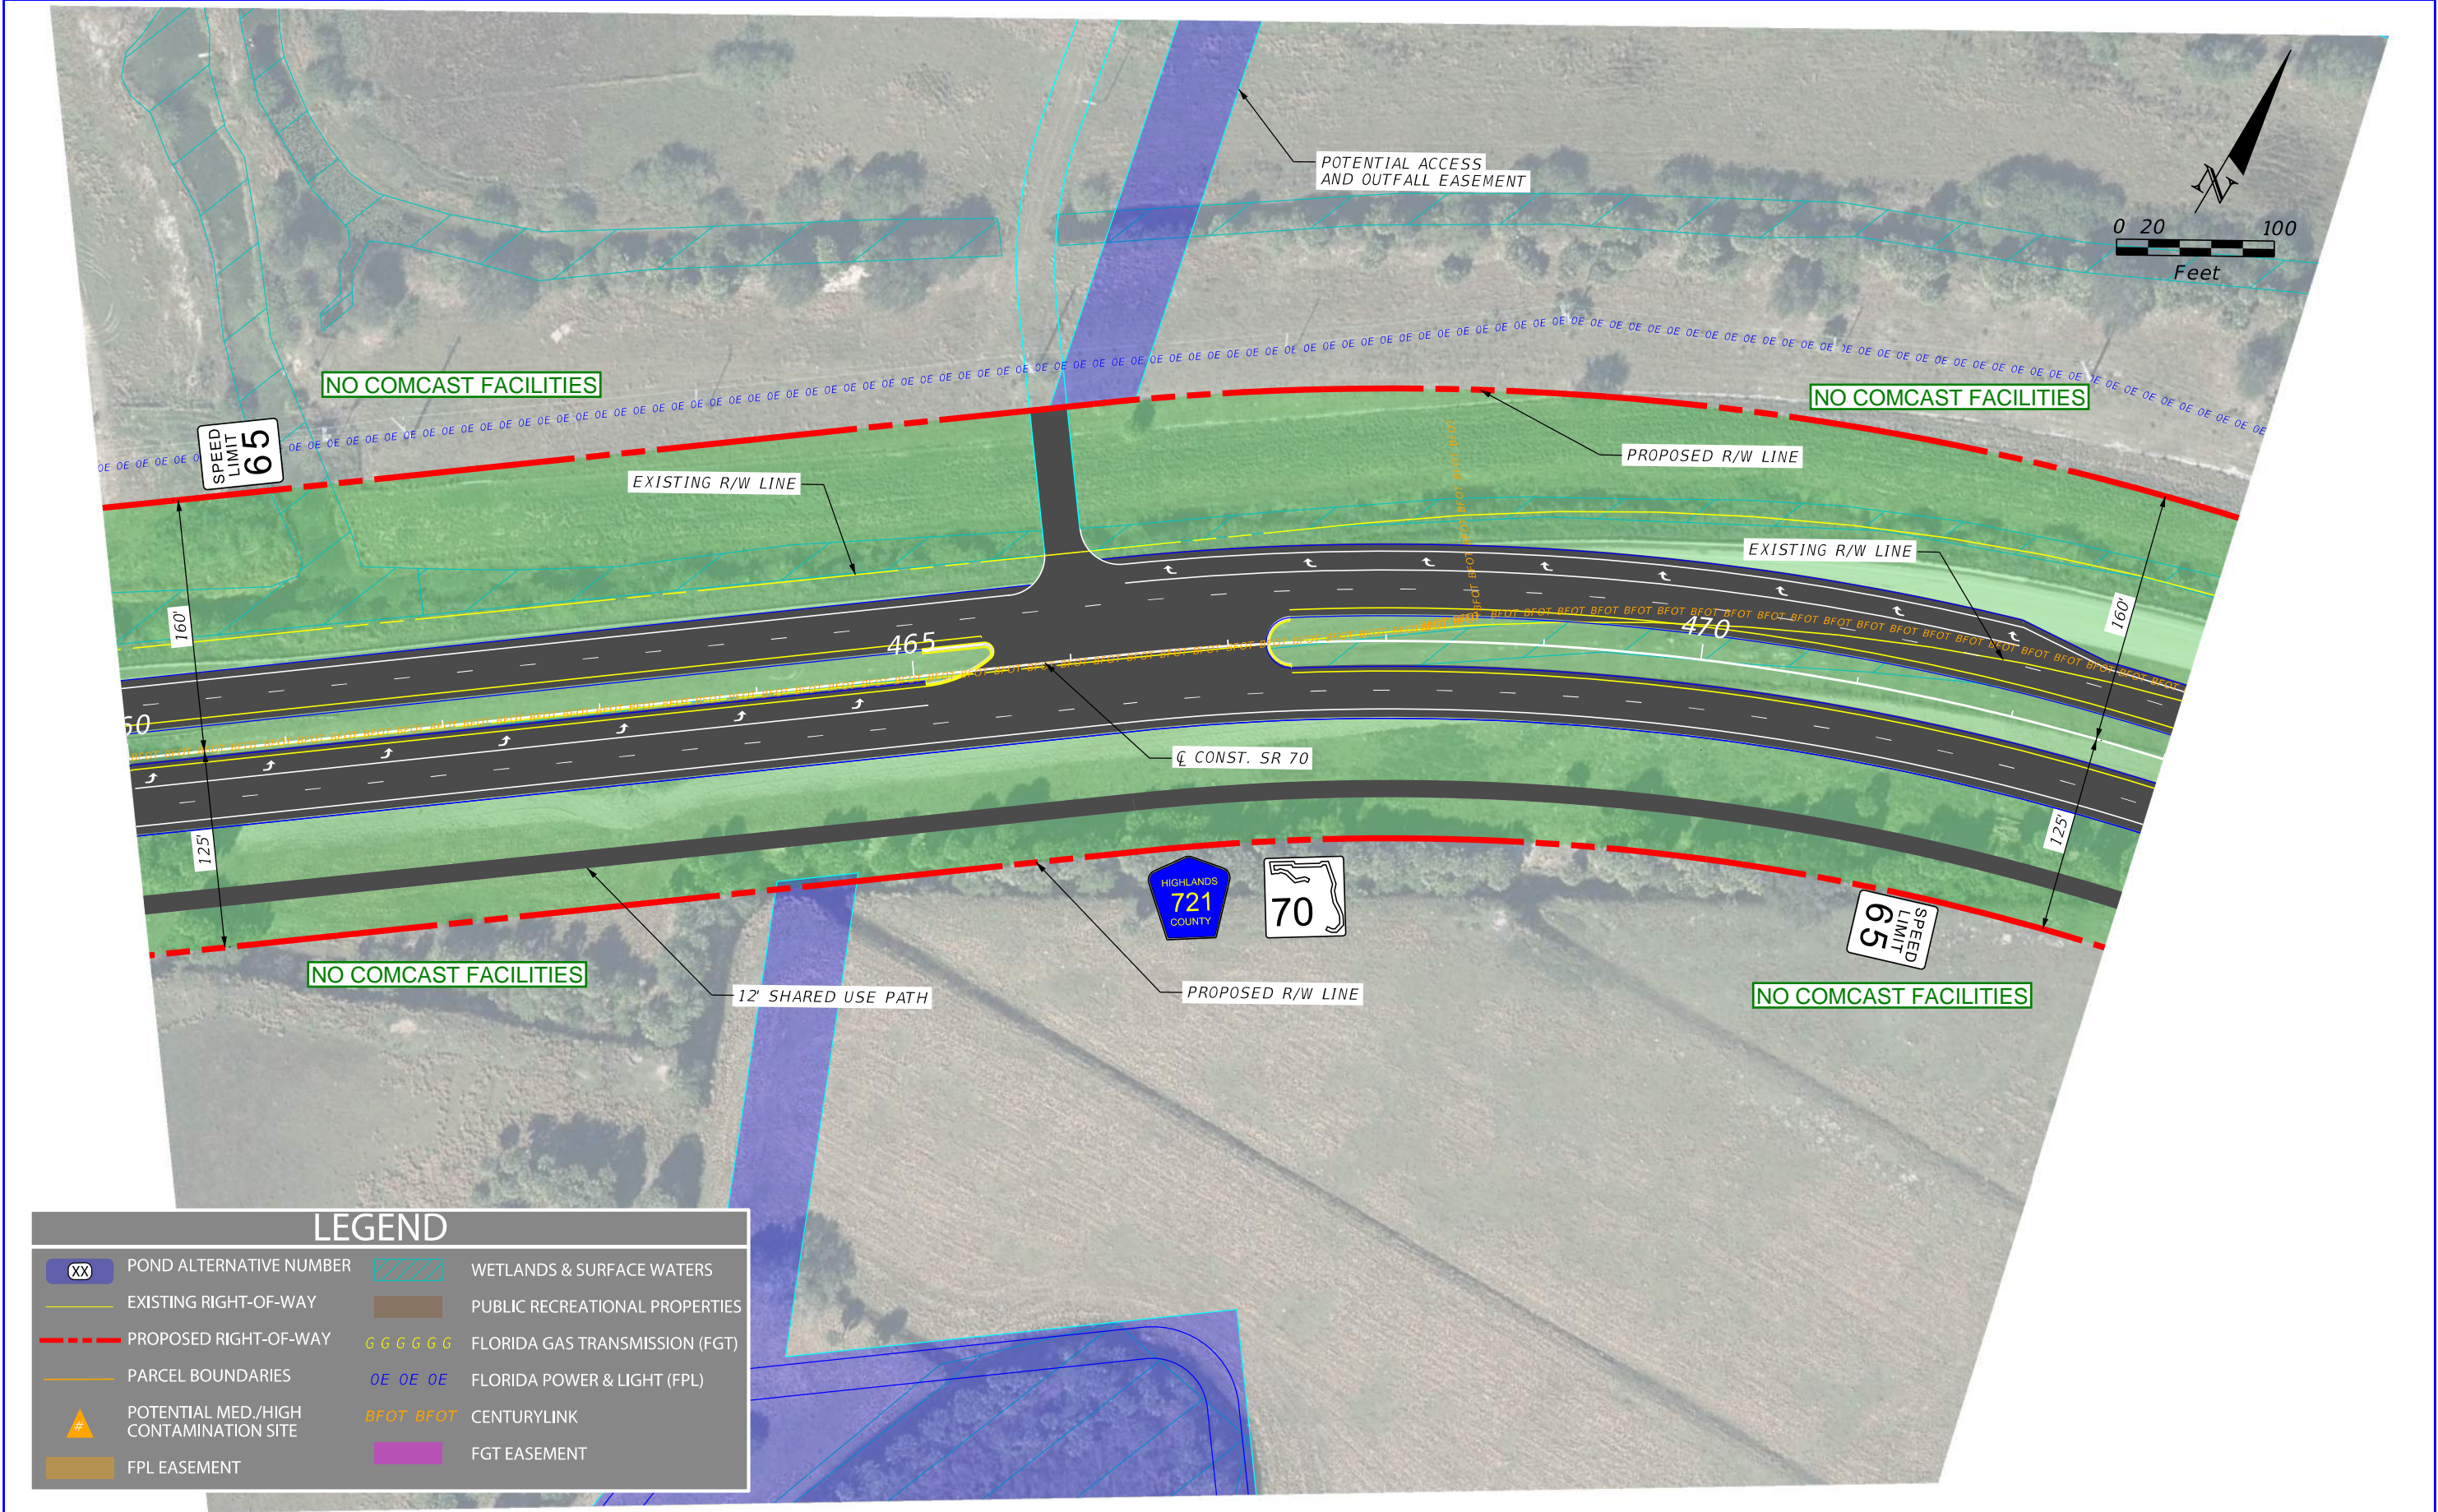

LEGEND

XX

POND ALTERNATIVE NUMBER

EXISTING RIGHT-OF-WAY

PROPOSED RIGHT-OF-WAY

PARCEL BOUNDARIES

#

POTENTIAL MED./HIGH CONTAMINATION SITE

FPL EASEMENT

WETLANDS & SURFACE WATERS

PUBLIC RECREATIONAL PROPERTIES

GGGGGG

FLORIDA GAS TRANSMISSION (FGT)

OE OE OE


FLORIDA POWER & LIGHT (FPL)

BFOT BFOT

CENTURYLINK

FGT EASEMENT

REVISIONS				ENGINEER OF RECORD		STATE OF FLORIDA DEPARTMENT OF TRANSPORTATION		ALTERNATIVE 1 CONCEPT PLAN	SHEET NO. 6
DATE	DESCRIPTION	DATE	DESCRIPTION	NICHOLAS JOHN CLAVELO LICENSE NUMBER: 84366 SCALAR CONSULTING GROUP INC. 5713 CORPORATE WAY, SUITE 200 WEST PALM BEACH, FLORIDA 33407		ROAD NO.	COUNTY		
						SR 70	HIGHLANDS OKEECHOBEE	FINANCIAL PROJECT ID 450334-1-22-01	

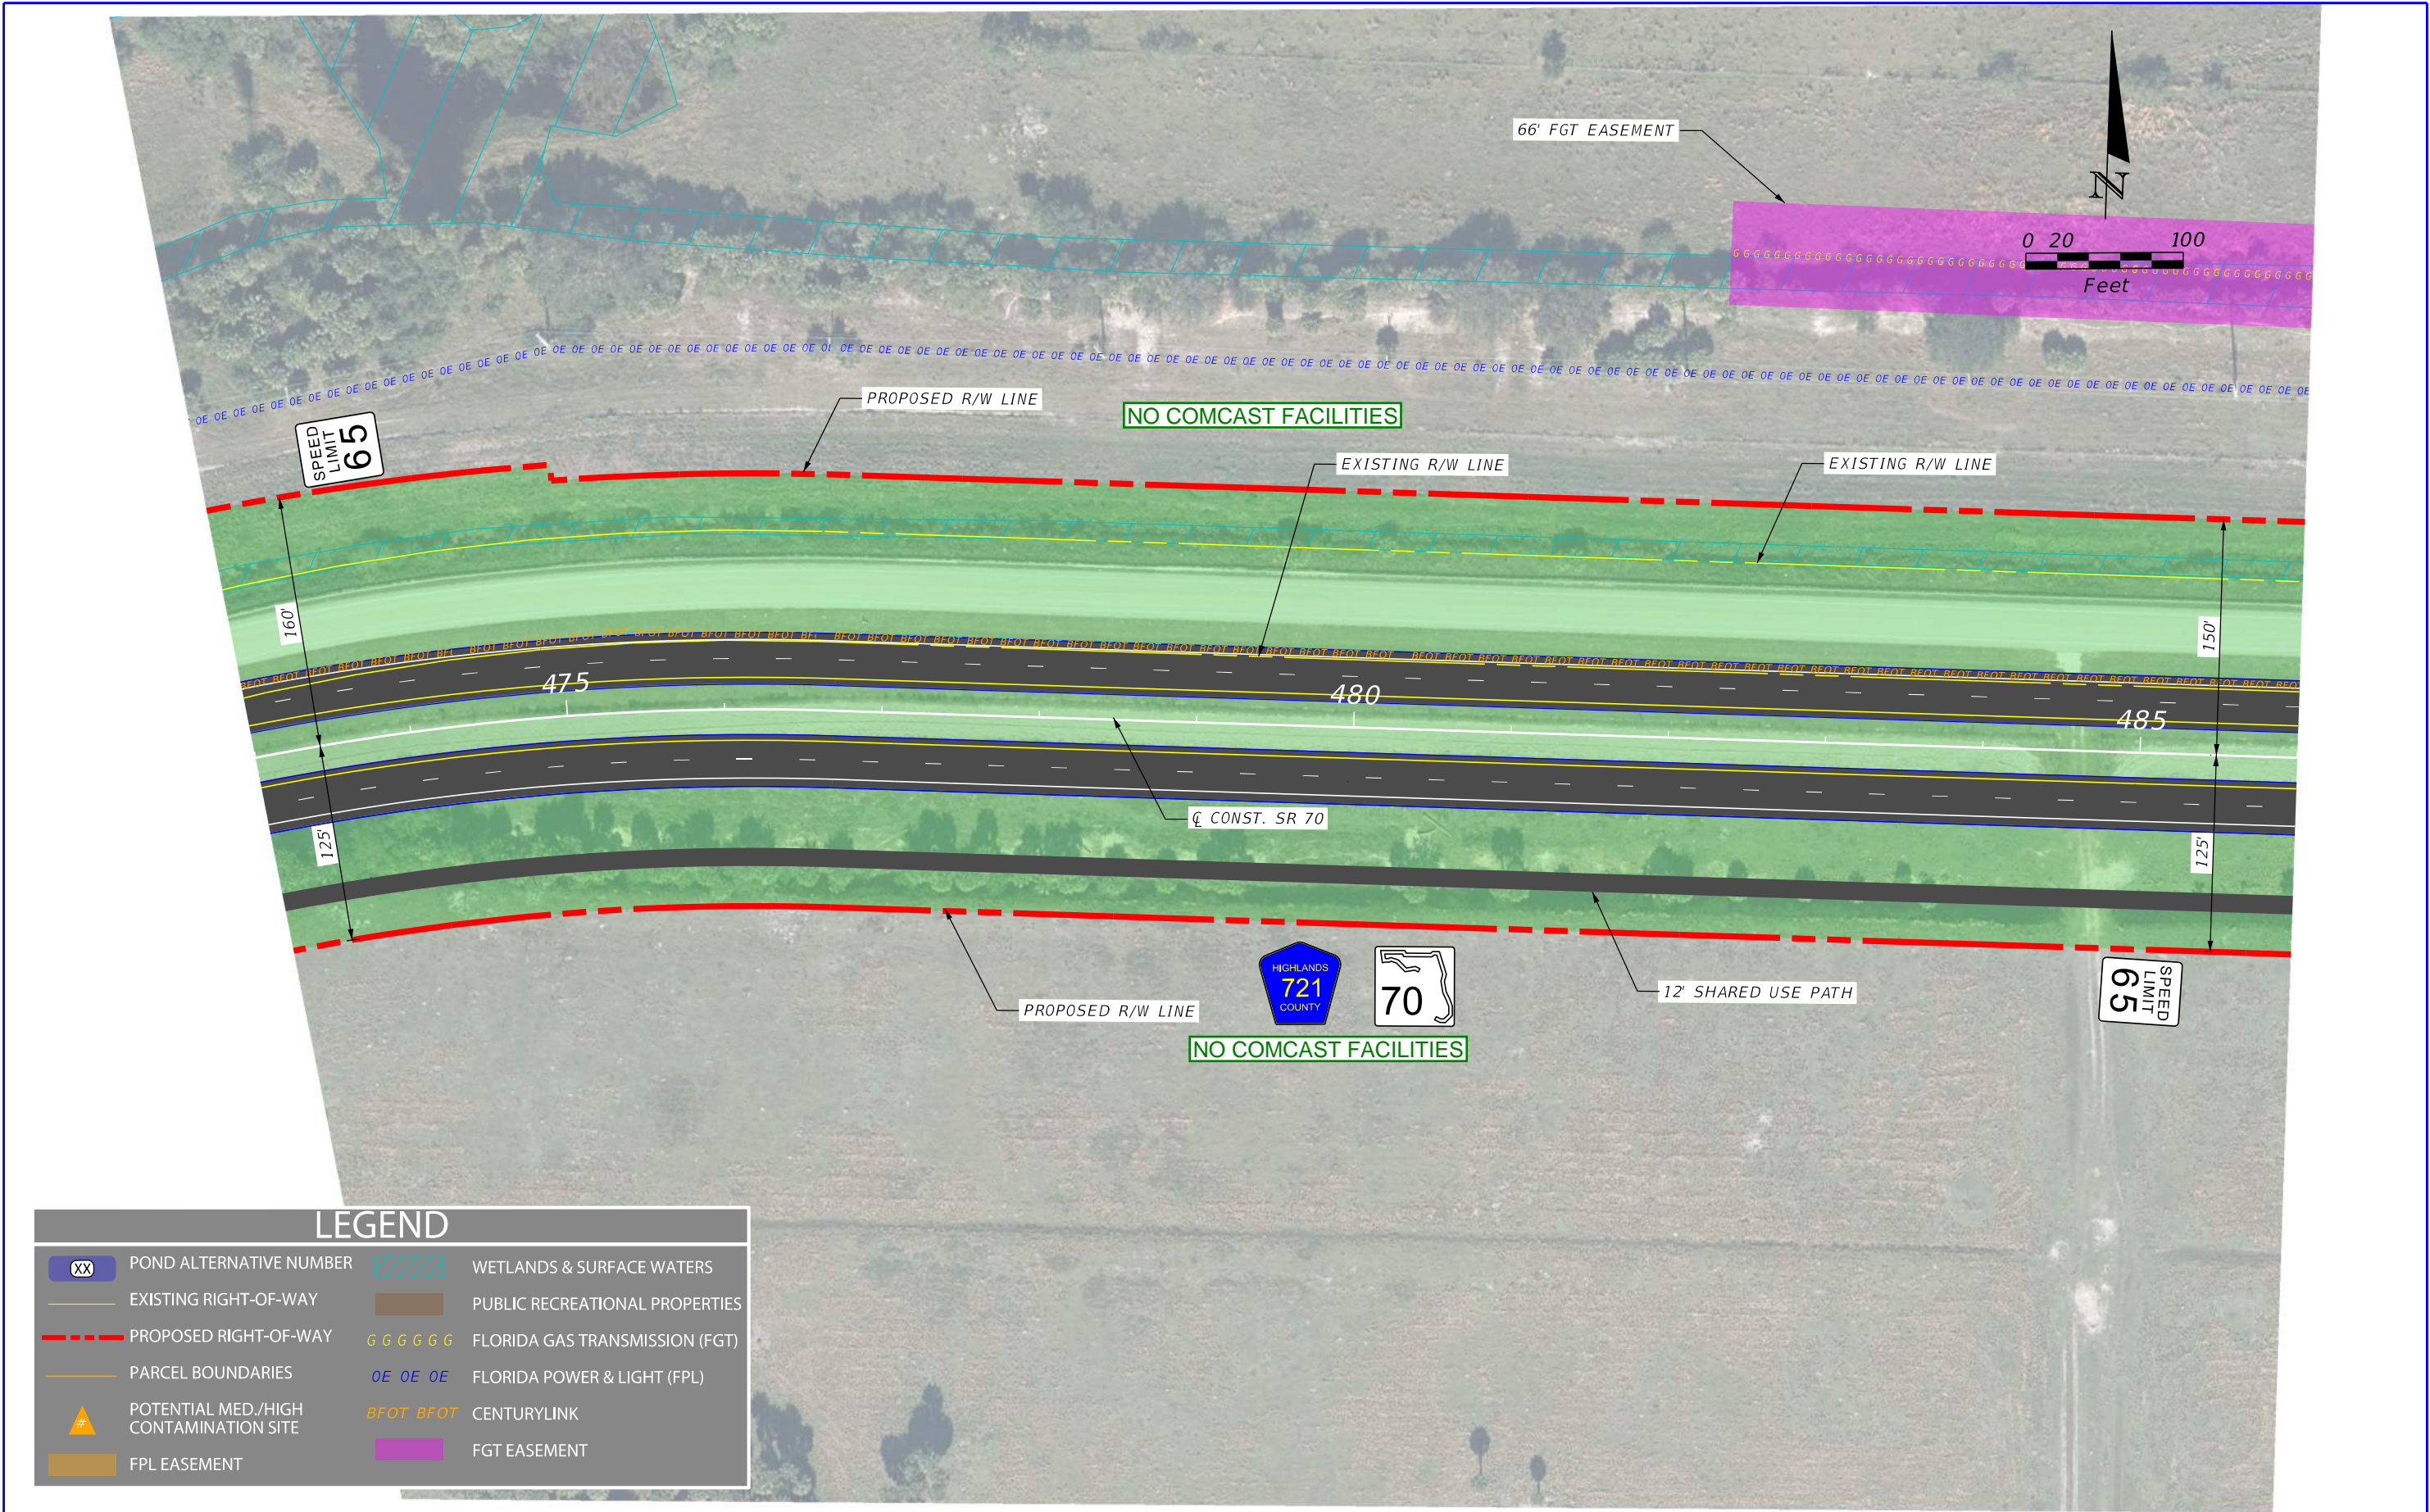

LEGEND

XX

POND ALTERNATIVE NUMBER

EXISTING RIGHT-OF-WAY

PROPOSED RIGHT-OF-WAY

PARCEL BOUNDARIES

POTENTIAL MED./HIGH CONTAMINATION SITE

FPL EASEMENT

WETLANDS & SURFACE WATERS

PUBLIC RECREATIONAL PROPERTIES


FLORIDA GAS TRANSMISSION (FGT)

FLORIDA POWER & LIGHT (FPL)

CENTURYLINK

FGT EASEMENT

REVISIONS				ENGINEER OF RECORD		STATE OF FLORIDA DEPARTMENT OF TRANSPORTATION		ALTERNATIVE 1 CONCEPT PLAN	SHEET NO. 7
DATE	DESCRIPTION	DATE	DESCRIPTION	NICHOLAS JOHN CLAVELO LICENSE NUMBER: 84366 SCALAR CONSULTING GROUP INC. 5713 CORPORATE WAY, SUITE 200 WEST PALM BEACH, FLORIDA 33407		ROAD NO.	COUNTY		
						SR 70	HIGHLANDS OKEECHOBEE	FINANCIAL PROJECT ID 450334-1-22-01	

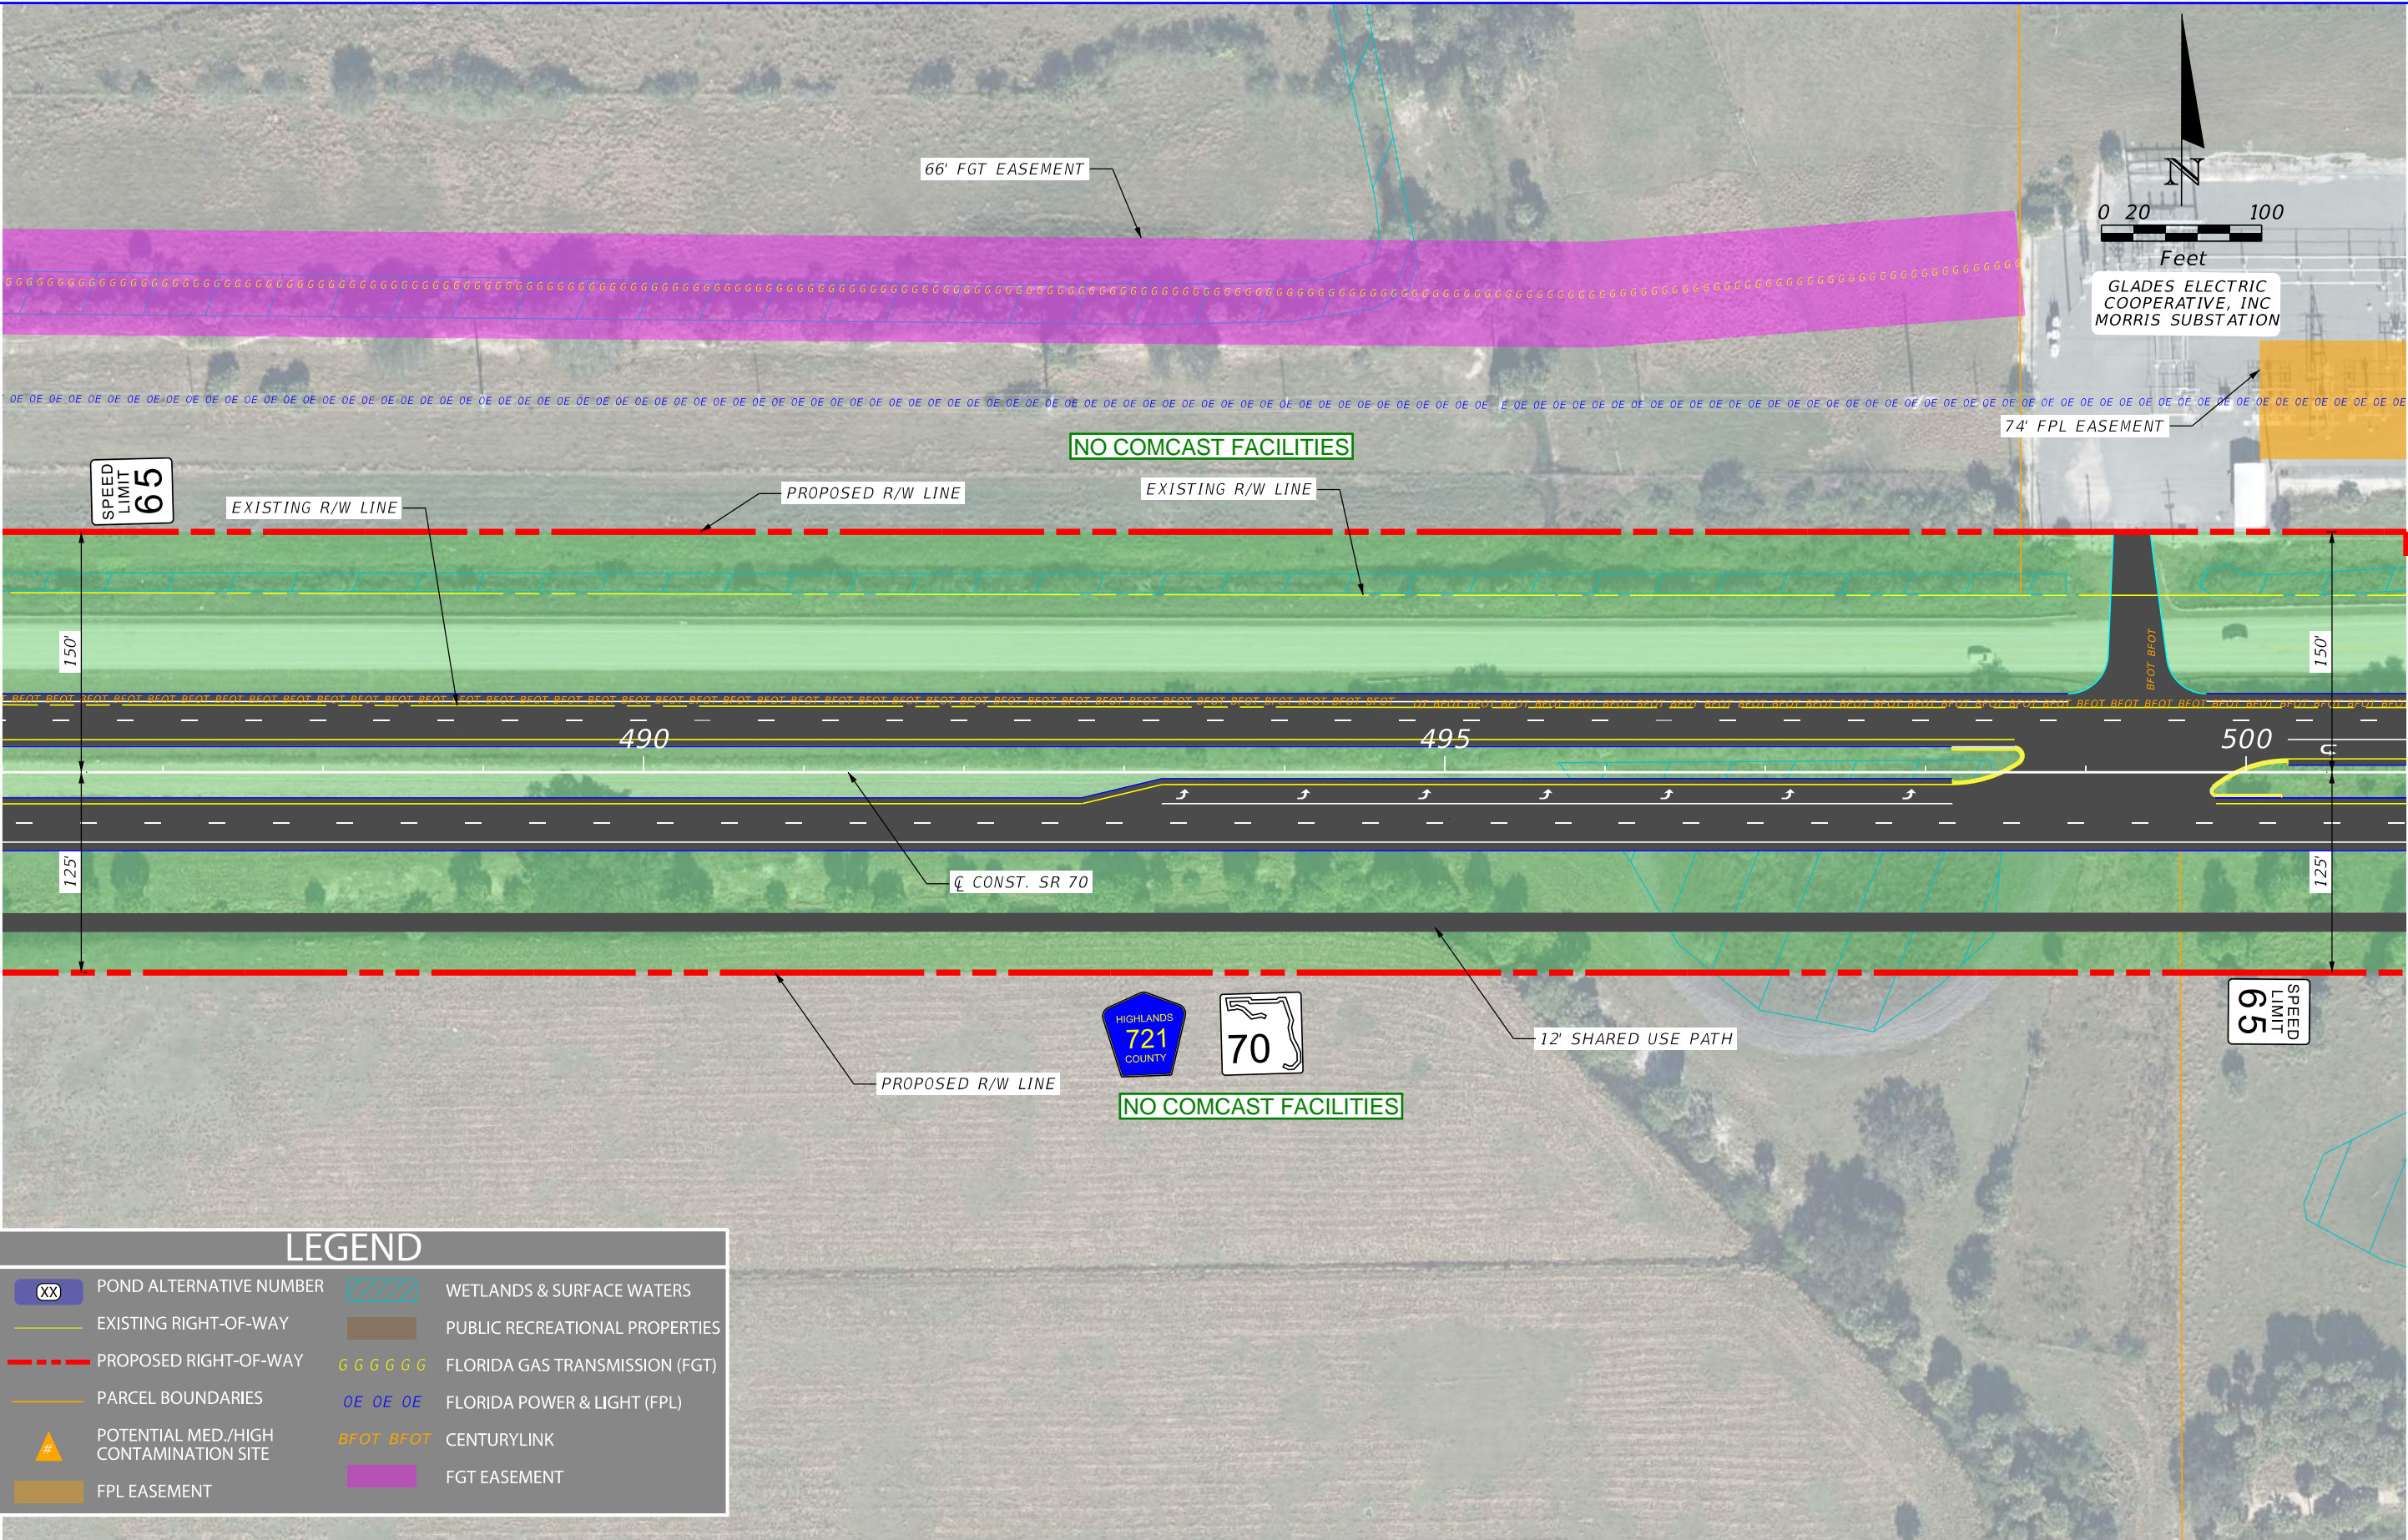

LEGEND

XX

POND ALTERNATIVE NUMBER

EXISTING RIGHT-OF-WAY

PROPOSED RIGHT-OF-WAY

PARCEL BOUNDARIES

POTENTIAL MED/HIGH CONTAMINATION SITE

FPL EASEMENT

WETLANDS & SURFACE WATERS

PUBLIC RECREATIONAL PROPERTIES

FLORIDA GAS TRANSMISSION (FGT)

FLORIDA POWER & LIGHT (FPL)


CENTURYLINK

FGT EASEMENT


REVISIONS				ENGINEER OF RECORD			STATE OF FLORIDA DEPARTMENT OF TRANSPORTATION			SHEET NO.
DATE	DESCRIPTION	DATE	DESCRIPTION	NICHOLAS JOHN CLAVELO LICENSE NUMBER: 84366 SCALAR CONSULTING GROUP INC. 5713 CORPORATE WAY, SUITE 200 WEST PALM BEACH, FLORIDA 33407			ROAD NO.	COUNTY	FINANCIAL PROJECT ID	
							SR 70	HIGHLANDS OKEECHOBEE	450334-1-22-01	

ALTERNATIVE 1
CONCEPT PLAN

8

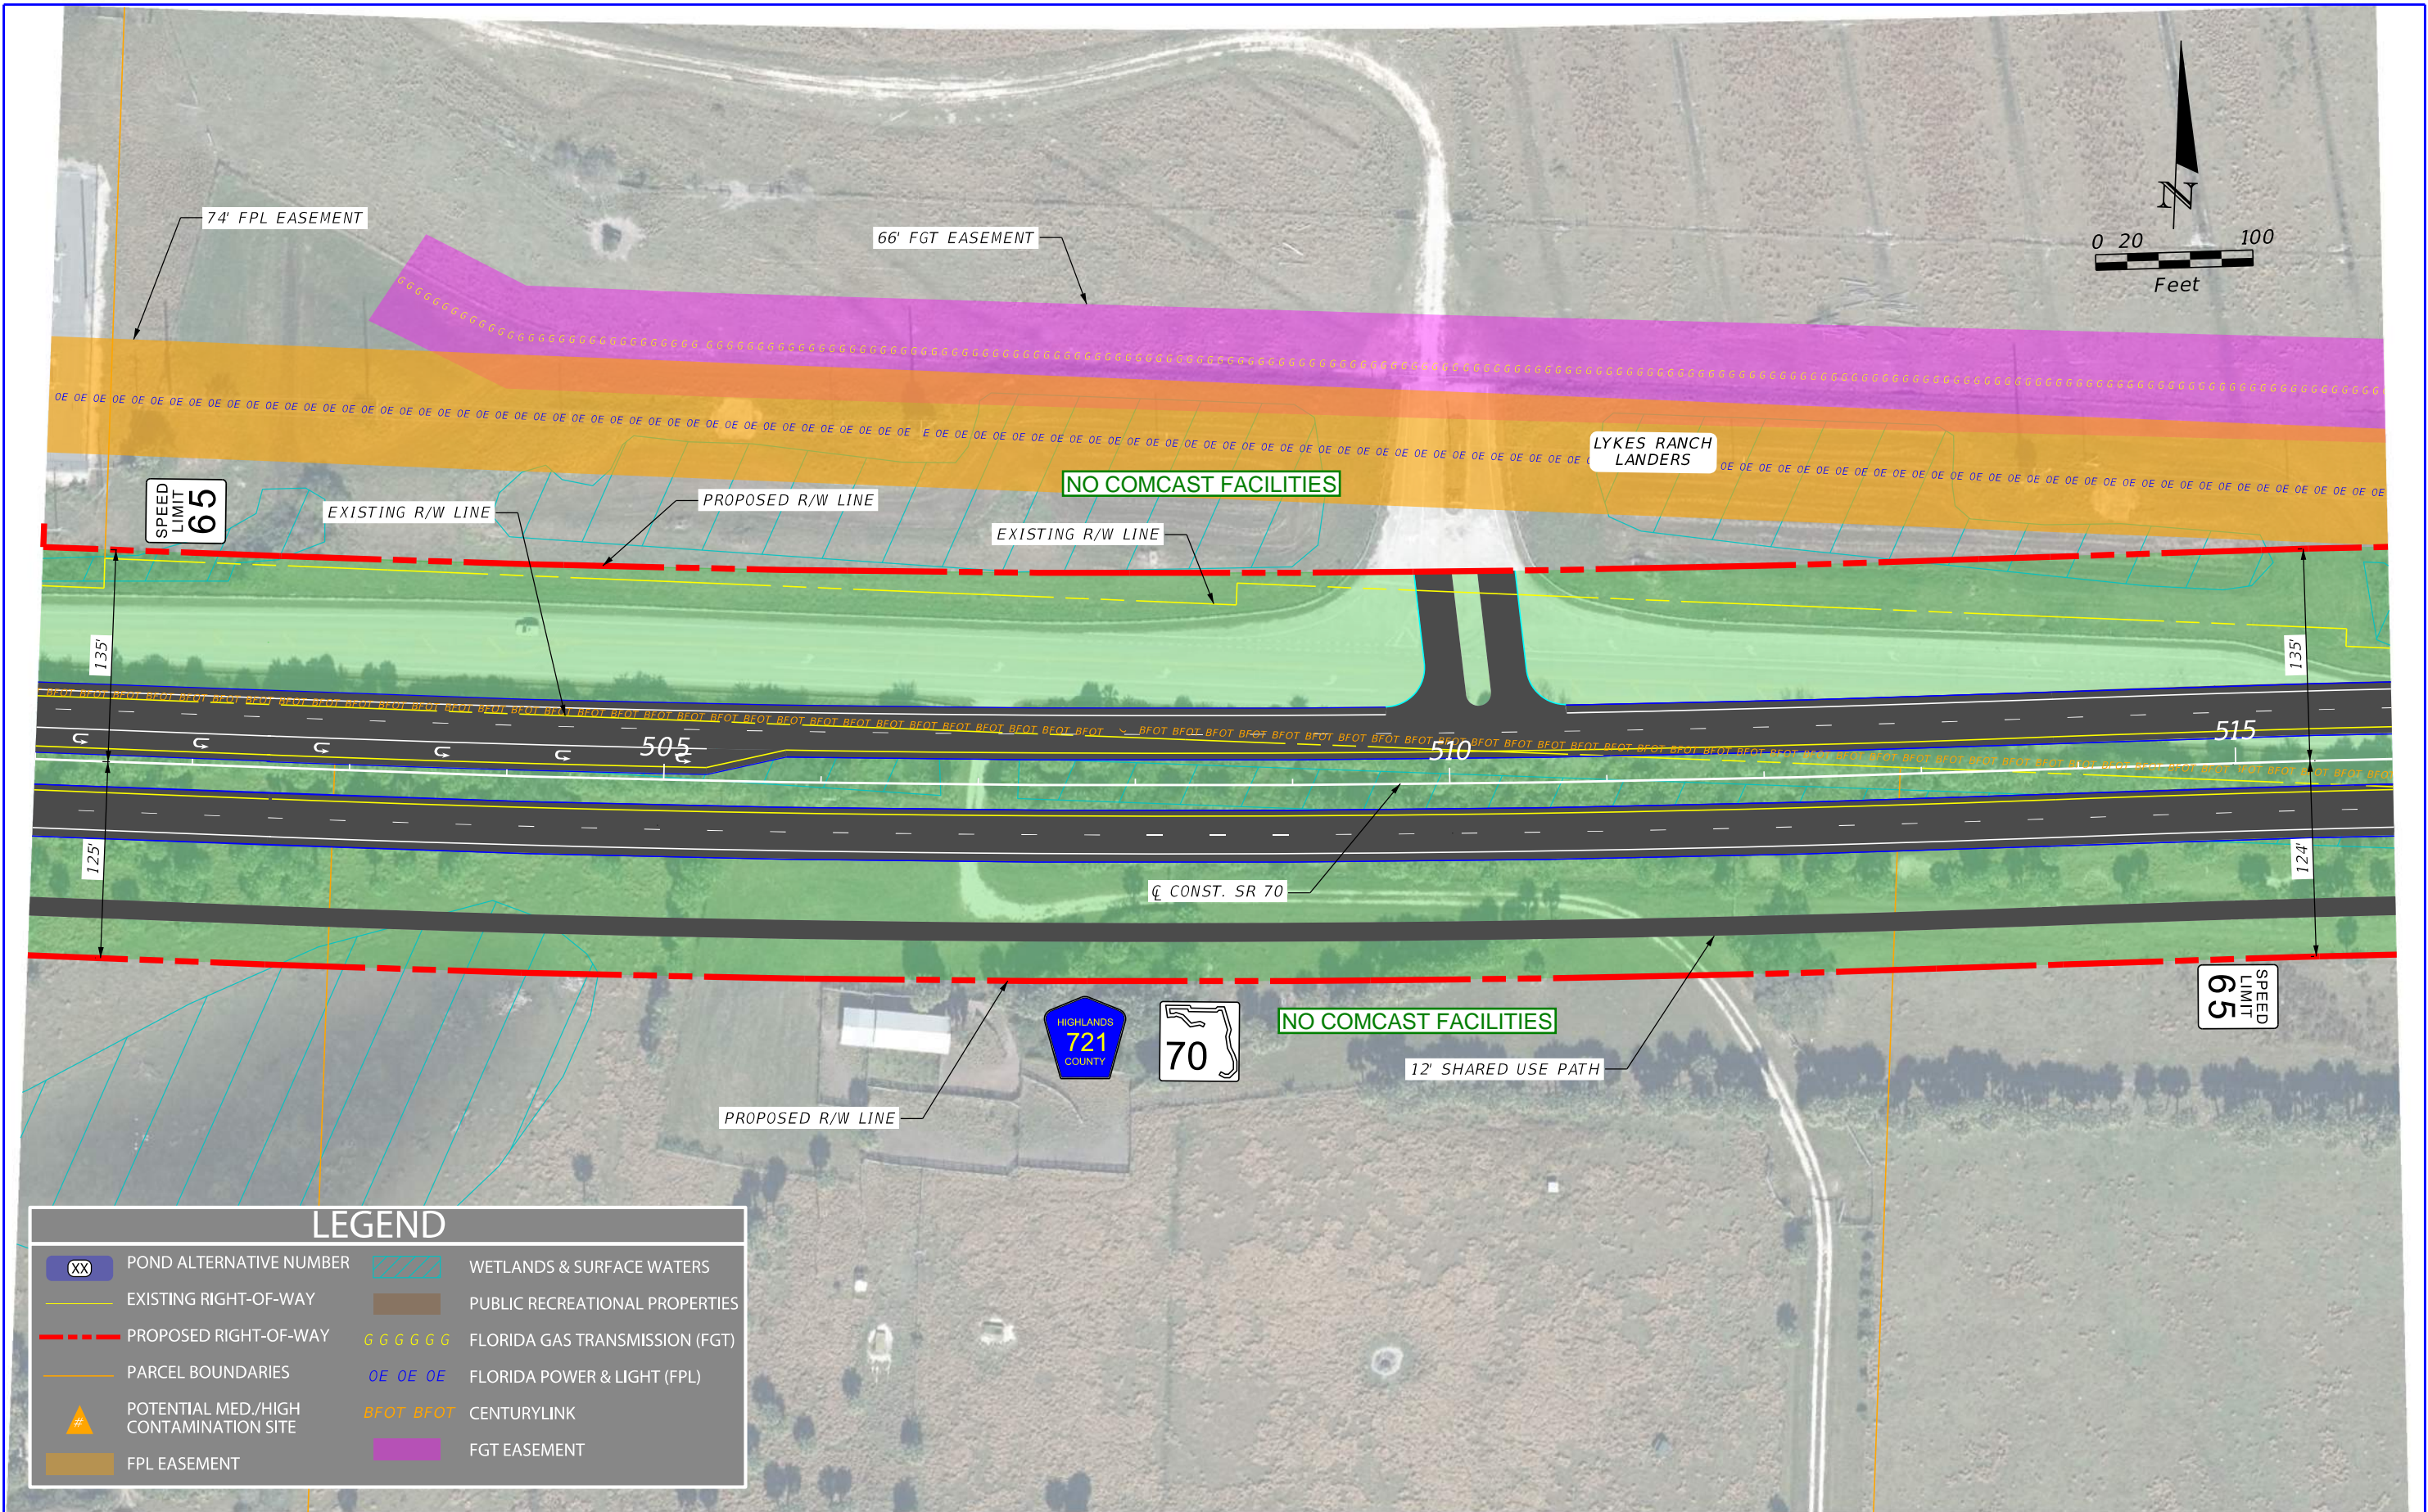

REVISIONS				ENGINEER OF RECORD		STATE OF FLORIDA DEPARTMENT OF TRANSPORTATION		ALTERNATIVE 1 CONCEPT PLAN	SHEET NO.
DATE	DESCRIPTION	DATE	DESCRIPTION	NICHOLAS JOHN CLAVELO LICENSE NUMBER: 84366 SCALAR CONSULTING GROUP INC. 5713 CORPORATE WAY, SUITE 200 WEST PALM BEACH, FLORIDA 33407		ROAD NO.	COUNTY		
						SR 70	HIGHLANDS OKEECHOBEE	FINANCIAL PROJECT ID 450334-1-22-01	9

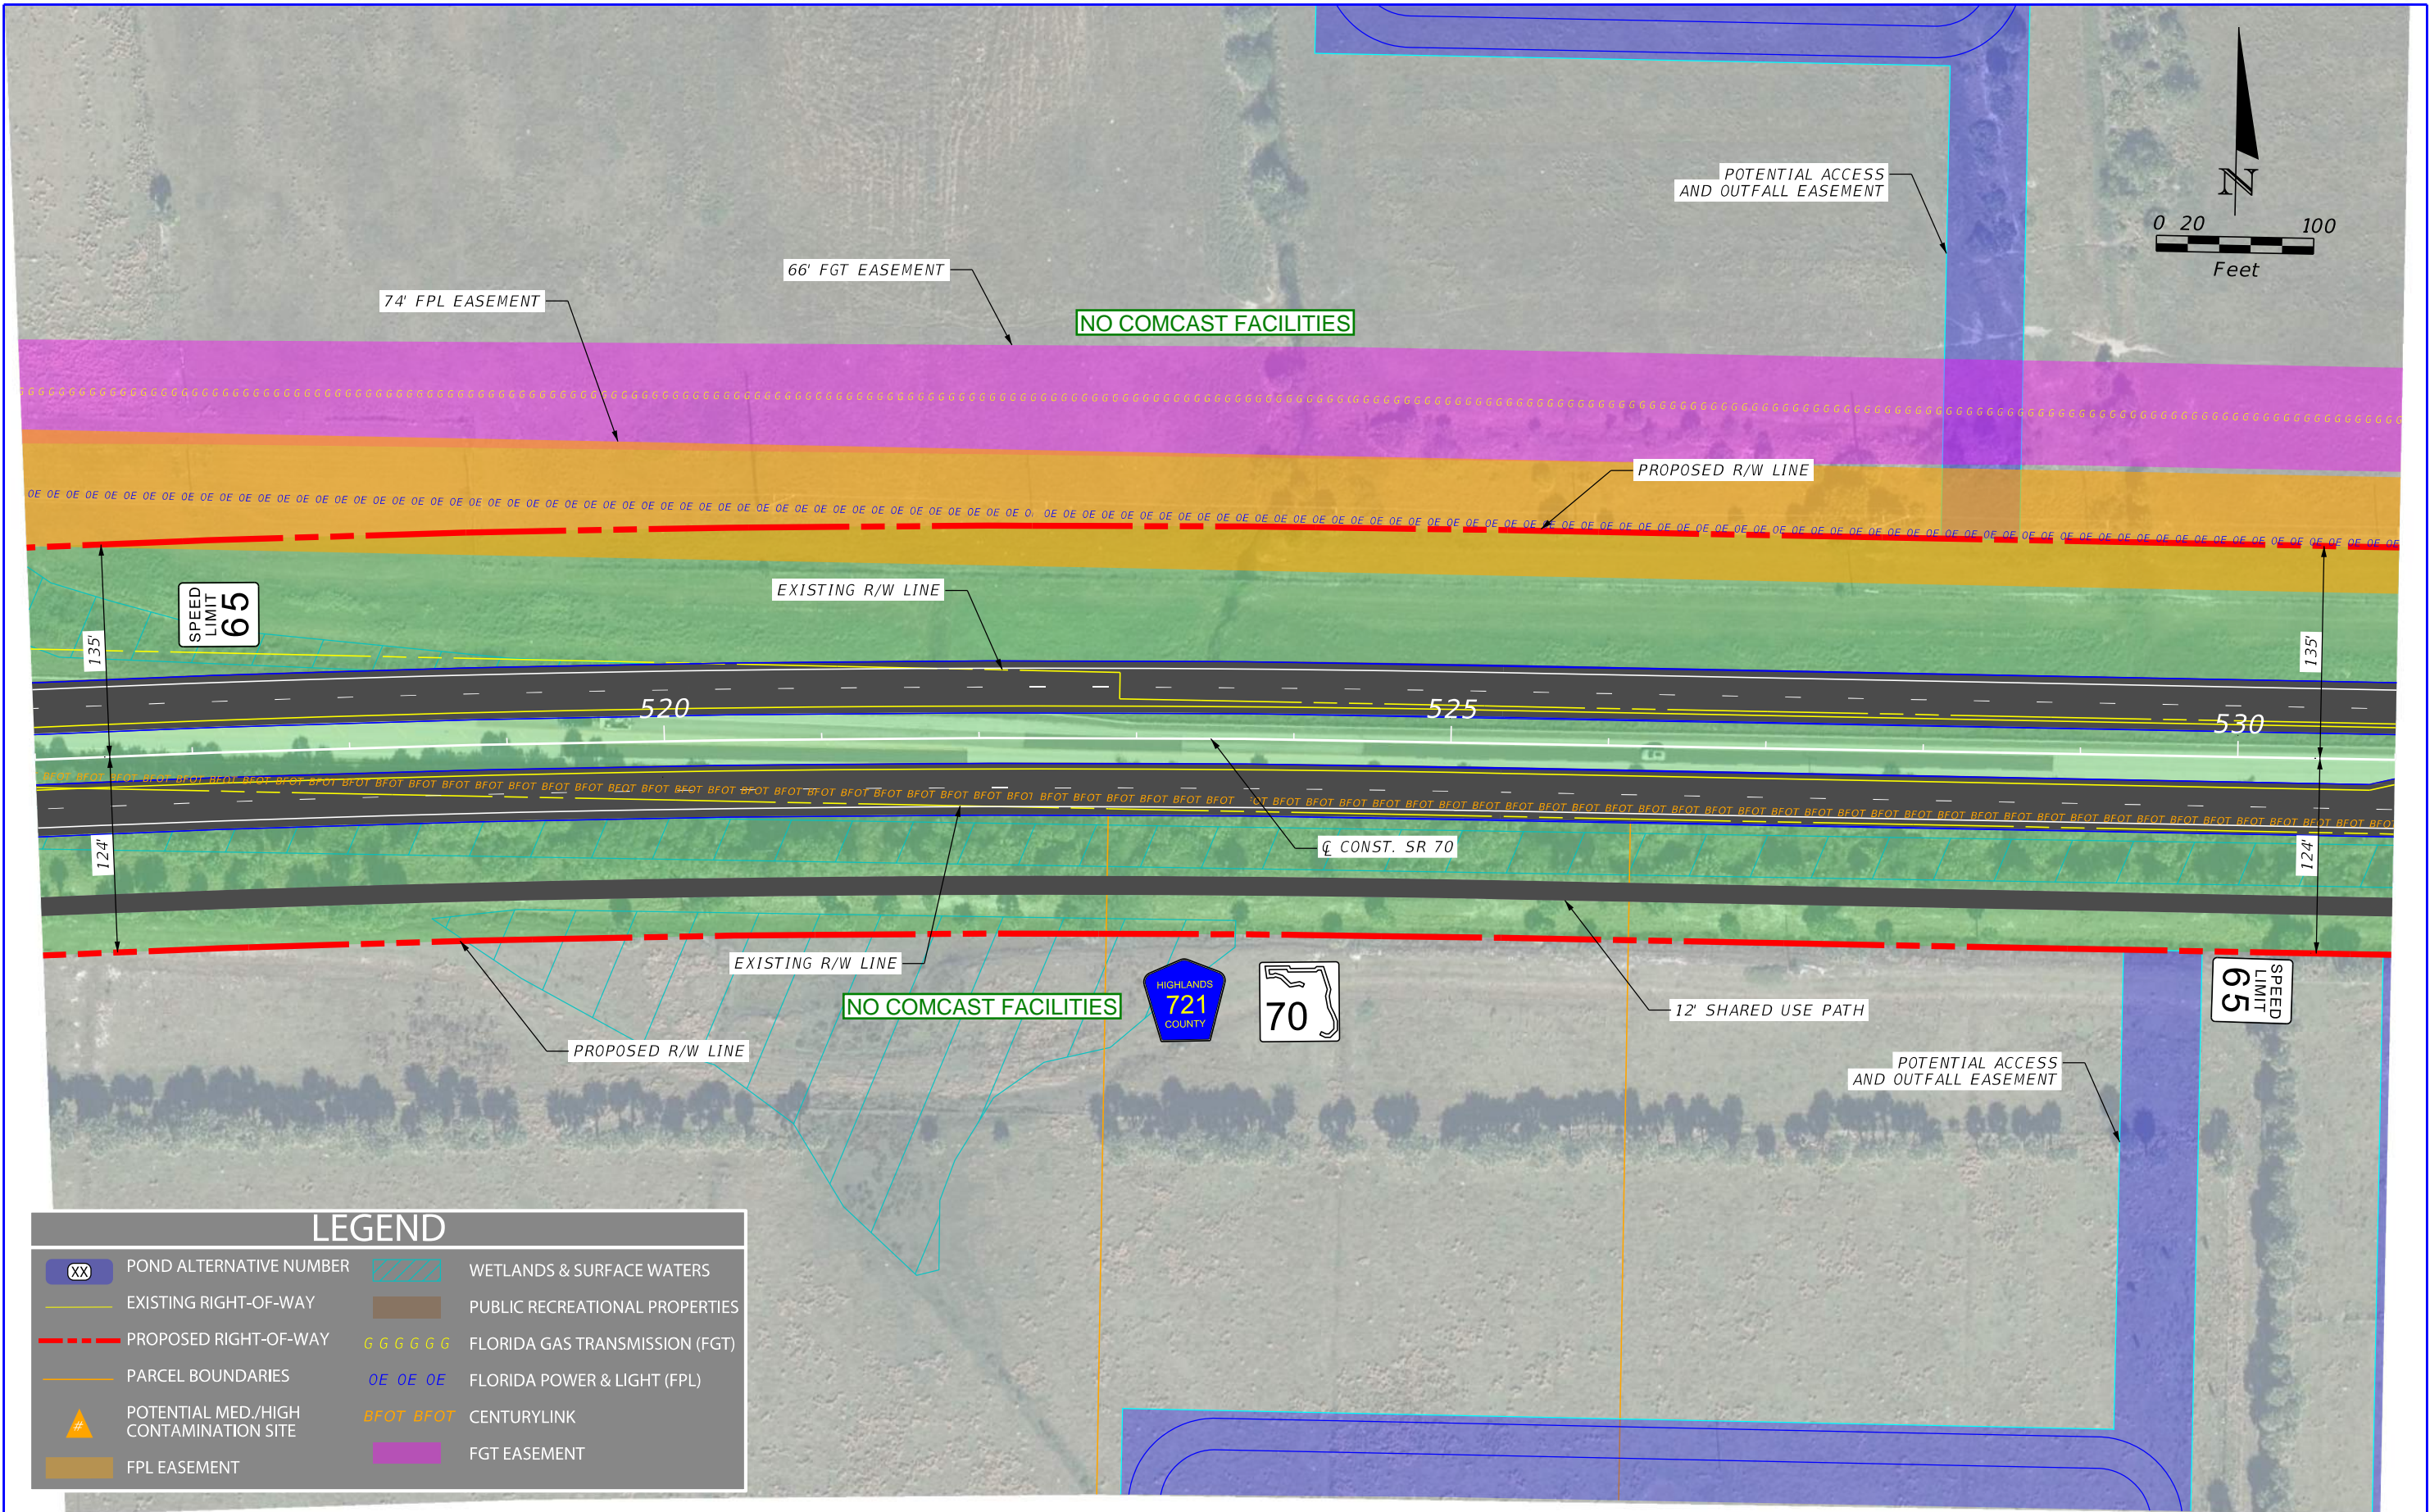

LEGEND

XX

POND ALTERNATIVE NUMBER

EXISTING RIGHT-OF-WAY

PROPOSED RIGHT-OF-WAY

PARCEL BOUNDARIES

POTENTIAL MED./HIGH CONTAMINATION SITE

FPL EASEMENT

WETLANDS & SURFACE WATERS

PUBLIC RECREATIONAL PROPERTIES

GGGGGG

FLORIDA GAS TRANSMISSION (FGT)

OE OE OE


FLORIDA POWER & LIGHT (FPL)

BFOT BFOT

CENTURYLINK

FGT EASEMENT

REVISIONS				ENGINEER OF RECORD			STATE OF FLORIDA DEPARTMENT OF TRANSPORTATION			ALTERNATIVE 1 CONCEPT PLAN	SHEET NO. 10
DATE	DESCRIPTION	DATE	DESCRIPTION	NICHOLAS JOHN CLAVELO LICENSE NUMBER: 84366 SCALAR CONSULTING GROUP INC. 5713 CORPORATE WAY, SUITE 200 WEST PALM BEACH, FLORIDA 33407			ROAD NO.	COUNTY	FINANCIAL PROJECT ID		
							SR 70	HIGHLANDS OKEECHOBEE	450334-1-22-01		

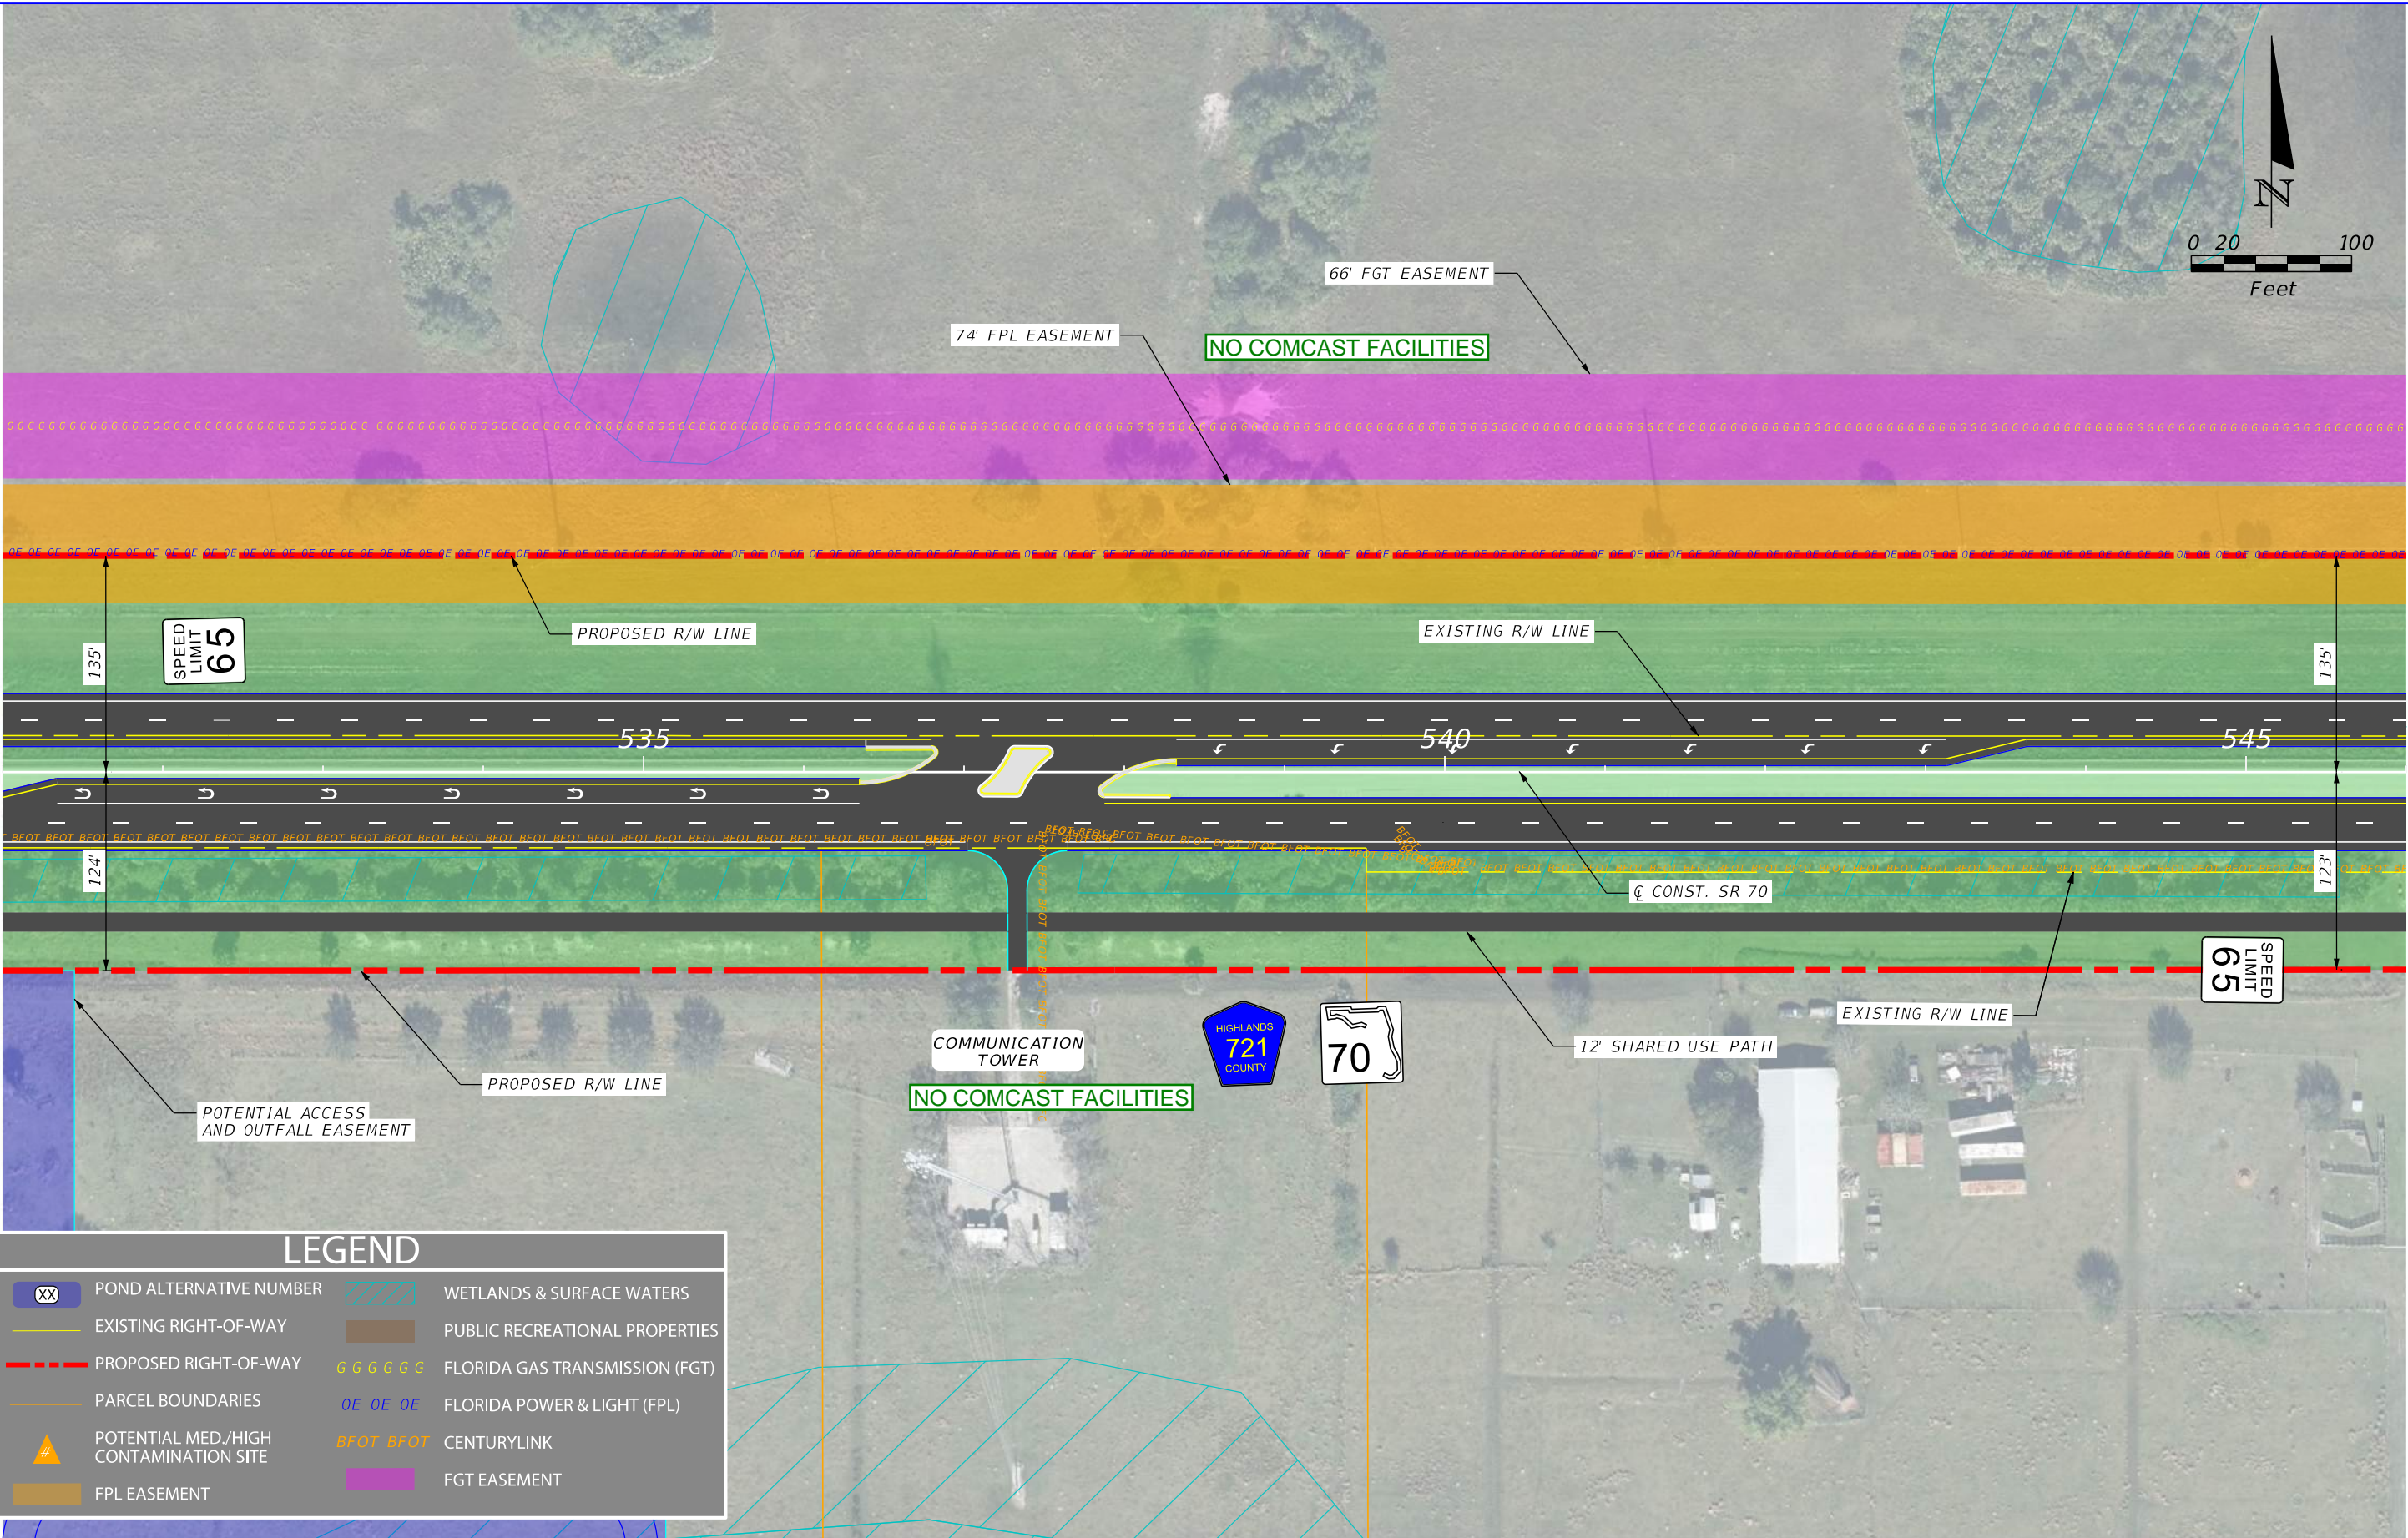

LEGEND

XX

POND ALTERNATIVE NUMBER

EXISTING RIGHT-OF-WAY

PROPOSED RIGHT-OF-WAY

PARCEL BOUNDARIES

#

POTENTIAL MED./HIGH CONTAMINATION SITE

FPL EASEMENT

WETLANDS & SURFACE WATERS

PUBLIC RECREATIONAL PROPERTIES

GGGGGG

FLORIDA GAS TRANSMISSION (FGT)

OE OE OE


FLORIDA POWER & LIGHT (FPL)

BFOT BFOT


CENTURYLINK

FGT EASEMENT


REVISIONS				ENGINEER OF RECORD		STATE OF FLORIDA DEPARTMENT OF TRANSPORTATION			SHEET NO. 11
DATE	DESCRIPTION	DATE	DESCRIPTION	NICHOLAS JOHN CLAVELO LICENSE NUMBER: 84366 SCALAR CONSULTING GROUP INC. 5713 CORPORATE WAY, SUITE 200 WEST PALM BEACH, FLORIDA 33407		ROAD NO.	COUNTY	FINANCIAL PROJECT ID	
						SR 70	HIGHLANDS OKEECHOBEE	450334-1-22-01	

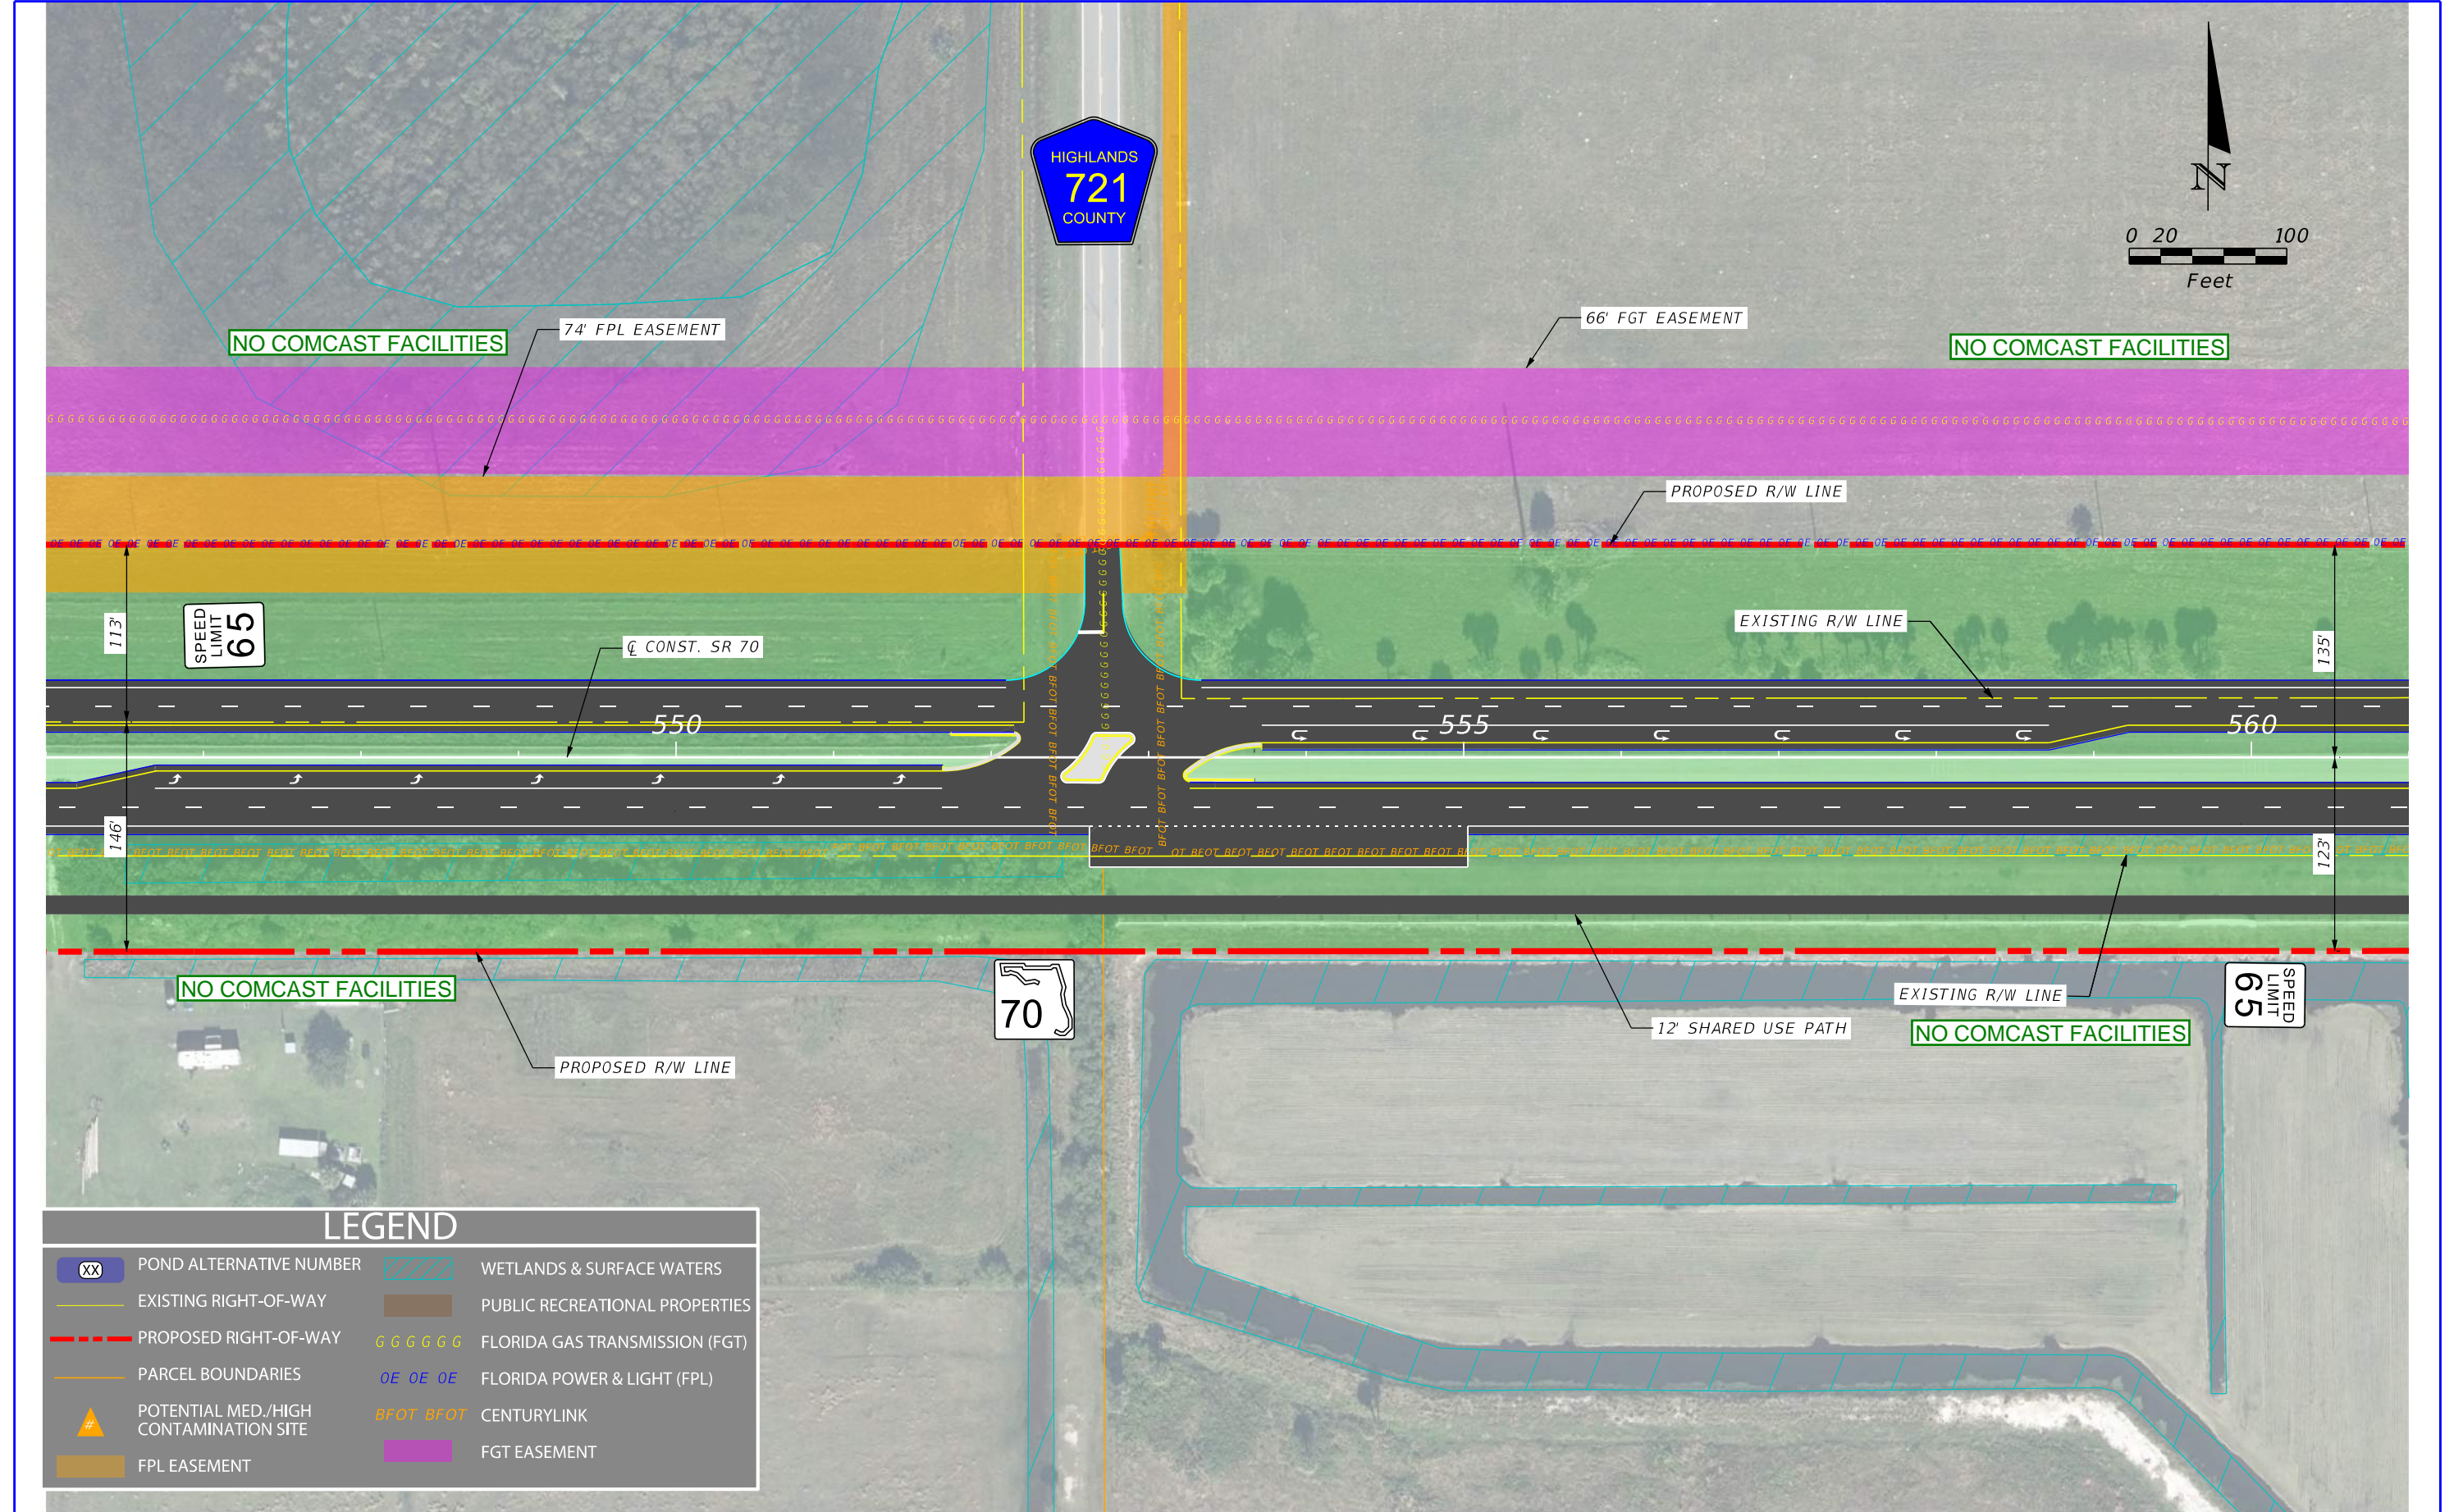

REVISIONS				ENGINEER OF RECORD		STATE OF FLORIDA DEPARTMENT OF TRANSPORTATION		ALTERNATIVE 1 CONCEPT PLAN	SHEET NO.
DATE	DESCRIPTION	DATE	DESCRIPTION	NICHOLAS JOHN CLAVELO LICENSE NUMBER: 84366 SCALAR CONSULTING GROUP INC. 5713 CORPORATE WAY, SUITE 200 WEST PALM BEACH, FLORIDA 33407		ROAD NO.	COUNTY		
						SR 70	HIGHLANDS OKEECHOBEE	FINANCIAL PROJECT ID 450334-1-22-01	12

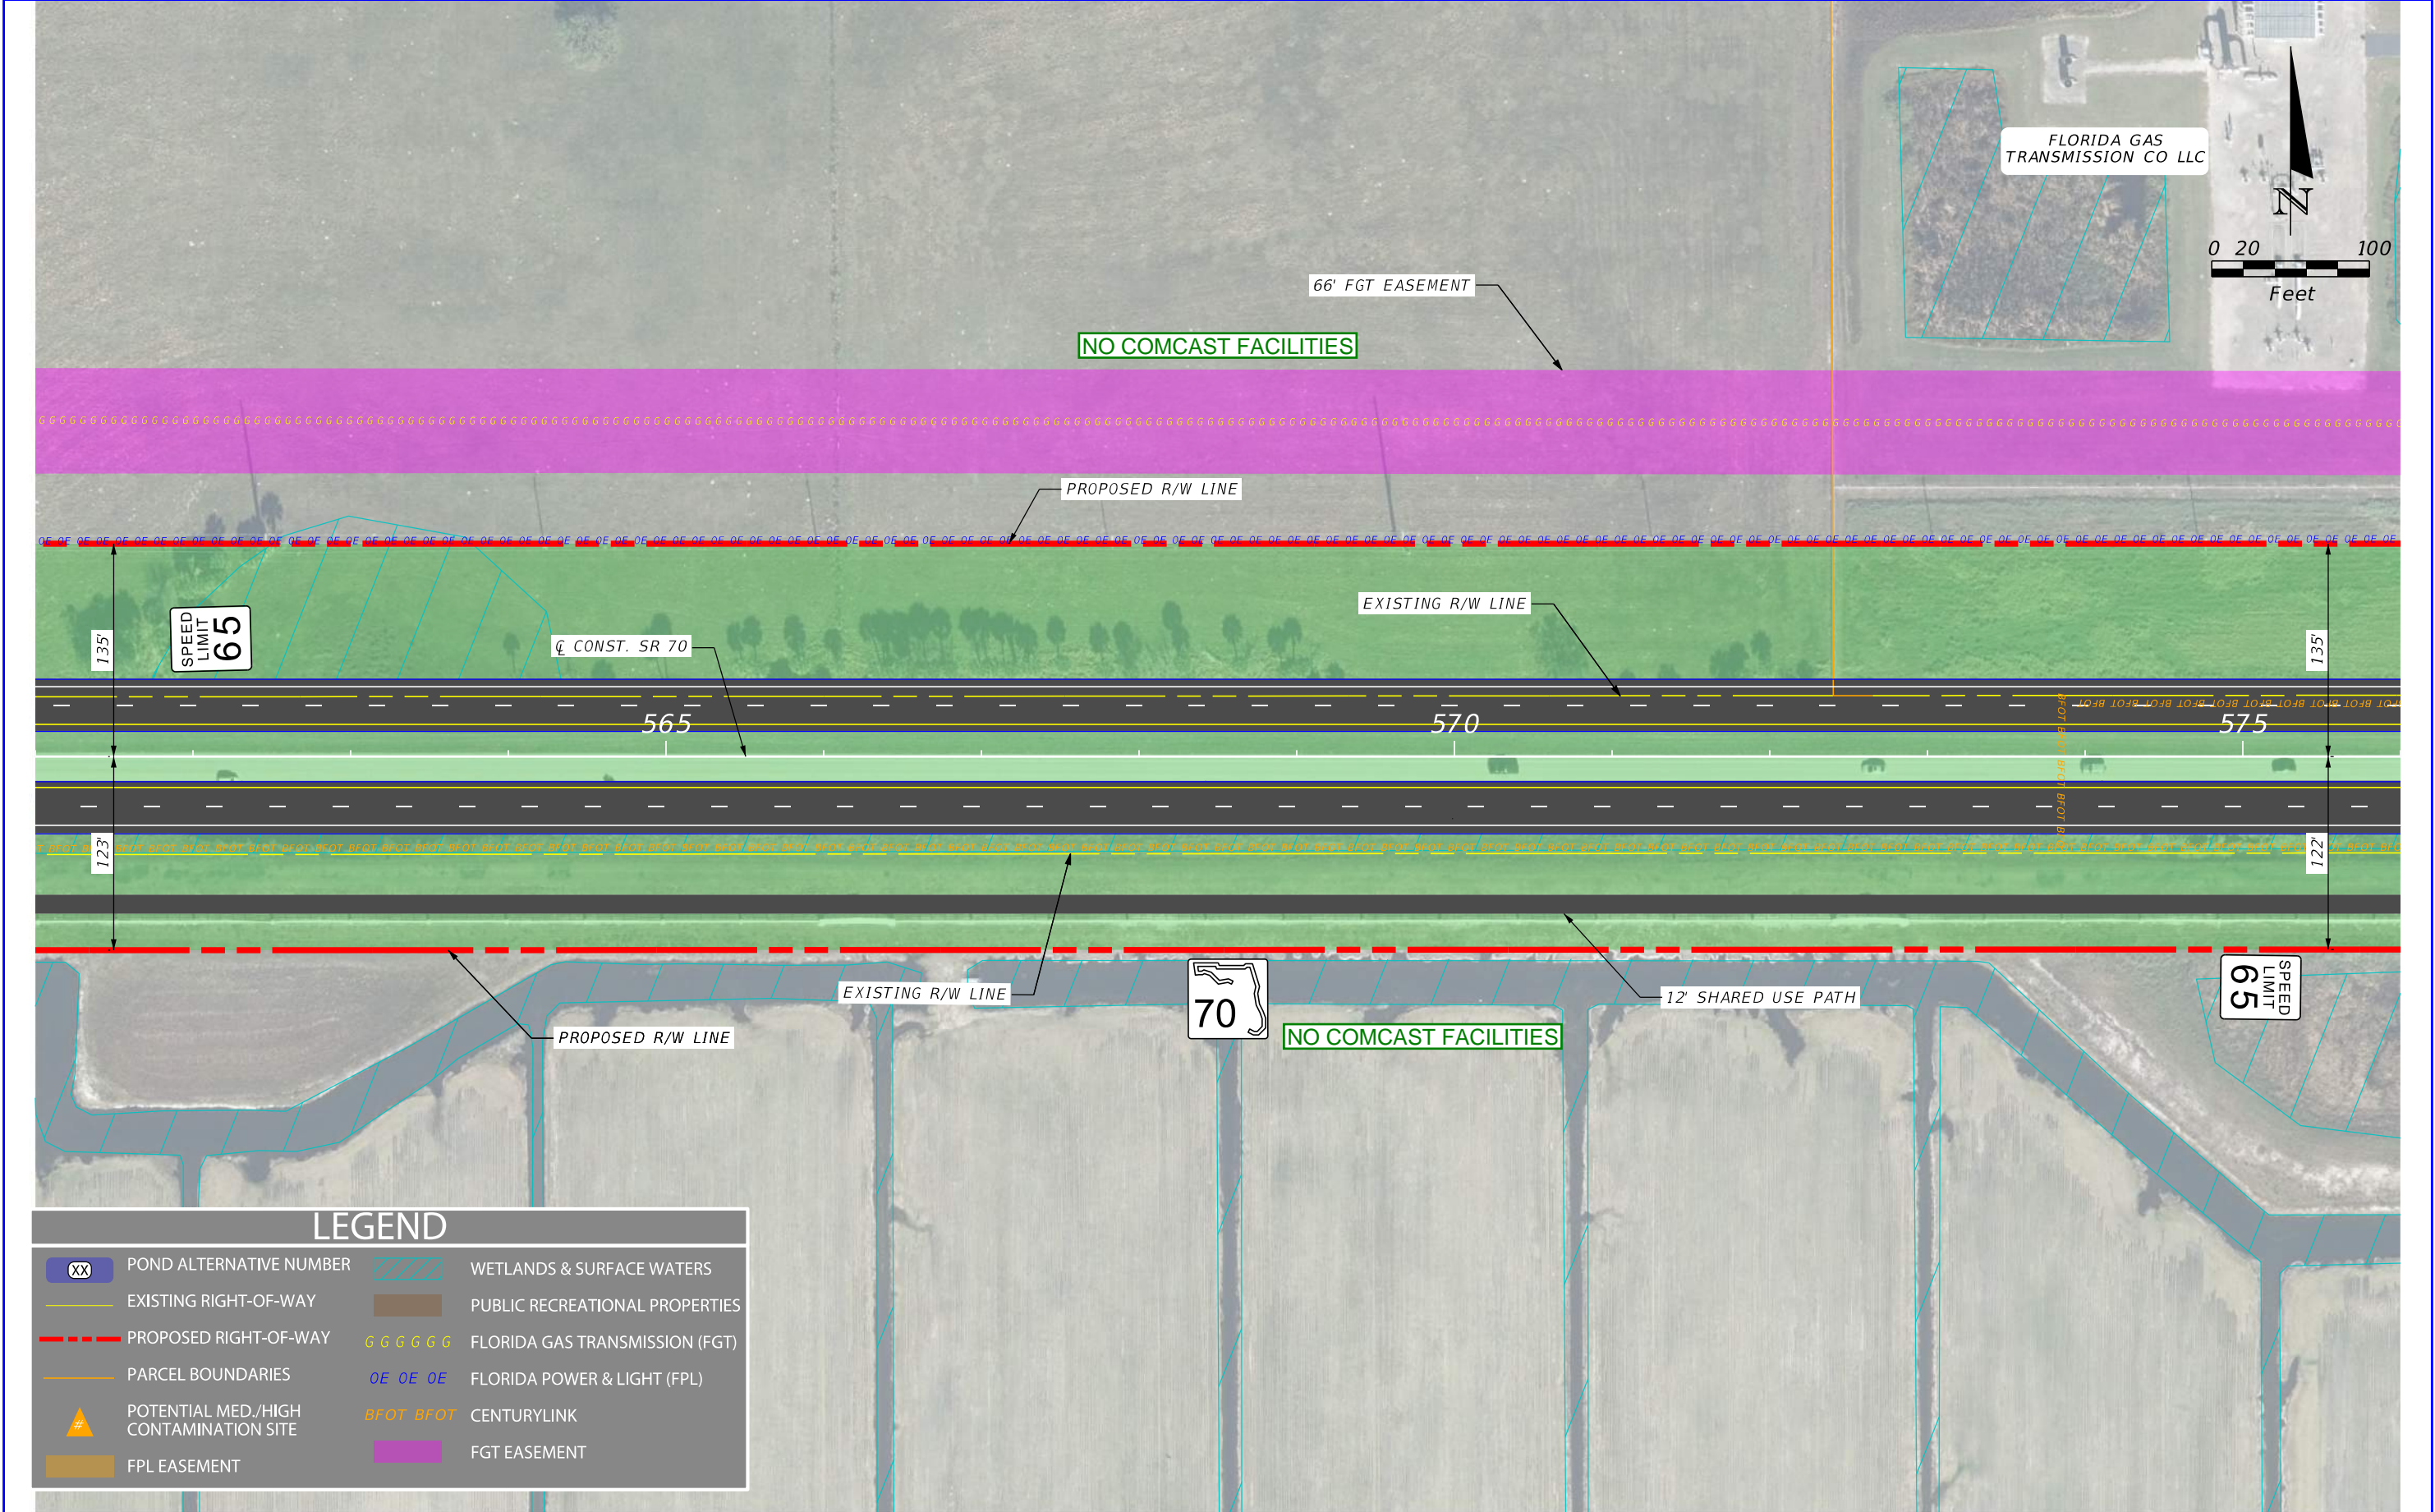

REVISIONS				ENGINEER OF RECORD		STATE OF FLORIDA DEPARTMENT OF TRANSPORTATION		ALTERNATIVE 1 CONCEPT PLAN	SHEET NO. 13
DATE	DESCRIPTION	DATE	DESCRIPTION	NICHOLAS JOHN CLAVELO LICENSE NUMBER: 84366 SCALAR CONSULTING GROUP INC. 5713 CORPORATE WAY, SUITE 200 WEST PALM BEACH, FLORIDA 33407		ROAD NO.	COUNTY		
						SR 70	HIGHLANDS OKEECHOBEE	FINANCIAL PROJECT ID 450334-1-22-01	

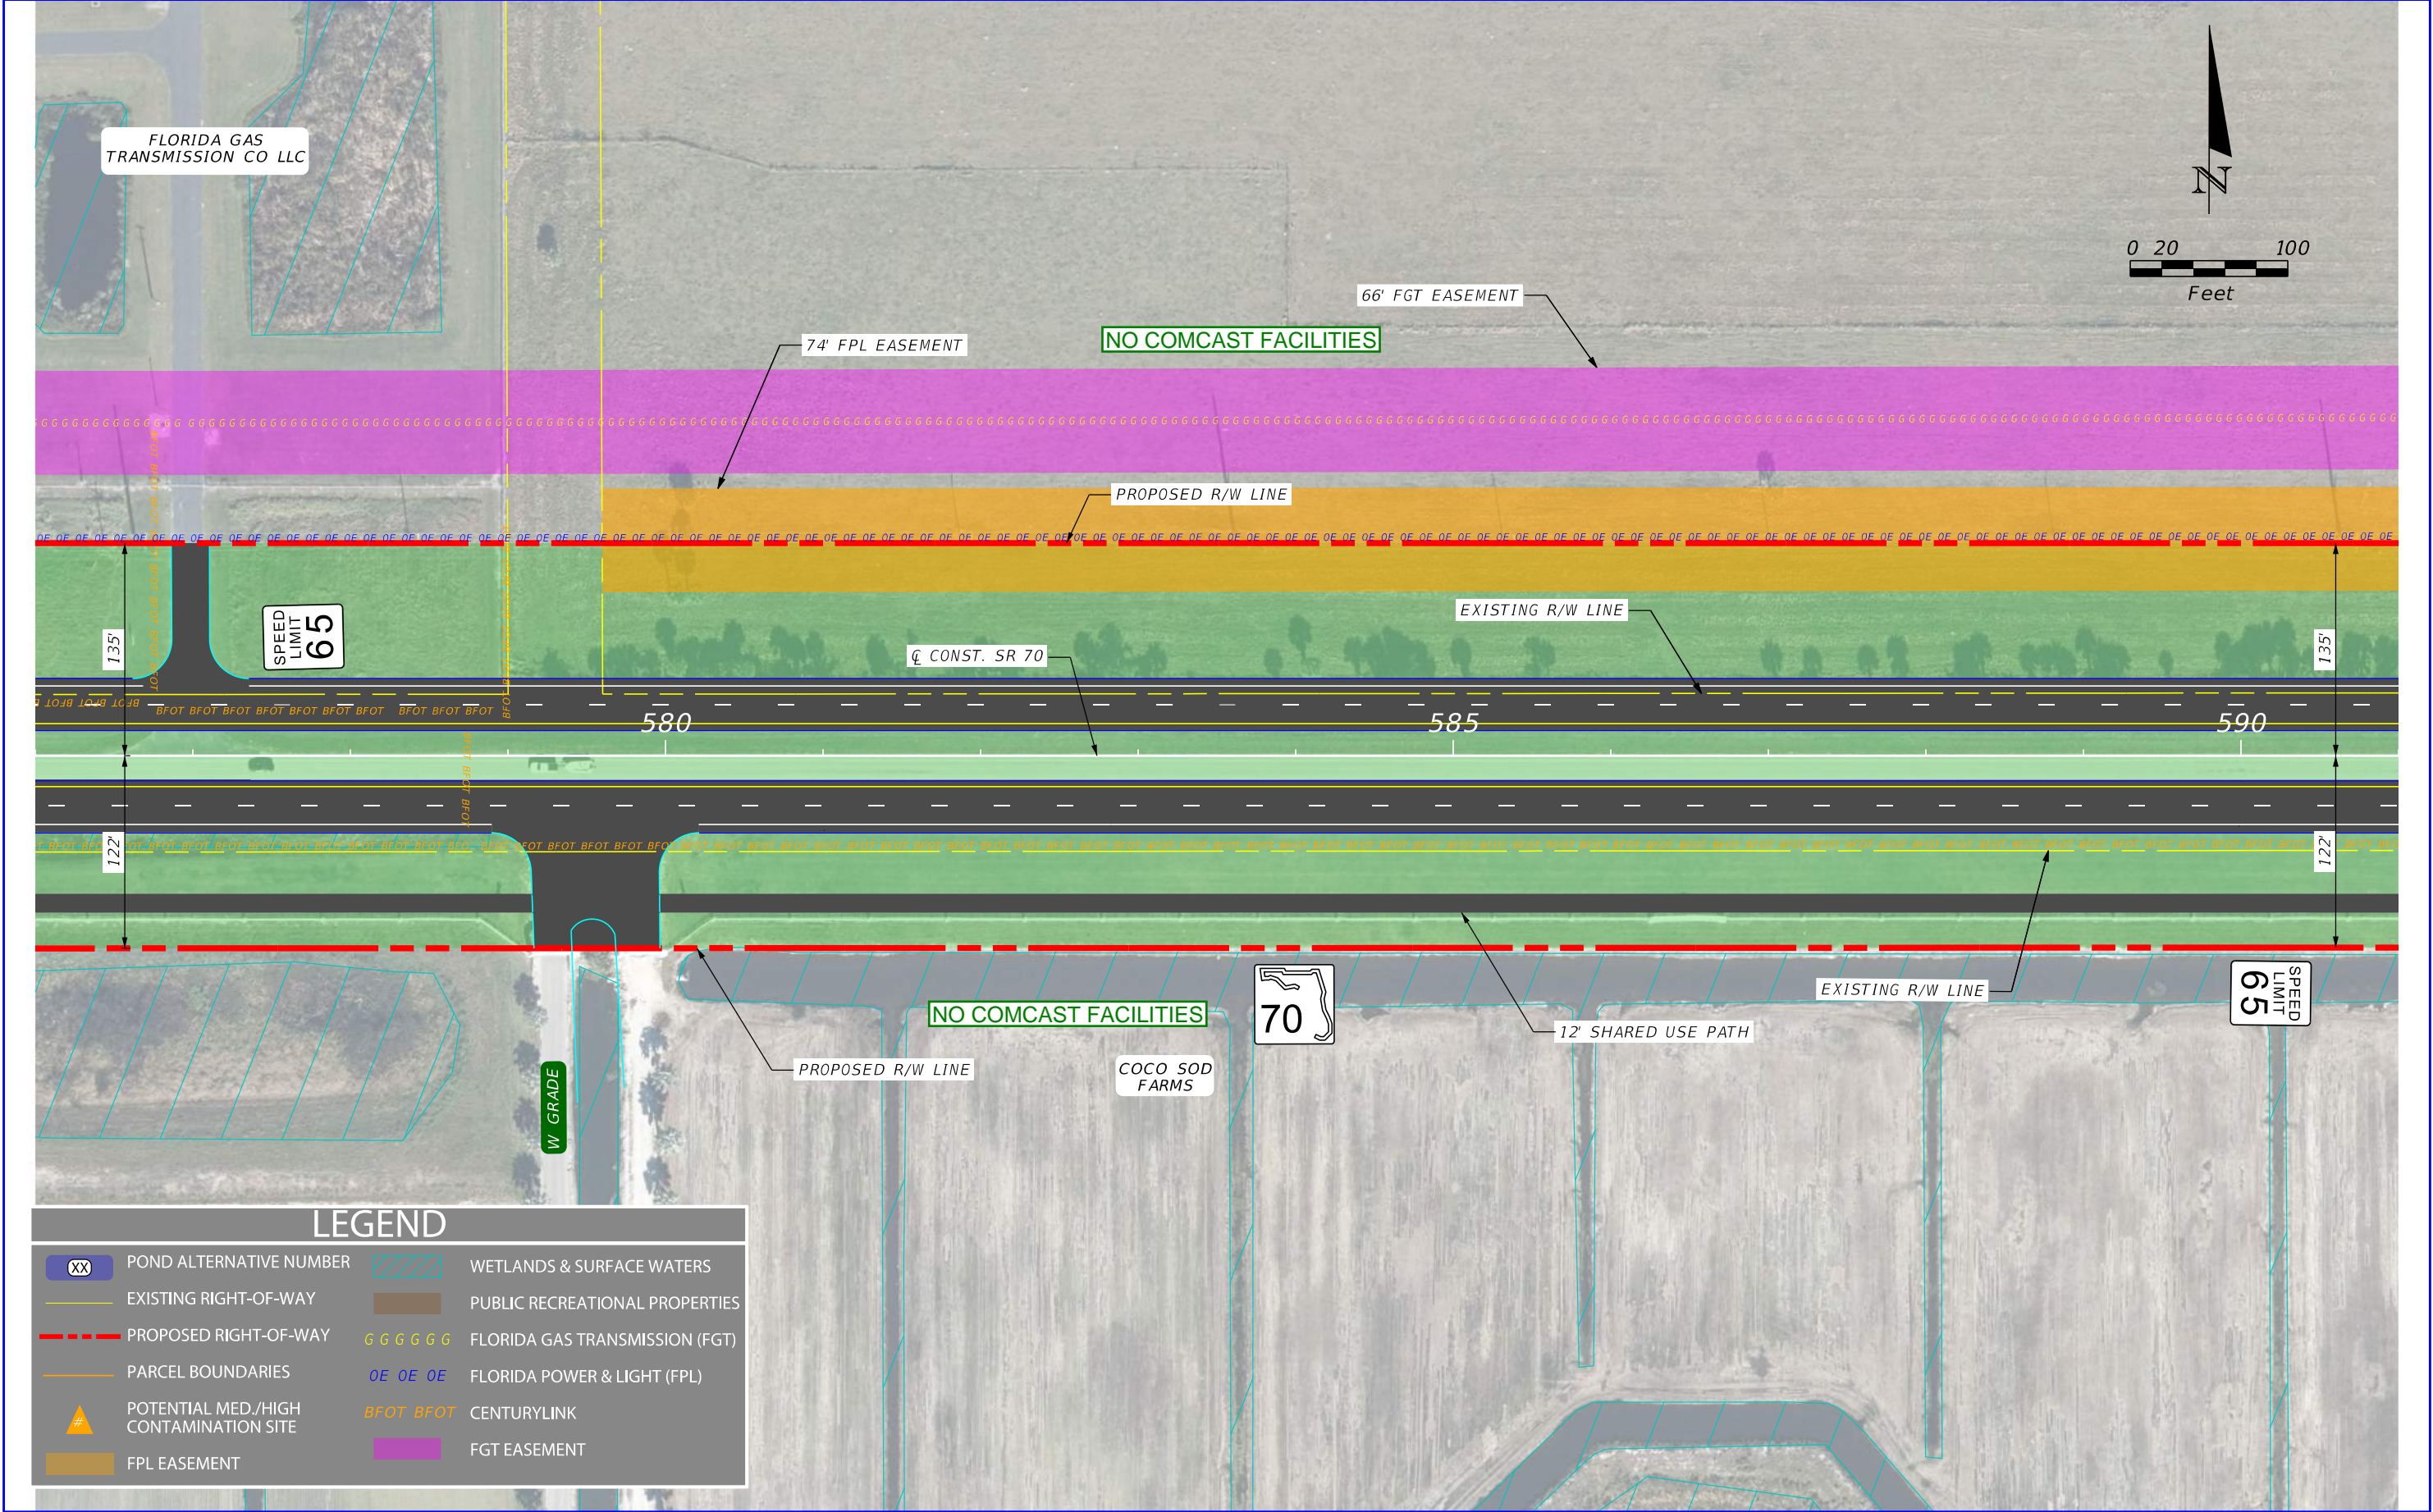

LEGEND

XX

POND ALTERNATIVE NUMBER

EXISTING RIGHT-OF-WAY

PROPOSED RIGHT-OF-WAY

PARCEL BOUNDARIES

POTENTIAL MED./HIGH CONTAMINATION SITE

FPL EASEMENT

WETLANDS & SURFACE WATERS

PUBLIC RECREATIONAL PROPERTIES

GGGGGG

FLORIDA GAS TRANSMISSION (FGT)

OE OE OE


FLORIDA POWER & LIGHT (FPL)

BFOT BFOT


CENTURYLINK

FGT EASEMENT

REVISIONS				ENGINEER OF RECORD		STATE OF FLORIDA DEPARTMENT OF TRANSPORTATION		ALTERNATIVE 1 CONCEPT PLAN	SHEET NO. 14
DATE	DESCRIPTION	DATE	DESCRIPTION	NICHOLAS JOHN CLAVELO LICENSE NUMBER: 84366 SCALAR CONSULTING GROUP INC. 5713 CORPORATE WAY, SUITE 200 WEST PALM BEACH, FLORIDA 33407		ROAD NO.	COUNTY		
						SR 70	HIGHLANDS OKEECHOBEE	FINANCIAL PROJECT ID 450334-1-22-01	

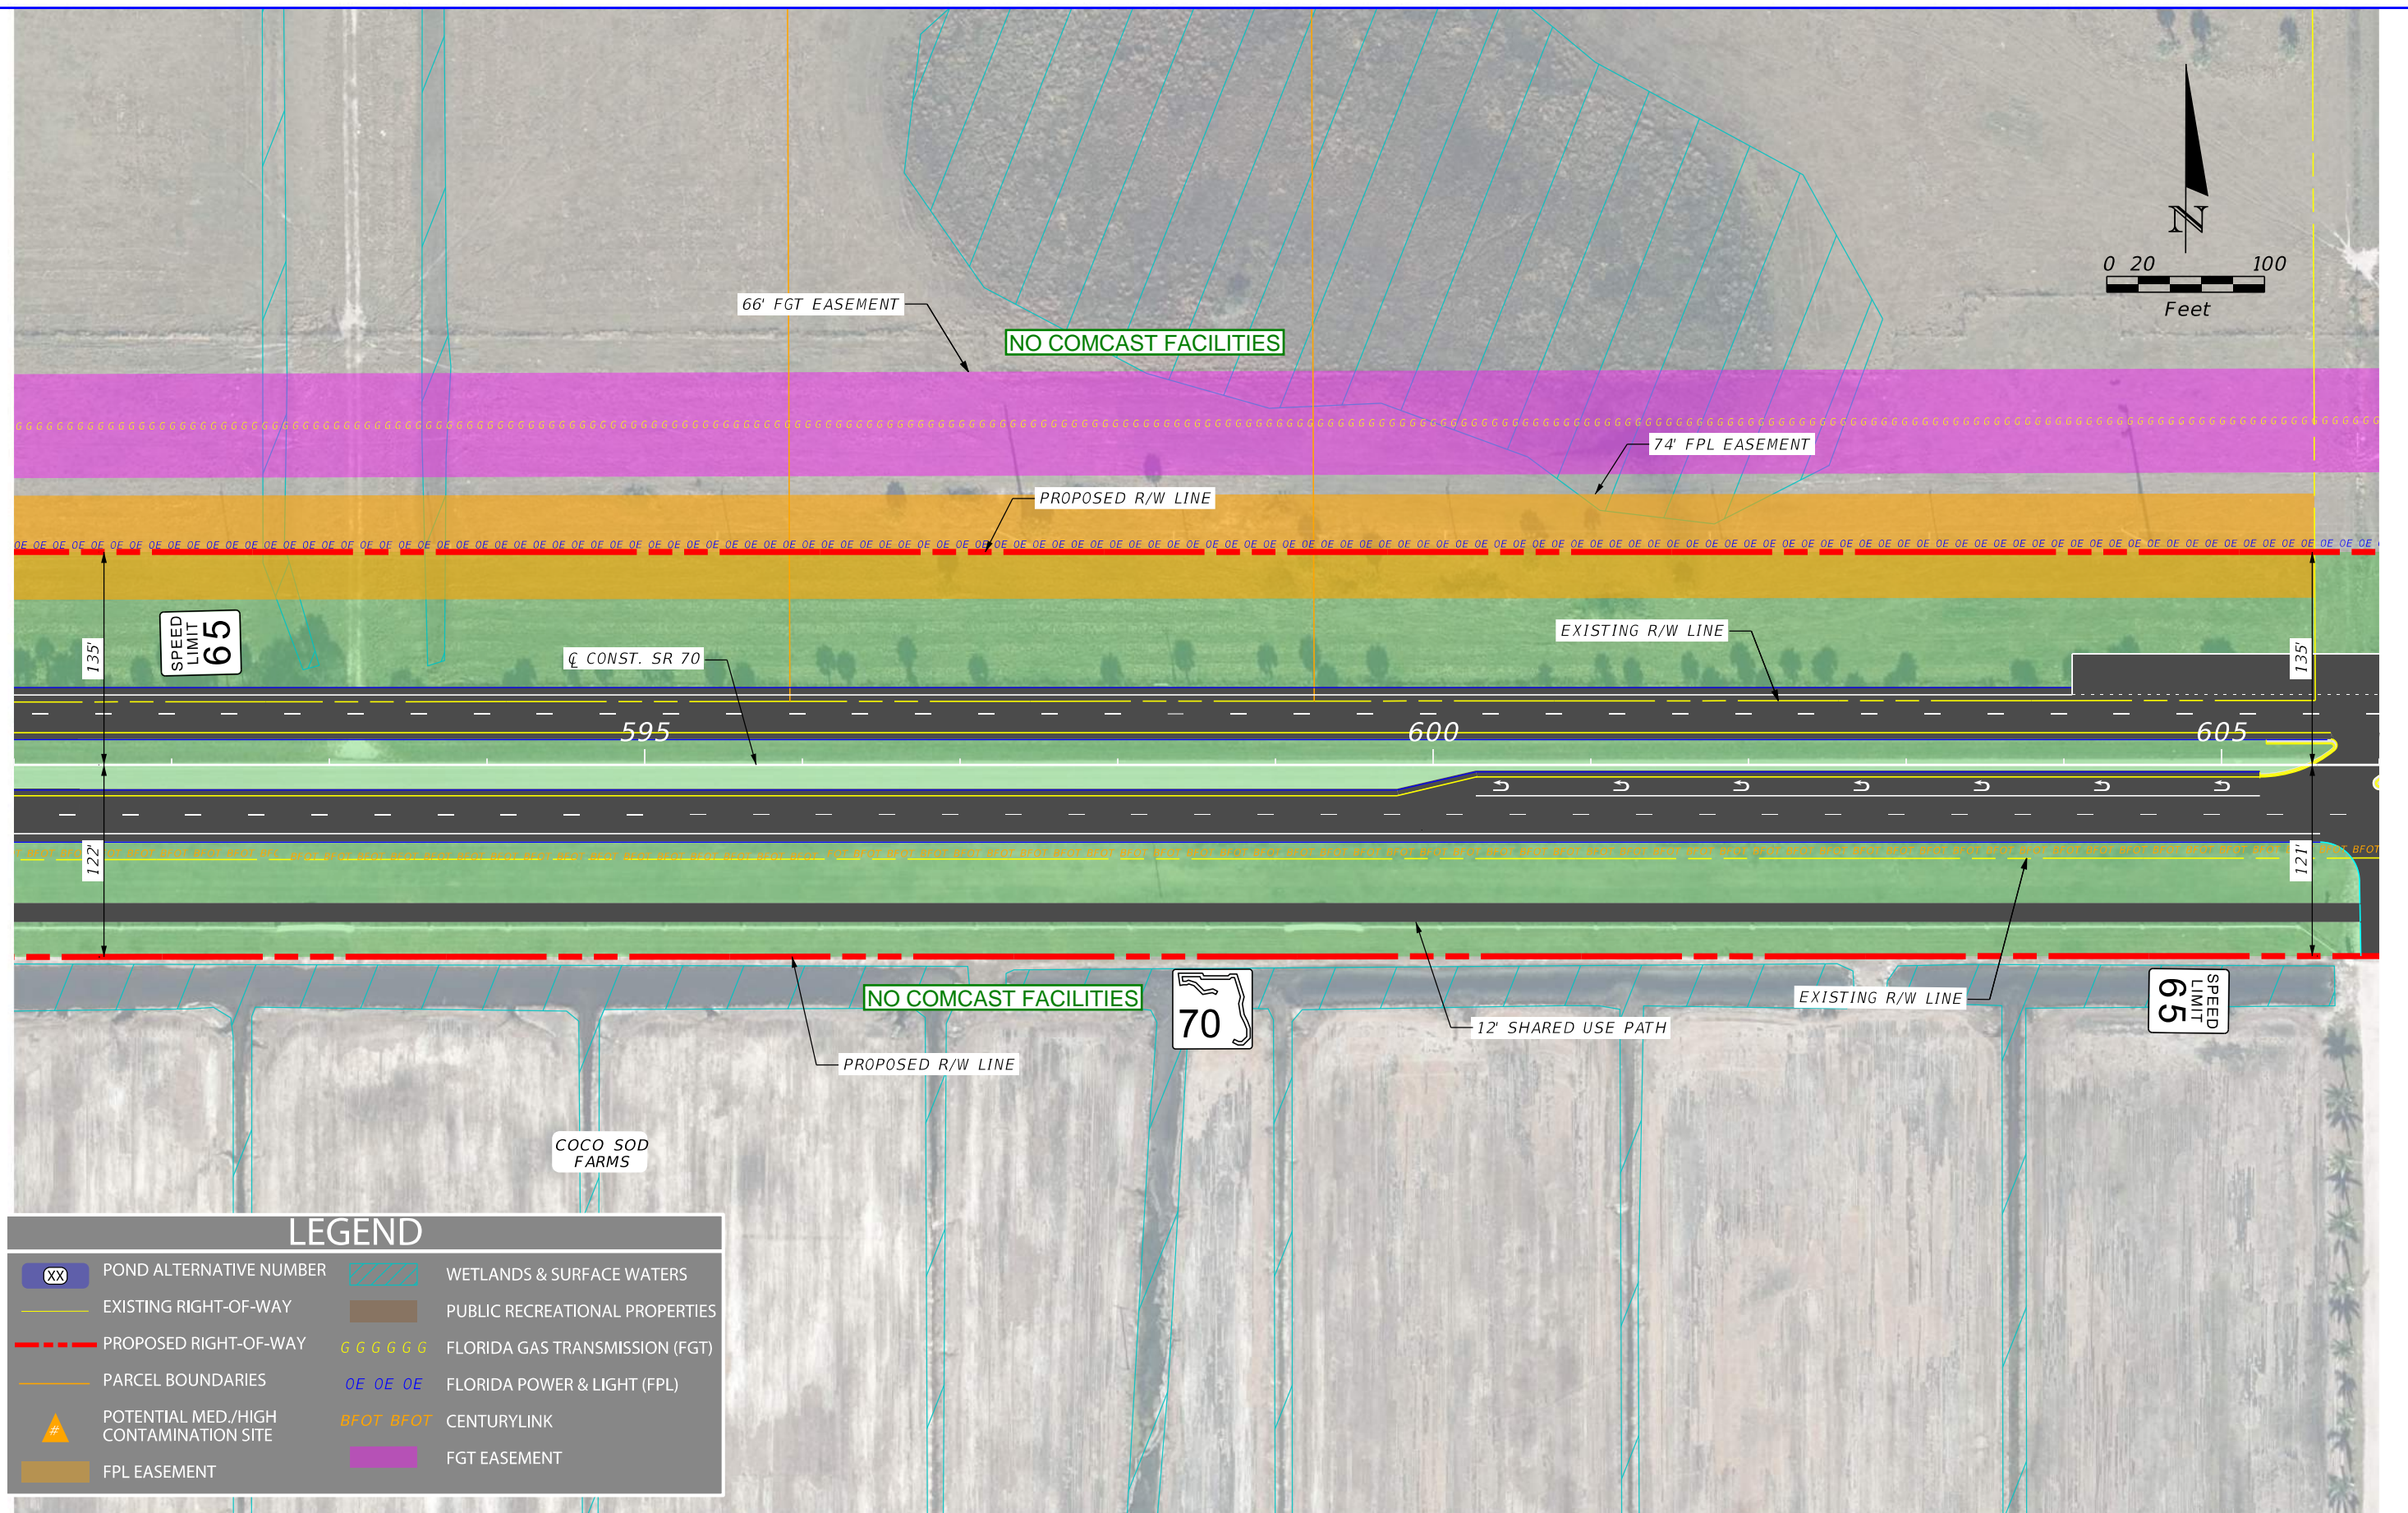

REVISIONS				ENGINEER OF RECORD	STATE OF FLORIDA DEPARTMENT OF TRANSPORTATION			ALTERNATIVE 1 CONCEPT PLAN	SHEET NO.
DATE	DESCRIPTION	DATE	DESCRIPTION		ROAD NO.	COUNTY	FINANCIAL PROJECT ID		
					SR 70	HIGHLANDS OKEECHOBEE	450334-1-22-01		15

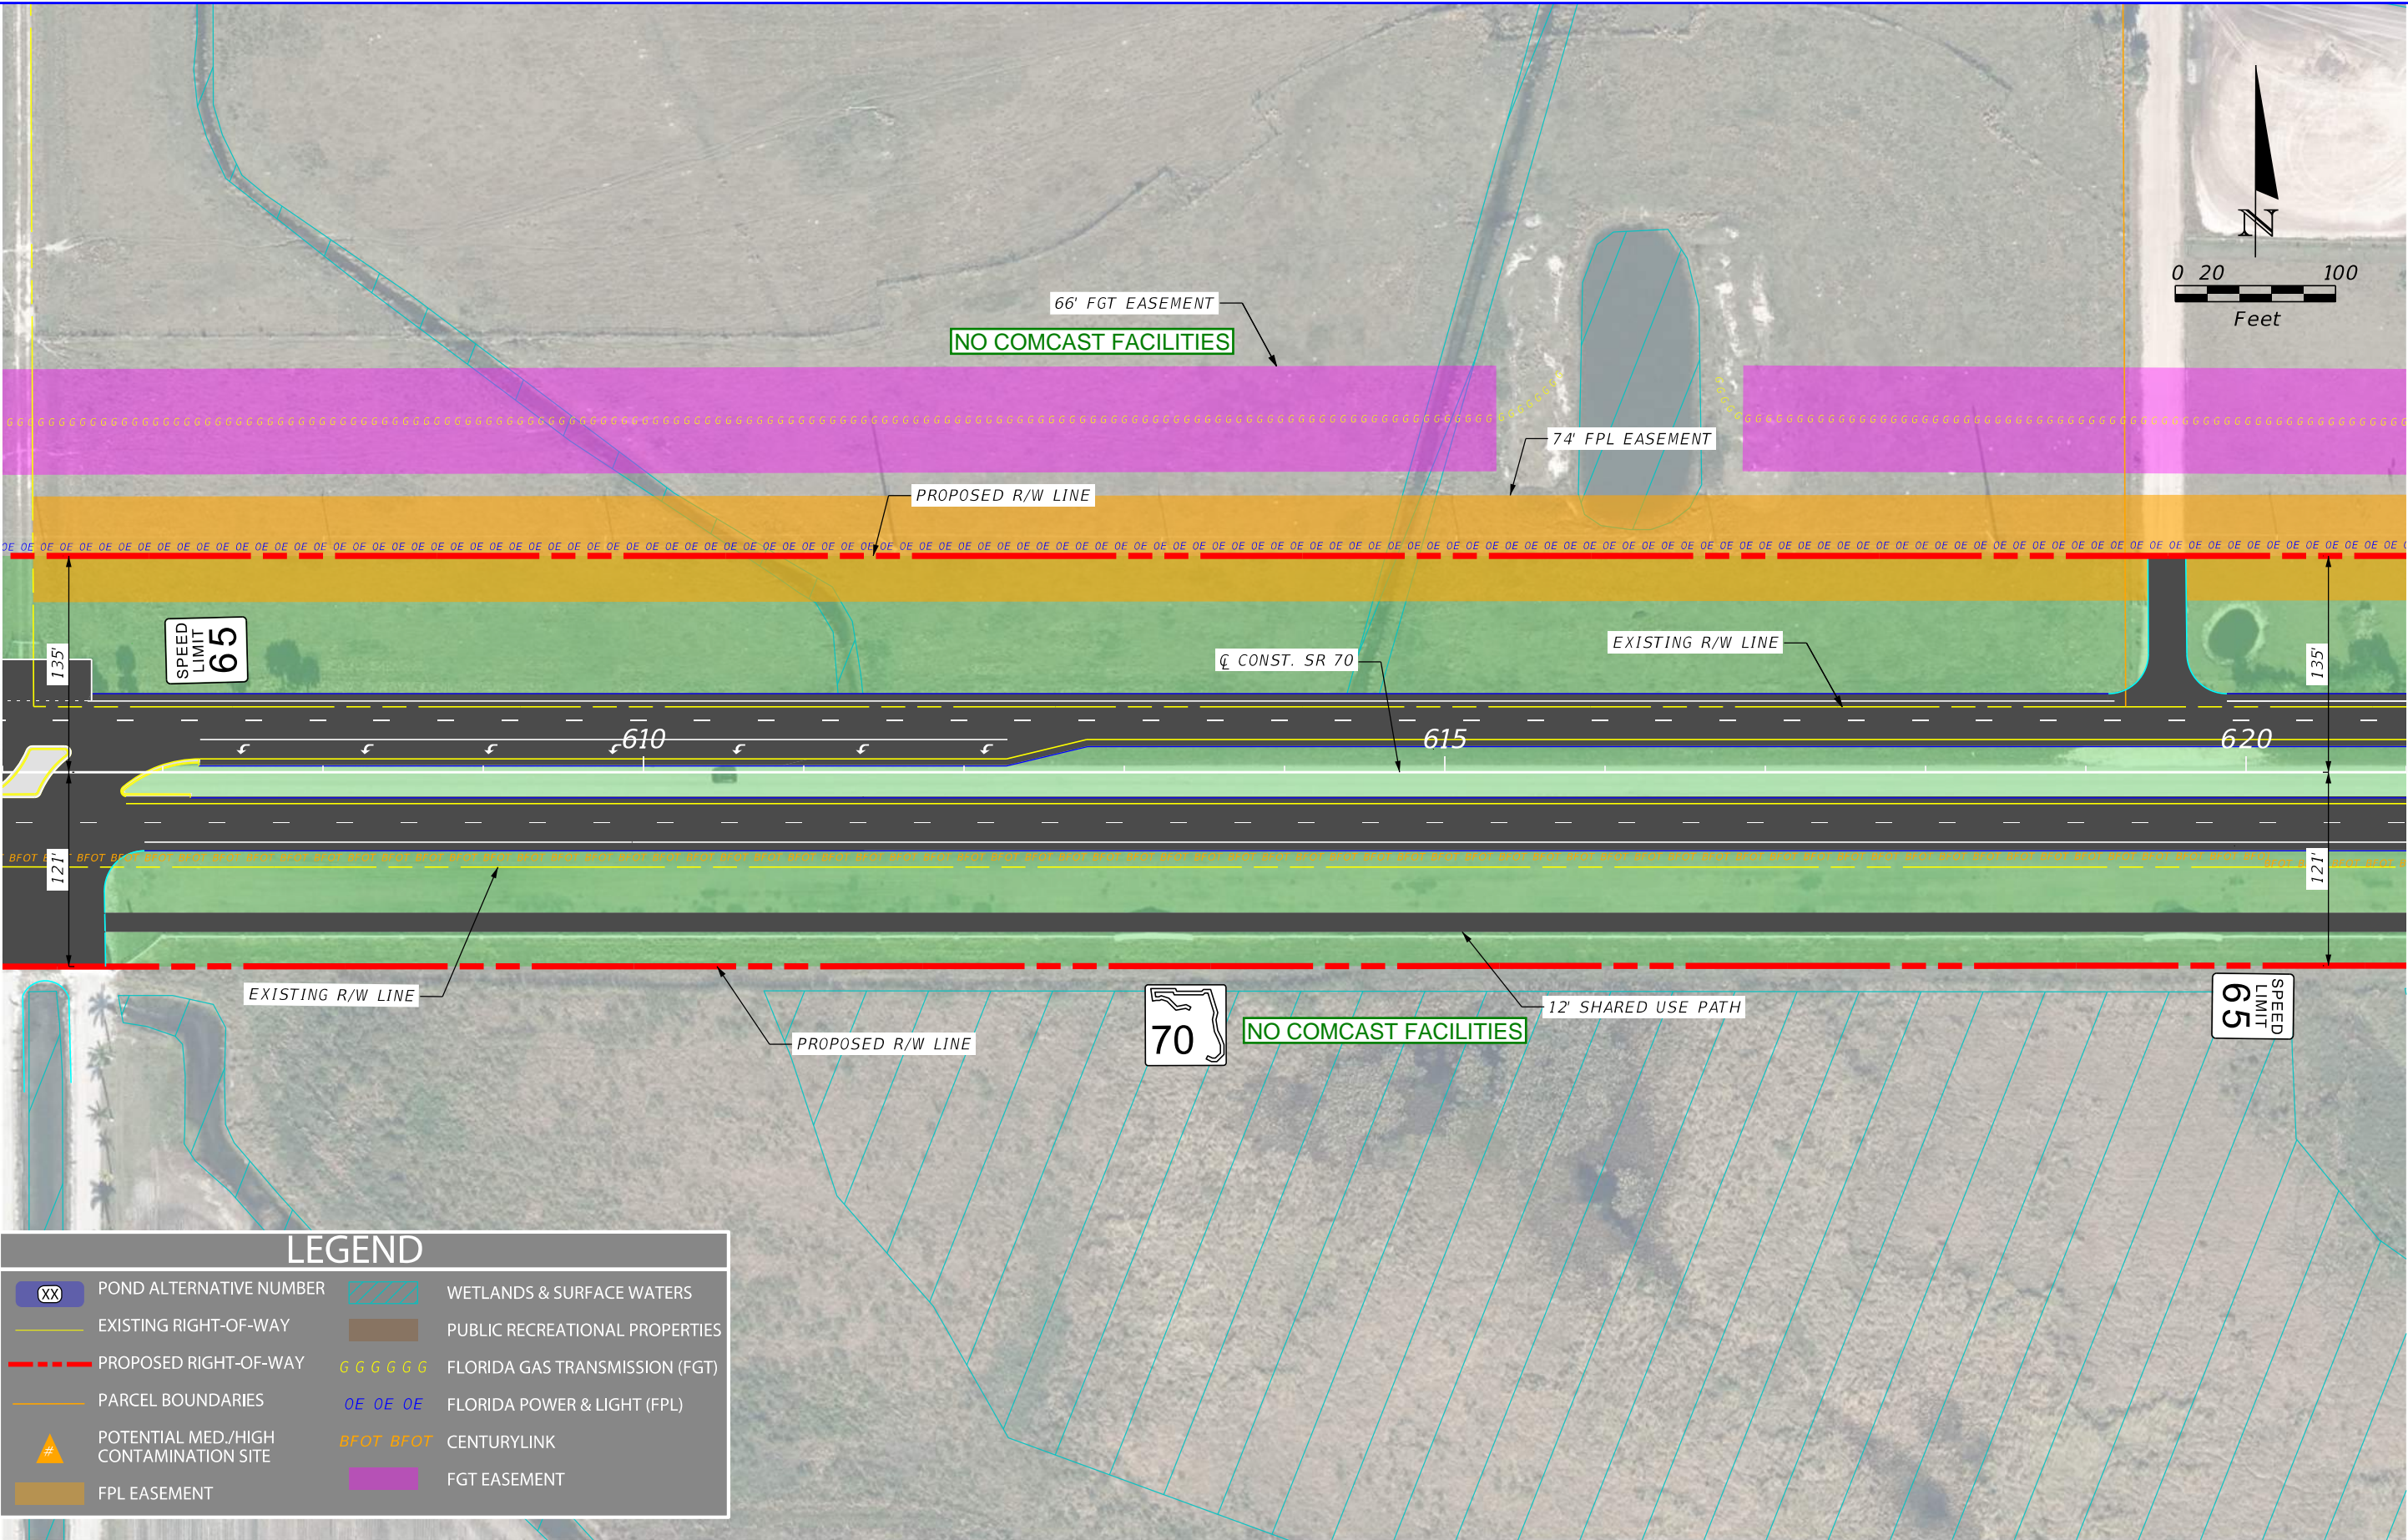

LEGEND

XX

POND ALTERNATIVE NUMBER

EXISTING RIGHT-OF-WAY

PROPOSED RIGHT-OF-WAY

PARCEL BOUNDARIES

#

POTENTIAL MED/HIGH CONTAMINATION SITE

FPL EASEMENT

WETLANDS & SURFACE WATERS

PUBLIC RECREATIONAL PROPERTIES

GGGGGG

FLORIDA GAS TRANSMISSION (FGT)

OE OE OE

FLORIDA POWER & LIGHT (FPL)


BFOT BFOT

CENTURYLINK

FGT EASEMENT


REVISIONS				ENGINEER OF RECORD		STATE OF FLORIDA DEPARTMENT OF TRANSPORTATION		ALTERNATIVE 1 CONCEPT PLAN	SHEET NO.
DATE	DESCRIPTION	DATE	DESCRIPTION	NICHOLAS JOHN CLAVELO LICENSE NUMBER: 84366 SCALAR CONSULTING GROUP INC. 5713 CORPORATE WAY, SUITE 200 WEST PALM BEACH, FLORIDA 33407		ROAD NO.	COUNTY		
						SR 70	HIGHLANDS OKEECHOBEE	FINANCIAL PROJECT ID 450334-1-22-01	16

P:\FL23010.00 SR 70 PD&E Study\45033412201\roadway\PLANRD01.dgn : CL11 - PLAN 16 [SHEET]
USER: areginato 11/27/2024 4:57:43 PM

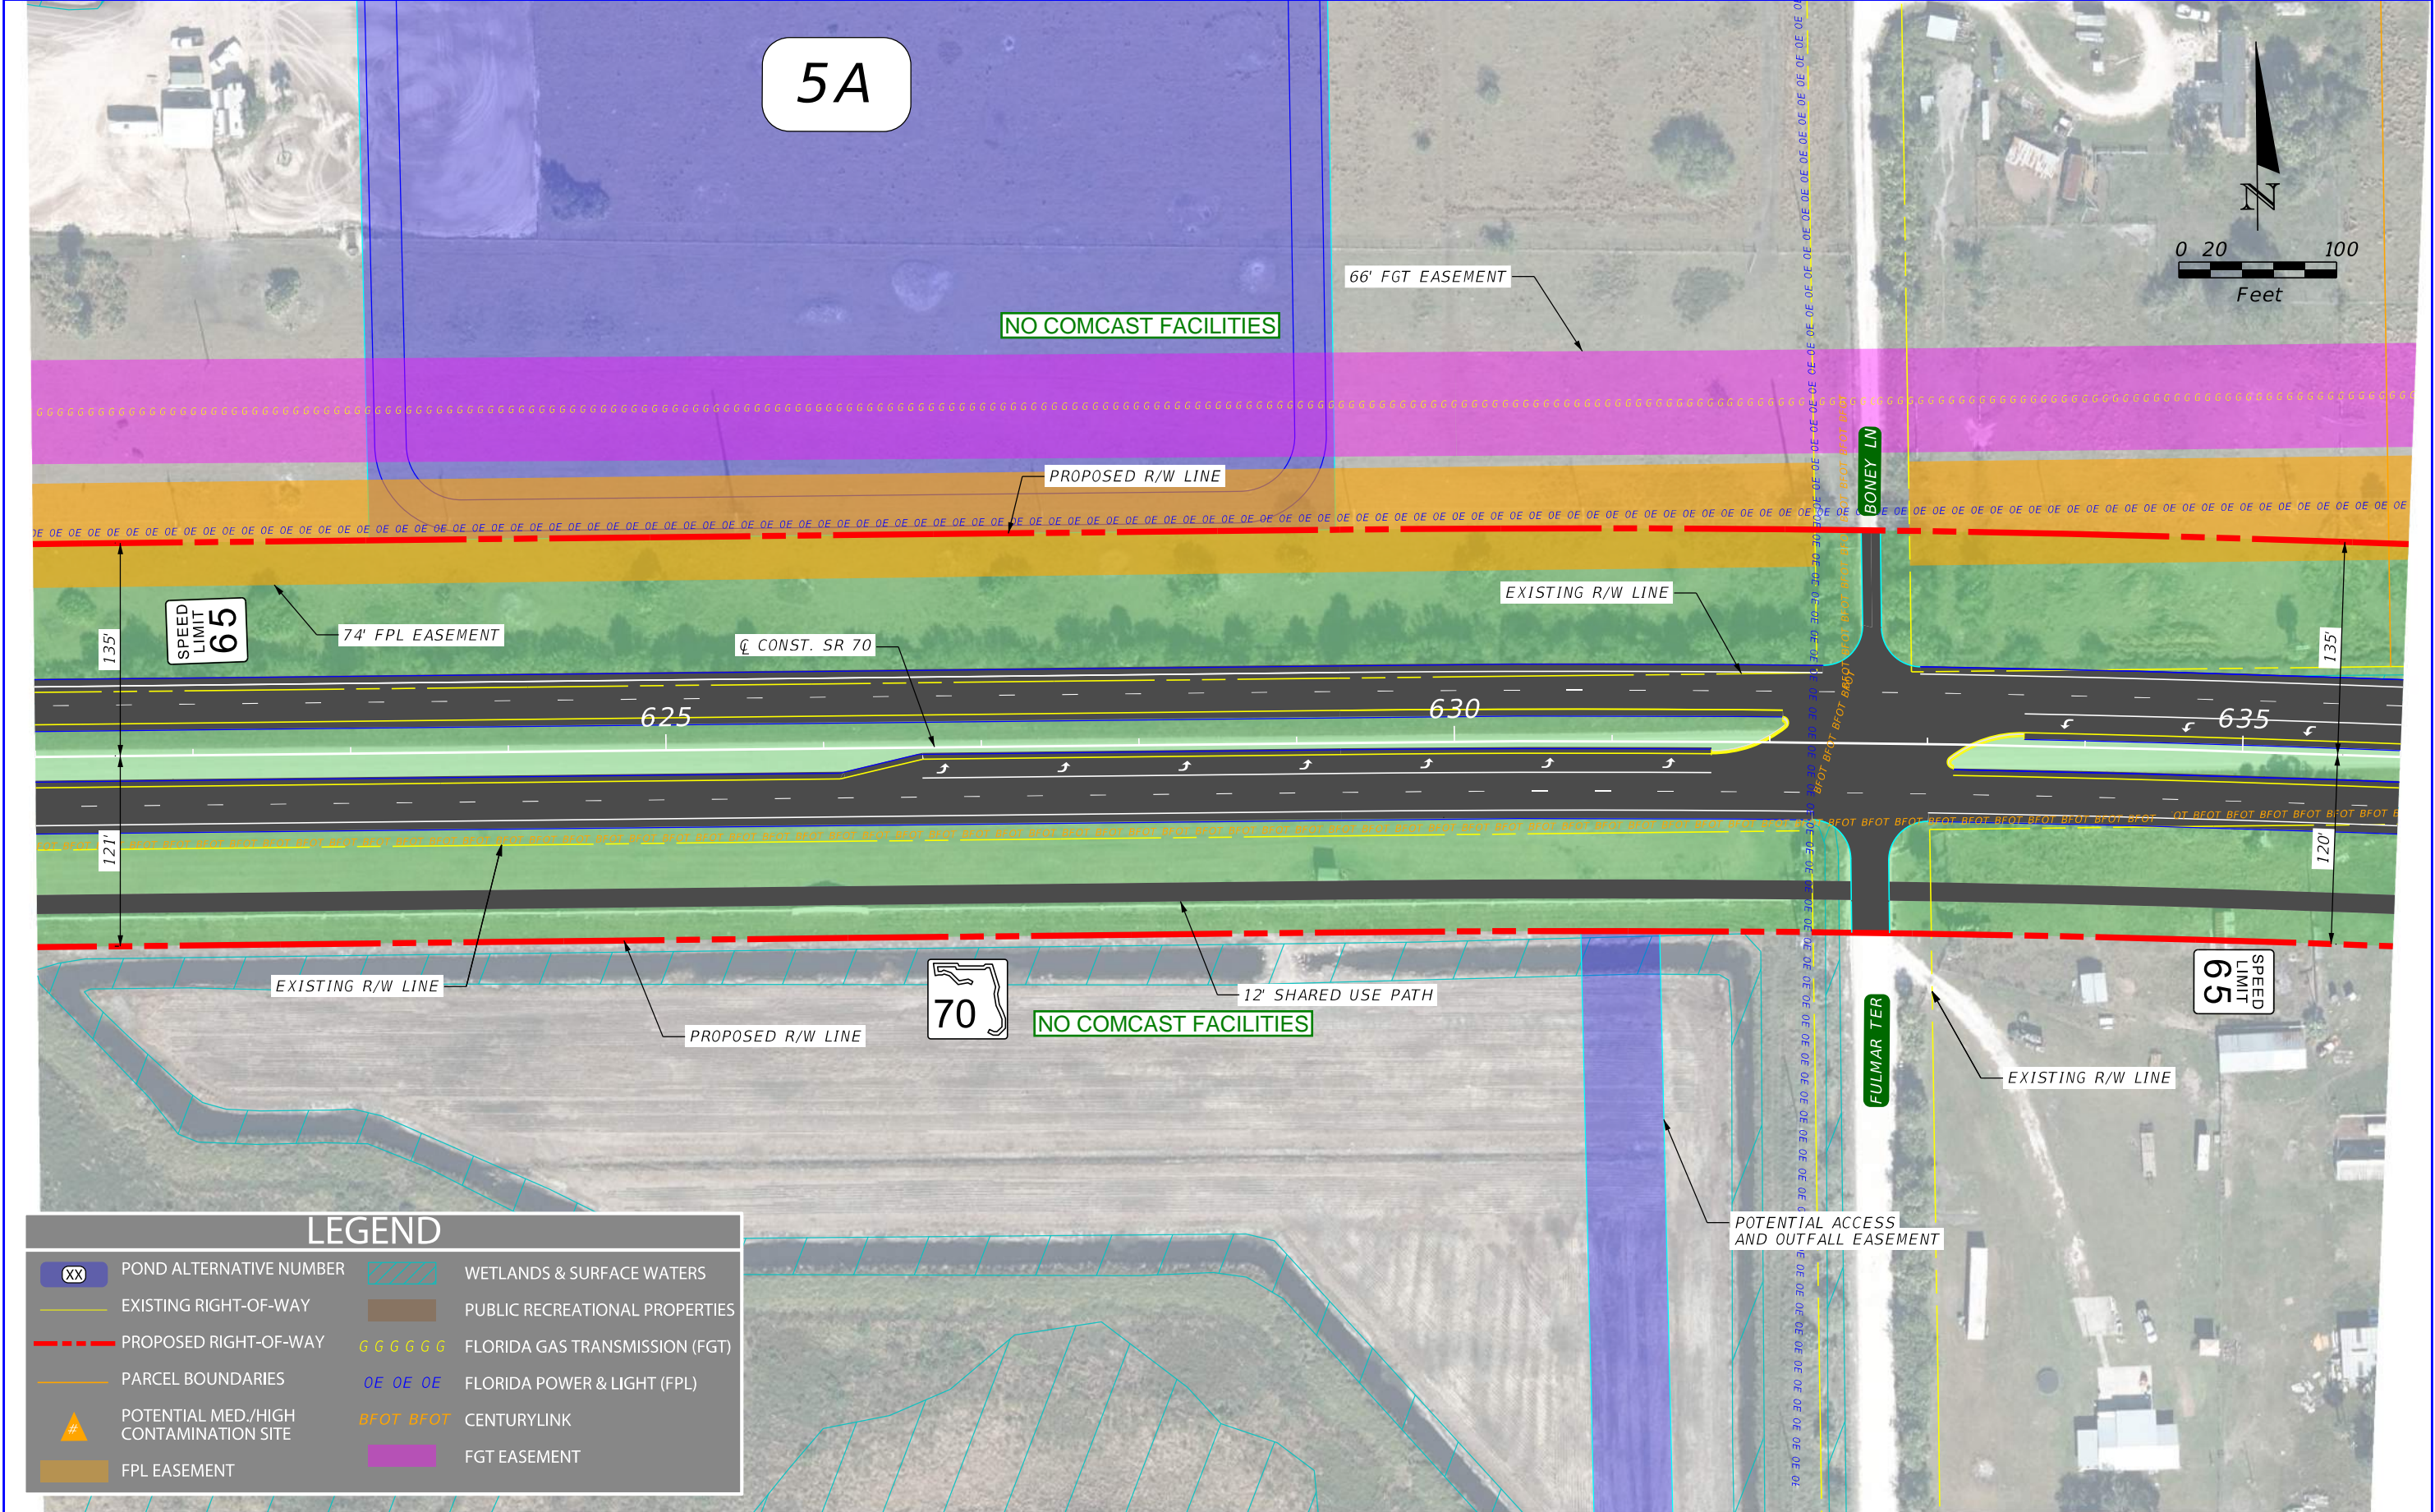

LEGEND			
XX	POND ALTERNATIVE NUMBER		WETLANDS & SURFACE WATERS
	EXISTING RIGHT-OF-WAY		PUBLIC RECREATIONAL PROPERTIES
	PROPOSED RIGHT-OF-WAY		FLORIDA GAS TRANSMISSION (FGT)
	PARCEL BOUNDARIES		FLORIDA POWER & LIGHT (FPL)
	POTENTIAL MED./HIGH CONTAMINATION SITE		CENTURYLINK
	FPL EASEMENT		FGT EASEMENT

REVISIONS				ENGINEER OF RECORD			STATE OF FLORIDA DEPARTMENT OF TRANSPORTATION			ALTERNATIVE 1 CONCEPT PLAN	SHEET NO. 17
DATE	DESCRIPTION	DATE	DESCRIPTION	NICHOLAS JOHN CLAVELO LICENSE NUMBER: 84366 SCALAR CONSULTING GROUP INC. 5713 CORPORATE WAY, SUITE 200 WEST PALM BEACH, FLORIDA 33407			ROAD NO.	COUNTY	FINANCIAL PROJECT ID		
							SR 70	HIGHLANDS OKEECHOBEE	450334-1-22-01		

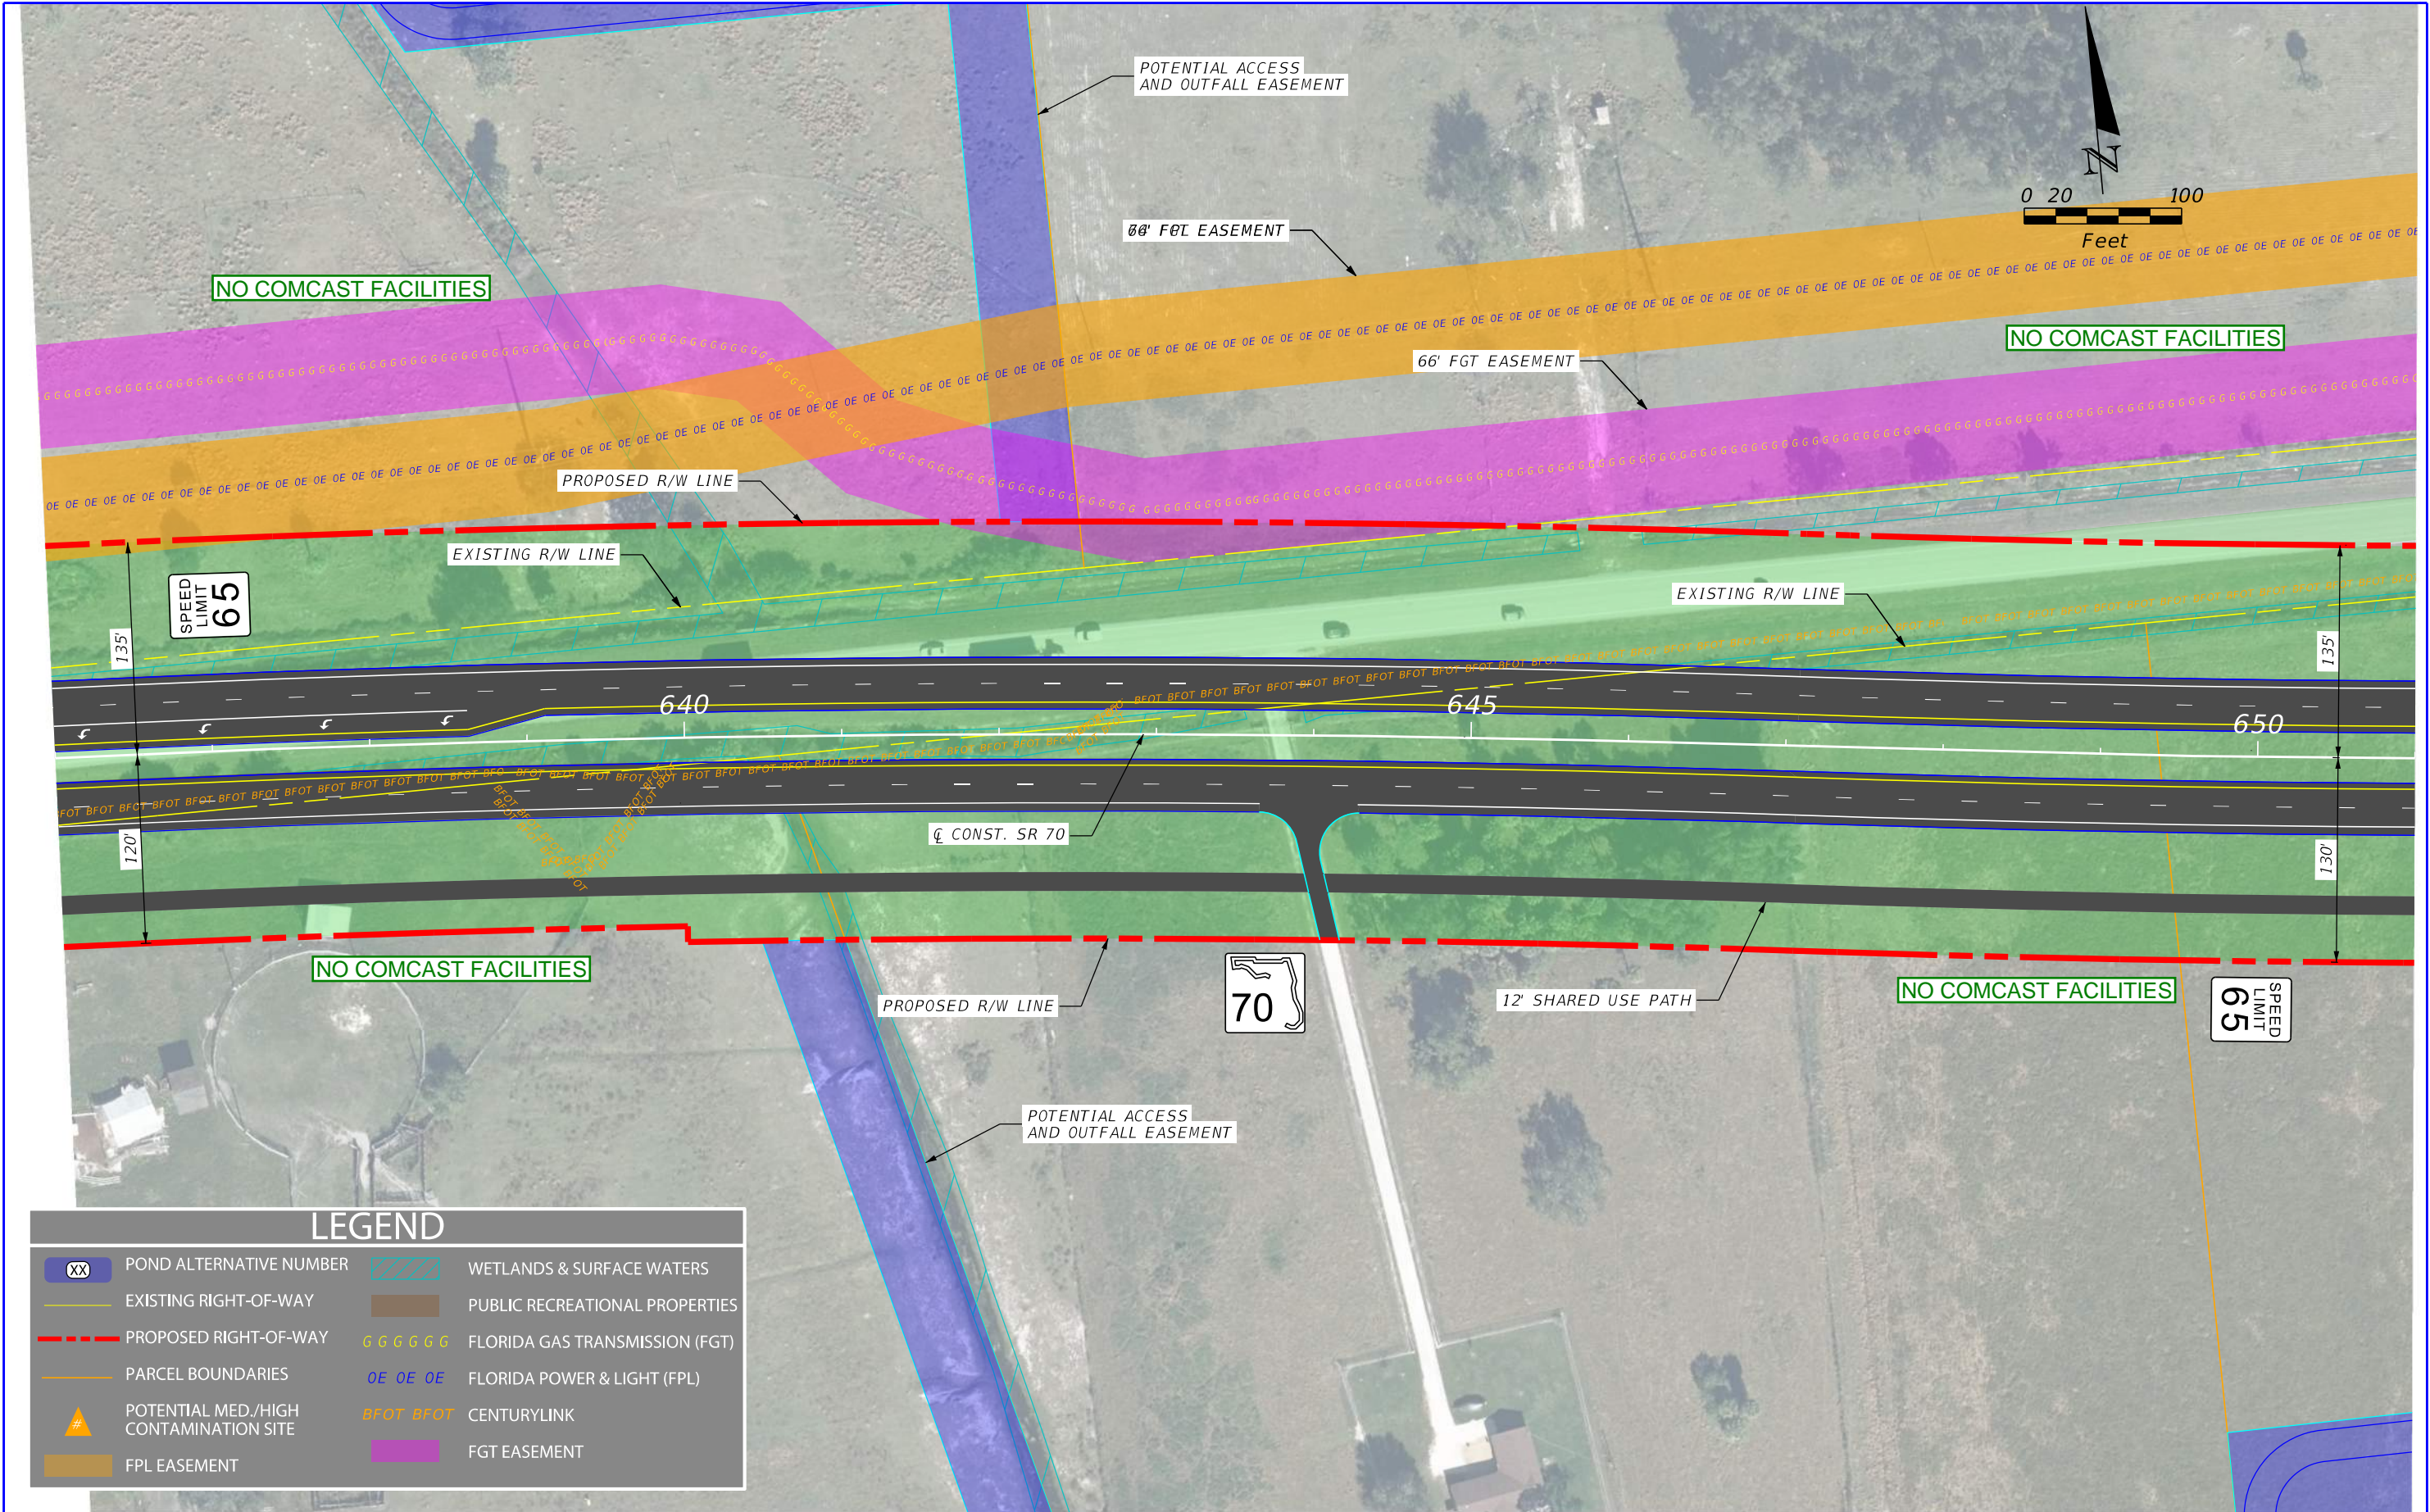

XX

POND ALTERNATIVE NUMBER

EXISTING RIGHT-OF-WAY

PROPOSED RIGHT-OF-WAY

PARCEL BOUNDARIES

#

POTENTIAL MED./HIGH CONTAMINATION SITE

FPL EASEMENT

WETLANDS & SURFACE WATERS

PUBLIC RECREATIONAL PROPERTIES


GGGGGGFLORIDA GAS TRANSMISSION (FGT)

OE OE OEFLORIDA POWER & LIGHT (FPL)

BFOT BFOTCENTURYLINK


FGT EASEMENT

REVISIONS				ENGINEER OF RECORD		STATE OF FLORIDA DEPARTMENT OF TRANSPORTATION		ALTERNATIVE 1 CONCEPT PLAN	SHEET NO. 18
DATE	DESCRIPTION	DATE	DESCRIPTION	NICHOLAS JOHN CLAVELLO LICENSE NUMBER: 84366 SCALAR CONSULTING GROUP INC. 5713 CORPORATE WAY, SUITE 200 WEST PALM BEACH, FLORIDA 33407		ROAD NO.	COUNTY		
						SR 70	HIGHLANDS OKEECHOBEE	FINANCIAL PROJECT ID 450334-1-22-01	

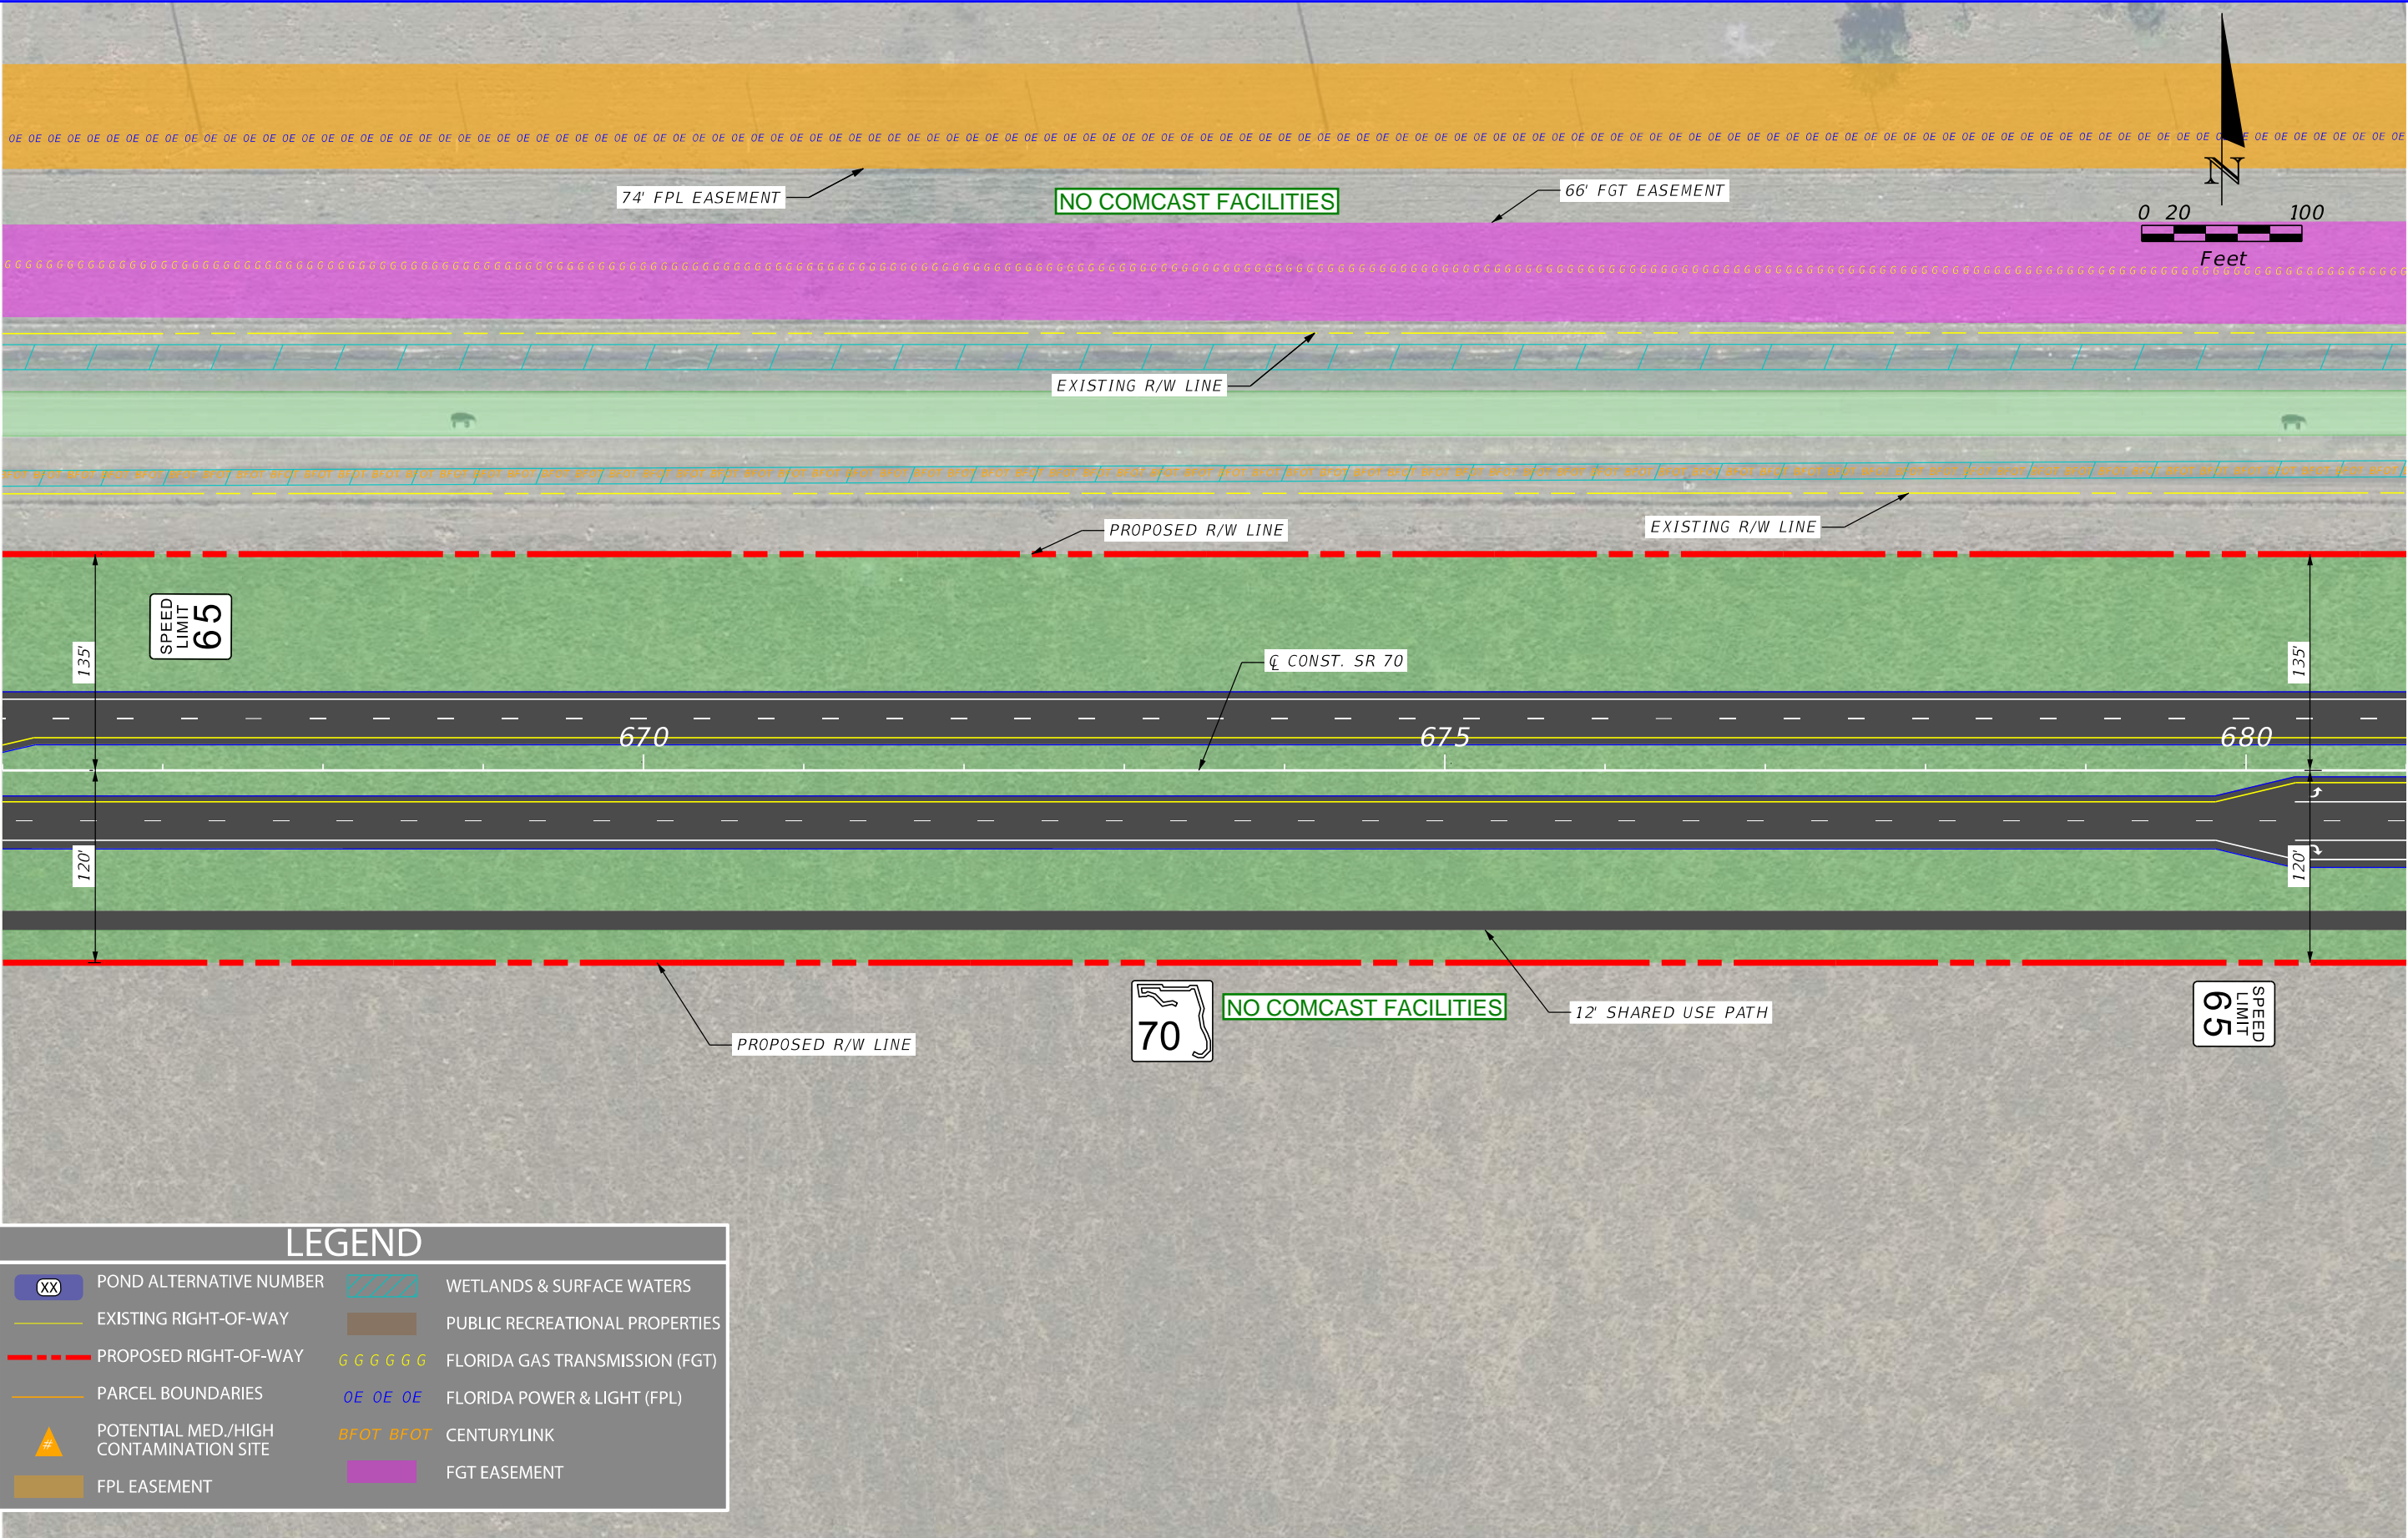


LEGEND			
	POND ALTERNATIVE NUMBER		WETLANDS & SURFACE WATERS
	EXISTING RIGHT-OF-WAY		PUBLIC RECREATIONAL PROPERTIES
	PROPOSED RIGHT-OF-WAY		FLORIDA GAS TRANSMISSION (FGT)
	PARCEL BOUNDARIES		FLORIDA POWER & LIGHT (FPL)
	POTENTIAL MED./HIGH CONTAMINATION SITE		CENTURYLINK
	FPL EASEMENT		FGT EASEMENT


REVISIONS				ENGINEER OF RECORD	STATE OF FLORIDA DEPARTMENT OF TRANSPORTATION			ALTERNATIVE 1 CONCEPT PLAN	SHEET NO.	
DATE	DESCRIPTION		DATE	DESCRIPTION		ROAD NO.	COUNTY		FINANCIAL PROJECT ID	20
						SR 70	HIGHLANDS OKEECHOBEE		450334-1-22-01	
				NICHOLAS JOHN CLAVELLO LICENSE NUMBER: 84366 SCALAR CONSULTING GROUP INC. 5713 CORPORATE WAY, SUITE 200 WEST PALM BEACH, FLORIDA 33407						

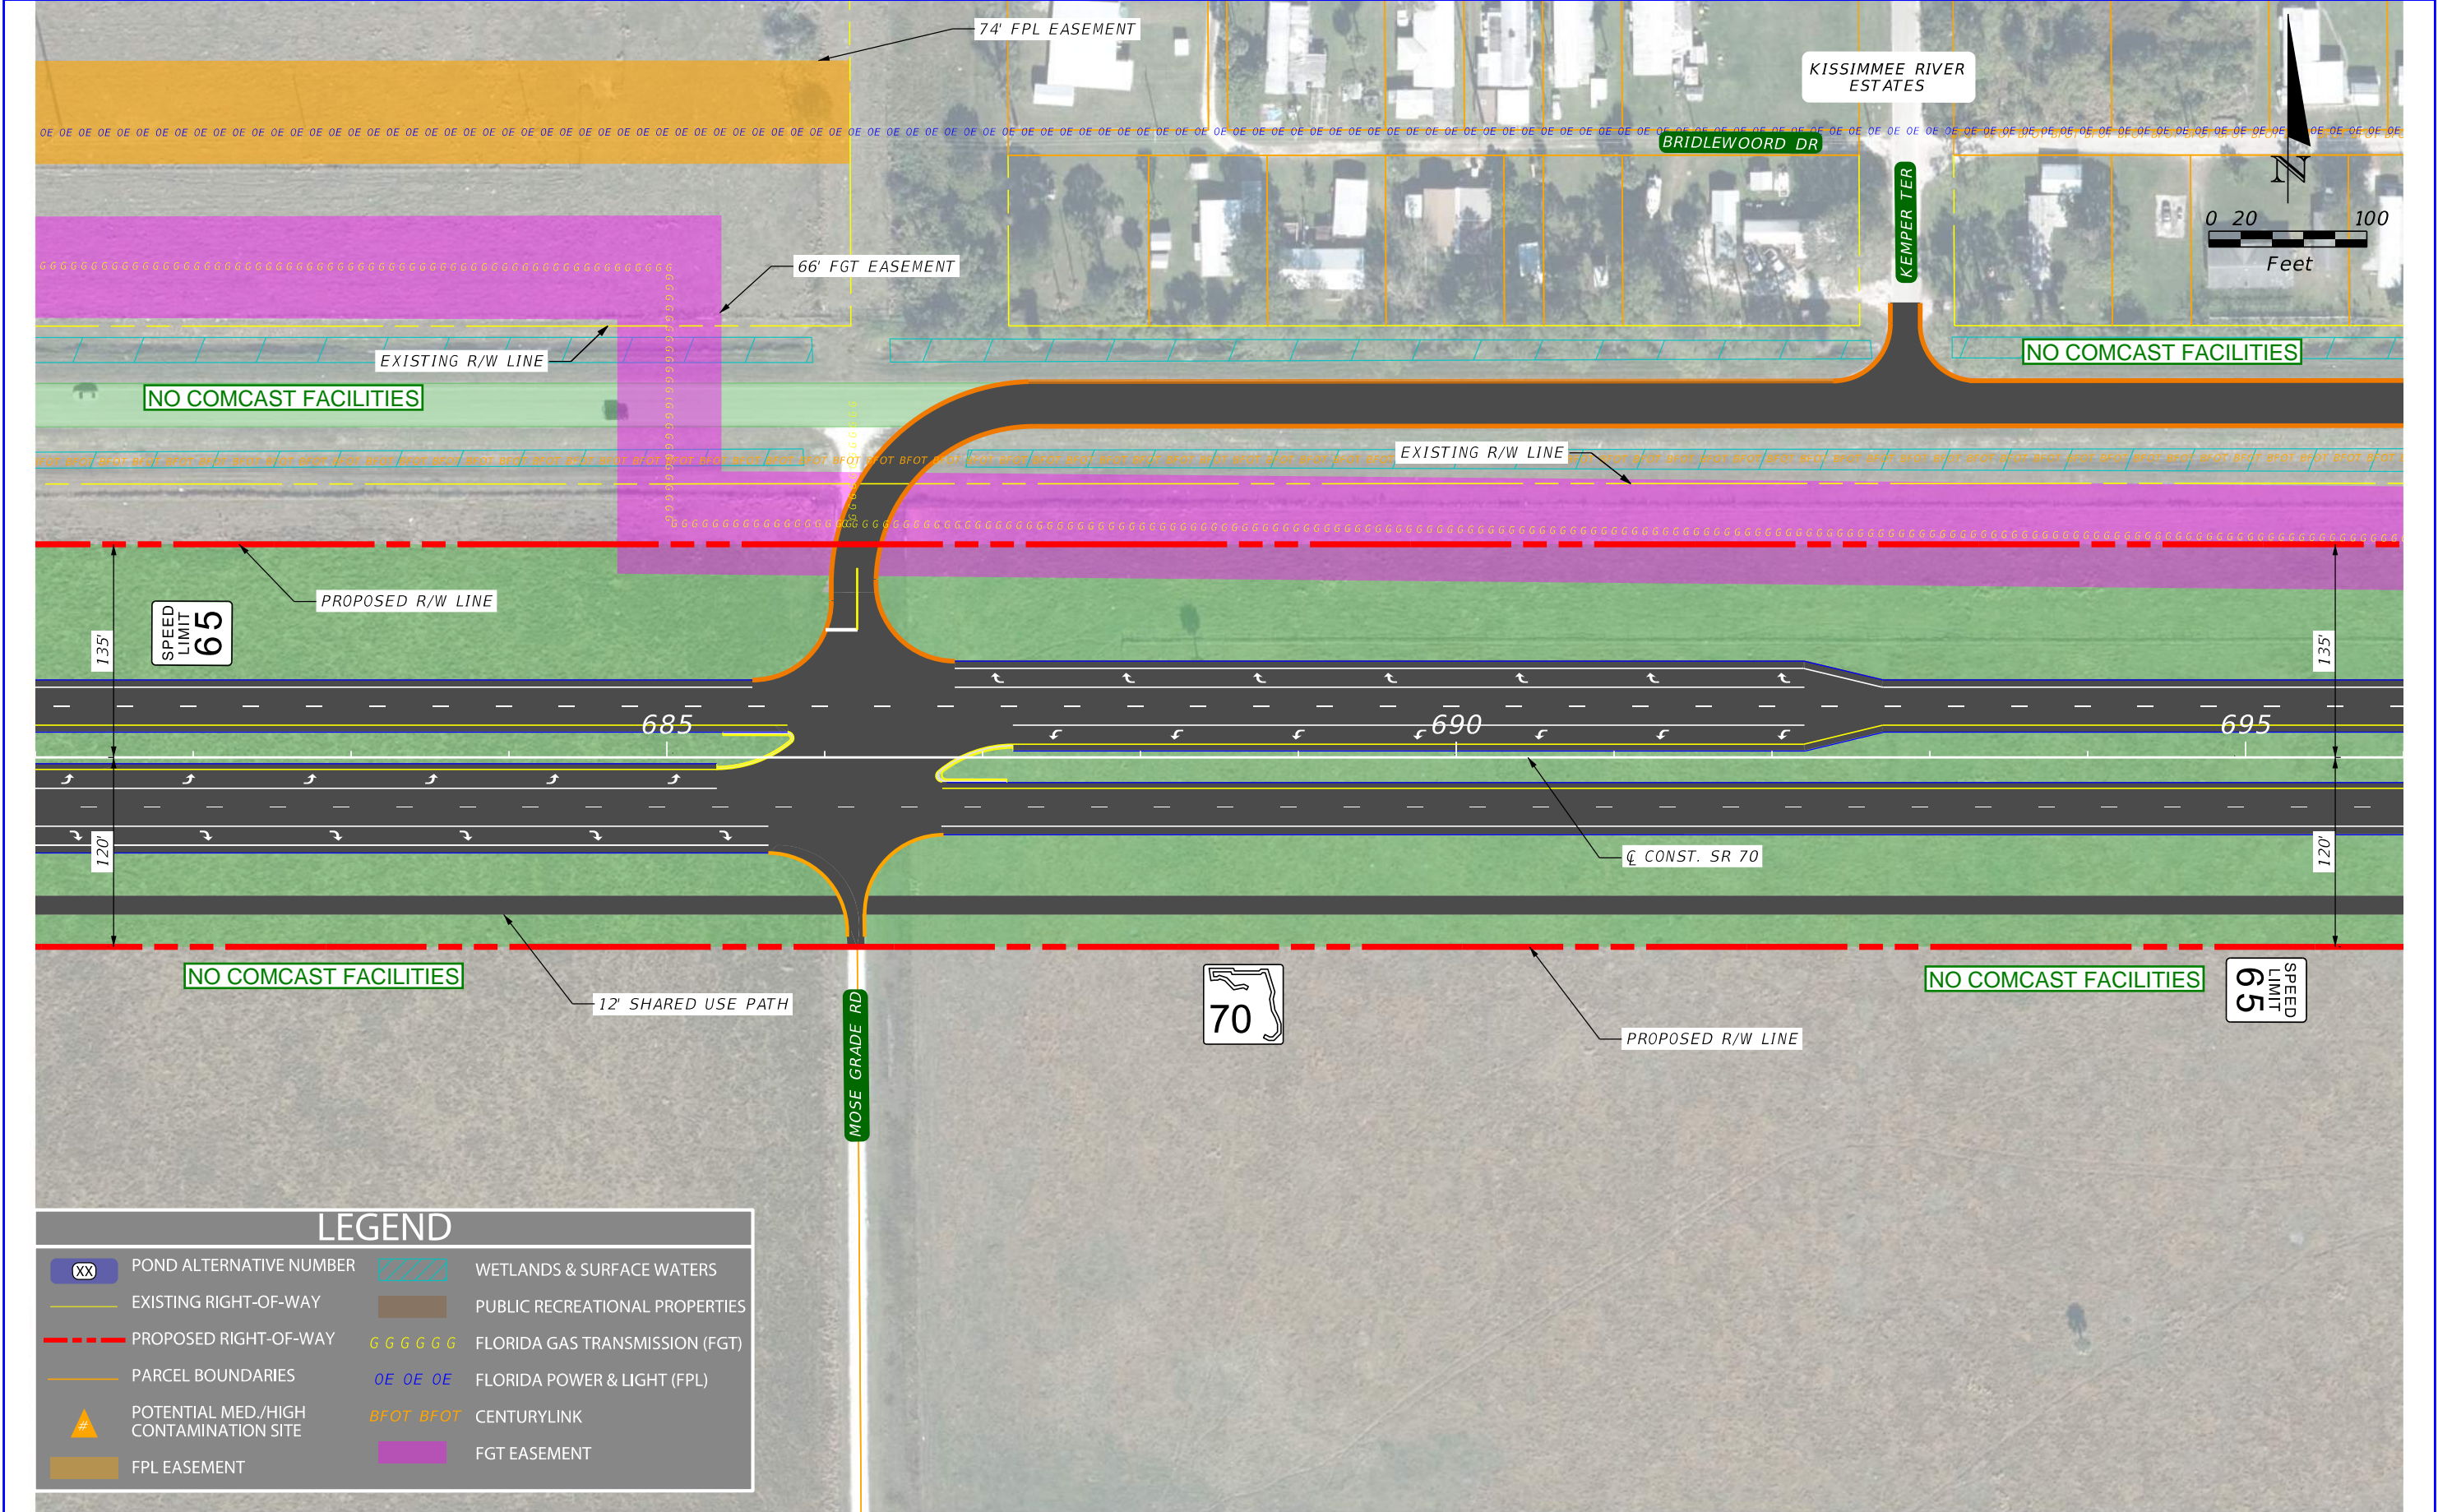


REVISIONS				ENGINEER OF RECORD		STATE OF FLORIDA DEPARTMENT OF TRANSPORTATION		ALTERNATIVE 1 CONCEPT PLAN	SHEET NO. 21
DATE	DESCRIPTION	DATE	DESCRIPTION	NICHOLAS JOHN CLAVELO LICENSE NUMBER: 84366 SCALAR CONSULTING GROUP INC. 5713 CORPORATE WAY, SUITE 200 WEST PALM BEACH, FLORIDA 33407		ROAD NO.	COUNTY		
						SR 70	HIGHLANDS OKEECHOBEE	FINANCIAL PROJECT ID 450334-1-22-01	

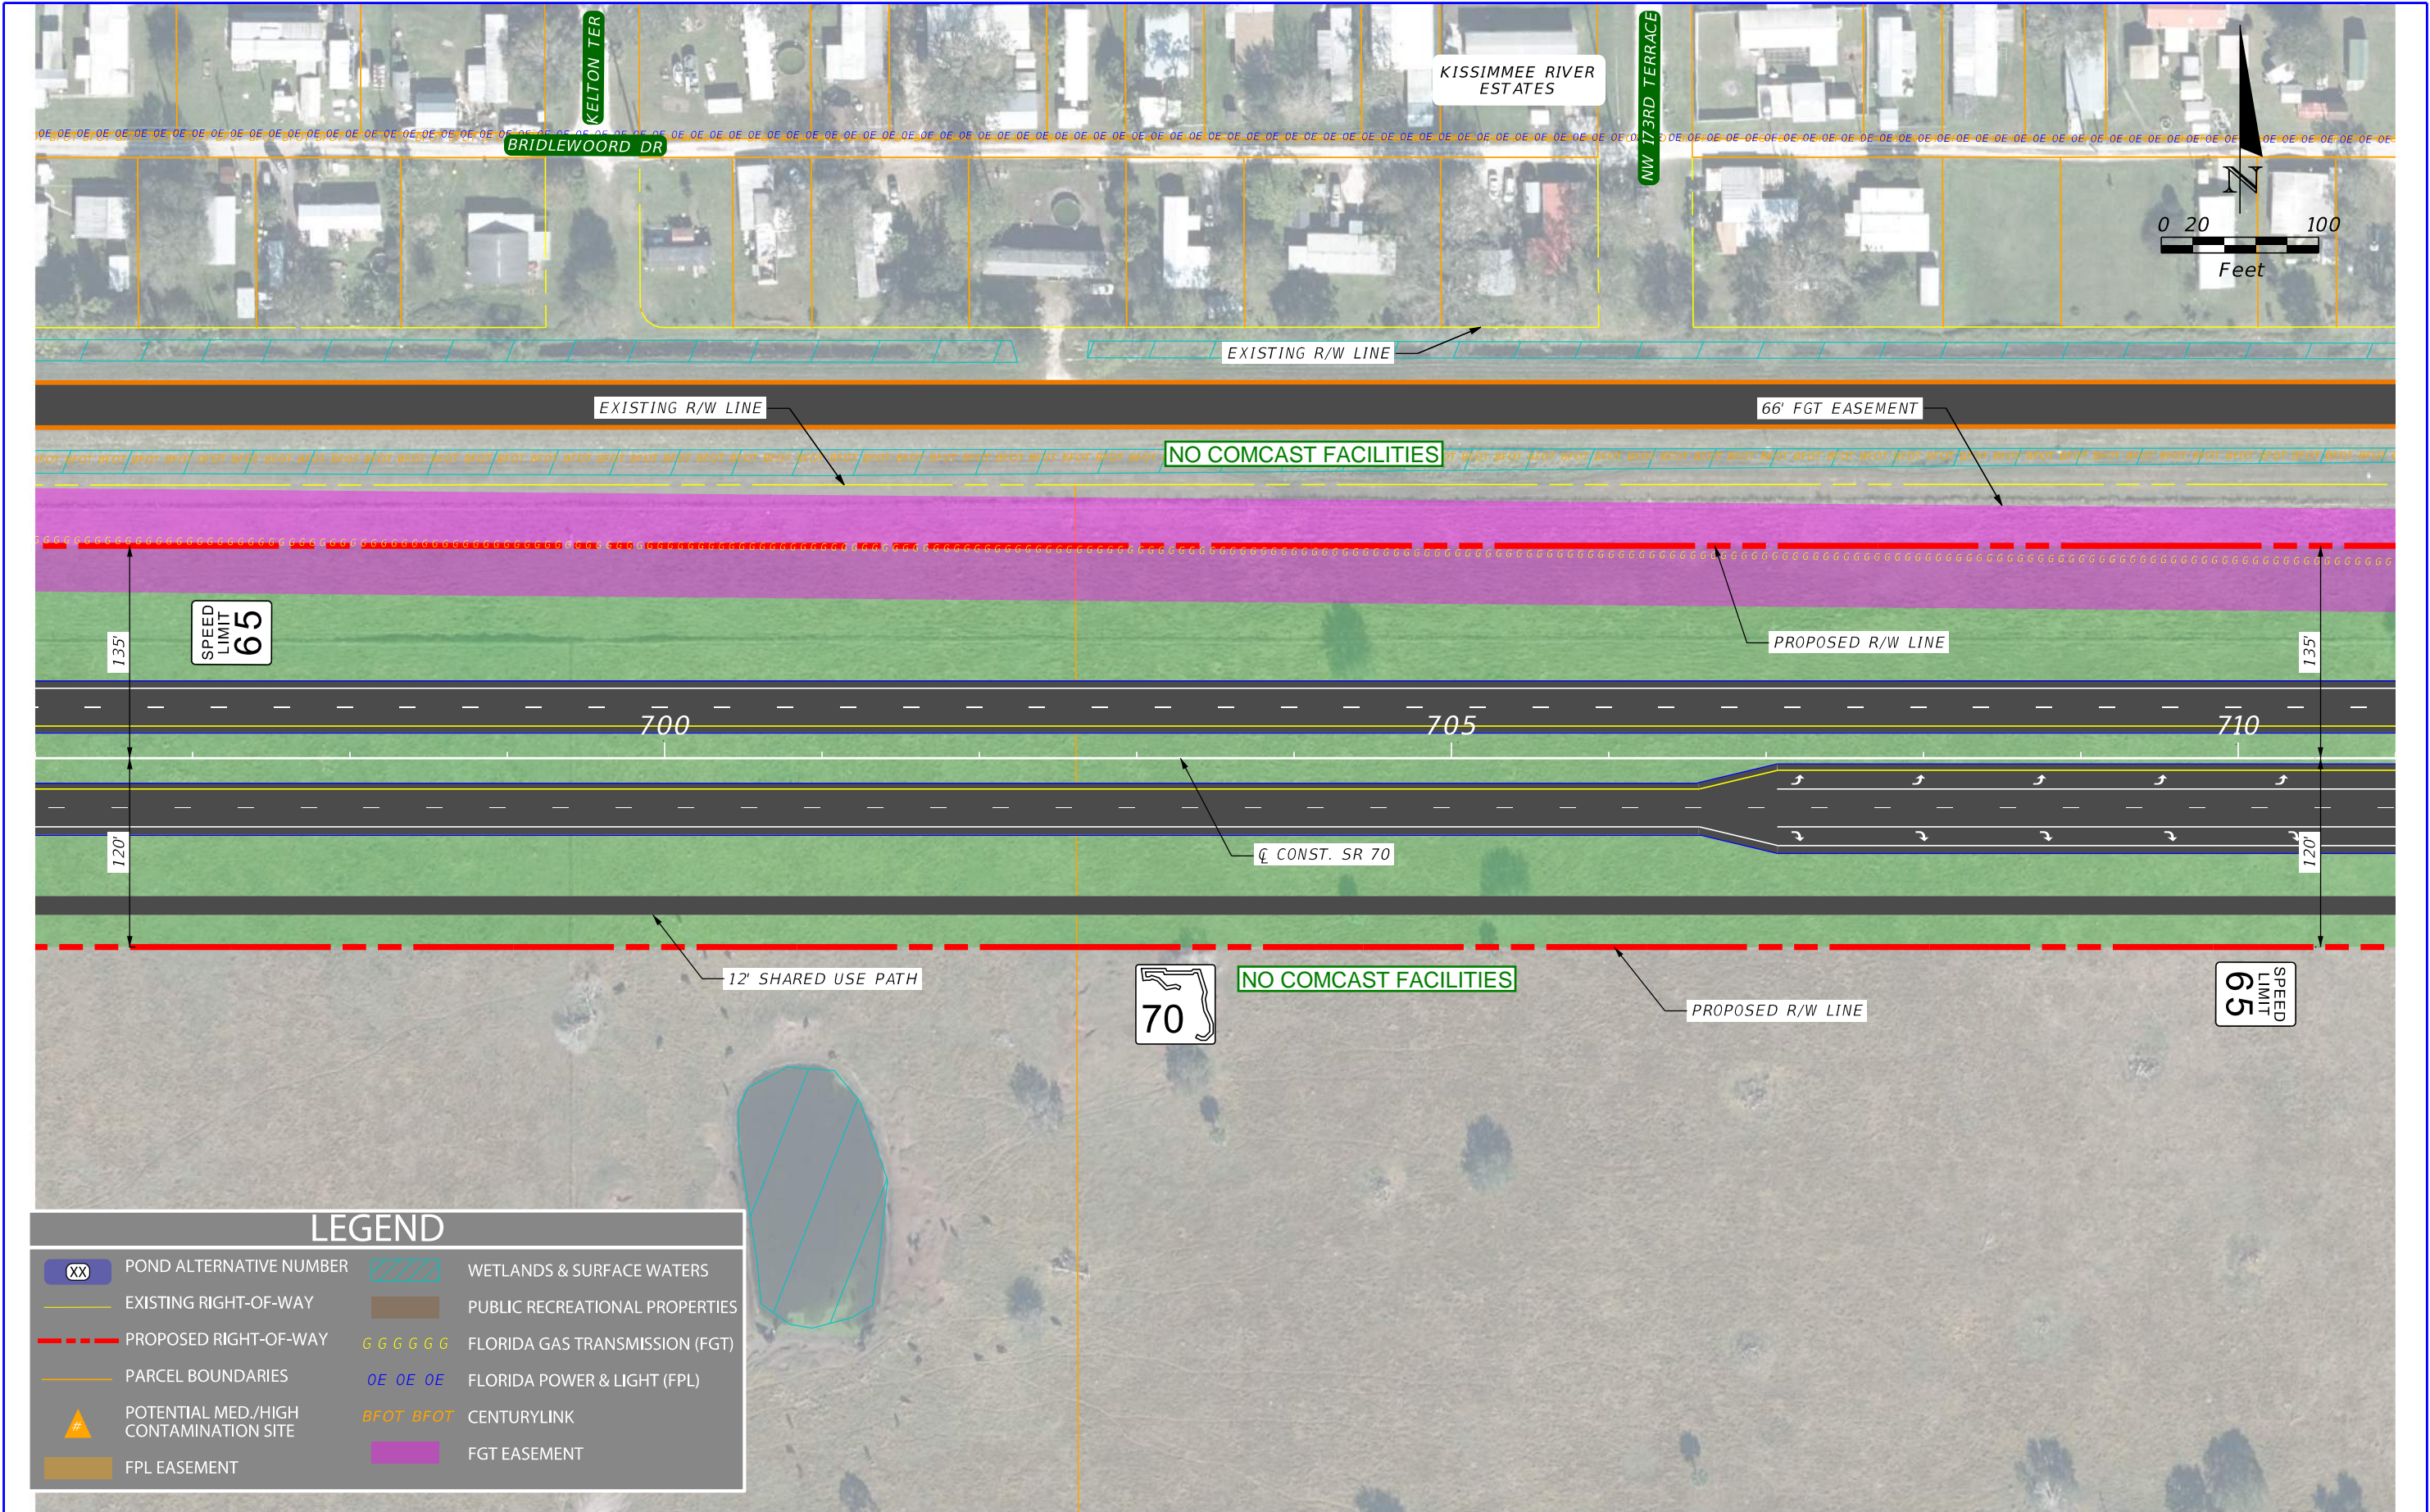

REVISIONS				ENGINEER OF RECORD		STATE OF FLORIDA DEPARTMENT OF TRANSPORTATION		ALTERNATIVE 1 CONCEPT PLAN	SHEET NO. 22
DATE	DESCRIPTION	DATE	DESCRIPTION	NICHOLAS JOHN CLAVELLO LICENSE NUMBER: 84366 SCALAR CONSULTING GROUP INC. 5713 CORPORATE WAY, SUITE 200 WEST PALM BEACH, FLORIDA 33407		ROAD NO.	COUNTY		
						SR 70	HIGHLANDS OKEECHOBEE	FINANCIAL PROJECT ID 450334-1-22-01	

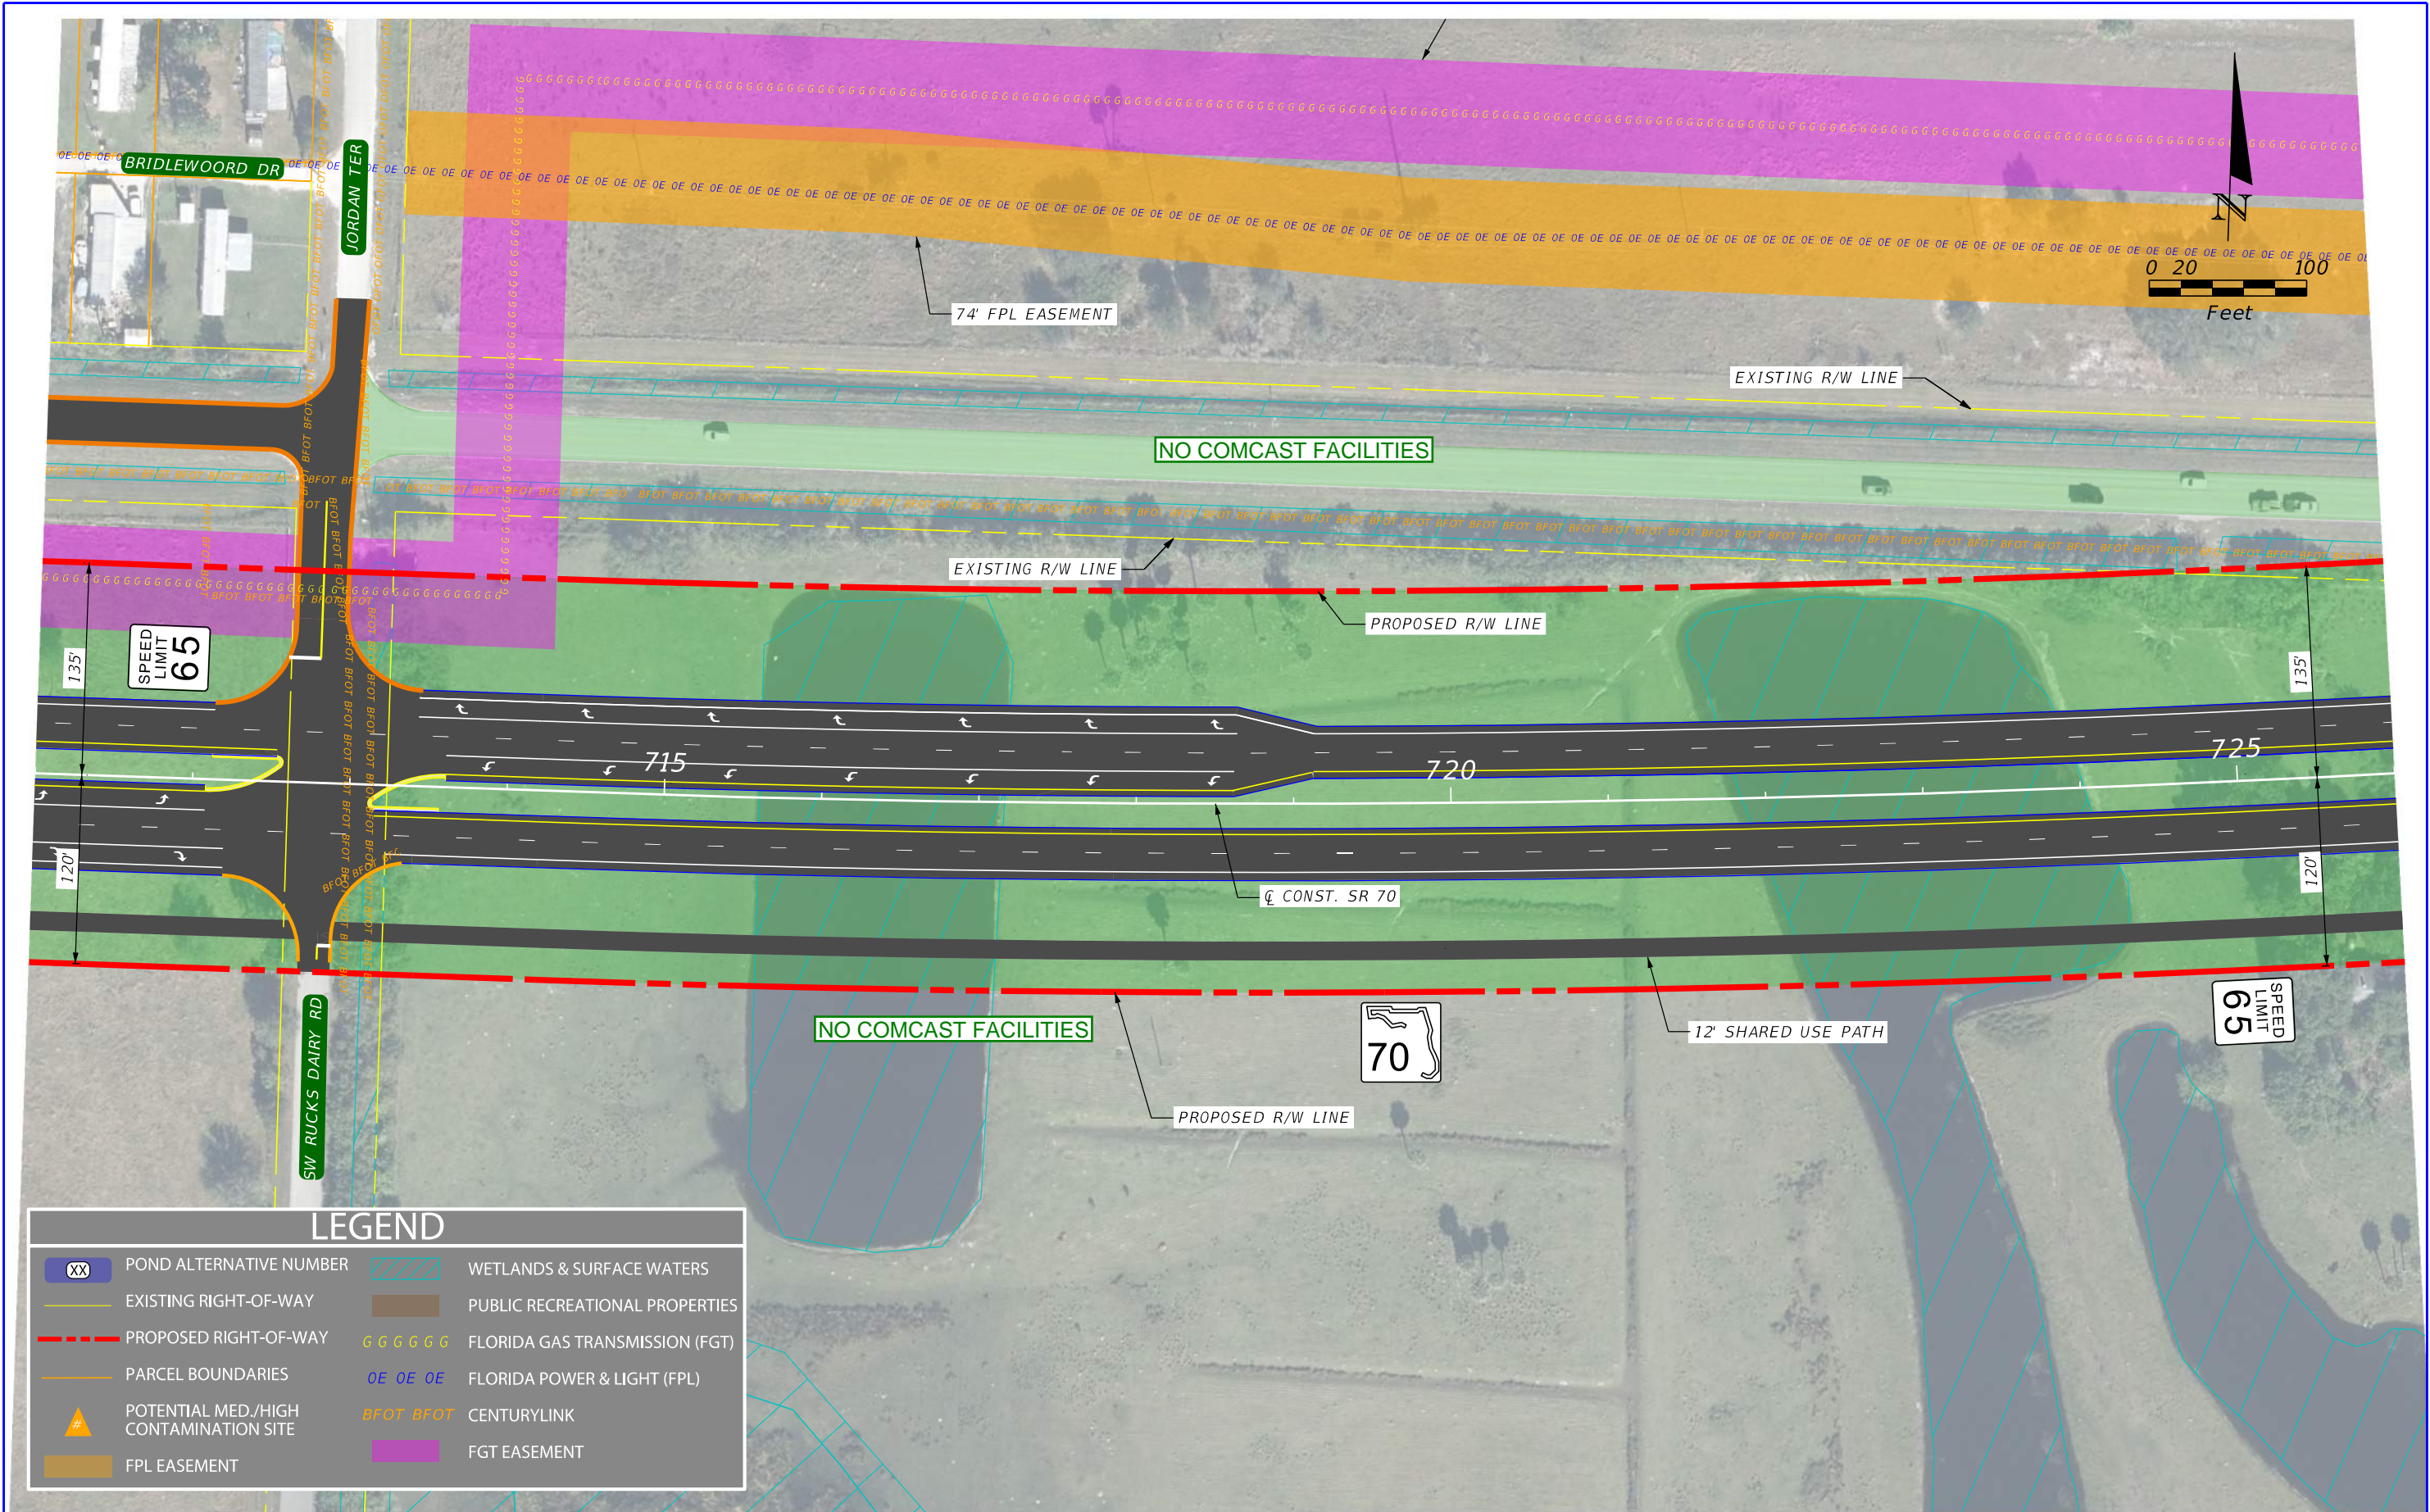

REVISIONS				ENGINEER OF RECORD		STATE OF FLORIDA DEPARTMENT OF TRANSPORTATION		ALTERNATIVE 1 CONCEPT PLAN	SHEET NO. 23
DATE	DESCRIPTION	DATE	DESCRIPTION	NICHOLAS JOHN CLAVELO LICENSE NUMBER: 84366 SCALAR CONSULTING GROUP INC. 5713 CORPORATE WAY, SUITE 200 WEST PALM BEACH, FLORIDA 33407		ROAD NO.	COUNTY		
						SR 70	HIGHLANDS OKEECHOBEE	FINANCIAL PROJECT ID 450334-1-22-01	

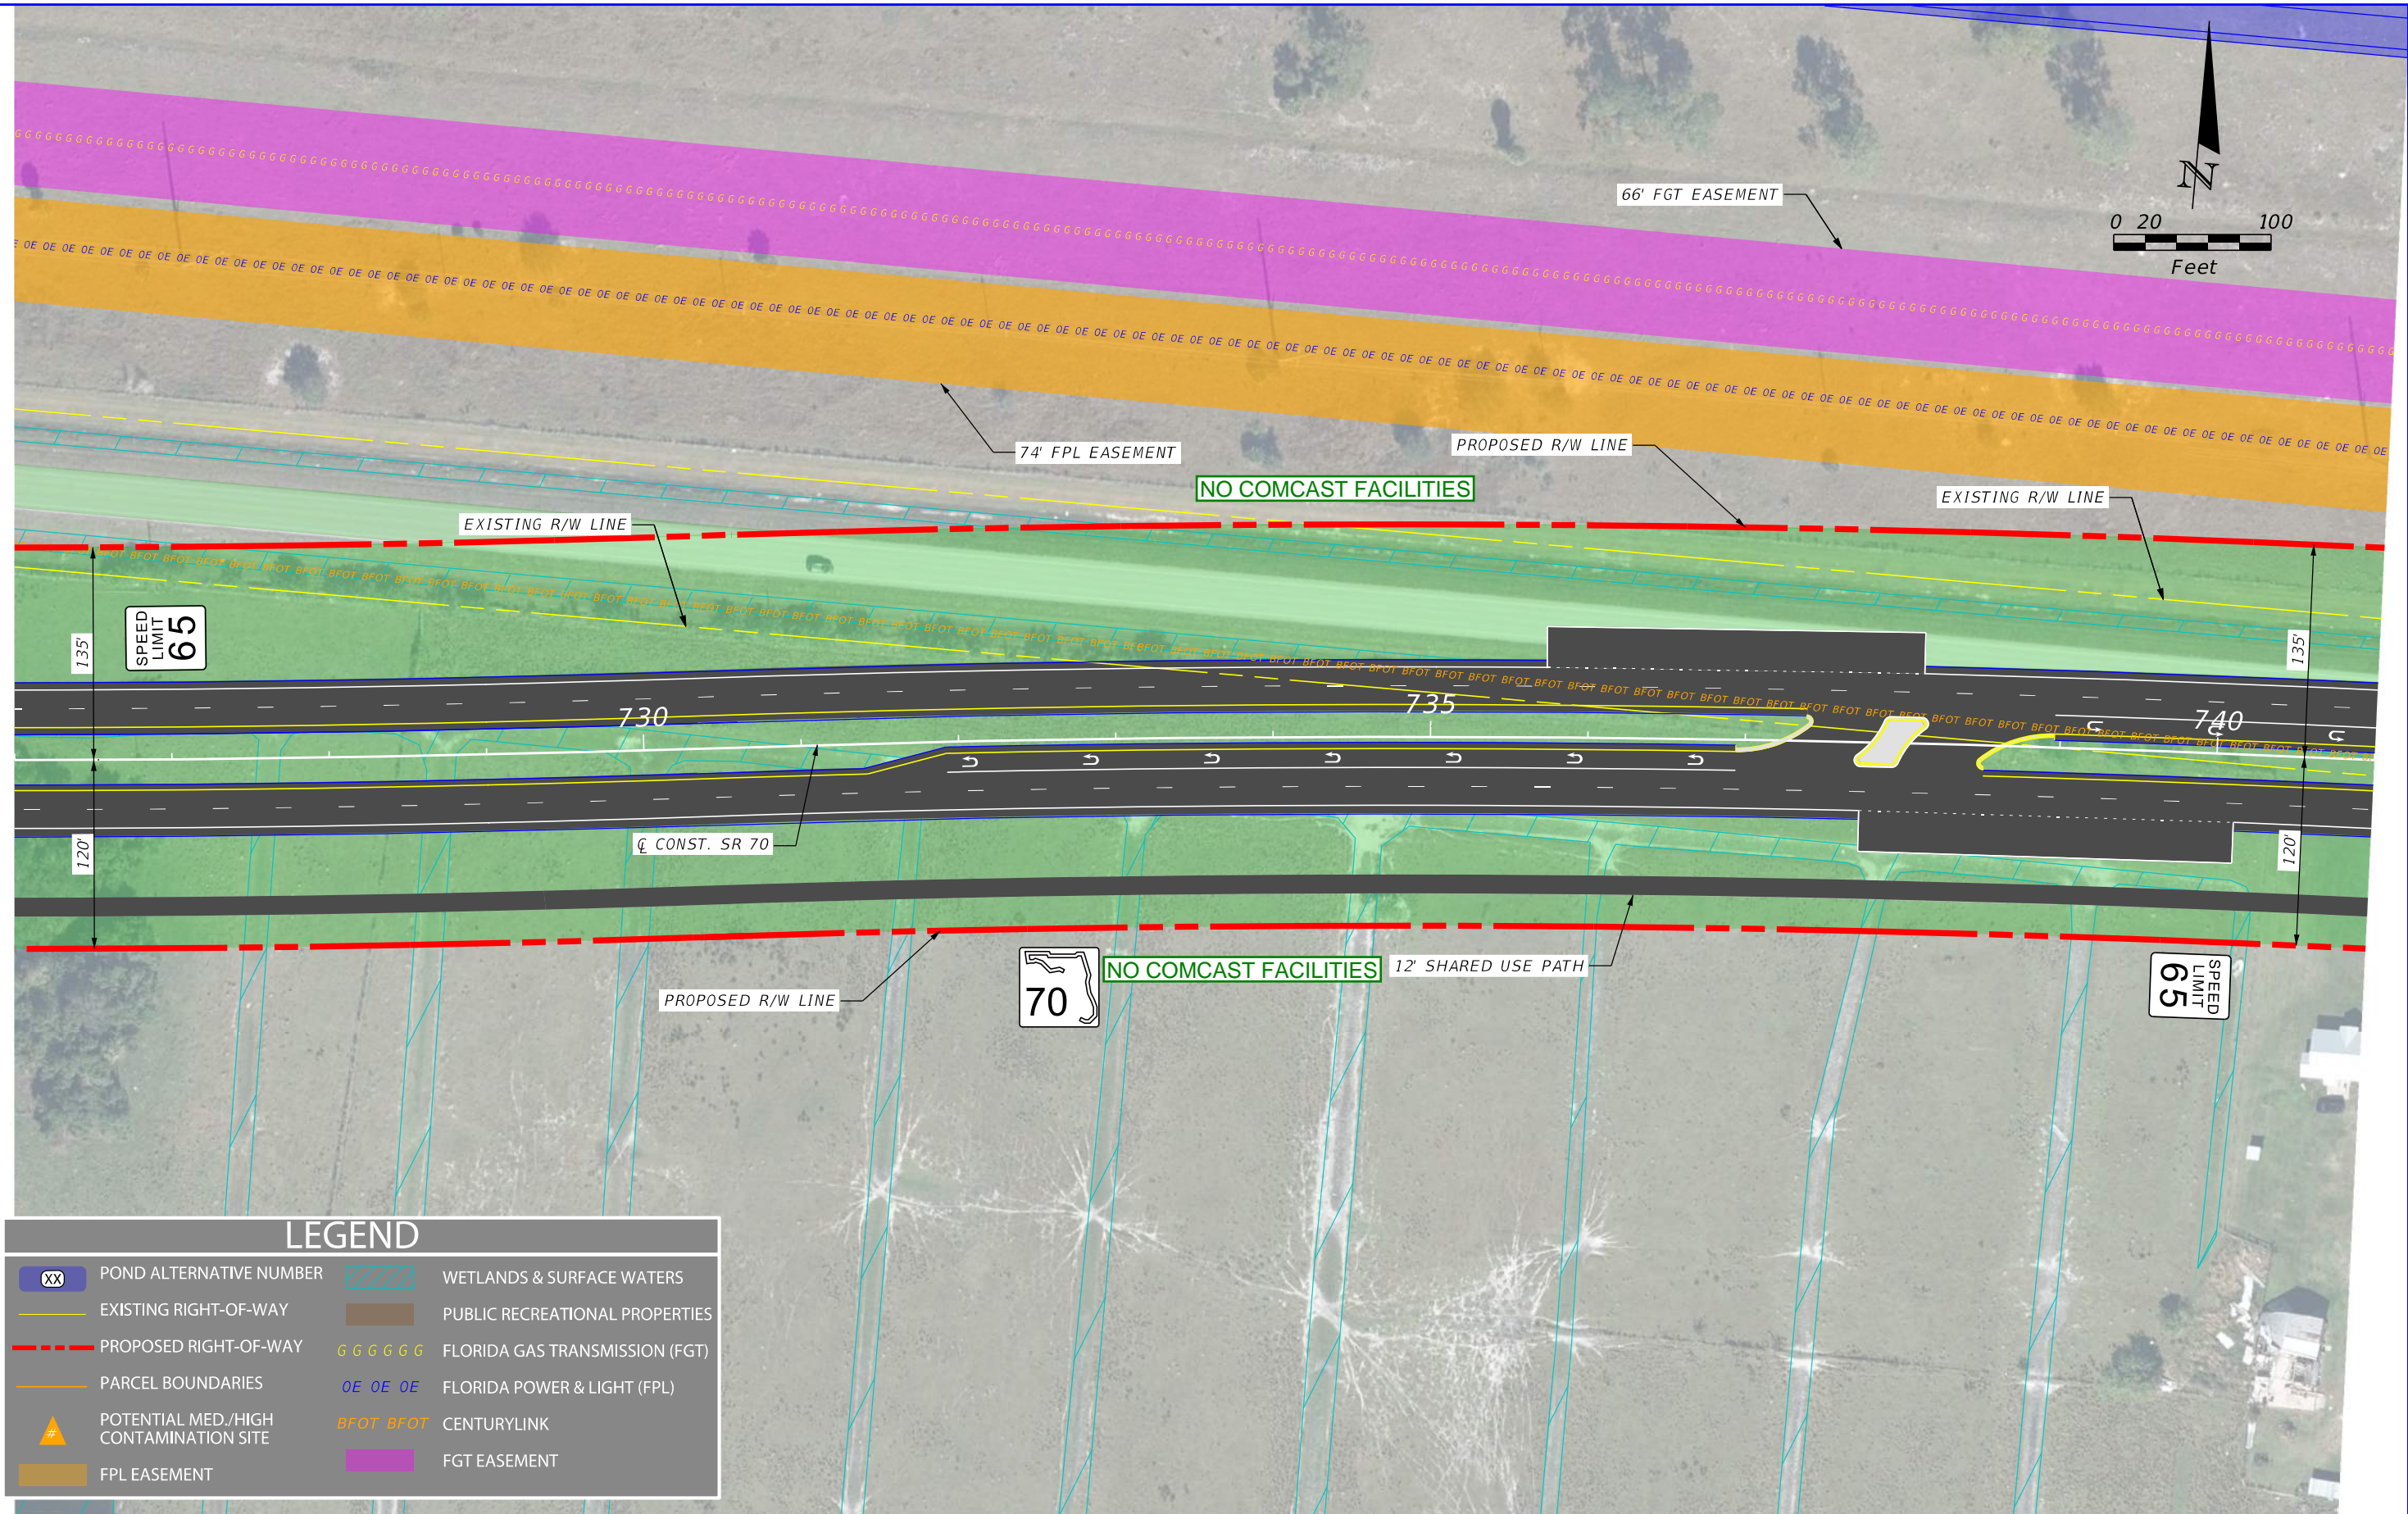

LEGEND

XX

POND ALTERNATIVE NUMBER

EXISTING RIGHT-OF-WAY

PROPOSED RIGHT-OF-WAY

PARCEL BOUNDARIES

#

POTENTIAL MED./HIGH CONTAMINATION SITE

FPL EASEMENT

WETLANDS & SURFACE WATERS

PUBLIC RECREATIONAL PROPERTIES

GGGGGG

FLORIDA GAS TRANSMISSION (FGT)

OE OE OE

FLORIDA POWER & LIGHT (FPL)


BFOT BFOT

CENTURYLINK


FGT EASEMENT

REVISIONS				ENGINEER OF RECORD	STATE OF FLORIDA DEPARTMENT OF TRANSPORTATION			SHEET NO. 24
DATE	DESCRIPTION	DATE	DESCRIPTION		ROAD NO.	COUNTY	FINANCIAL PROJECT ID	
					SR 70	HIGHLANDS OKEECHOBEE	450334-1-22-01	

ALTERNATIVE 1
CONCEPT PLAN

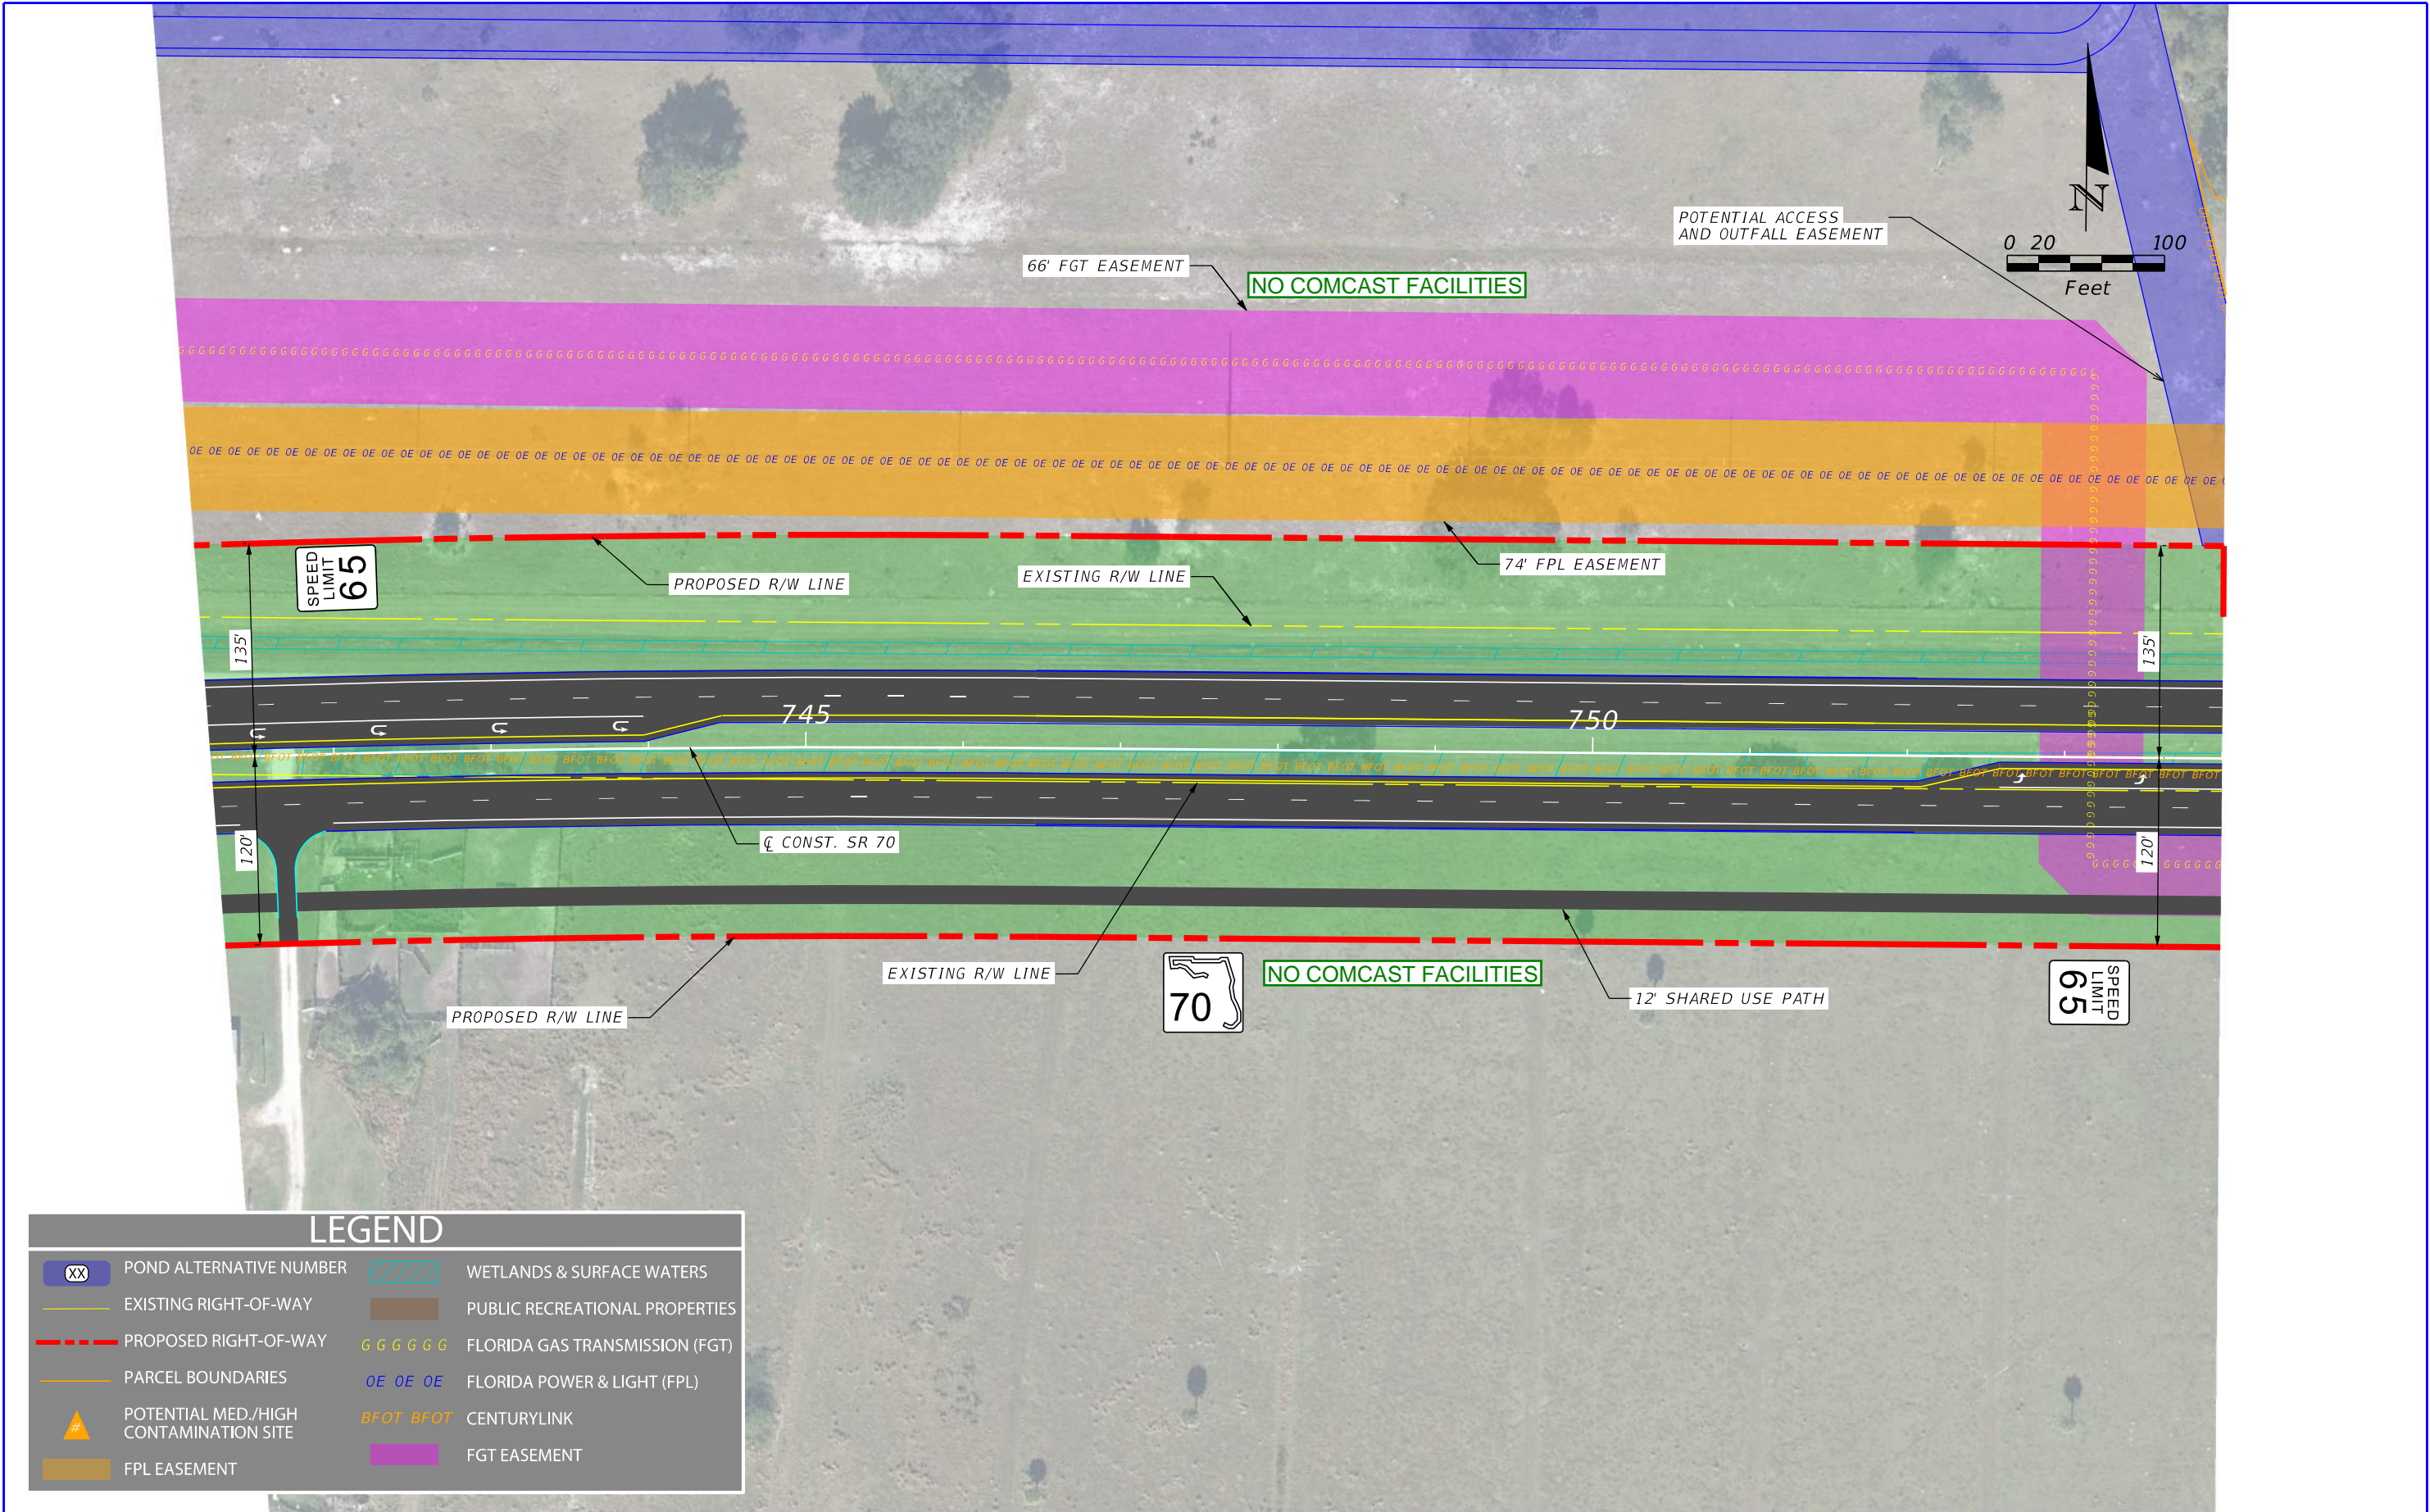

REVISIONS				ENGINEER OF RECORD		STATE OF FLORIDA DEPARTMENT OF TRANSPORTATION		ALTERNATIVE 1 CONCEPT PLAN	SHEET NO.
DATE	DESCRIPTION	DATE	DESCRIPTION	NICHOLAS JOHN CLAVELO LICENSE NUMBER: 84366 SCALAR CONSULTING GROUP INC. 5713 CORPORATE WAY, SUITE 200 WEST PALM BEACH, FLORIDA 33407		ROAD NO.	COUNTY		
						SR 70	HIGHLANDS OKEECHOBEE	FINANCIAL PROJECT ID 450334-1-22-01	25

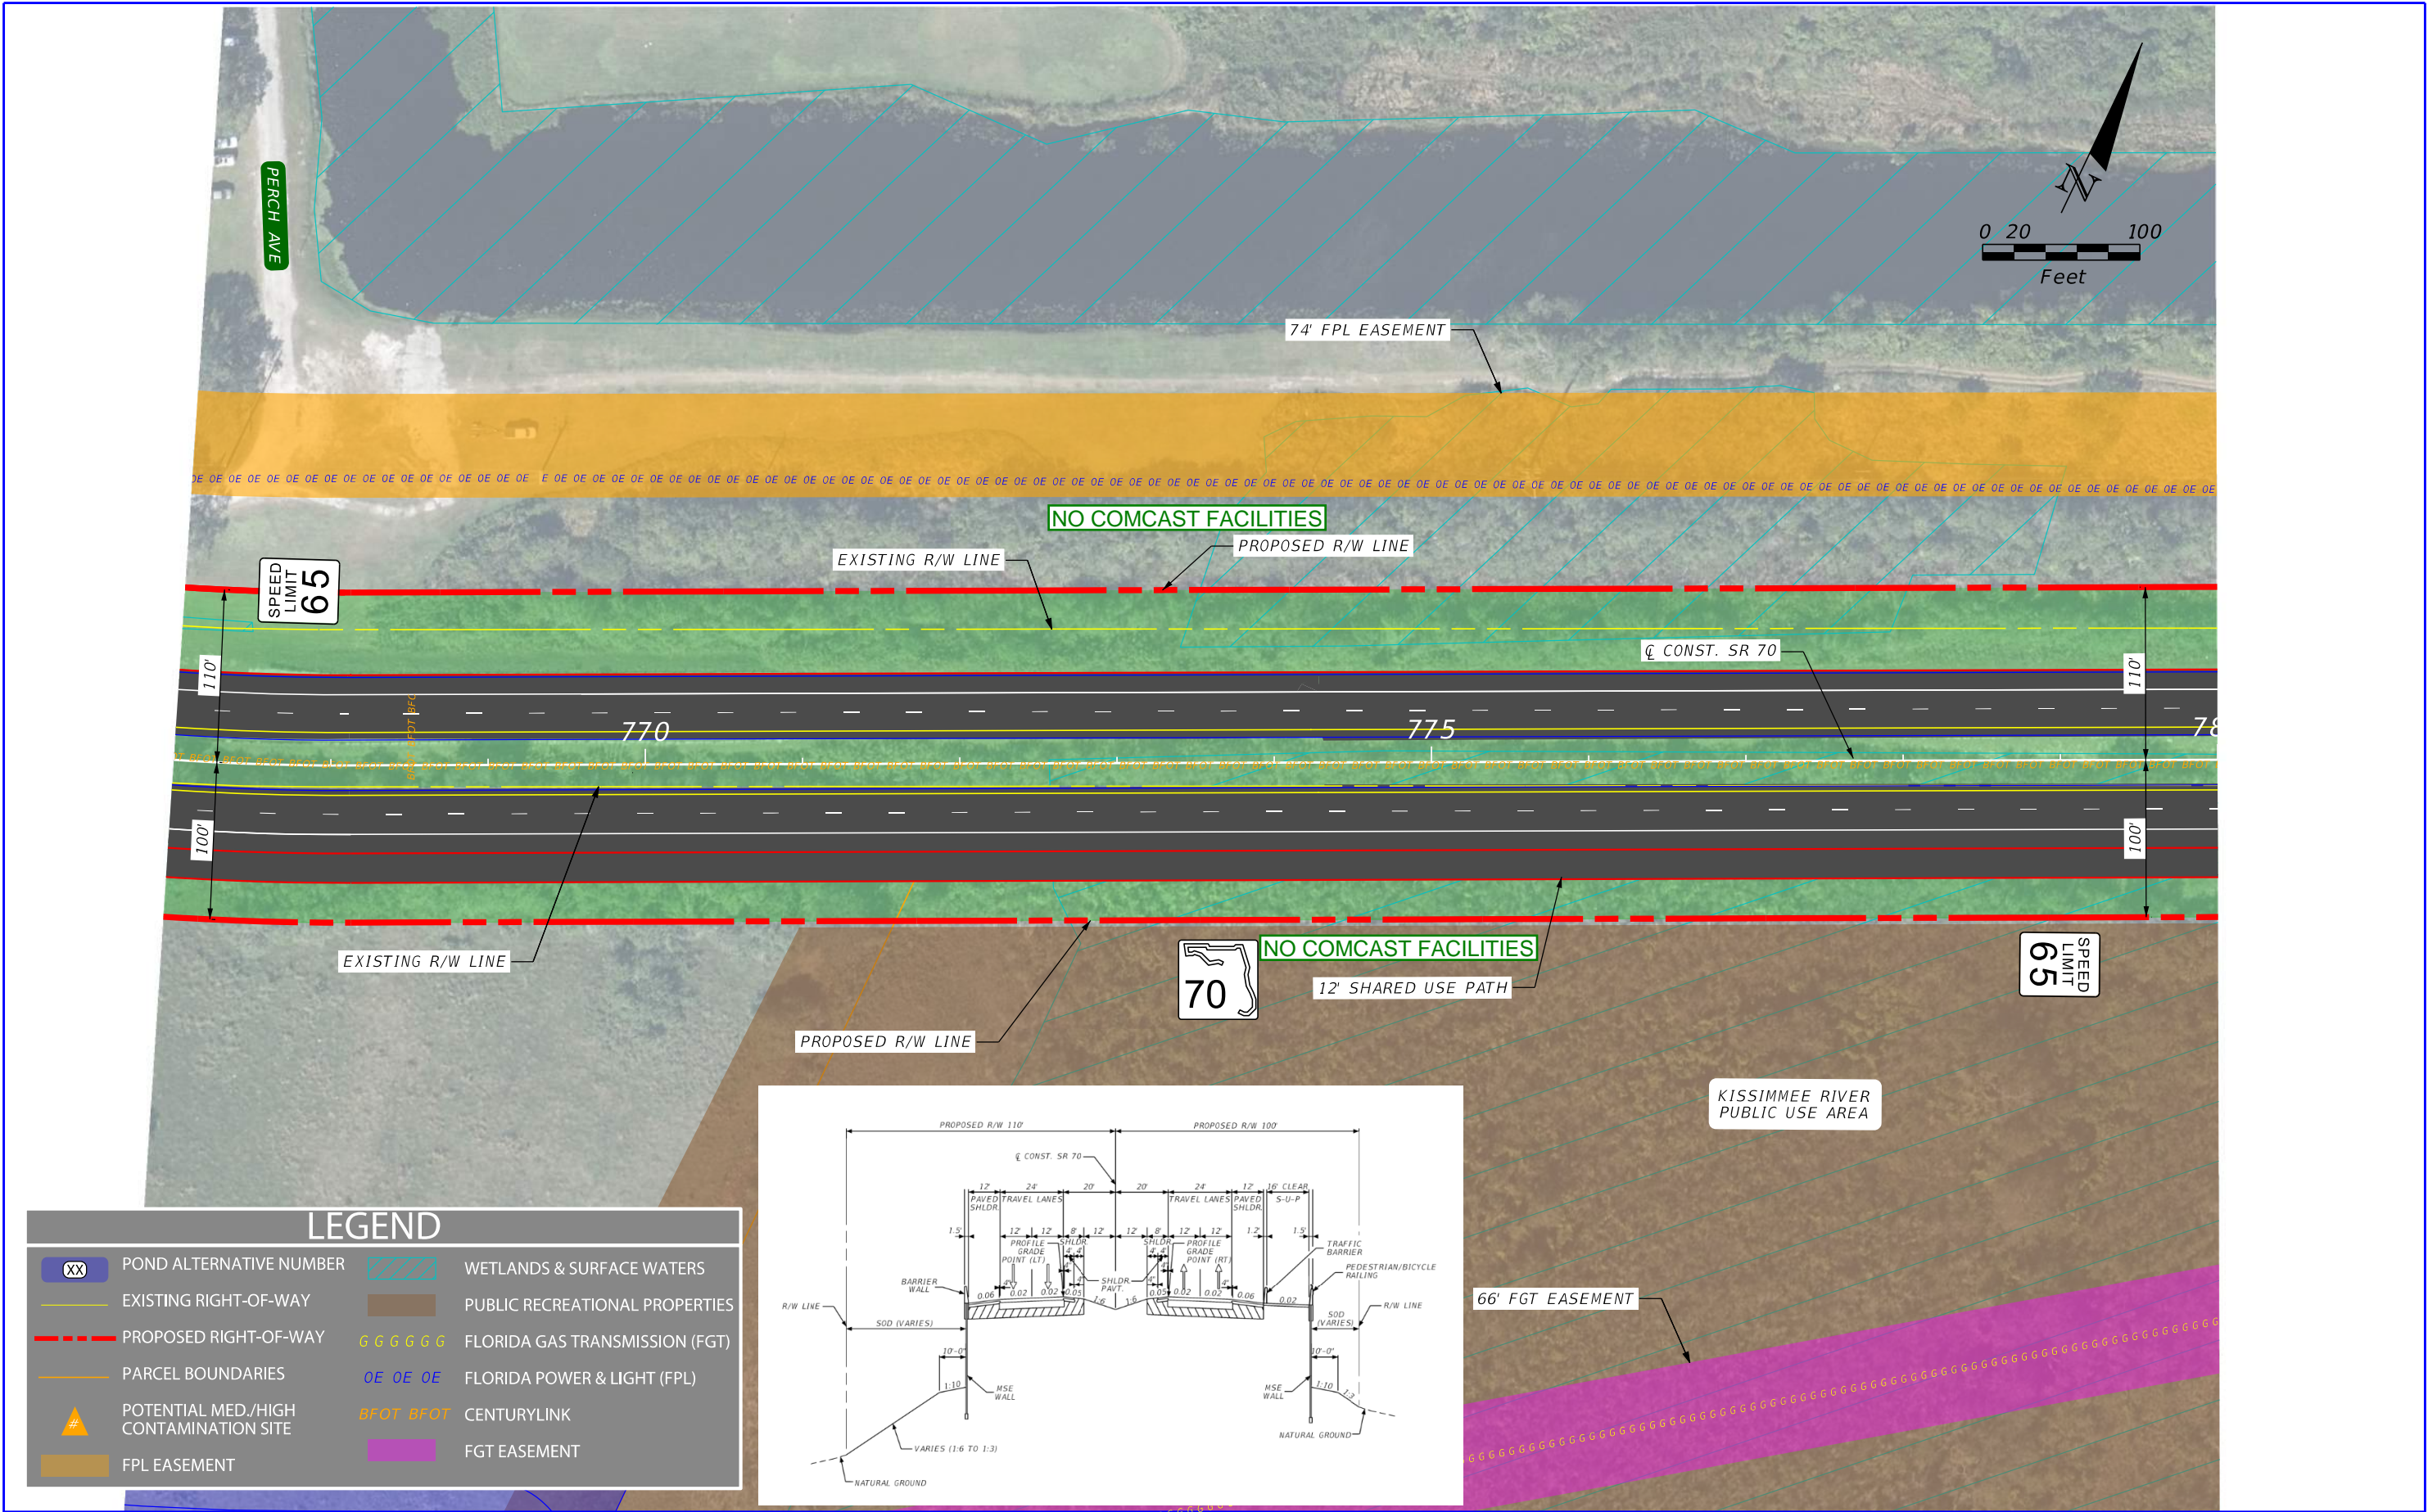

LEGEND

XX

POND ALTERNATIVE NUMBER

EXISTING RIGHT-OF-WAY

PROPOSED RIGHT-OF-WAY

PARCEL BOUNDARIES

#

POTENTIAL MED./HIGH CONTAMINATION SITE

FPL EASEMENT

WETLANDS & SURFACE WATERS

PUBLIC RECREATIONAL PROPERTIES

GGGGGG

FLORIDA GAS TRANSMISSION (FGT)

OE OE OE


FLORIDA POWER & LIGHT (FPL)

BFOT BFOT

CENTURYLINK

FGT EASEMENT

REVISIONS				ENGINEER OF RECORD		STATE OF FLORIDA DEPARTMENT OF TRANSPORTATION		ALTERNATIVE 1 CONCEPT PLAN	SHEET NO. 27
DATE	DESCRIPTION	DATE	DESCRIPTION	NICHOLAS JOHN CLAVELLO LICENSE NUMBER: 84366 SCALAR CONSULTING GROUP INC. 5713 CORPORATE WAY, SUITE 200 WEST PALM BEACH, FLORIDA 33407		ROAD NO.	COUNTY		
						SR 70	HIGHLANDS OKEECHOBEE	FINANCIAL PROJECT ID 450334-1-22-01	

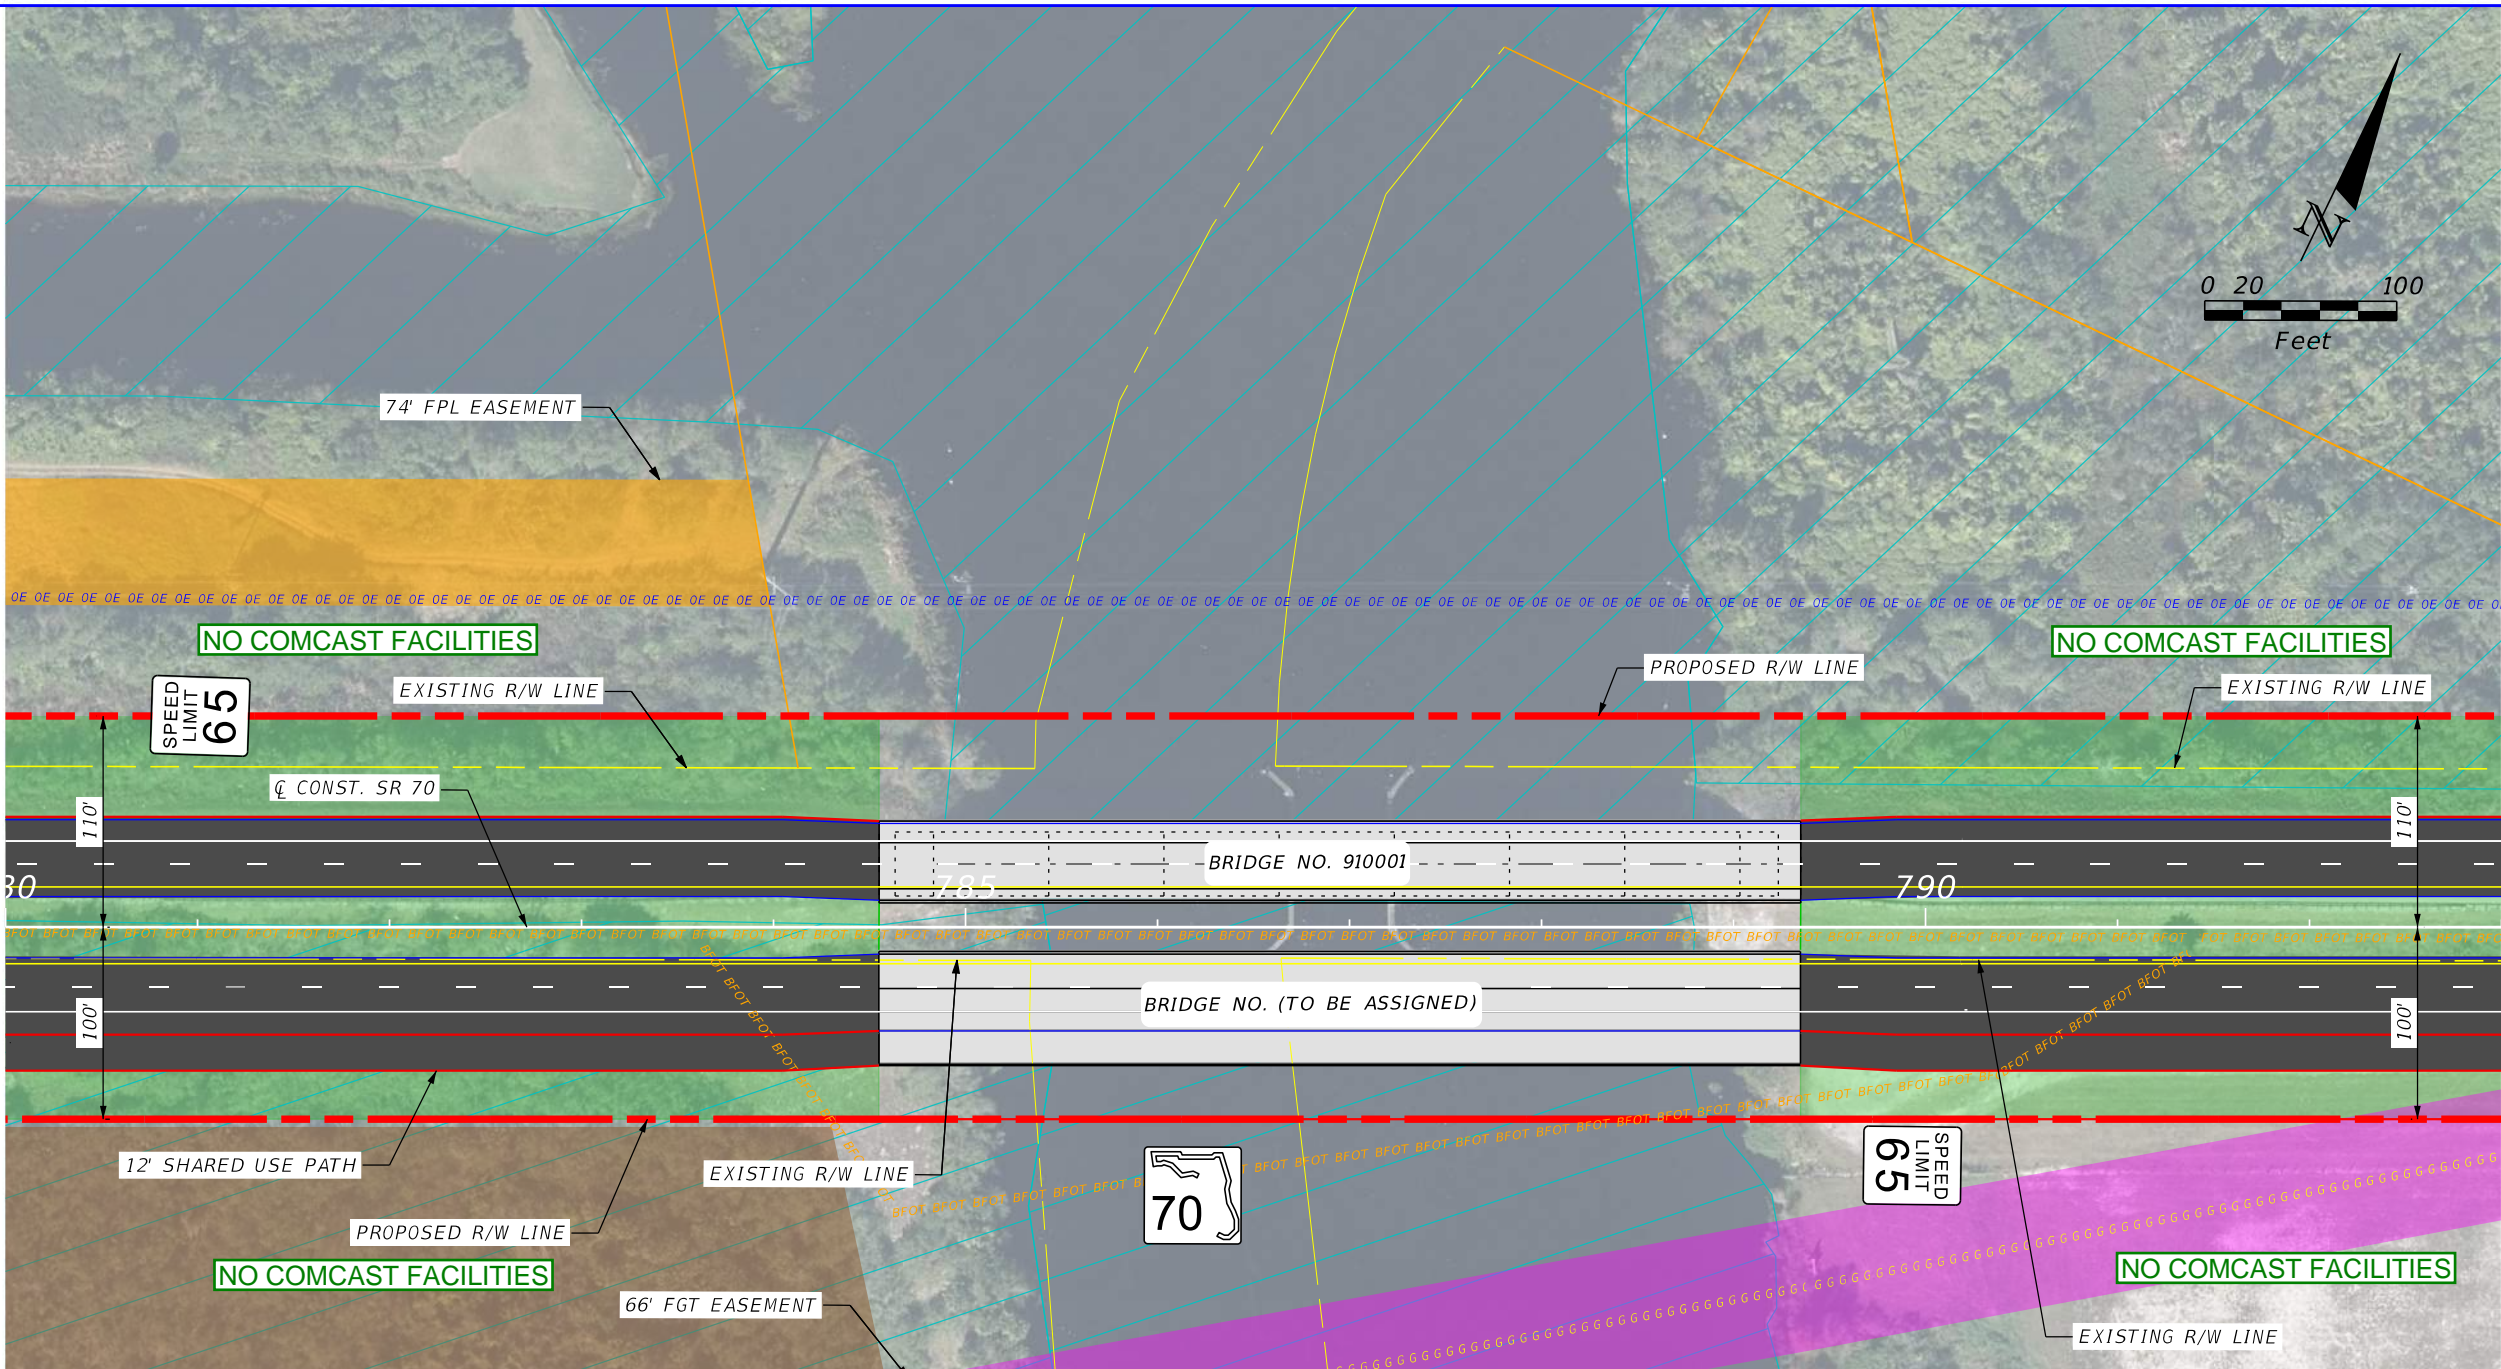

LEGEND

XX

POND ALTERNATIVE NUMBER

EXISTING RIGHT-OF-WAY

PROPOSED RIGHT-OF-WAY

PARCEL BOUNDARIES

#

POTENTIAL MED./HIGH CONTAMINATION SITE

FPL EASEMENT

WETLANDS & SURFACE WATERS

PUBLIC RECREATIONAL PROPERTIES

GGGGGG

FLORIDA GAS TRANSMISSION (FGT)


OE OE OE

FLORIDA POWER & LIGHT (FPL)




BEOT BFOT

CENTURYLINK

FGT EASEMENT

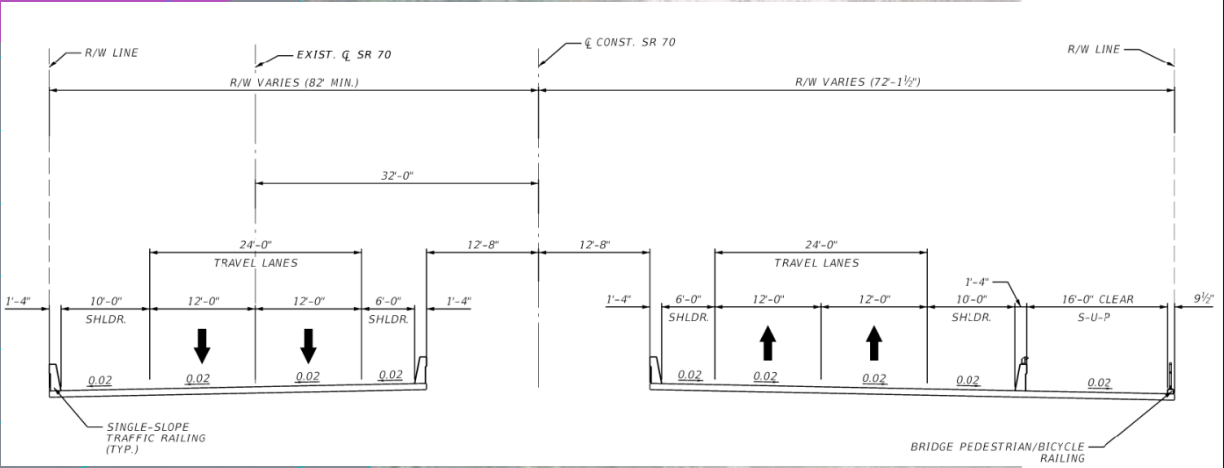


REVISIONS				ENGINEER OF RECORD	STATE OF FLORIDA DEPARTMENT OF TRANSPORTATION			ALTERNATIVE 1 CONCEPT PLAN	SHEET NO.
DATE	DESCRIPTION	DATE	DESCRIPTION	NICHOLAS JOHN CLAVELLO LICENSE NUMBER: 84366 SCALAR CONSULTING GROUP INC. 5713 CORPORATE WAY, SUITE 200 WEST PALM BEACH, FLORIDA 33407	ROAD NO.	COUNTY	FINANCIAL PROJECT ID		28
					SR 70	HIGHLANDS OKEECHOBEE	450334-1-22-01		

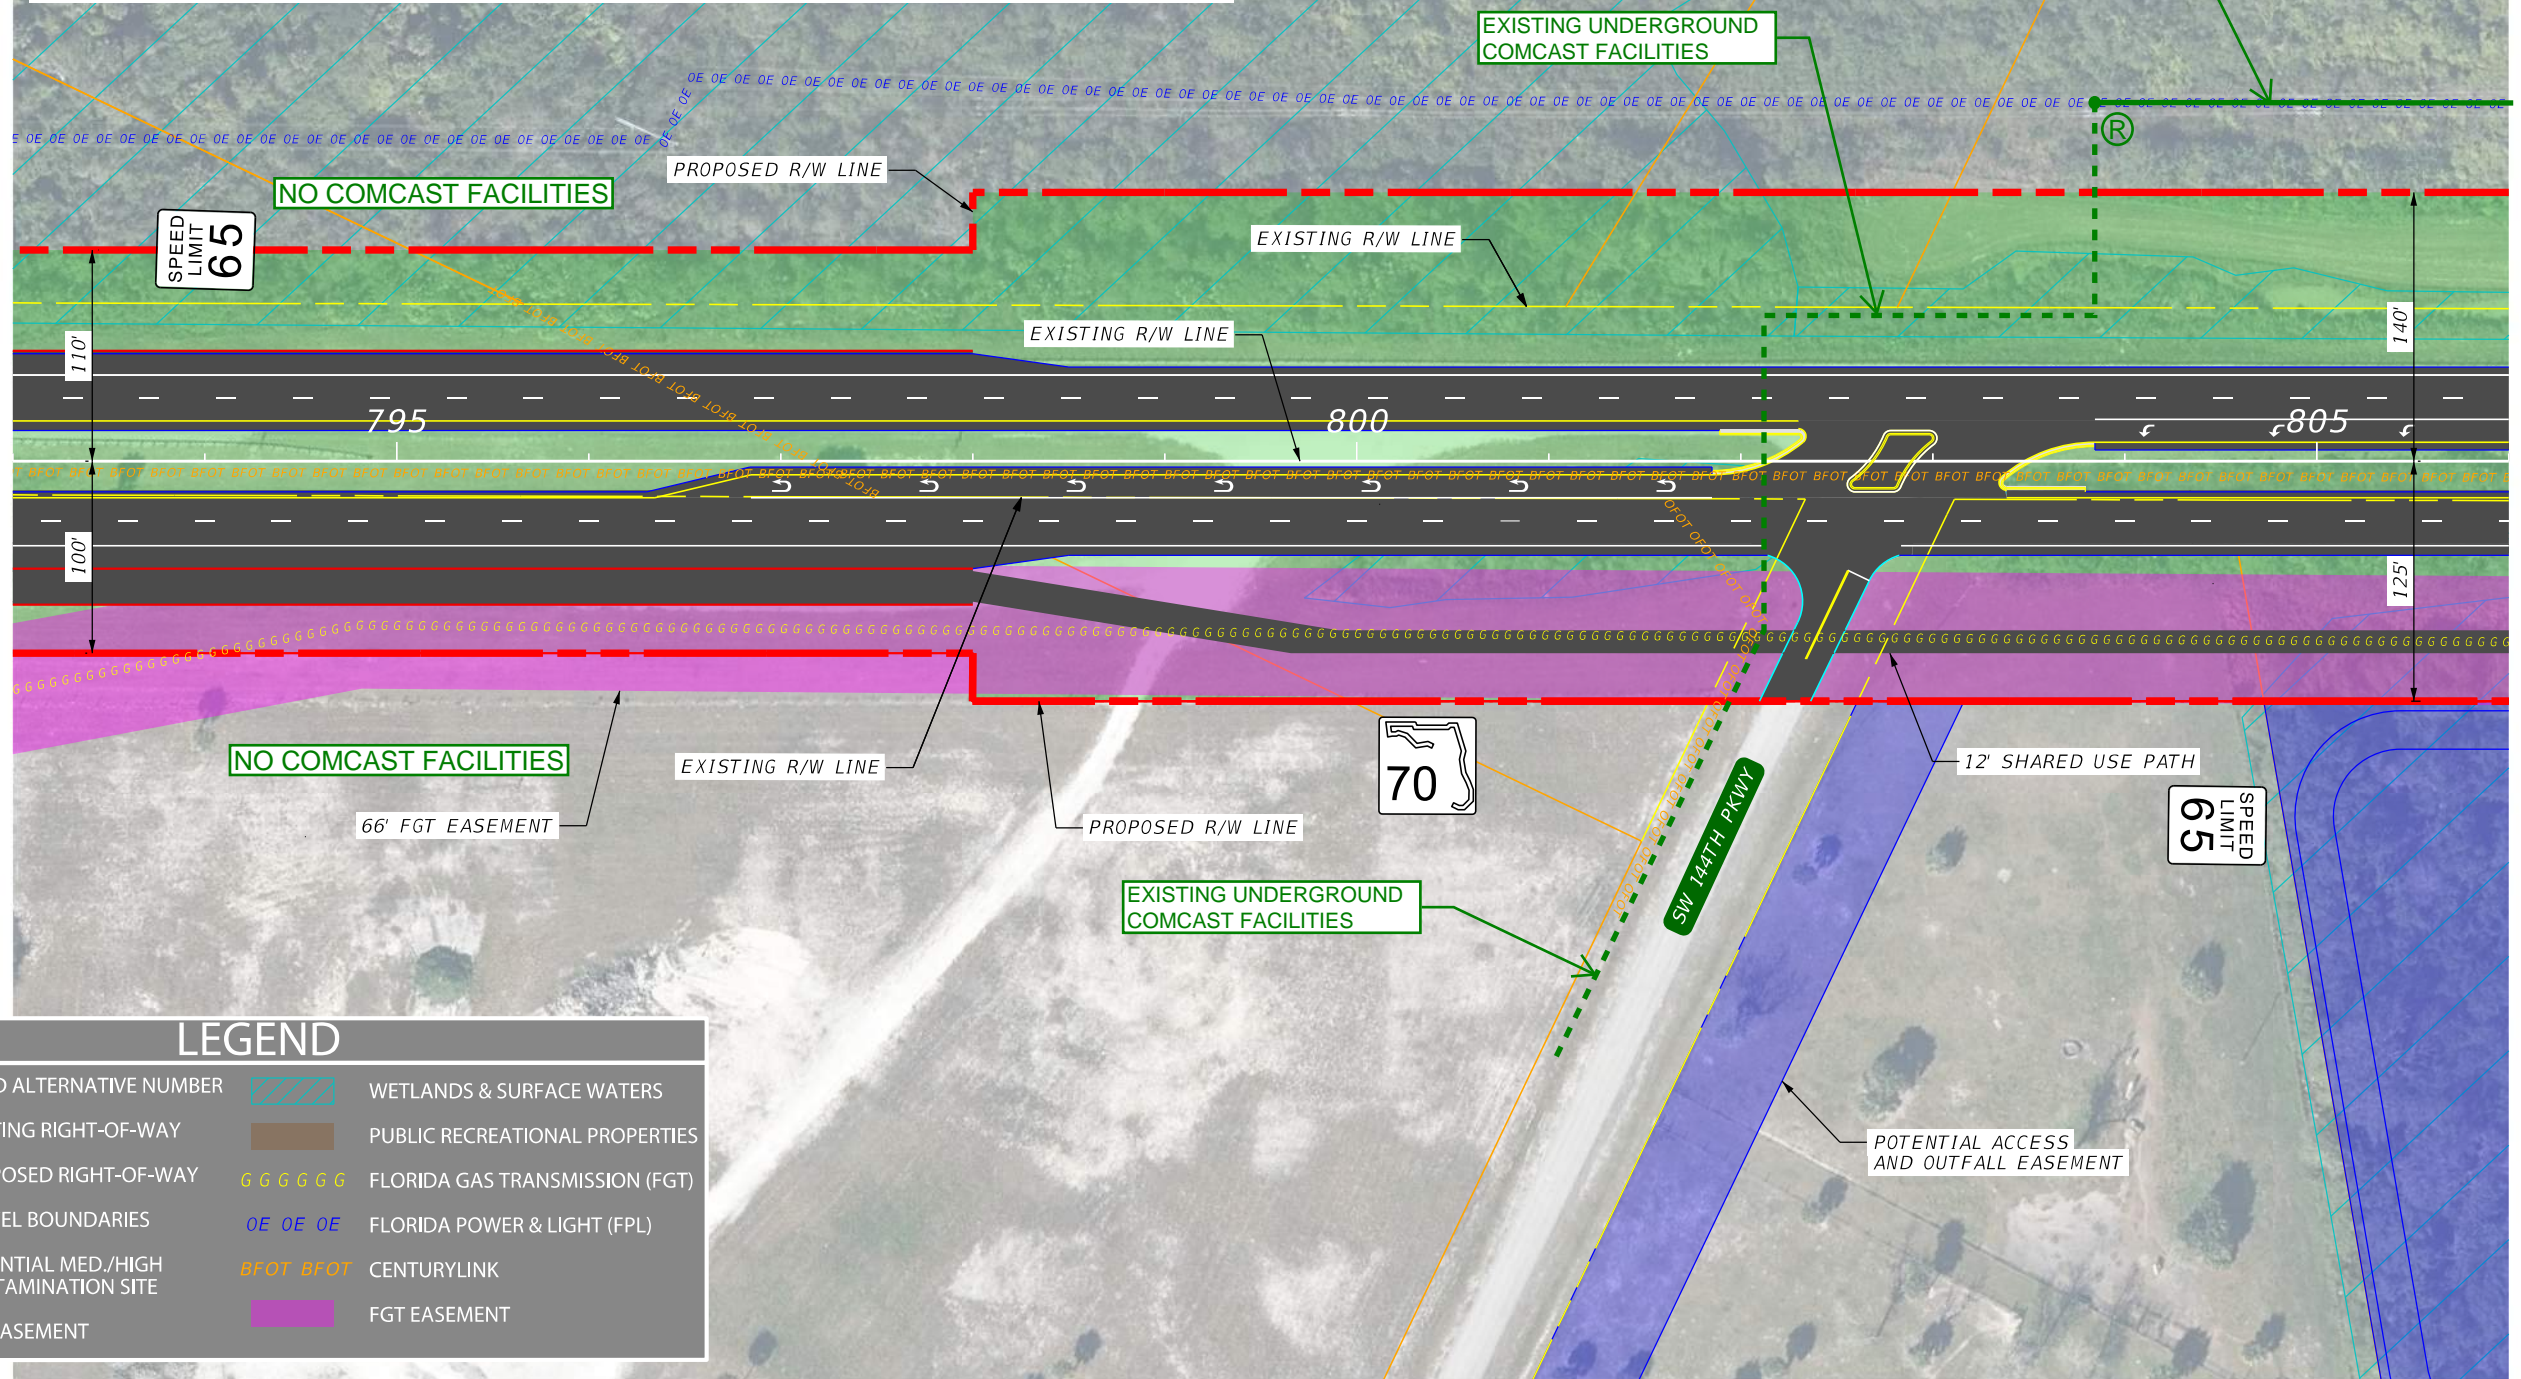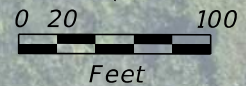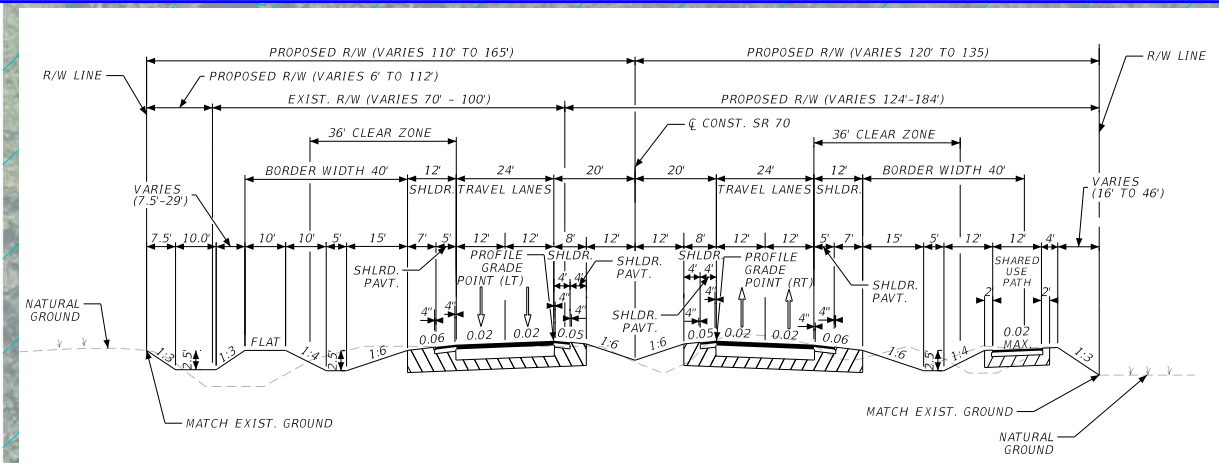

LEGEND

	POND ALTERNATIVE NUMBER		WETLANDS & SURFACE WATERS
	EXISTING RIGHT-OF-WAY		PUBLIC RECREATIONAL PROPERTIES
	PROPOSED RIGHT-OF-WAY		FLORIDA GAS TRANSMISSION (FGT)
	PARCEL BOUNDARIES		FLORIDA POWER & LIGHT (FPL)
	POTENTIAL MED./HIGH CONTAMINATION SITE		CENTURYLINK
	FPL EASEMENT		FGT EASEMENT

REVISIONS				ENGINEER OF RECORD		STATE OF FLORIDA DEPARTMENT OF TRANSPORTATION		ALTERNATIVE 1 CONCEPT PLAN	SHEET NO. 29
DATE	DESCRIPTION	DATE	DESCRIPTION	NICHOLAS JOHN CLAVELLO LICENSE NUMBER: 84366 SCALAR CONSULTING GROUP INC. 5713 CORPORATE WAY, SUITE 200 WEST PALM BEACH, FLORIDA 33407		ROAD NO.	COUNTY		
						SR 70	HIGHLANDS OKEECHOBEE	FINANCIAL PROJECT ID 450334-1-22-01	

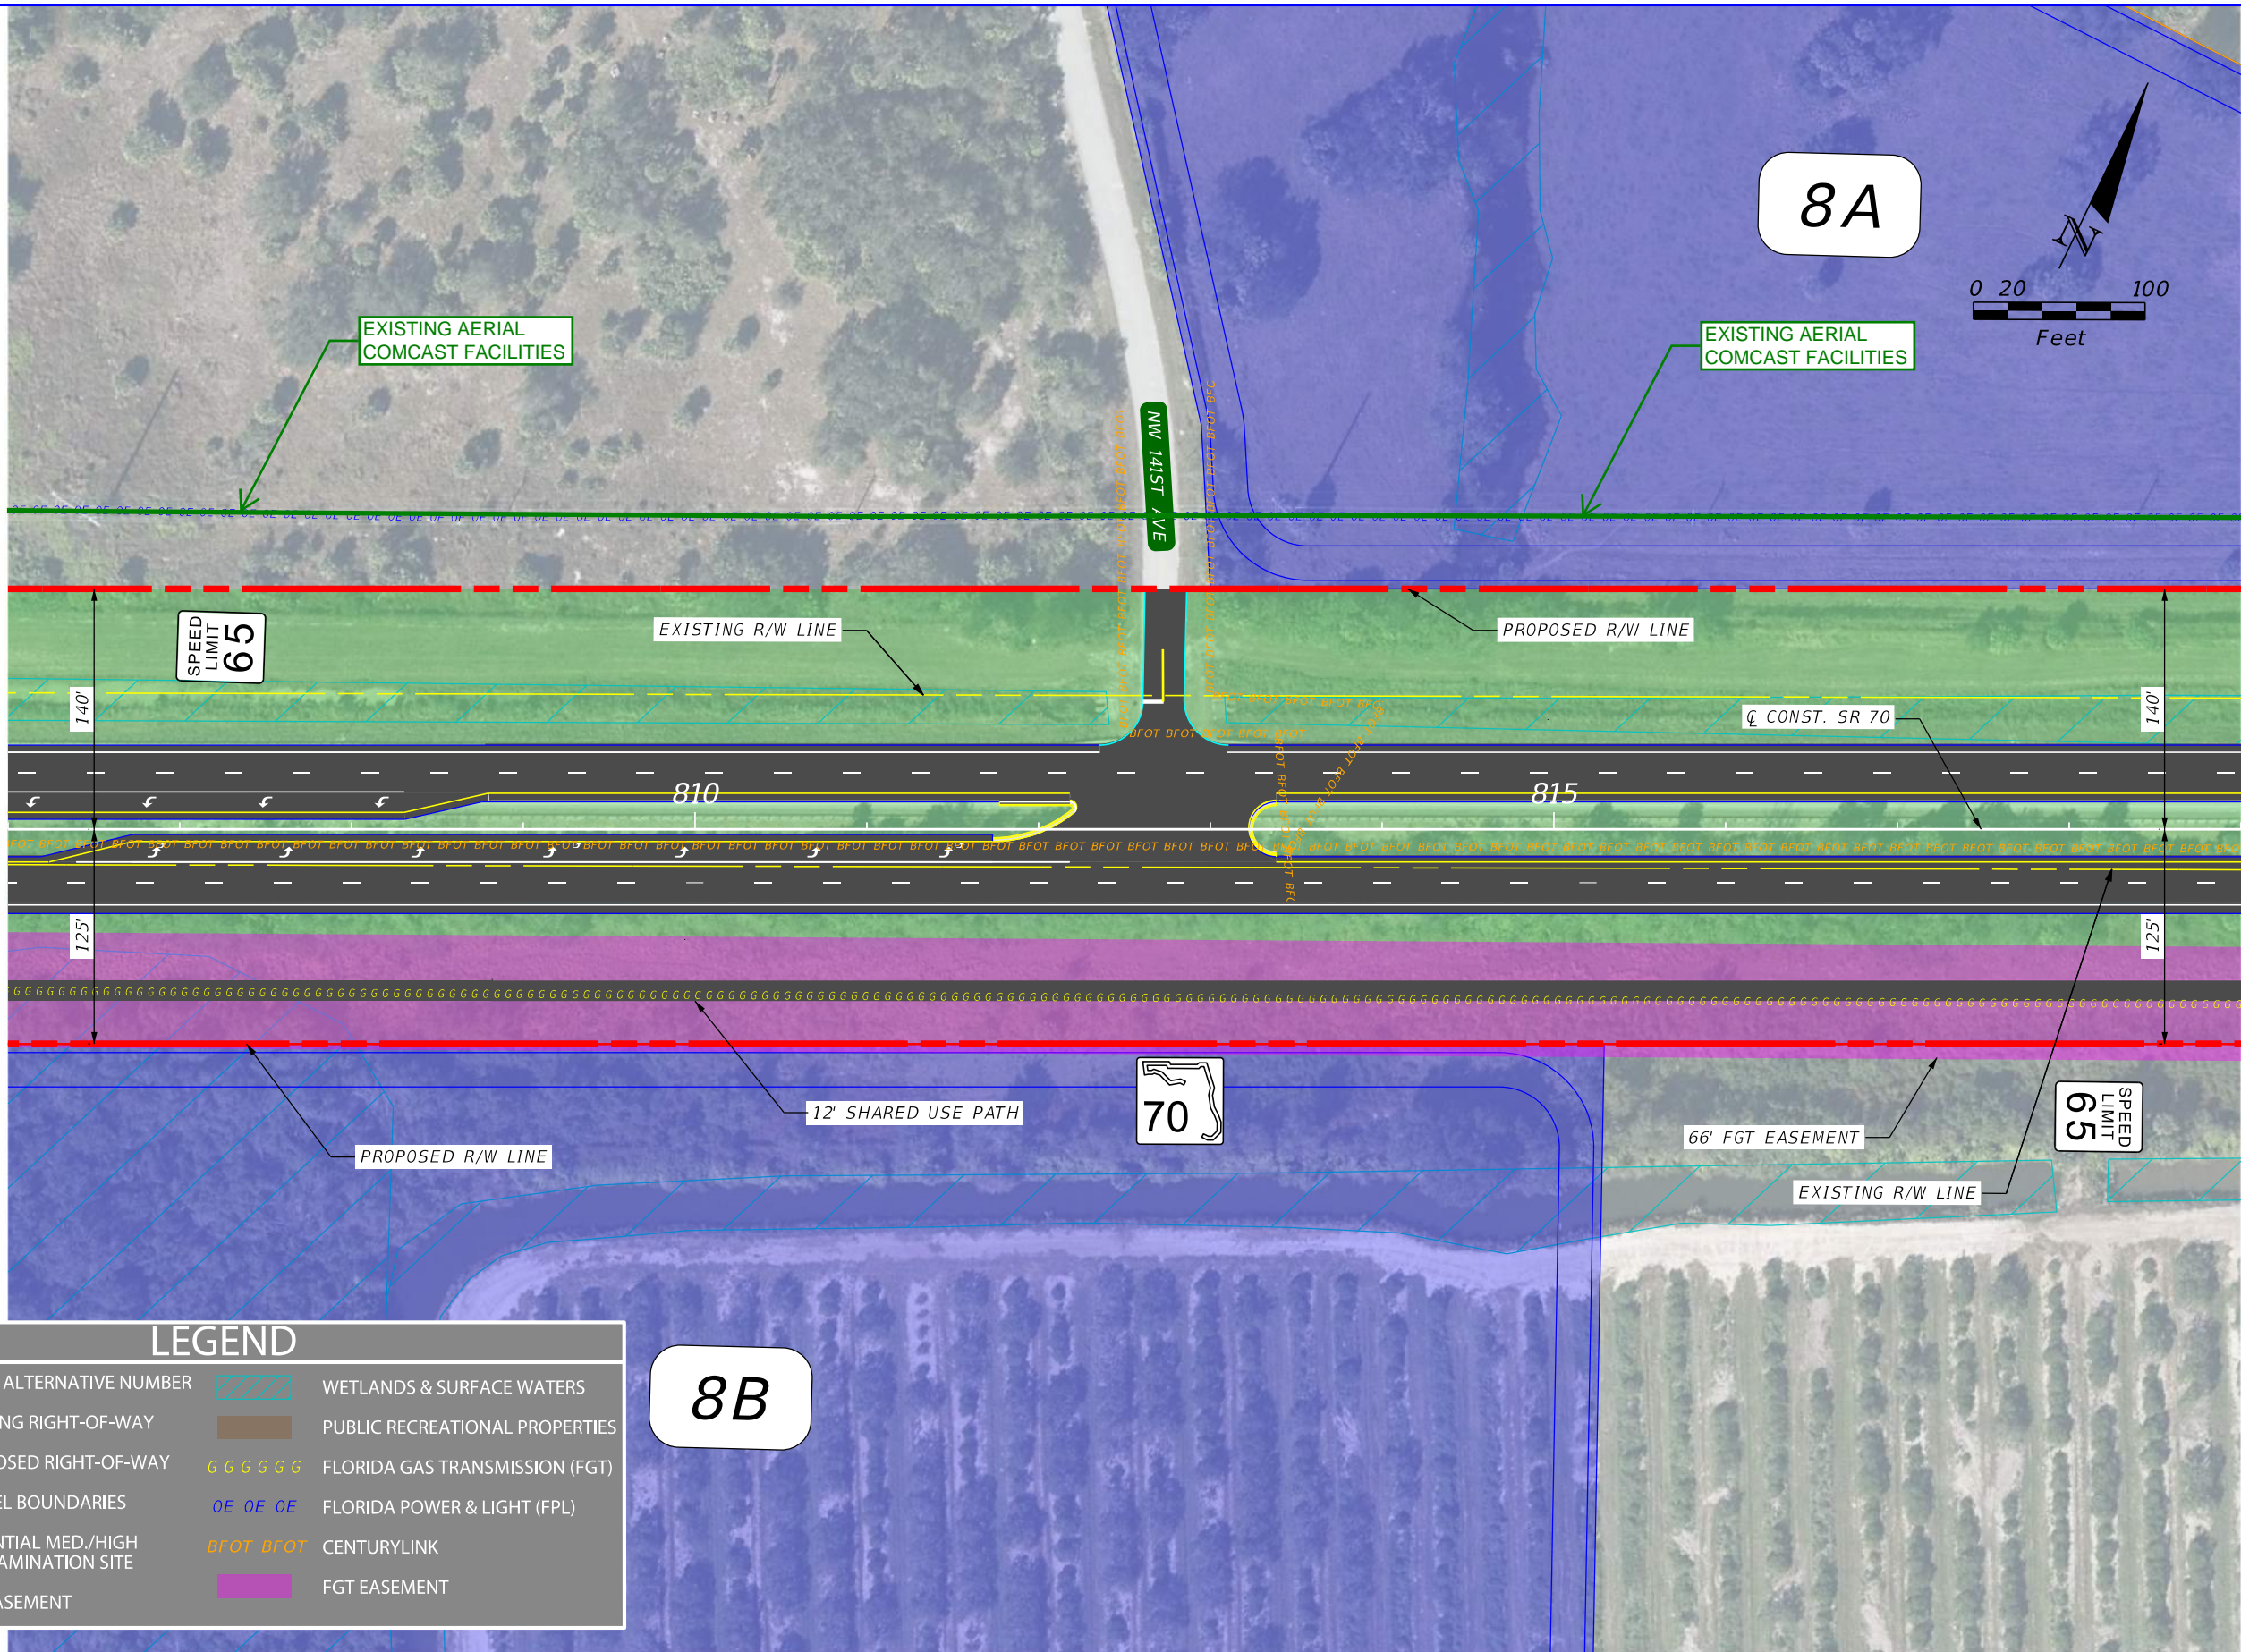

LEGEND

XX

POND ALTERNATIVE NUMBER

EXISTING RIGHT-OF-WAY

PROPOSED RIGHT-OF-WAY

PARCEL BOUNDARIES

POTENTIAL MED./HIGH CONTAMINATION SITE

FPL EASEMENT

WETLANDS & SURFACE WATERS

PUBLIC RECREATIONAL PROPERTIES

GGGGGG

FLORIDA GAS TRANSMISSION (FGT)

OE OE OE


FLORIDA POWER & LIGHT (FPL)

BFOT BFOT

CENTURYLINK

FGT EASEMENT

REVISIONS				ENGINEER OF RECORD		STATE OF FLORIDA DEPARTMENT OF TRANSPORTATION		ALTERNATIVE 1 CONCEPT PLAN	SHEET NO. 30
DATE	DESCRIPTION	DATE	DESCRIPTION	NICHOLAS JOHN CLAVELO LICENSE NUMBER: 84366 SCALAR CONSULTING GROUP INC. 5713 CORPORATE WAY, SUITE 200 WEST PALM BEACH, FLORIDA 33407		ROAD NO.	COUNTY		
						SR 70	HIGHLANDS OKEECHOBEE	FINANCIAL PROJECT ID 450334-1-22-01	

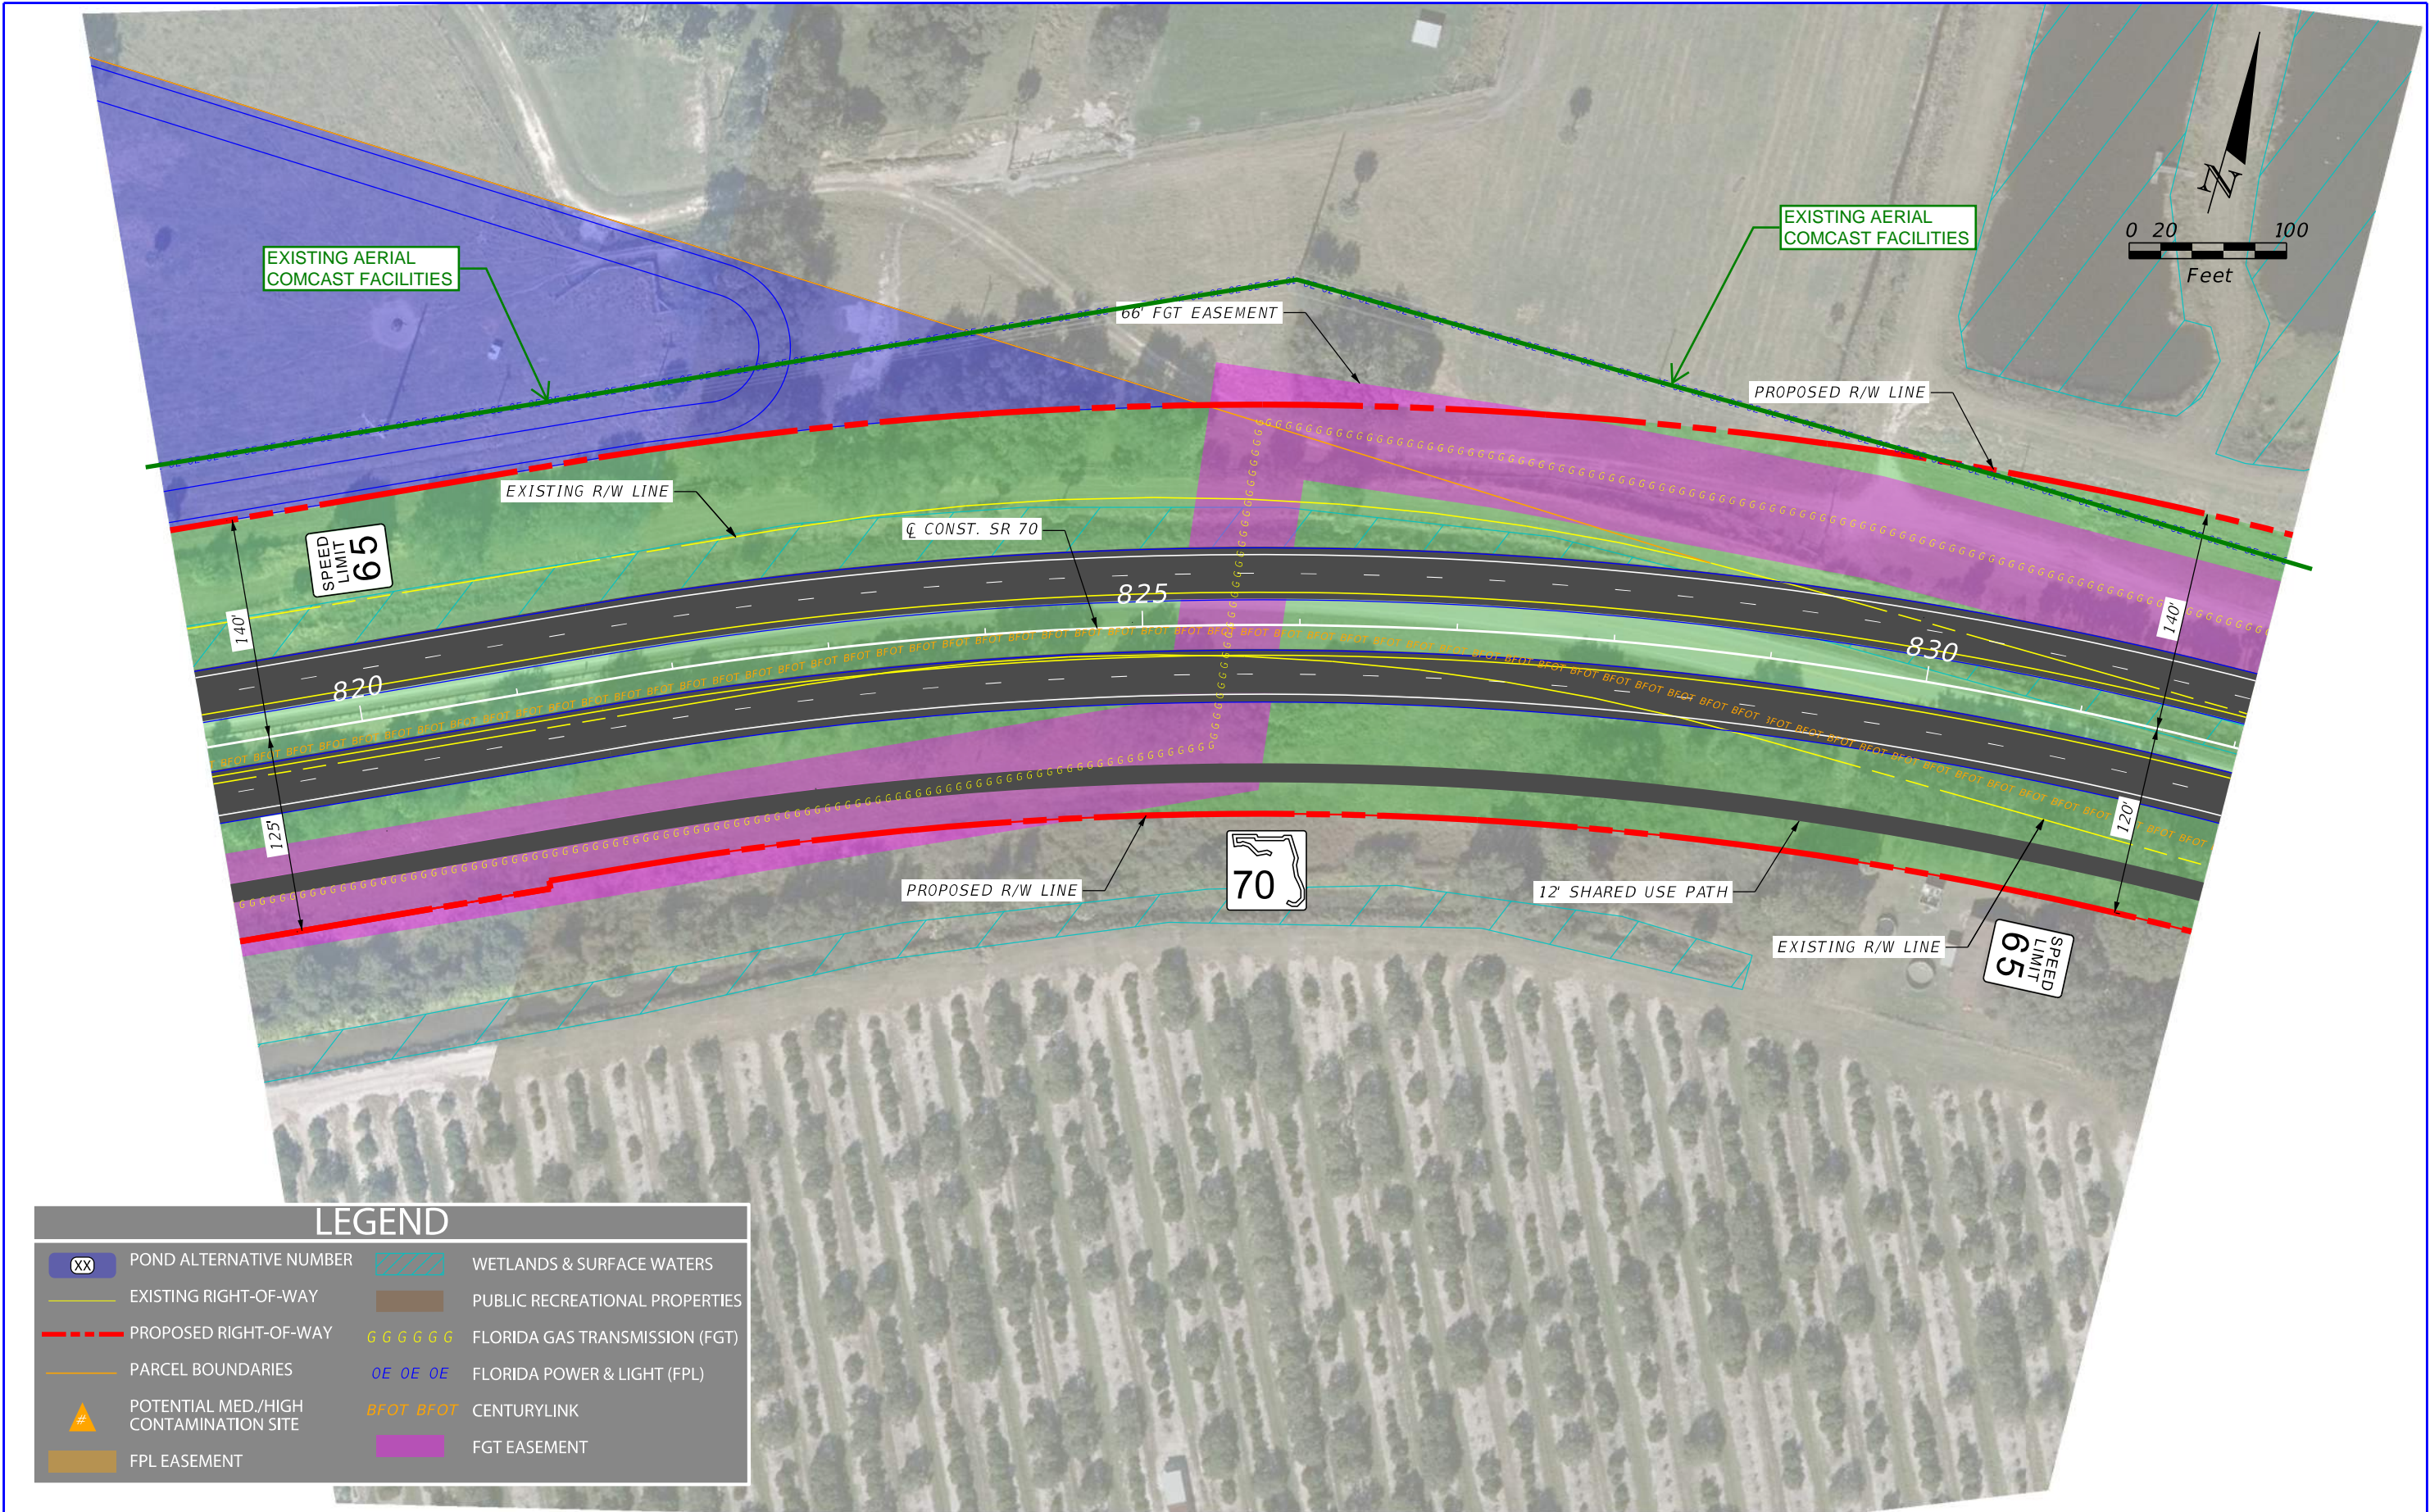

LEGEND

XX

POND ALTERNATIVE NUMBER

EXISTING RIGHT-OF-WAY

PROPOSED RIGHT-OF-WAY

PARCEL BOUNDARIES

#

POTENTIAL MED./HIGH CONTAMINATION SITE

FPL EASEMENT

WETLANDS & SURFACE WATERS

PUBLIC RECREATIONAL PROPERTIES

GGGGGG

FLORIDA GAS TRANSMISSION (FGT)

OE OE OE

FLORIDA POWER & LIGHT (FPL)

BFOT BFOT

CENTURYLINK

FGT EASEMENT

REVISIONS				ENGINEER OF RECORD		STATE OF FLORIDA DEPARTMENT OF TRANSPORTATION		ALTERNATIVE 1 CONCEPT PLAN	SHEET NO. 31
DATE	DESCRIPTION	DATE	DESCRIPTION	NICHOLAS JOHN CLAVELO LICENSE NUMBER: 84366 SCALAR CONSULTING GROUP INC. 5713 CORPORATE WAY, SUITE 200 WEST PALM BEACH, FLORIDA 33407		ROAD NO.	COUNTY		
						SR 70	HIGHLANDS OKEECHOBEE	FINANCIAL PROJECT ID 450334-1-22-01	

P:\FL23010.00 SR 70 PD&E Study\45033412201\roadway\PLANRD01.dgn : CL12 - PLAN 31 [SHEET]
USER: areginato 11/27/2024 4:59:04 PM



LEGEND

XX

POND ALTERNATIVE NUMBER

EXISTING RIGHT-OF-WAY

PROPOSED RIGHT-OF-WAY

PARCEL BOUNDARIES

#

POTENTIAL MED./HIGH CONTAMINATION SITE

FPL EASEMENT

WETLANDS & SURFACE WATERS

PUBLIC RECREATIONAL PROPERTIES

GGGGGG

FLORIDA GAS TRANSMISSION (FGT)

OE OE OE


FLORIDA POWER & LIGHT (FPL)

BPOT BPOT

CENTURYLINK

FGT EASEMENT

REVISIONS				ENGINEER OF RECORD		STATE OF FLORIDA DEPARTMENT OF TRANSPORTATION		ALTERNATIVE 1 CONCEPT PLAN	SHEET NO.
DATE	DESCRIPTION	DATE	DESCRIPTION	NICHOLAS JOHN CLAVELLO LICENSE NUMBER: 84366 SCALAR CONSULTING GROUP INC. 5713 CORPORATE WAY, SUITE 200 WEST PALM BEACH, FLORIDA 33407		ROAD NO.	COUNTY		
						SR 70	HIGHLANDS OKEECHOBEE	FINANCIAL PROJECT ID 450334-1-22-01	32

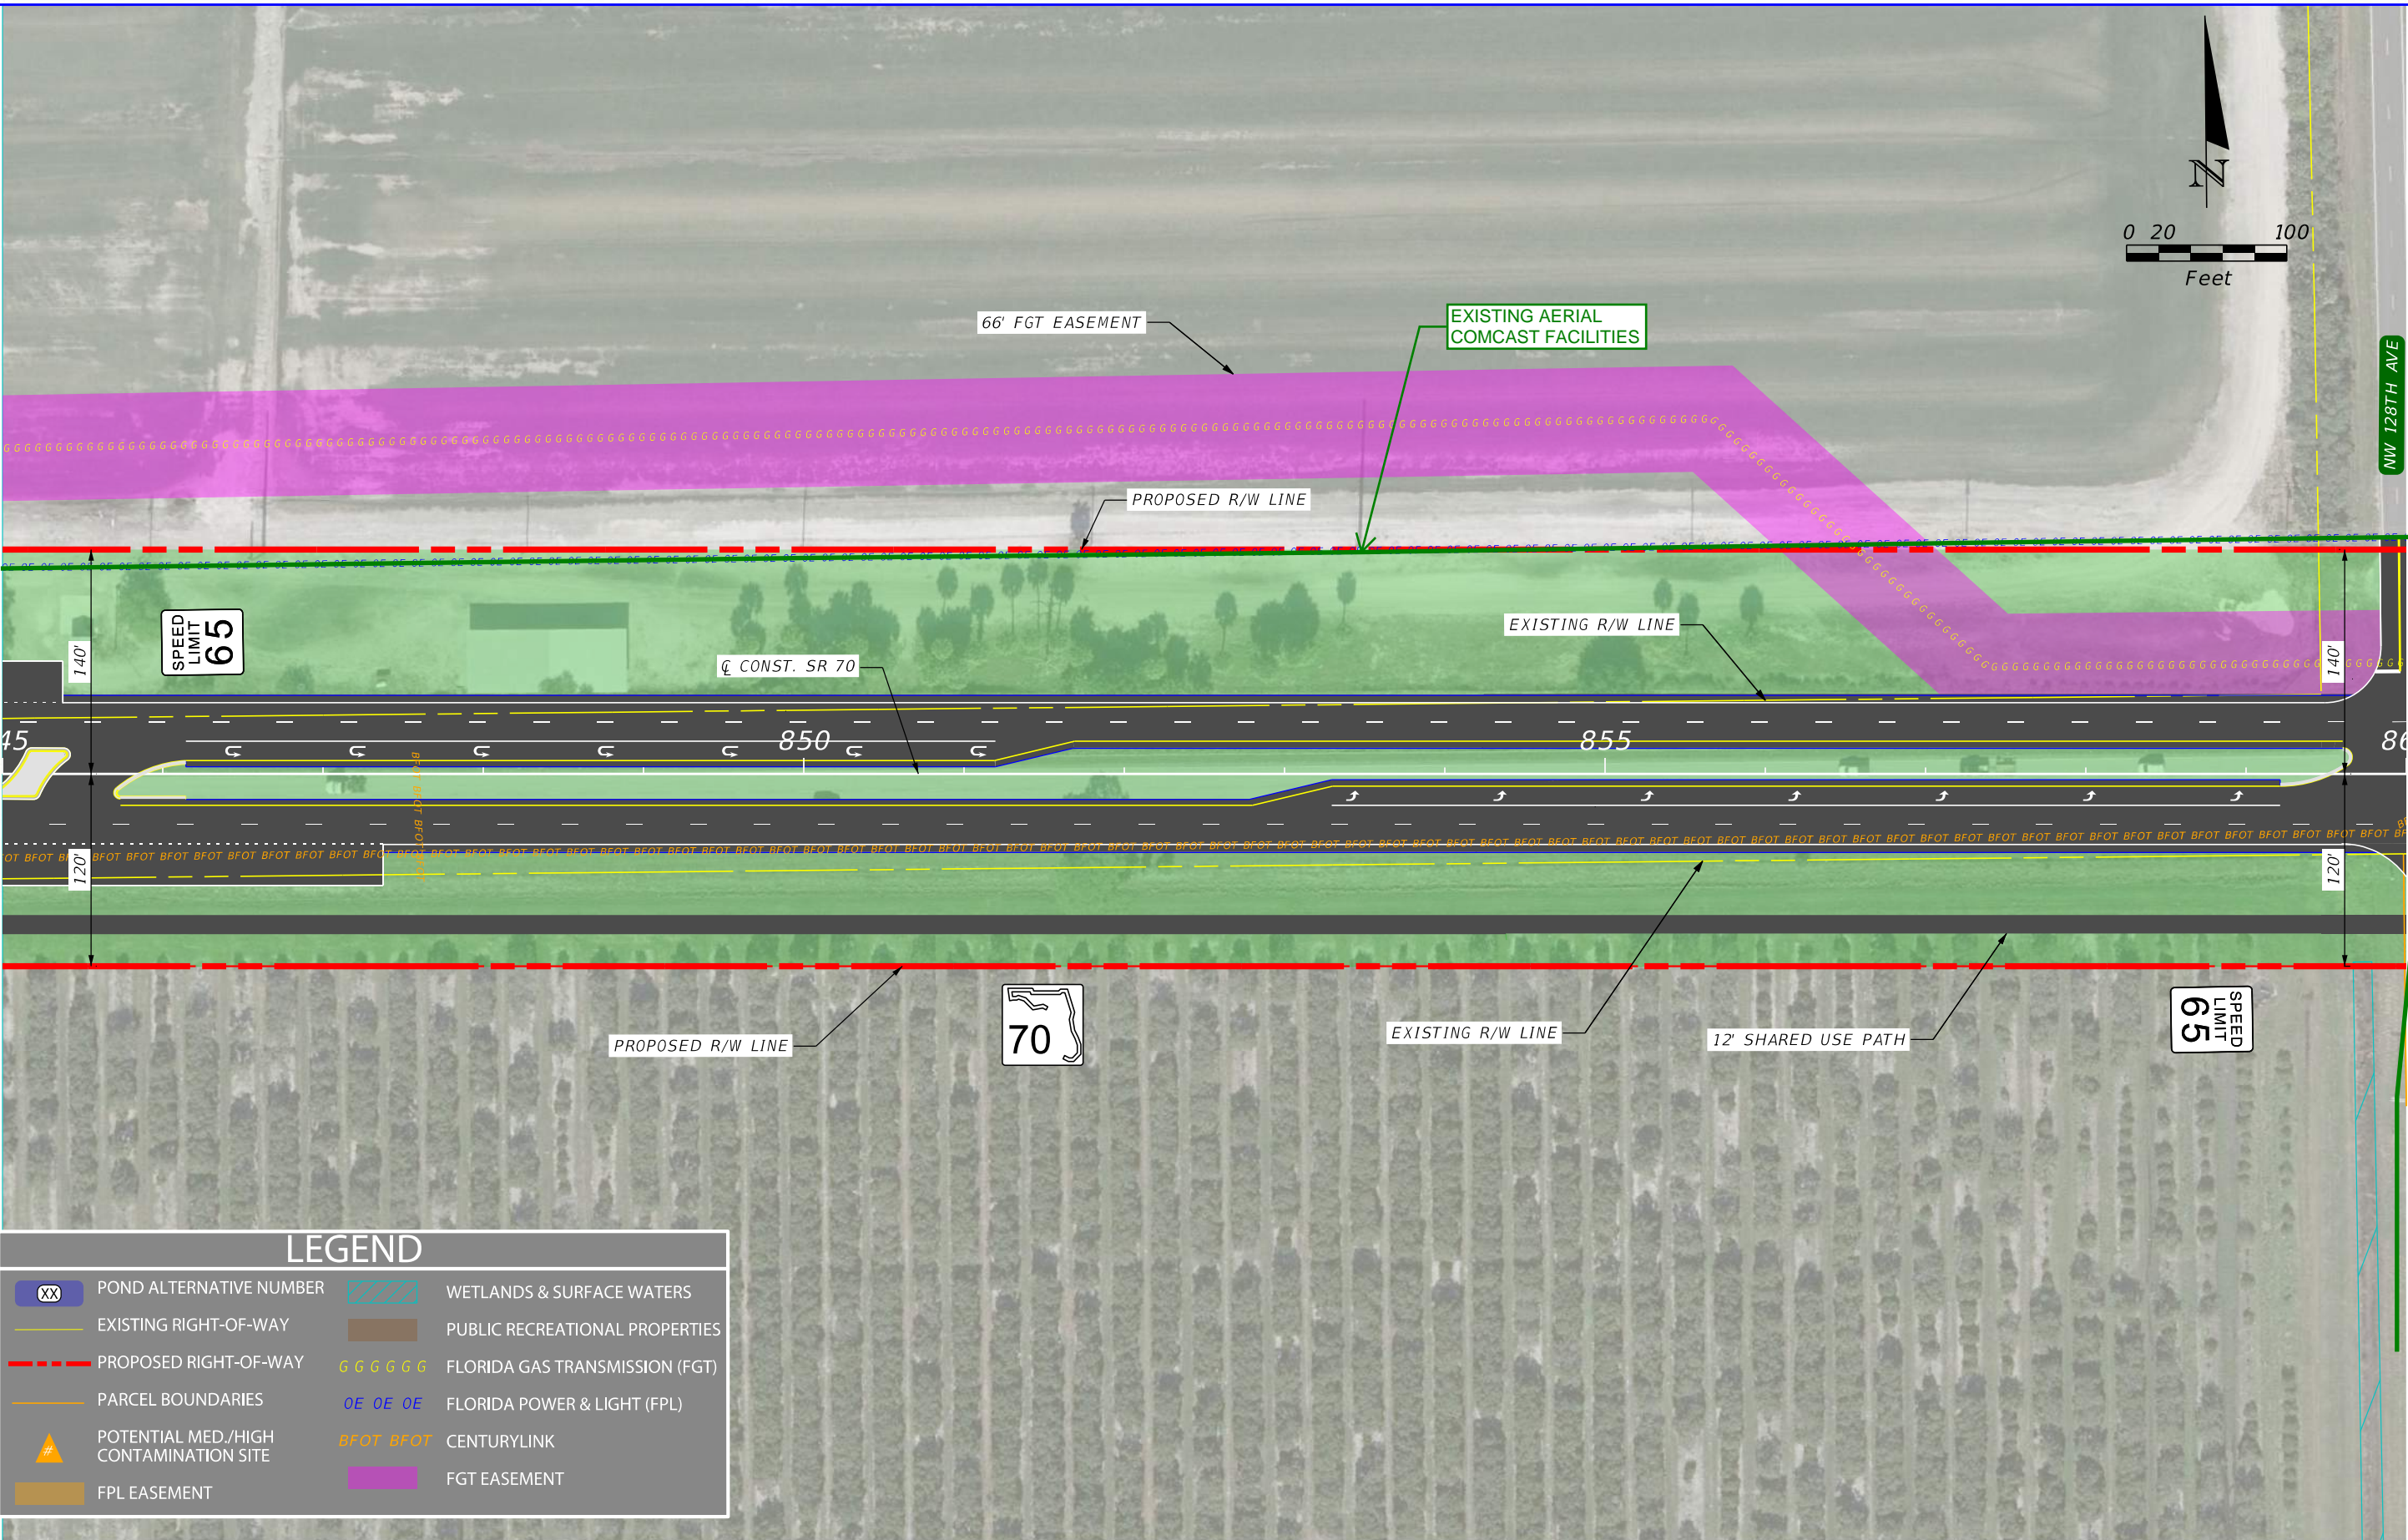


LEGEND

- | | | | |
|-----|--|-----------|--------------------------------|
| XX | POND ALTERNATIVE NUMBER | | WETLANDS & SURFACE WATERS |
| --- | EXISTING RIGHT-OF-WAY | --- | PUBLIC RECREATIONAL PROPERTIES |
| --- | PROPOSED RIGHT-OF-WAY | GGGGGG | FLORIDA GAS TRANSMISSION (FGT) |
| --- | PARCEL BOUNDARIES | OE OE OE | FLORIDA POWER & LIGHT (FPL) |
| # | POTENTIAL MED./HIGH CONTAMINATION SITE | BFOT BFOT | CENTURYLINK |
| --- | FPL EASEMENT | --- | FGT EASEMENT |

REVISIONS				ENGINEER OF RECORD			STATE OF FLORIDA DEPARTMENT OF TRANSPORTATION			ALTERNATIVE 1 CONCEPT PLAN	SHEET NO. 33
DATE	DESCRIPTION	DATE	DESCRIPTION	NICHOLAS JOHN CLAVELO LICENSE NUMBER: 84366 SCALAR CONSULTING GROUP INC. 5713 CORPORATE WAY, SUITE 200 WEST PALM BEACH, FLORIDA 33407			ROAD NO.	COUNTY	FINANCIAL PROJECT ID		
							SR 70	HIGHLANDS OKEECHOBEE	450334-1-22-01		



REVISIONS				ENGINEER OF RECORD		STATE OF FLORIDA DEPARTMENT OF TRANSPORTATION		ALTERNATIVE 1 CONCEPT PLAN	SHEET NO. 34
DATE	DESCRIPTION	DATE	DESCRIPTION	NICHOLAS JOHN CLAVELO LICENSE NUMBER: 84366 SCALAR CONSULTING GROUP INC. 5713 CORPORATE WAY, SUITE 200 WEST PALM BEACH, FLORIDA 33407		ROAD NO.	COUNTY		
						SR 70	HIGHLANDS OKEECHOBEE	FINANCIAL PROJECT ID 450334-1-22-01	

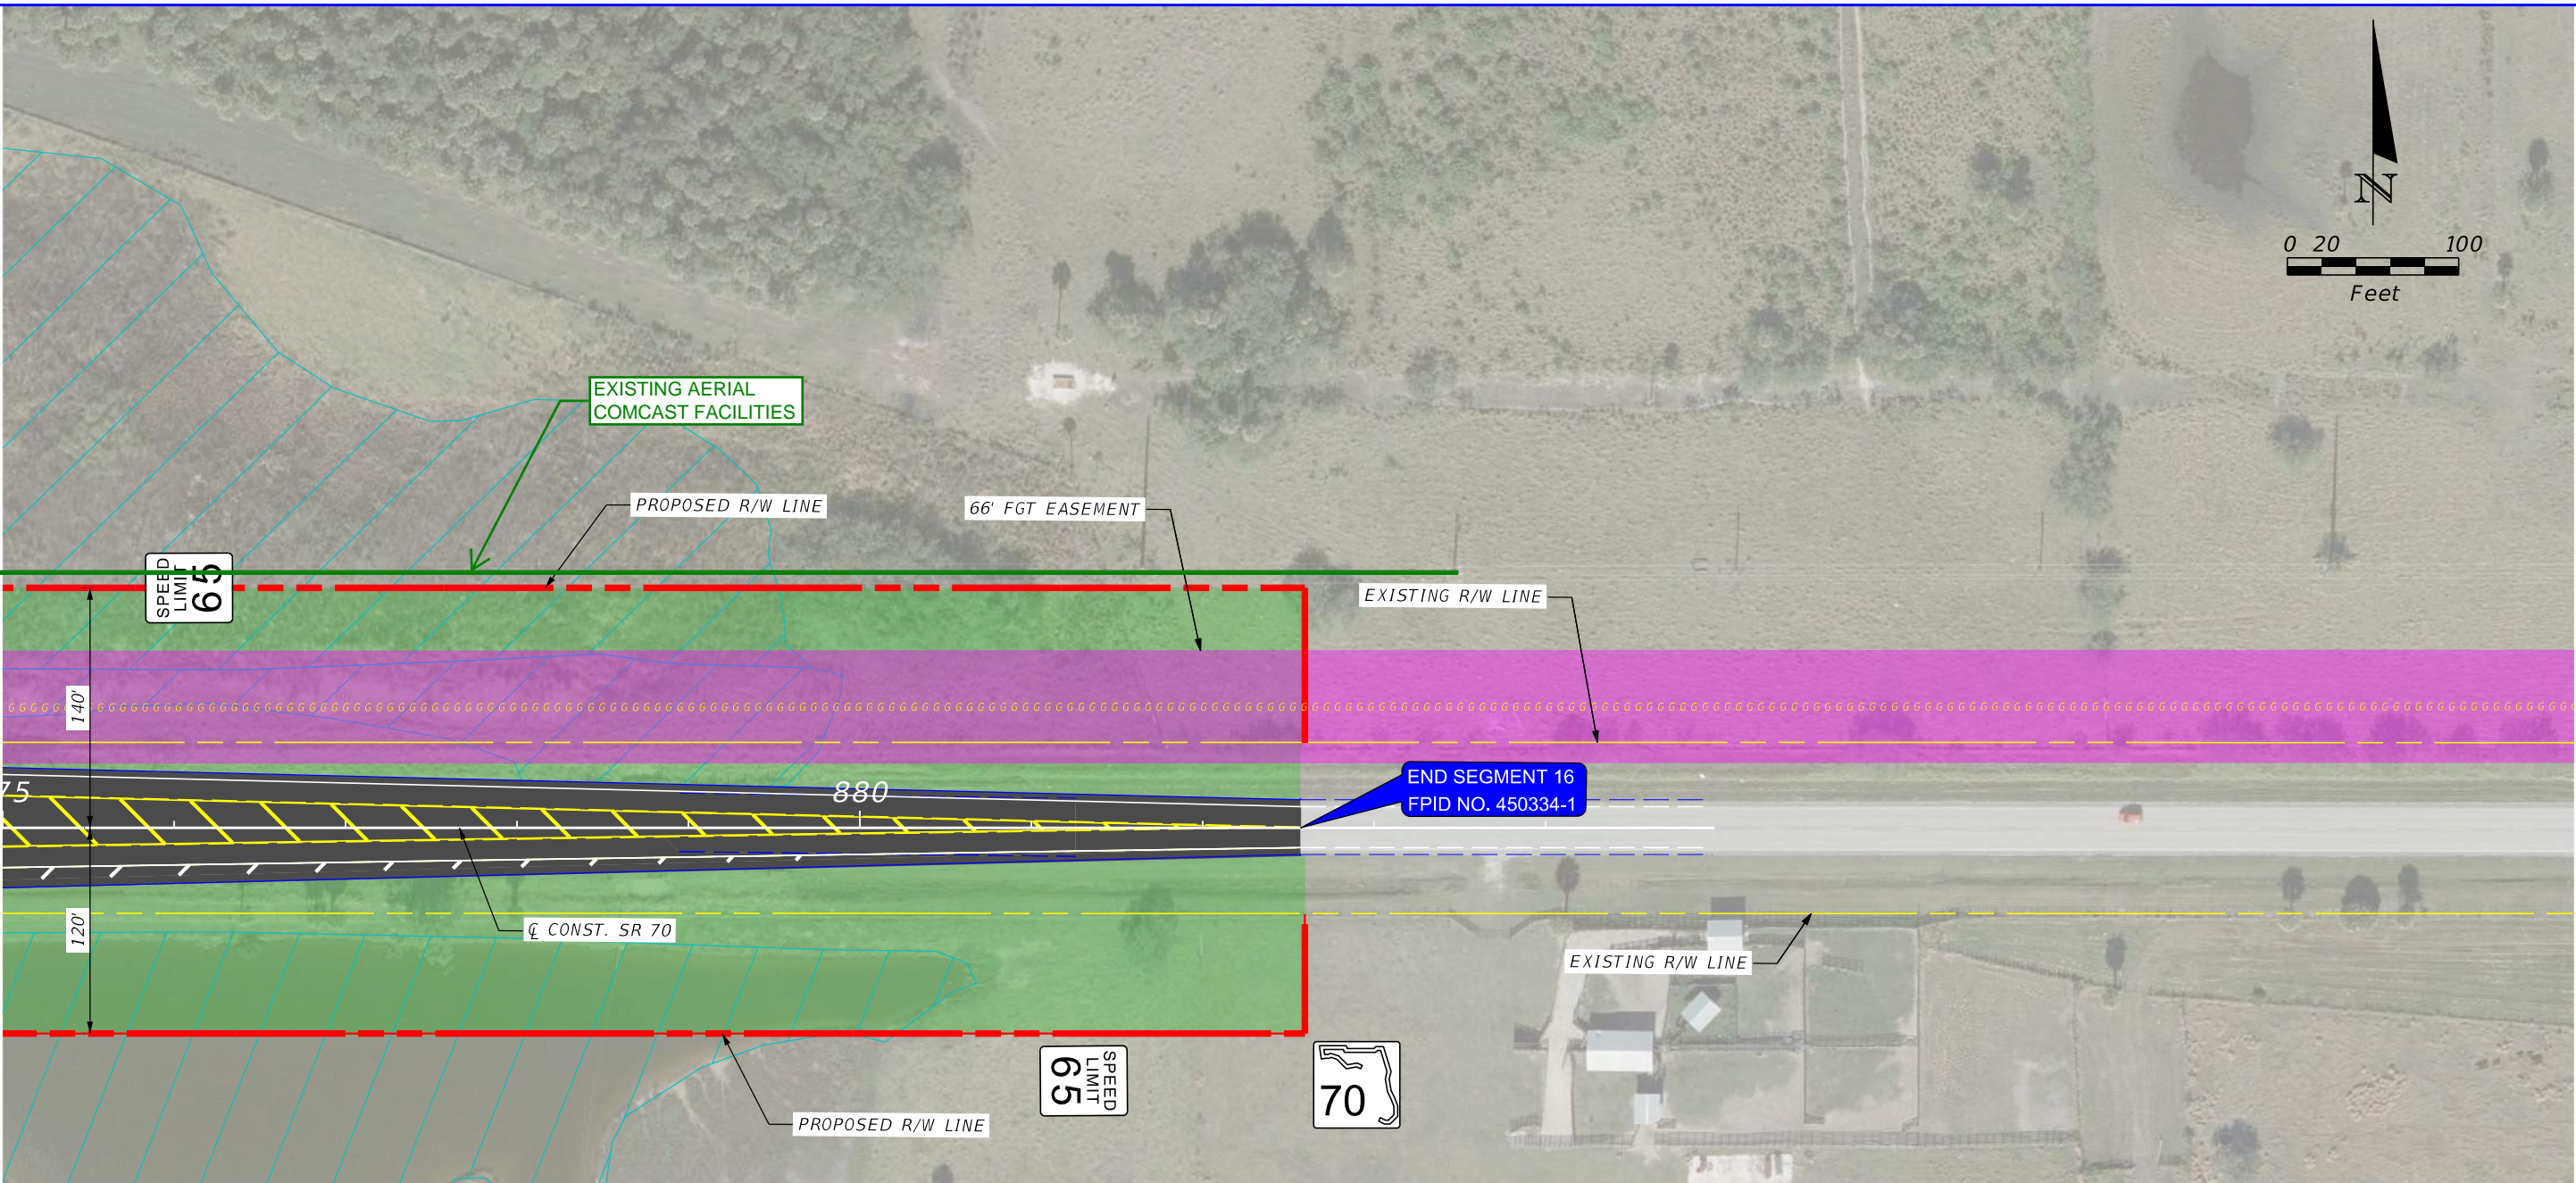

XX

POND ALTERNATIVE NUMBER

EXISTING RIGHT-OF-WAY

PROPOSED RIGHT-OF-WAY

PARCEL BOUNDARIES

#

POTENTIAL MED./HIGH CONTAMINATION SITE

FPL EASEMENT

WETLANDS & SURFACE WATERS

PUBLIC RECREATIONAL PROPERTIES

GGGGGG

FLORIDA GAS TRANSMISSION (FGT)


OE OE OE

FLORIDA POWER & LIGHT (FPL)

BFOT BFOT


CENTURYLINK

FGT EASEMENT

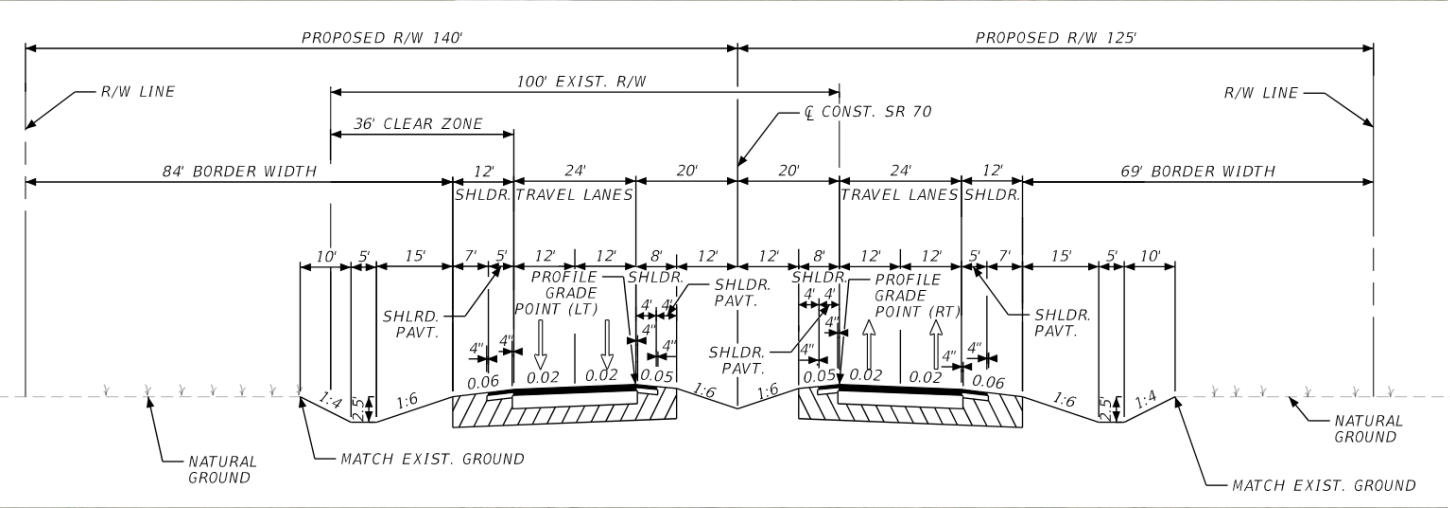

REVISIONS				ENGINEER OF RECORD	STATE OF FLORIDA DEPARTMENT OF TRANSPORTATION			ALTERNATIVE 1 CONCEPT PLAN	SHEET NO.
DATE	DESCRIPTION	DATE	DESCRIPTION	NICHOLAS JOHN CLAVELO LICENSE NUMBER: 84366 SCALAR CONSULTING GROUP INC. 5713 CORPORATE WAY, SUITE 200 WEST PALM BEACH, FLORIDA 33407	ROAD NO.	COUNTY	FINANCIAL PROJECT ID		35
					SR 70	HIGHLANDS OKEECHOBEE	450334-1-22-01		

ALTERNATIVE 1
CONCEPT PLAN

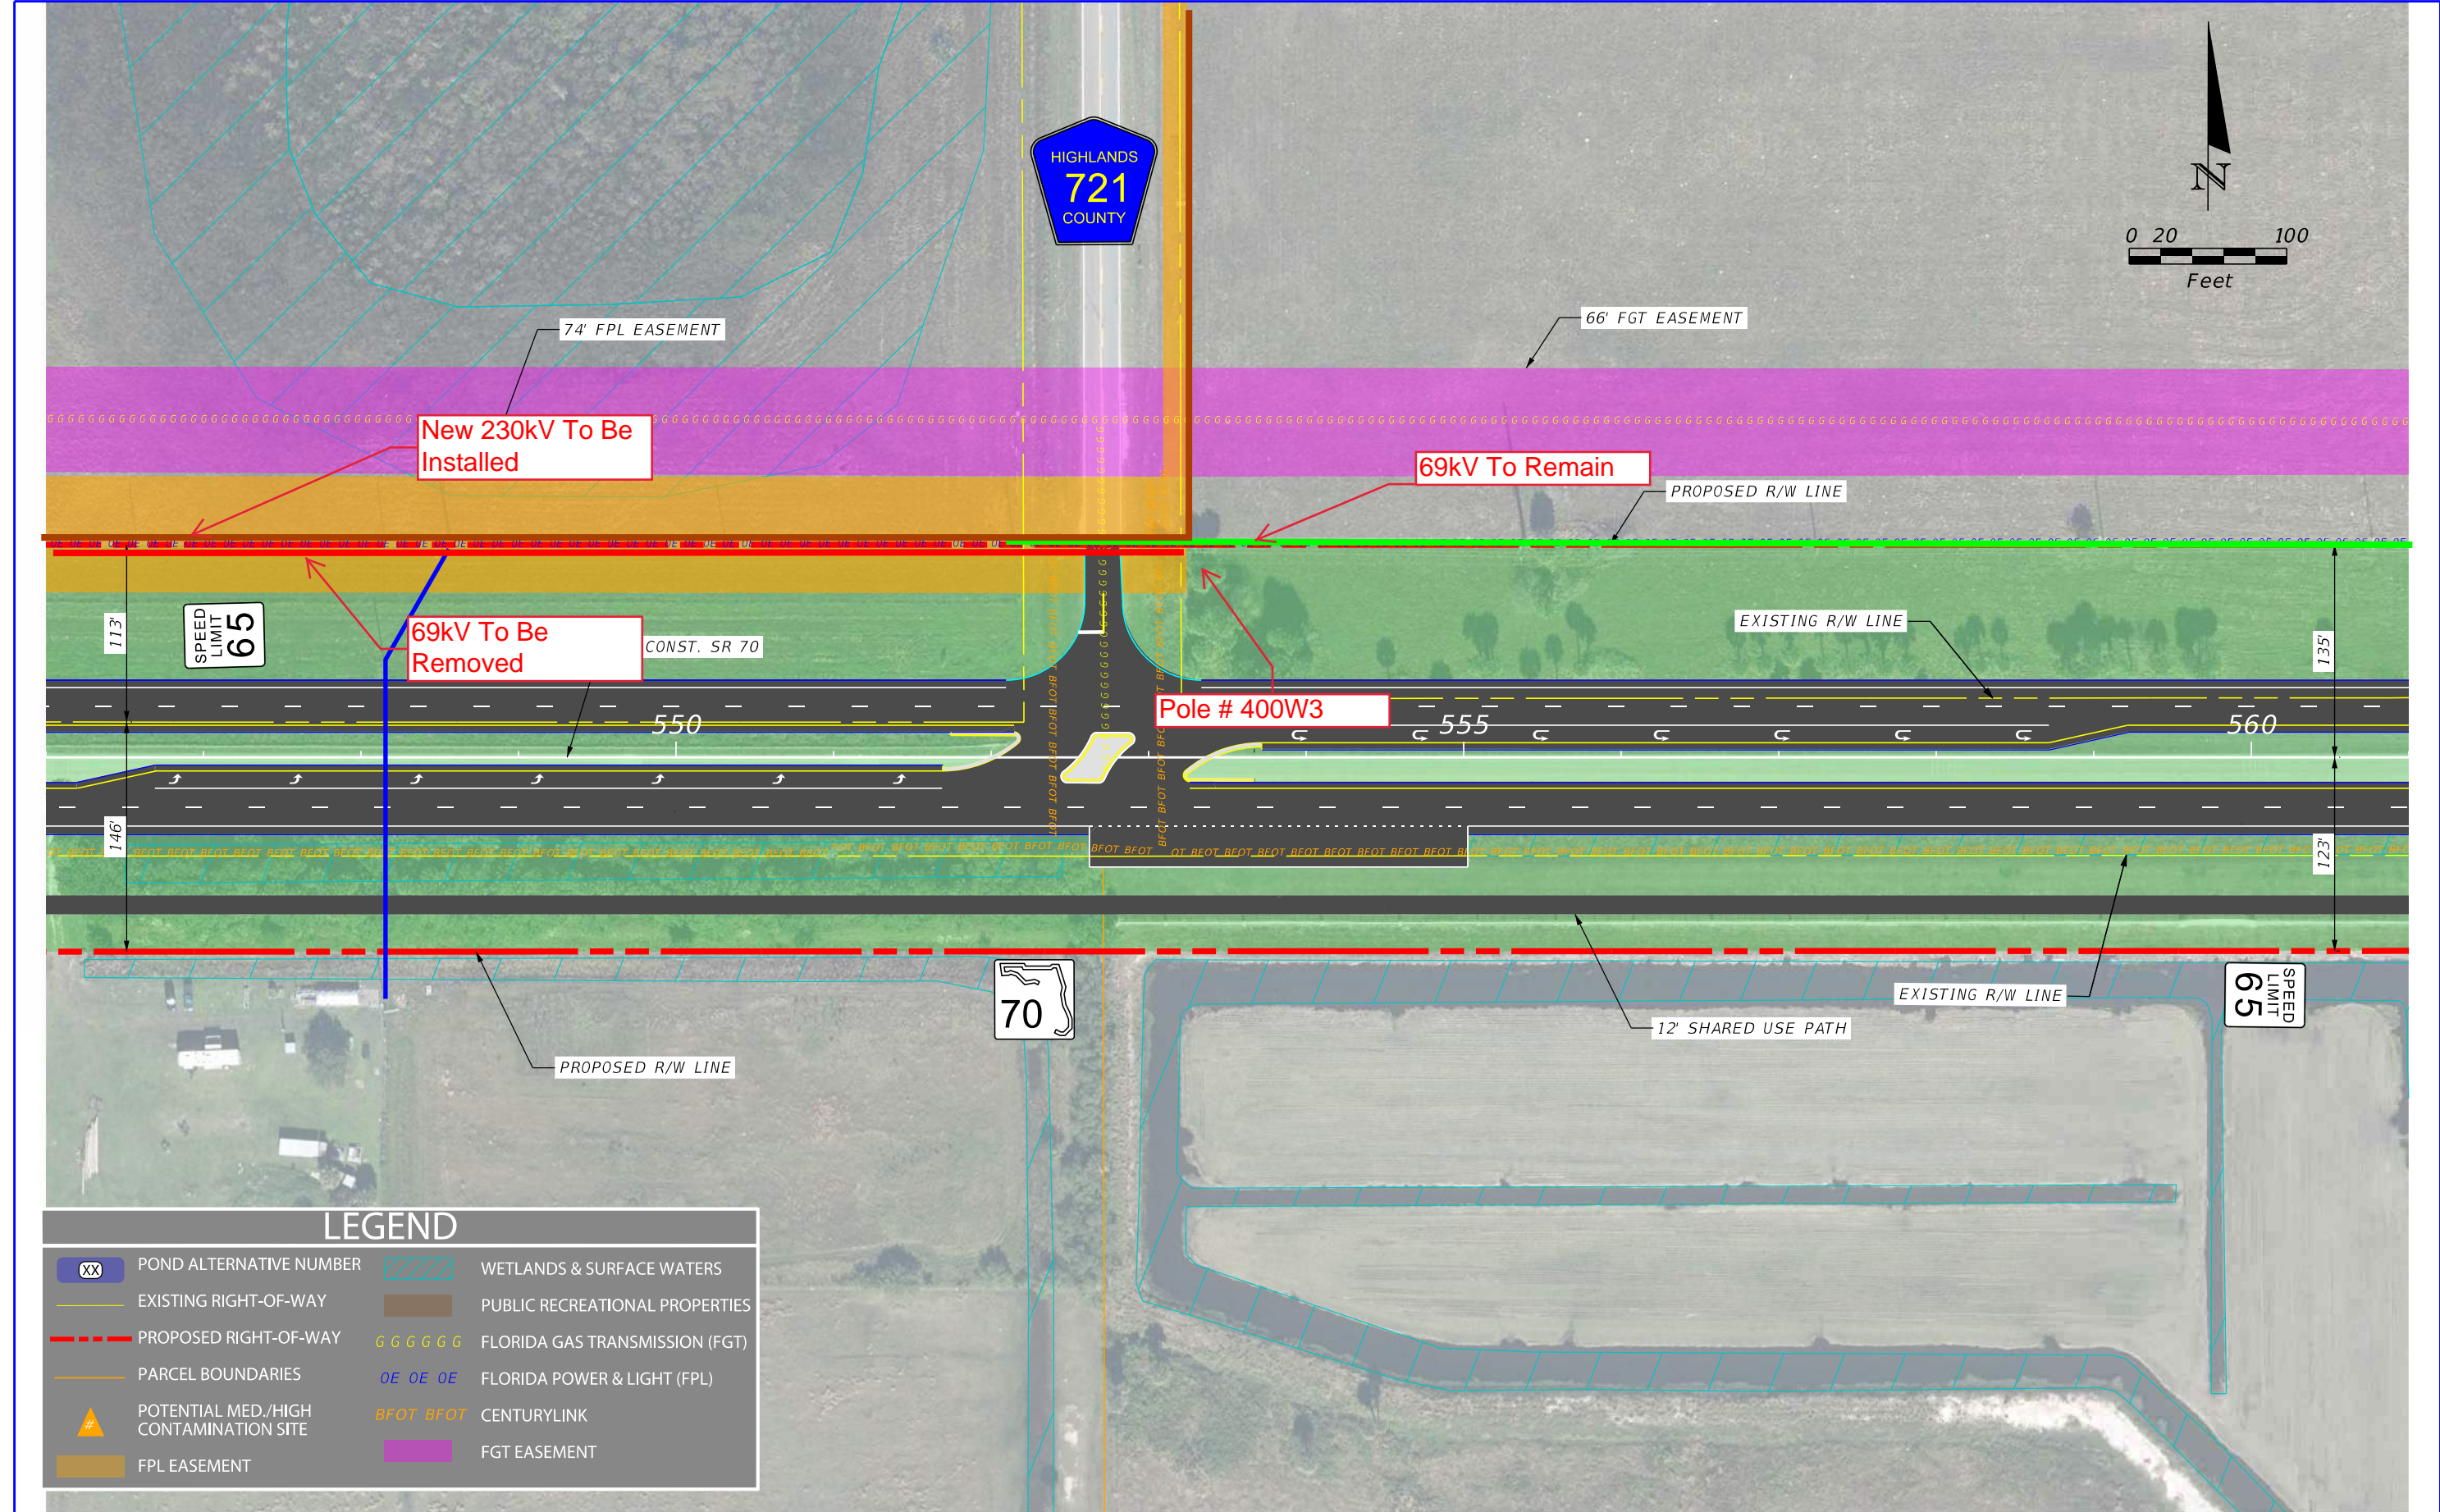

REVISIONS				ENGINEER OF RECORD		STATE OF FLORIDA DEPARTMENT OF TRANSPORTATION		ALTERNATIVE 1 CONCEPT PLAN	SHEET NO. 12
DATE	DESCRIPTION	DATE	DESCRIPTION	NICHOLAS JOHN CLAVELO LICENSE NUMBER: 84366 SCALAR CONSULTING GROUP INC. 5713 CORPORATE WAY, SUITE 200 WEST PALM BEACH, FLORIDA 33407		ROAD NO.	COUNTY		
						SR 70	HIGHLANDS OKEECHOBEE	FINANCIAL PROJECT ID 450334-1-22-01	

FLORIDA GAS TRANSMISSION




<div><div>1000</div><div>CONSTRUCTION</div><div>EXIST. R/W LINE</div><div>PROP. R/W LINE</div><div>PROP. PERP. EASEMENT</div></div> <div><div>PARCEL LINE</div><div>EXIST. EASEMENT</div><div>PROP. TEMP. EASEMENT</div><div>BRIDGE</div></div> <div><div>FPC SITE</div><div>SMF SITE</div><div>PROPOSED ROADWAY</div><div>MILLING AND RESURF.</div></div>	<div><div><div>RK&K</div><div>Rummel, Klepper & Kahl, LLP 402 S. Kentucky Avenue Suite 400 Lakeland, FL 33801 FBPR C.A. NO. 26879</div></div><div><div>JASON L. LYLE, P.E. 69009</div><div>4/7/2023 6:21:51 PM Default</div></div></div> <div><table><tr><th colspan="3">STATE OF FLORIDA DEPARTMENT OF TRANSPORTATION</th></tr><tr><td>ROAD NO.</td><td>COUNTY</td><td>FINANCIAL PROJECT ID</td></tr><tr><td>SR 70</td><td>GLADES HIGHLANDS OKEECHOBEE</td><td>414506-1-22-01</td></tr></table></div> <div><div>SR 70 PD&E STUDY BASEMAP</div></div> <div><div>SHEET NO.</div><div>57</div></div>	STATE OF FLORIDA DEPARTMENT OF TRANSPORTATION			ROAD NO.	COUNTY	FINANCIAL PROJECT ID	SR 70	GLADES HIGHLANDS OKEECHOBEE	414506-1-22-01
STATE OF FLORIDA DEPARTMENT OF TRANSPORTATION										
ROAD NO.	COUNTY	FINANCIAL PROJECT ID								
SR 70	GLADES HIGHLANDS OKEECHOBEE	414506-1-22-01								

rmarrero

THE OFFICIAL RECORD OF THIS SHEET IS THE ELECTRONIC FILE DIGITALLY SIGNED AND SEALED UNDER RULE 61G15-23.004, F.A.C.


\\ad.rkk.com\fs\Cloud\Projects\2020\20020_DICSCemo\Projects\DI 414506-1 SR 70 Jefferson Ave to CR 29\Eng\41450612201\Roadway\UAO\PLANRD57.dgn

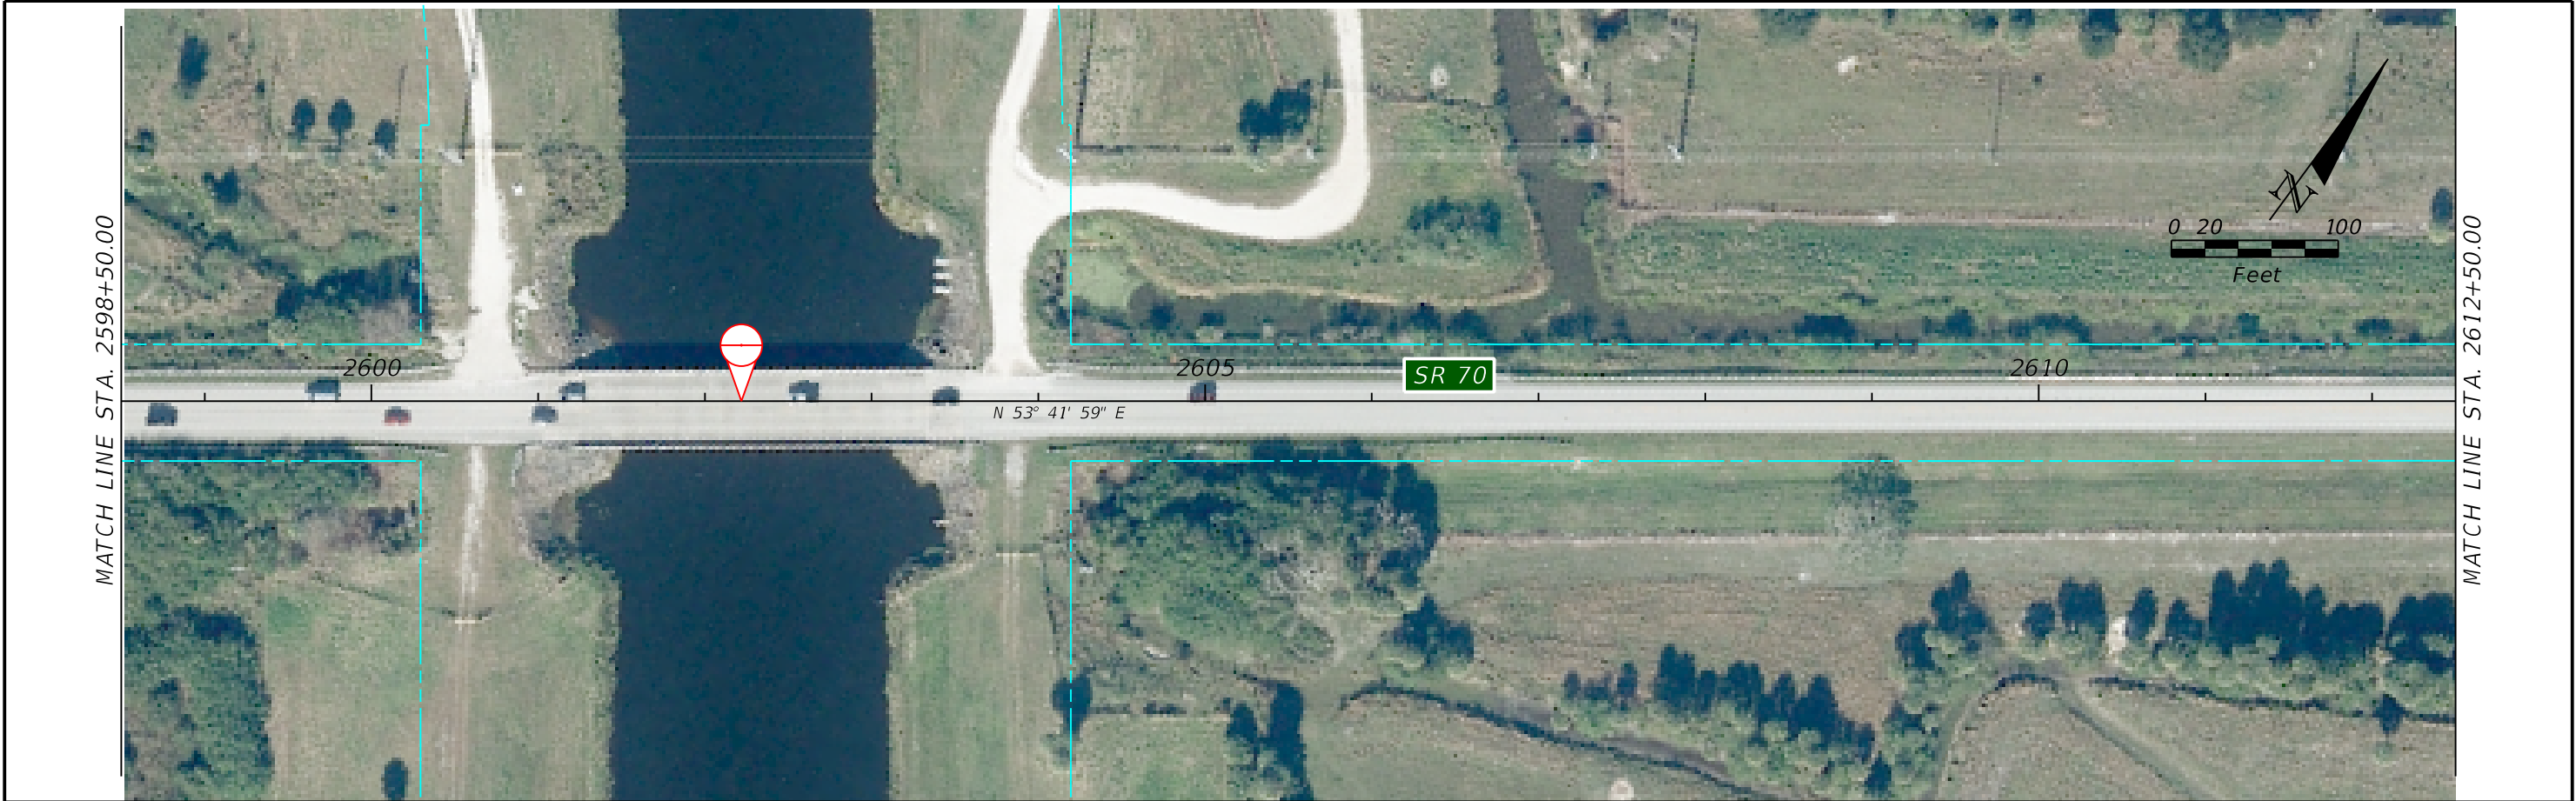

LEGEND		STATE OF FLORIDA DEPARTMENT OF TRANSPORTATION		SR 70 PD&E STUDY BASEMAP	SHEET NO. 58
1000 CONSTRUCTION	PARCEL LINE	FPC SITE	ROAD NO.		
EXIST. R/W LINE	EXIST. EASEMENT	SMF SITE	SR 70	GLADES HIGHLANDS OKEECHOBEE	414506-1-22-01
PROP. R/W LINE	PROP. TEMP. EASEMENT	PROPOSED ROADWAY			
PROP. PERP. EASEMENT	BRIDGE	MILLING AND RESURF.			

4/7/2023 6:21:56 PM Default \\ad.rkk.com\fs\Cloud\Projects\2020\20020_DICSCemo\Projects\DI 414506-1 SR 70 Jefferson Ave to CR 29\Eng\41450612201\Roadway\UAO\PLANRD58.dgn

THE OFFICIAL RECORD OF THIS SHEET IS THE ELECTRONIC FILE DIGITALLY SIGNED AND SEALED UNDER RULE 61G15-23.004, F.A.C.

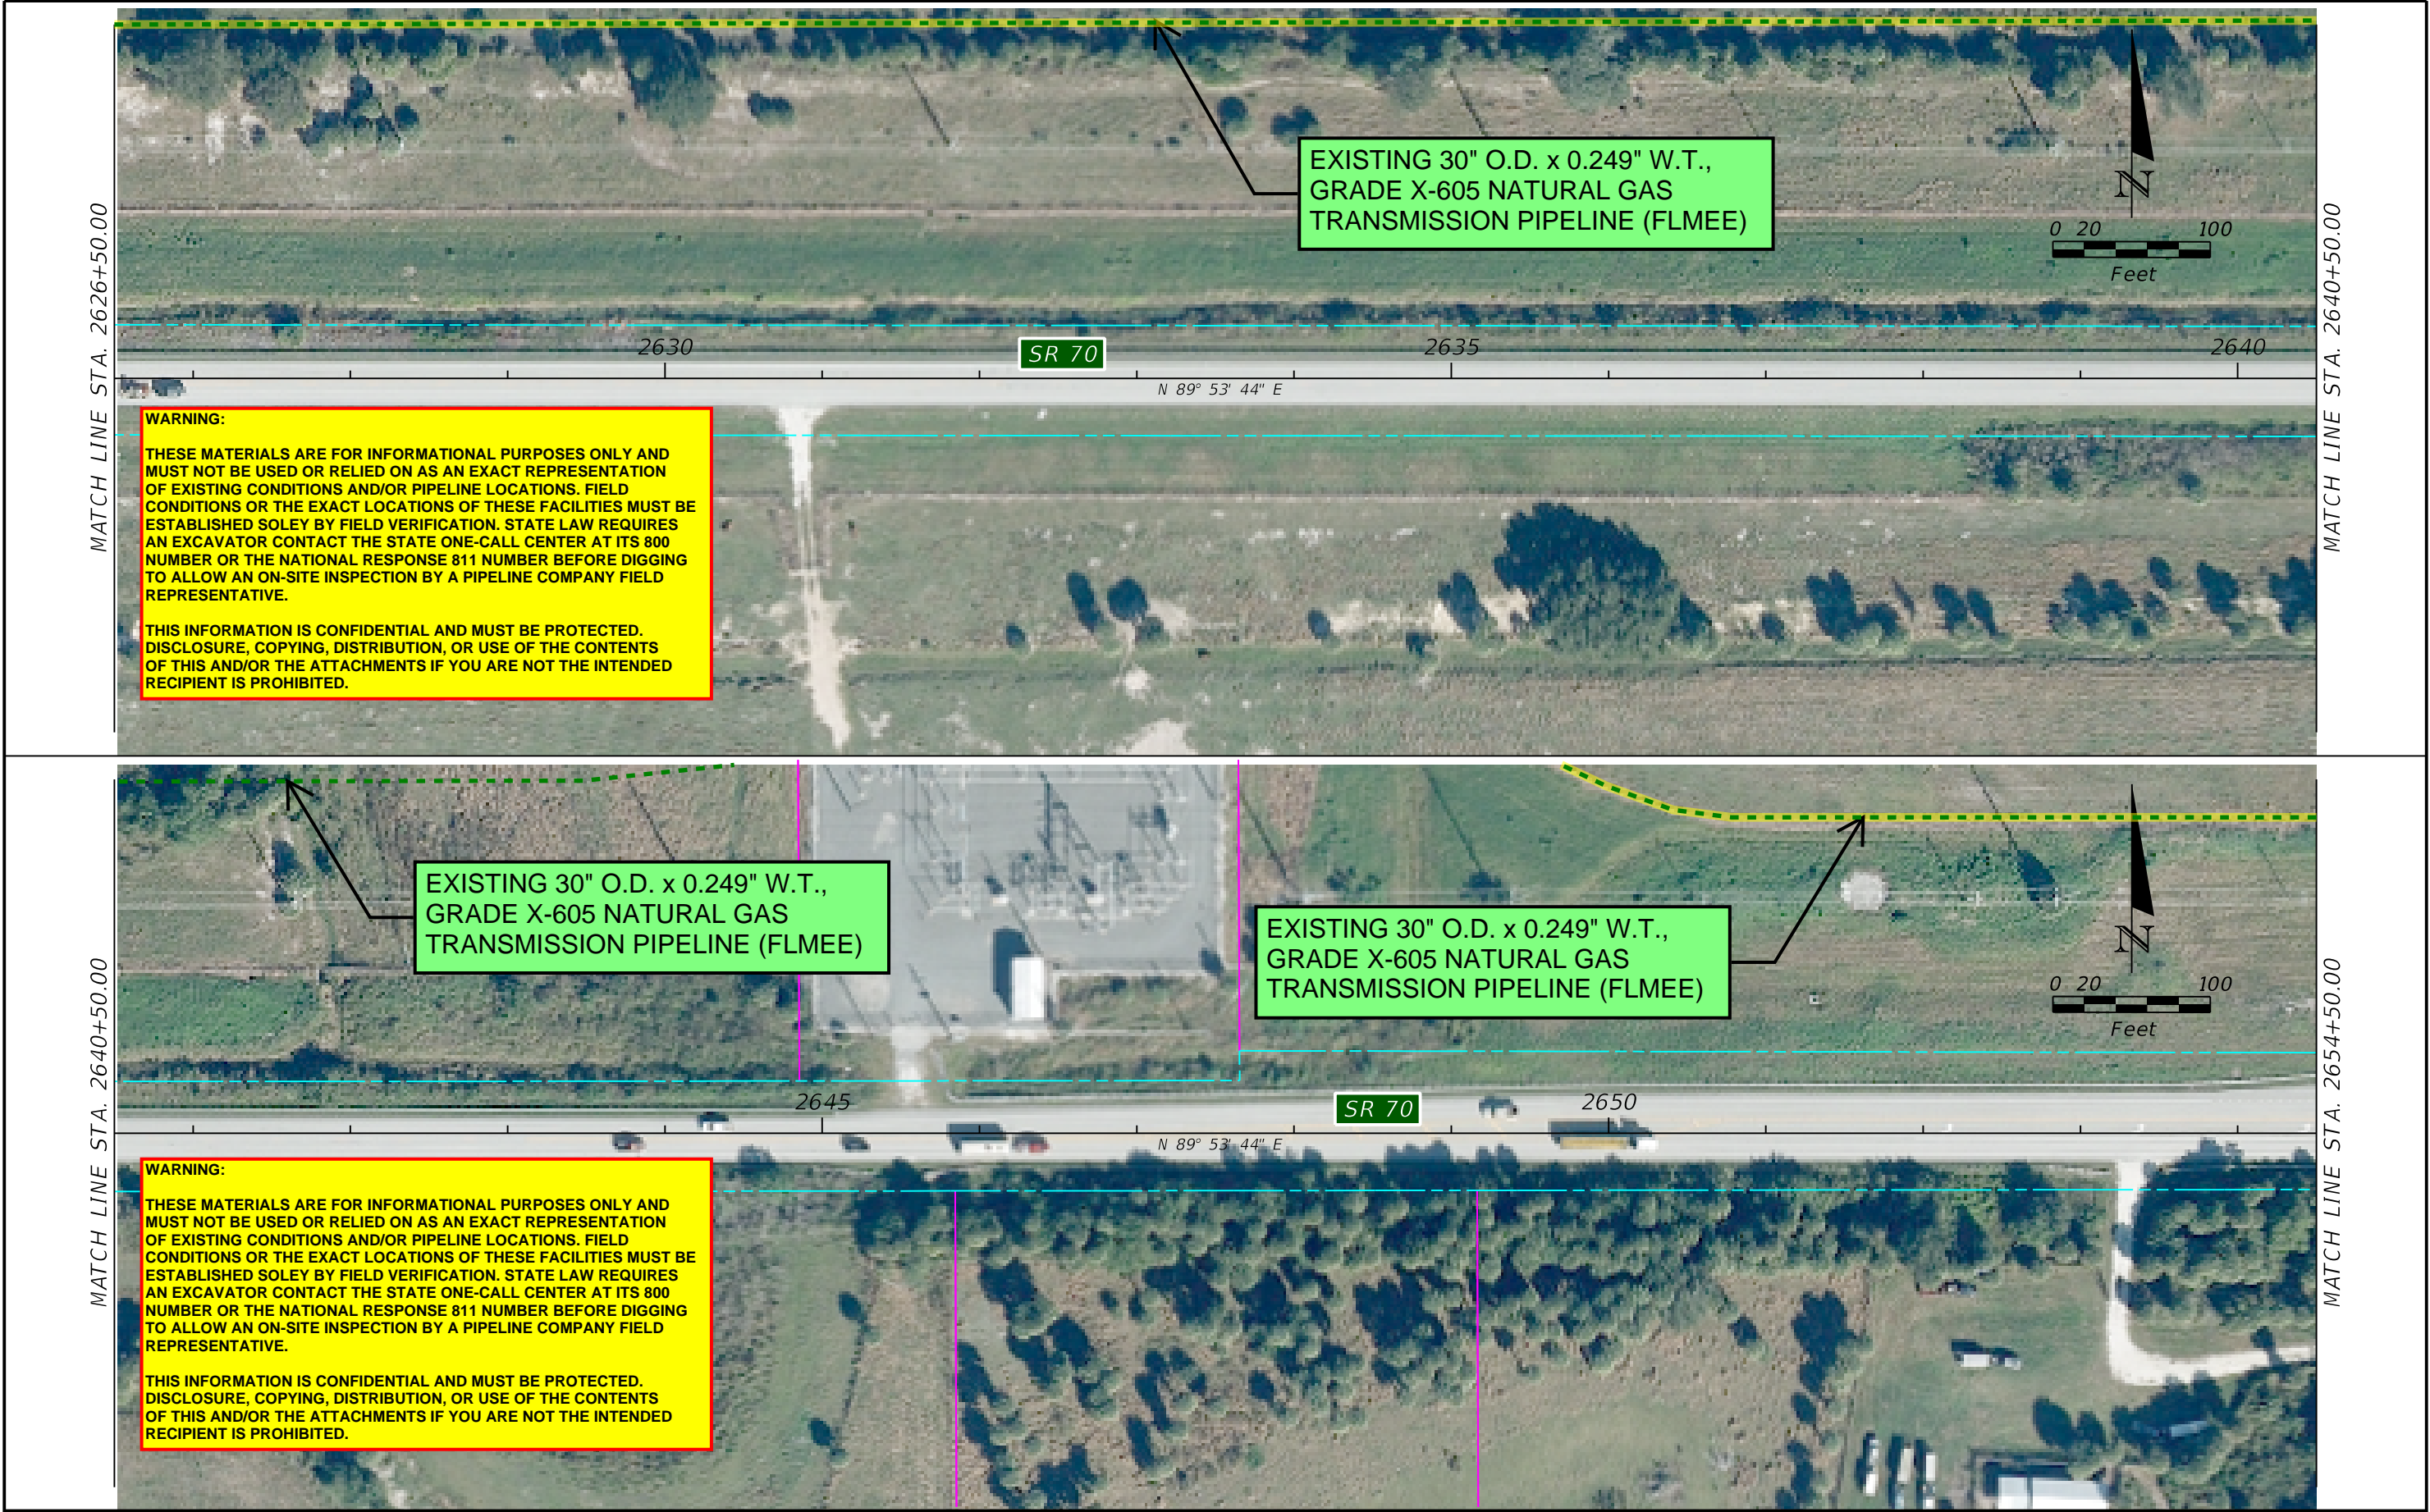

WARNING:

THESE MATERIALS ARE FOR INFORMATIONAL PURPOSES ONLY AND MUST NOT BE USED OR RELIED ON AS AN EXACT REPRESENTATION OF EXISTING CONDITIONS AND/OR PIPELINE LOCATIONS. FIELD CONDITIONS OR THE EXACT LOCATIONS OF THESE FACILITIES MUST BE ESTABLISHED SOLEY BY FIELD VERIFICATION. STATE LAW REQUIRES AN EXCAVATOR CONTACT THE STATE ONE-CALL CENTER AT ITS 800 NUMBER OR THE NATIONAL RESPONSE 811 NUMBER BEFORE DIGGING TO ALLOW AN ON-SITE INSPECTION BY A PIPELINE COMPANY FIELD REPRESENTATIVE.

THIS INFORMATION IS CONFIDENTIAL AND MUST BE PROTECTED. DISCLOSURE, COPYING, DISTRIBUTION, OR USE OF THE CONTENTS OF THIS AND/OR THE ATTACHMENTS IF YOU ARE NOT THE INTENDED RECIPIENT IS PROHIBITED.

EXISTING 30" O.D. x 0.249" W.T.,
GRADE X-605 NATURAL GAS
TRANSMISSION PIPELINE (FLMEE)

EXISTING 30" O.D. x 0.249" W.T.,
GRADE X-605 NATURAL GAS
TRANSMISSION PIPELINE (FLMEE)

WARNING:

THESE MATERIALS ARE FOR INFORMATIONAL PURPOSES ONLY AND MUST NOT BE USED OR RELIED ON AS AN EXACT REPRESENTATION OF EXISTING CONDITIONS AND/OR PIPELINE LOCATIONS. FIELD CONDITIONS OR THE EXACT LOCATIONS OF THESE FACILITIES MUST BE ESTABLISHED SOLEY BY FIELD VERIFICATION. STATE LAW REQUIRES AN EXCAVATOR CONTACT THE STATE ONE-CALL CENTER AT ITS 800 NUMBER OR THE NATIONAL RESPONSE 811 NUMBER BEFORE DIGGING TO ALLOW AN ON-SITE INSPECTION BY A PIPELINE COMPANY FIELD REPRESENTATIVE.

THIS INFORMATION IS CONFIDENTIAL AND MUST BE PROTECTED. DISCLOSURE, COPYING, DISTRIBUTION, OR USE OF THE CONTENTS OF THIS AND/OR THE ATTACHMENTS IF YOU ARE NOT THE INTENDED RECIPIENT IS PROHIBITED.




<p>1000</p> <p>Q CONSTRUCTION</p> <p>EXIST. R/W LINE</p> <p>PROP. R/W LINE</p> <p>PROP. PERP. EASEMENT</p>	<p>PARCEL LINE</p> <p>EXIST. EASEMENT</p> <p>PROP. TEMP. EASEMENT</p> <p>BRIDGE</p>	<p>FPC SITE</p> <p>SMF SITE</p> <p>PROPOSED ROADWAY</p> <p>MILLING AND RESURF.</p>	<p>RK&K</p> <p>Rummel, Klepper & Kahl, LLP 402 S. Kentucky Avenue Suite 400 Lakeland, FL 33801 FBPR C.A. NO. 26879</p> <p>JASON L. LYLE, P.E. 69009</p> <p>4/7/2023 6:22:15 PM Default</p>	<p>STATE OF FLORIDA DEPARTMENT OF TRANSPORTATION</p> <table><tr><td>ROAD NO.</td><td>COUNTY</td><td>FINANCIAL PROJECT ID</td></tr><tr><td>SR 70</td><td>GLADES HIGHLANDS OKEECHOBEE</td><td>414506-1-22-01</td></tr></table>	ROAD NO.	COUNTY	FINANCIAL PROJECT ID	SR 70	GLADES HIGHLANDS OKEECHOBEE	414506-1-22-01	<p>SR 70 PD&E STUDY BASEMAP</p>	<p>SHEET NO.</p> <p>61</p>
ROAD NO.	COUNTY	FINANCIAL PROJECT ID										
SR 70	GLADES HIGHLANDS OKEECHOBEE	414506-1-22-01										

rmarrerogonzalez

\\ad.rkk.com\fs\Cloud\Projects\2020\20020_DICSCMO\Projects\DI 414506-1 SR 70 Jefferson Ave to CR 29\Eng\41450612201\Roadway\UAO\PLANRD61.dgn


THE OFFICIAL RECORD OF THIS SHEET IS THE ELECTRONIC FILE DIGITALLY SIGNED AND SEALED UNDER RULE 61G15-23.004, F.A.C.

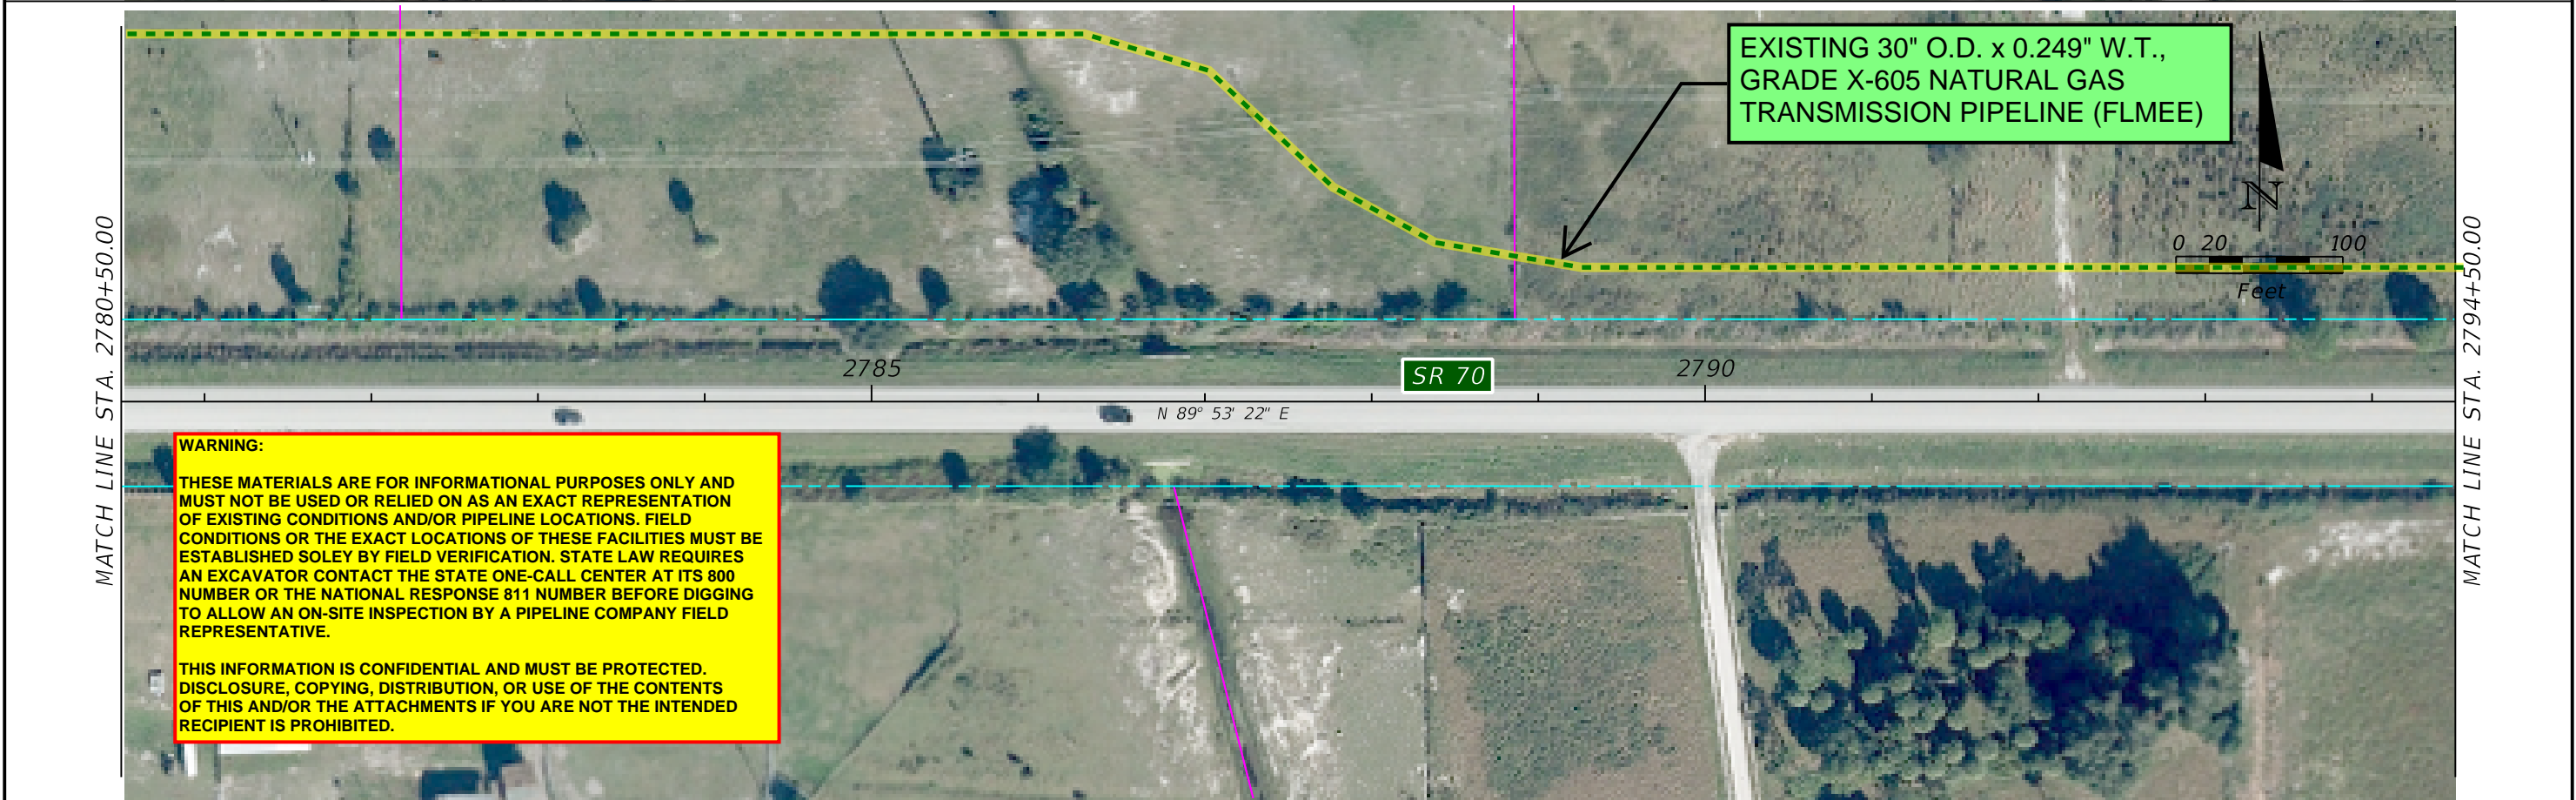


<p>1000</p> <p>Q CONSTRUCTION</p> <p>EXIST. R/W LINE</p> <p>PROP. R/W LINE</p> <p>PROP. PERP. EASEMENT</p>	<p>PARCEL LINE</p> <p>EXIST. EASEMENT</p> <p>PROP. TEMP. EASEMENT</p> <p>BRIDGE</p>	<p>FPC SITE</p> <p>SMF SITE</p> <p>PROPOSED ROADWAY</p> <p>MILLING AND RESURF.</p>	<p>RK&K</p> <p>Rummel, Klepper & Kahl, LLP 402 S. Kentucky Avenue Suite 400 Lakeland, FL 33801 FBPR C.A. NO. 26879</p> <p>JASON L. LYLE, P.E. 69009</p>	<p>STATE OF FLORIDA DEPARTMENT OF TRANSPORTATION</p> <table><tr><td>ROAD NO.</td><td>COUNTY</td><td>FINANCIAL PROJECT ID</td></tr><tr><td>SR 70</td><td>GLADES HIGHLANDS OKEECHOBEE</td><td>414506-1-22-01</td></tr></table>	ROAD NO.	COUNTY	FINANCIAL PROJECT ID	SR 70	GLADES HIGHLANDS OKEECHOBEE	414506-1-22-01	<p>SR 70 PD&E STUDY BASEMAP</p>	<p>SHEET NO.</p> <p>64</p>
ROAD NO.	COUNTY	FINANCIAL PROJECT ID										
SR 70	GLADES HIGHLANDS OKEECHOBEE	414506-1-22-01										

4/7/2023 6:22:29 PM Default \\ad.rkk.com\fs\Cloud\Projects\2020\20020_DICSCemo\Projects\DI 414506-1 SR 70 Jefferson Ave to CR 29\Eng\41450612201\Roadway\UAO\PLANRD64.dgn

THE OFFICIAL RECORD OF THIS SHEET IS THE ELECTRONIC FILE DIGITALLY SIGNED AND SEALED UNDER RULE 61G15-23.004, F.A.C.

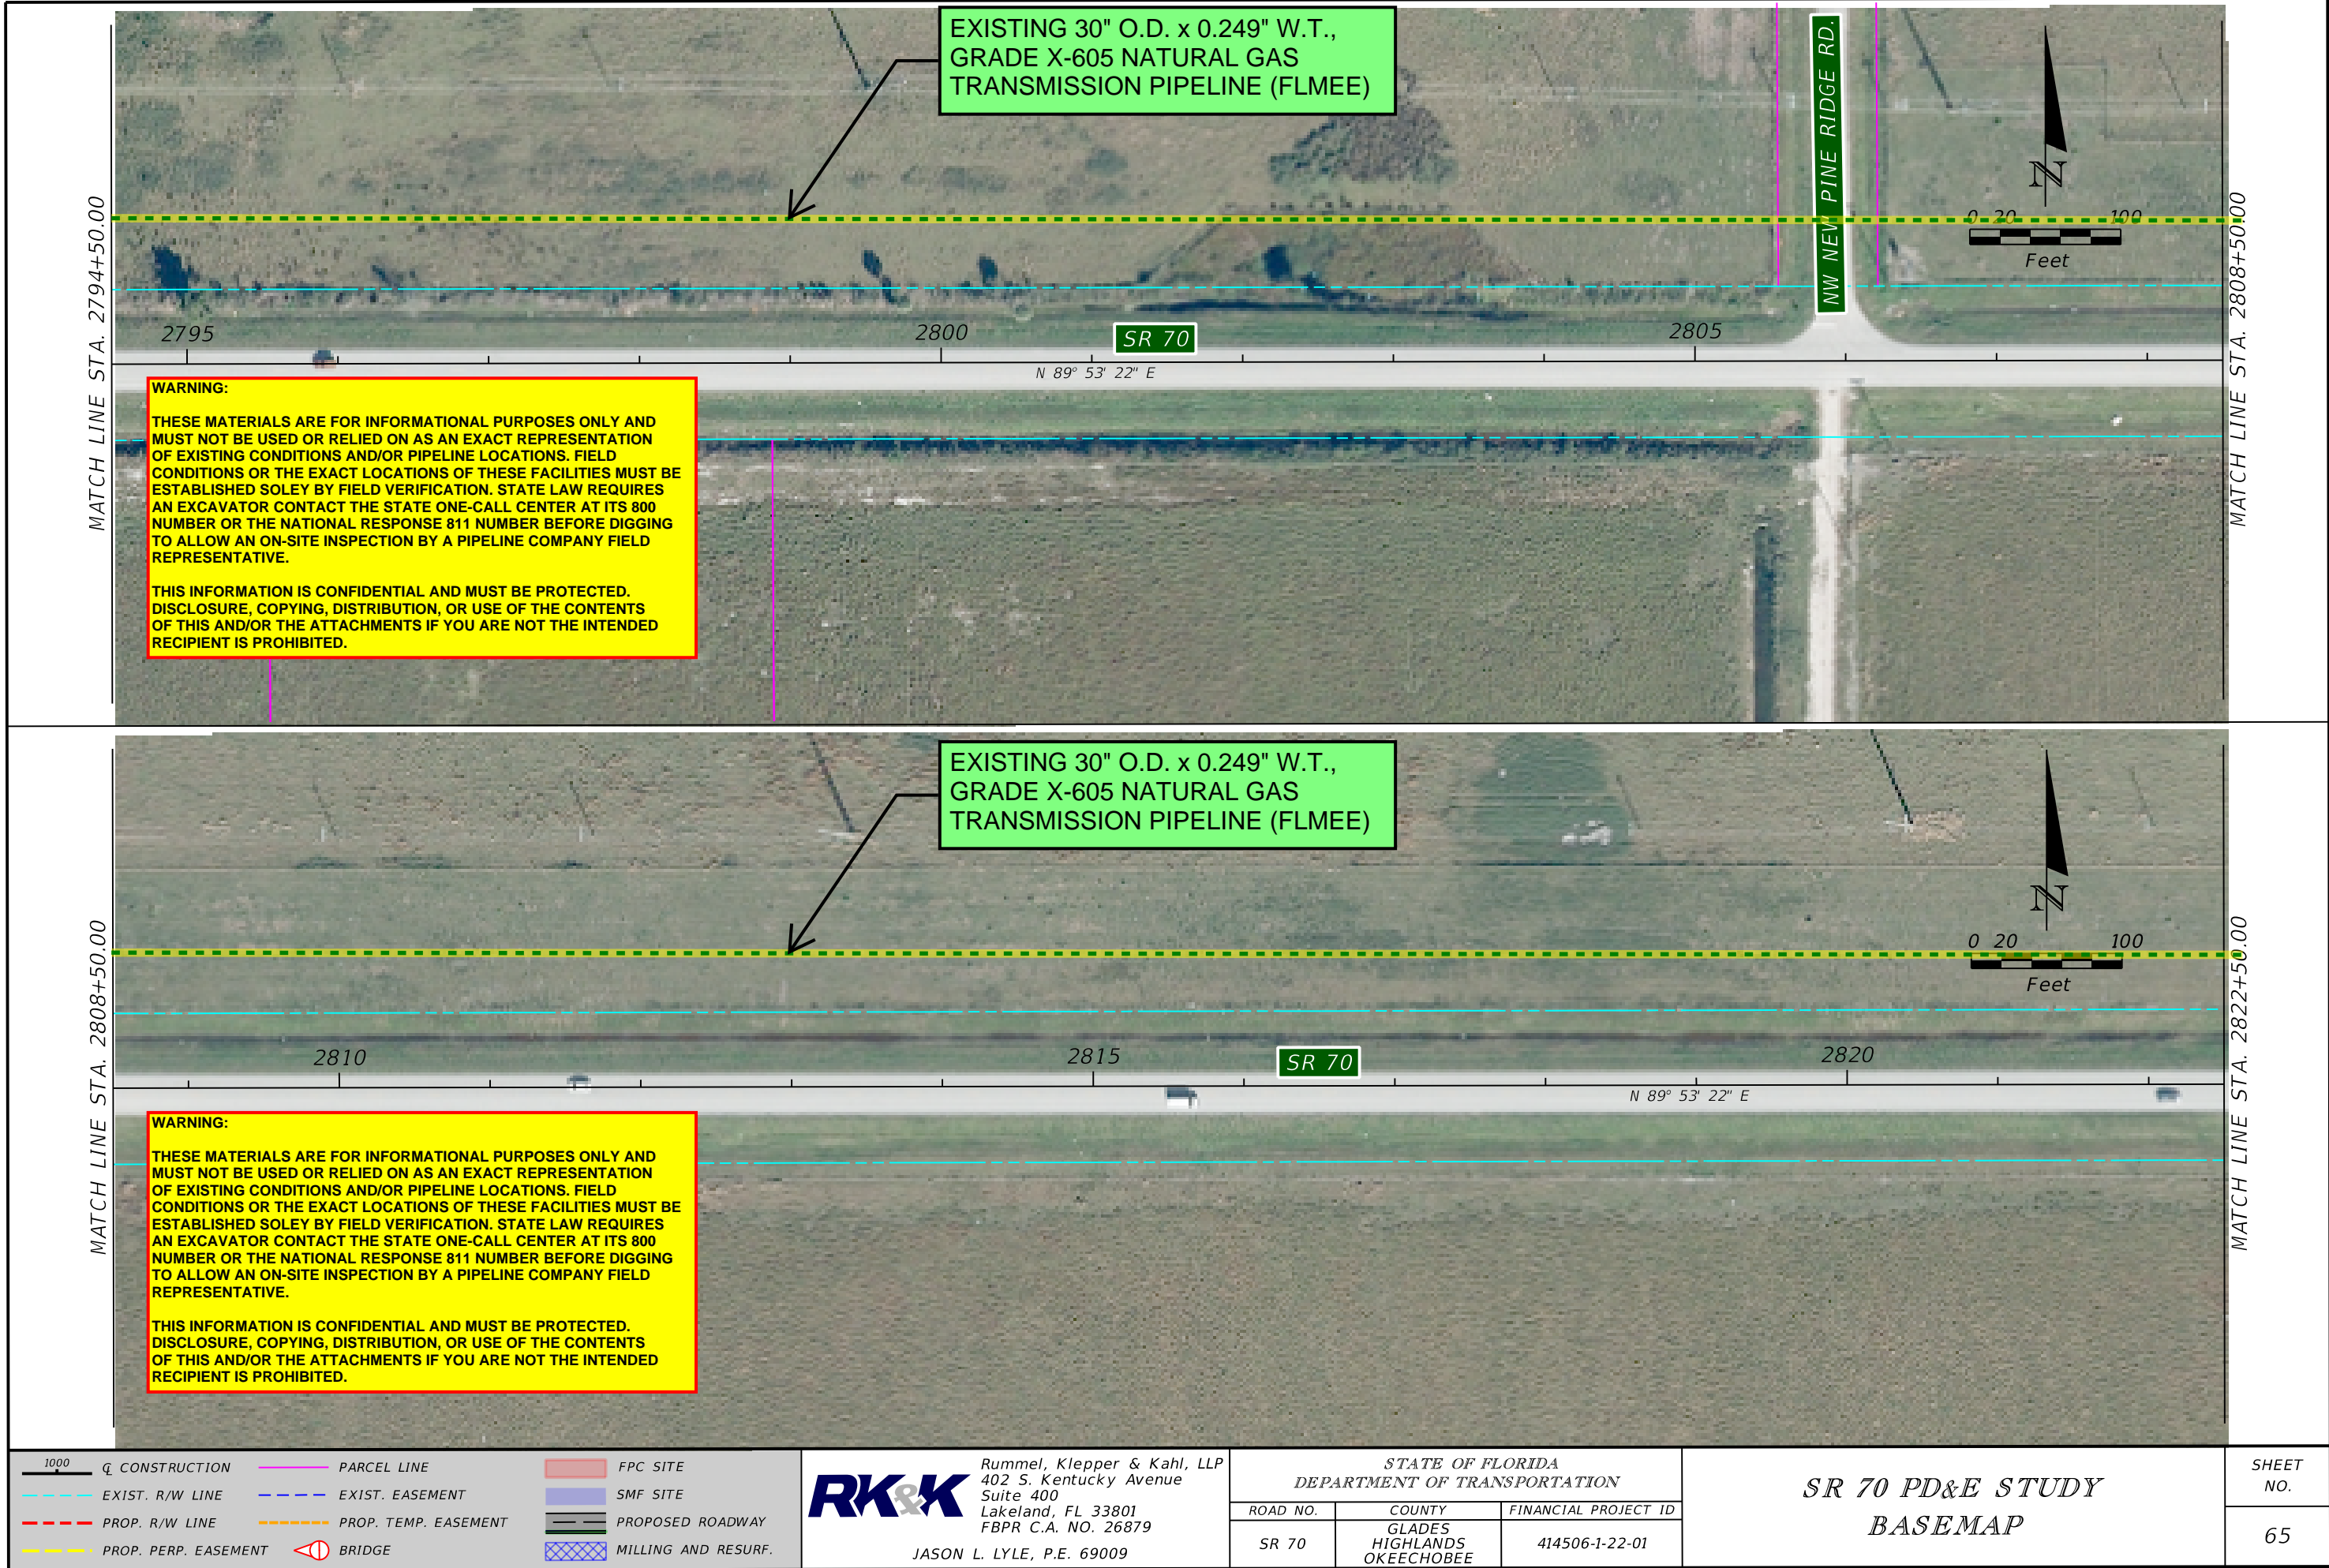

THE OFFICIAL RECORD OF THIS SHEET IS THE ELECTRONIC FILE DIGITALLY SIGNED AND SEALED UNDER RULE 61G15-23.004, F.A.C.

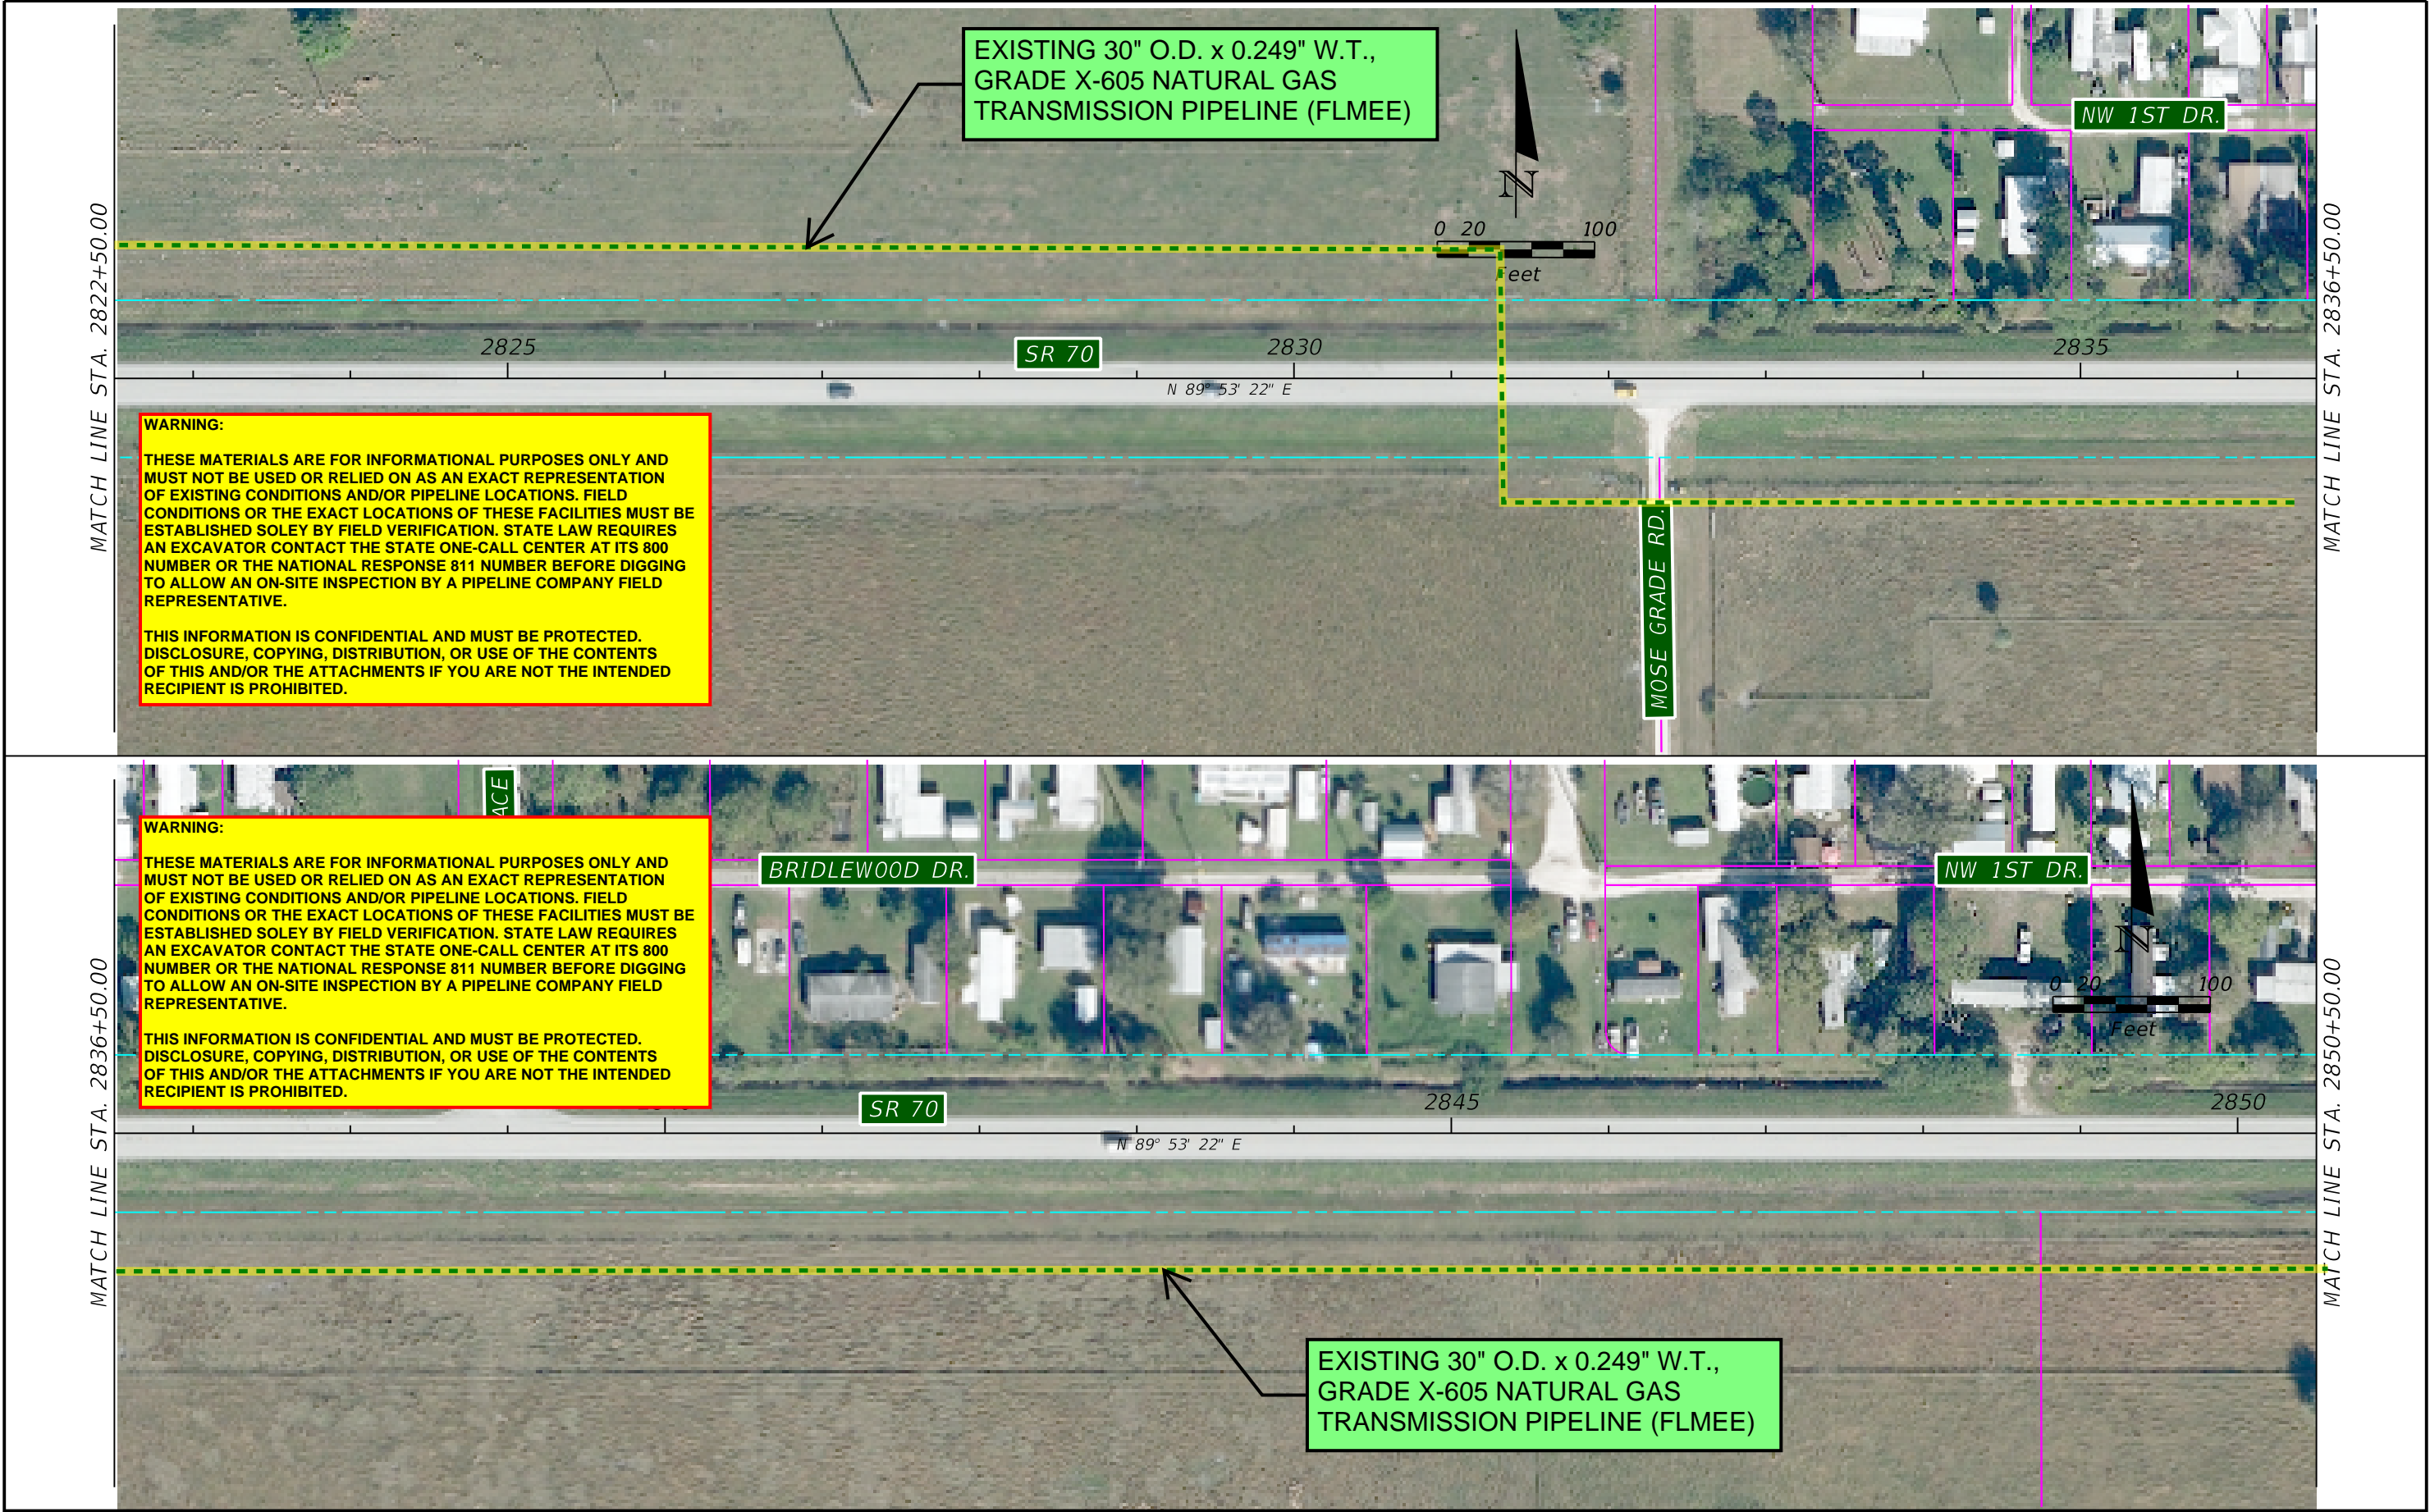

1000

CONSTRUCTION

EXIST. R/W LINE

PROP. R/W LINE

PROP. PERP. EASEMENT

PARCEL LINE

EXIST. EASEMENT

PROP. TEMP. EASEMENT

BRIDGE

FPC SITE

SMF SITE

PROPOSED ROADWAY

MILLING AND RESURF.

RK&K

Rummel, Klepper & Kahl, LLP
402 S. Kentucky Avenue
Suite 400
Lakeland, FL 33801
FBPR C.A. NO. 26879

JASON L. LYLE, P.E. 69009

STATE OF FLORIDA

DEPARTMENT OF TRANSPORTATION

ROAD NO.	COUNTY	FINANCIAL PROJECT ID
SR 70	GLADES HIGHLANDS OKEECHOBEE	414506-1-22-01

SR 70 PD&E STUDY


BASEMAP

SHEET NO.

66

4/7/2023 6:22:38 PM Default

\\ad.rkk.com\fs\Cloud\Projects\2020\20020_DICSCemo\Projects\DI 414506-1 SR 70 Jefferson Ave to CR 29\Eng\41450612201\Roadway\UAO\PLANRD66.dgn

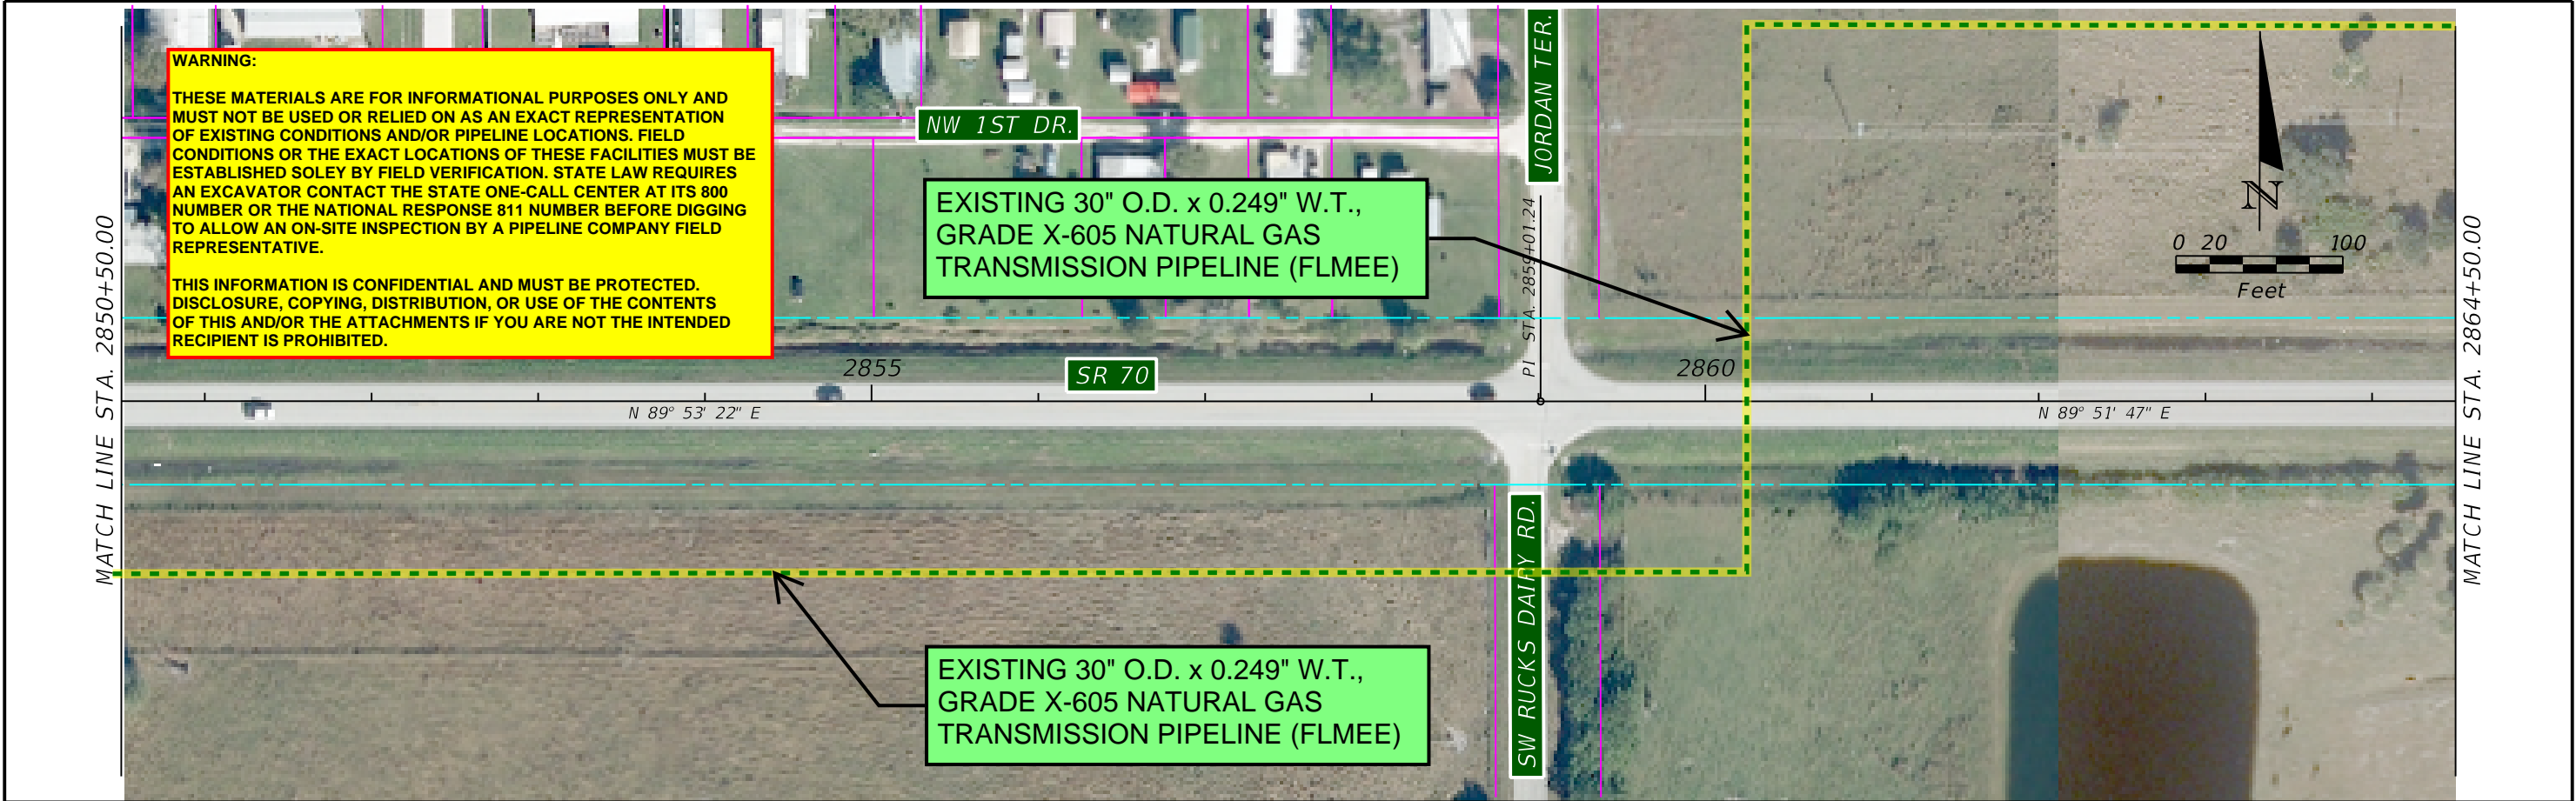


<p>1000</p> <p>CONSTRUCTION</p> <p>EXIST. R/W LINE</p> <p>PROP. R/W LINE</p> <p>PROP. PERP. EASEMENT</p>	<p>PARCEL LINE</p> <p>EXIST. EASEMENT</p> <p>PROP. TEMP. EASEMENT</p> <p>BRIDGE</p>	<p>FPC SITE</p> <p>SMF SITE</p> <p>PROPOSED ROADWAY</p> <p>MILLING AND RESURF.</p>	<p>RK&K</p> <p>Rummel, Klepper & Kahl, LLP 402 S. Kentucky Avenue Suite 400 Lakeland, FL 33801 FBPR C.A. NO. 26879</p> <p>JASON L. LYLE, P.E. 69009</p>	<p>STATE OF FLORIDA DEPARTMENT OF TRANSPORTATION</p> <table><tr><td>ROAD NO.</td><td>COUNTY</td><td>FINANCIAL PROJECT ID</td></tr><tr><td>SR 70</td><td>GLADES HIGHLANDS OKEECHOBEE</td><td>414506-1-22-01</td></tr></table>	ROAD NO.	COUNTY	FINANCIAL PROJECT ID	SR 70	GLADES HIGHLANDS OKEECHOBEE	414506-1-22-01	<p>SR 70 PD&E STUDY BASEMAP</p>	<p>SHEET NO.</p> <p>67</p>
ROAD NO.	COUNTY	FINANCIAL PROJECT ID										
SR 70	GLADES HIGHLANDS OKEECHOBEE	414506-1-22-01										


rmarrero@gonzalez

4/7/2023 6:22:43 PM Default

\\ad.rkk.com\rs\Cloud\Projects\2020\20020_DICSCMO\Projects\DI 414506-1 SR 70 Jefferson Ave to CR 29\Eng\41450612201\Roadway\UAO\PLANRD67.dgn

THE OFFICIAL RECORD OF THIS SHEET IS THE ELECTRONIC FILE DIGITALLY SIGNED AND SEALED UNDER RULE 61G15-23.004, F.A.C.

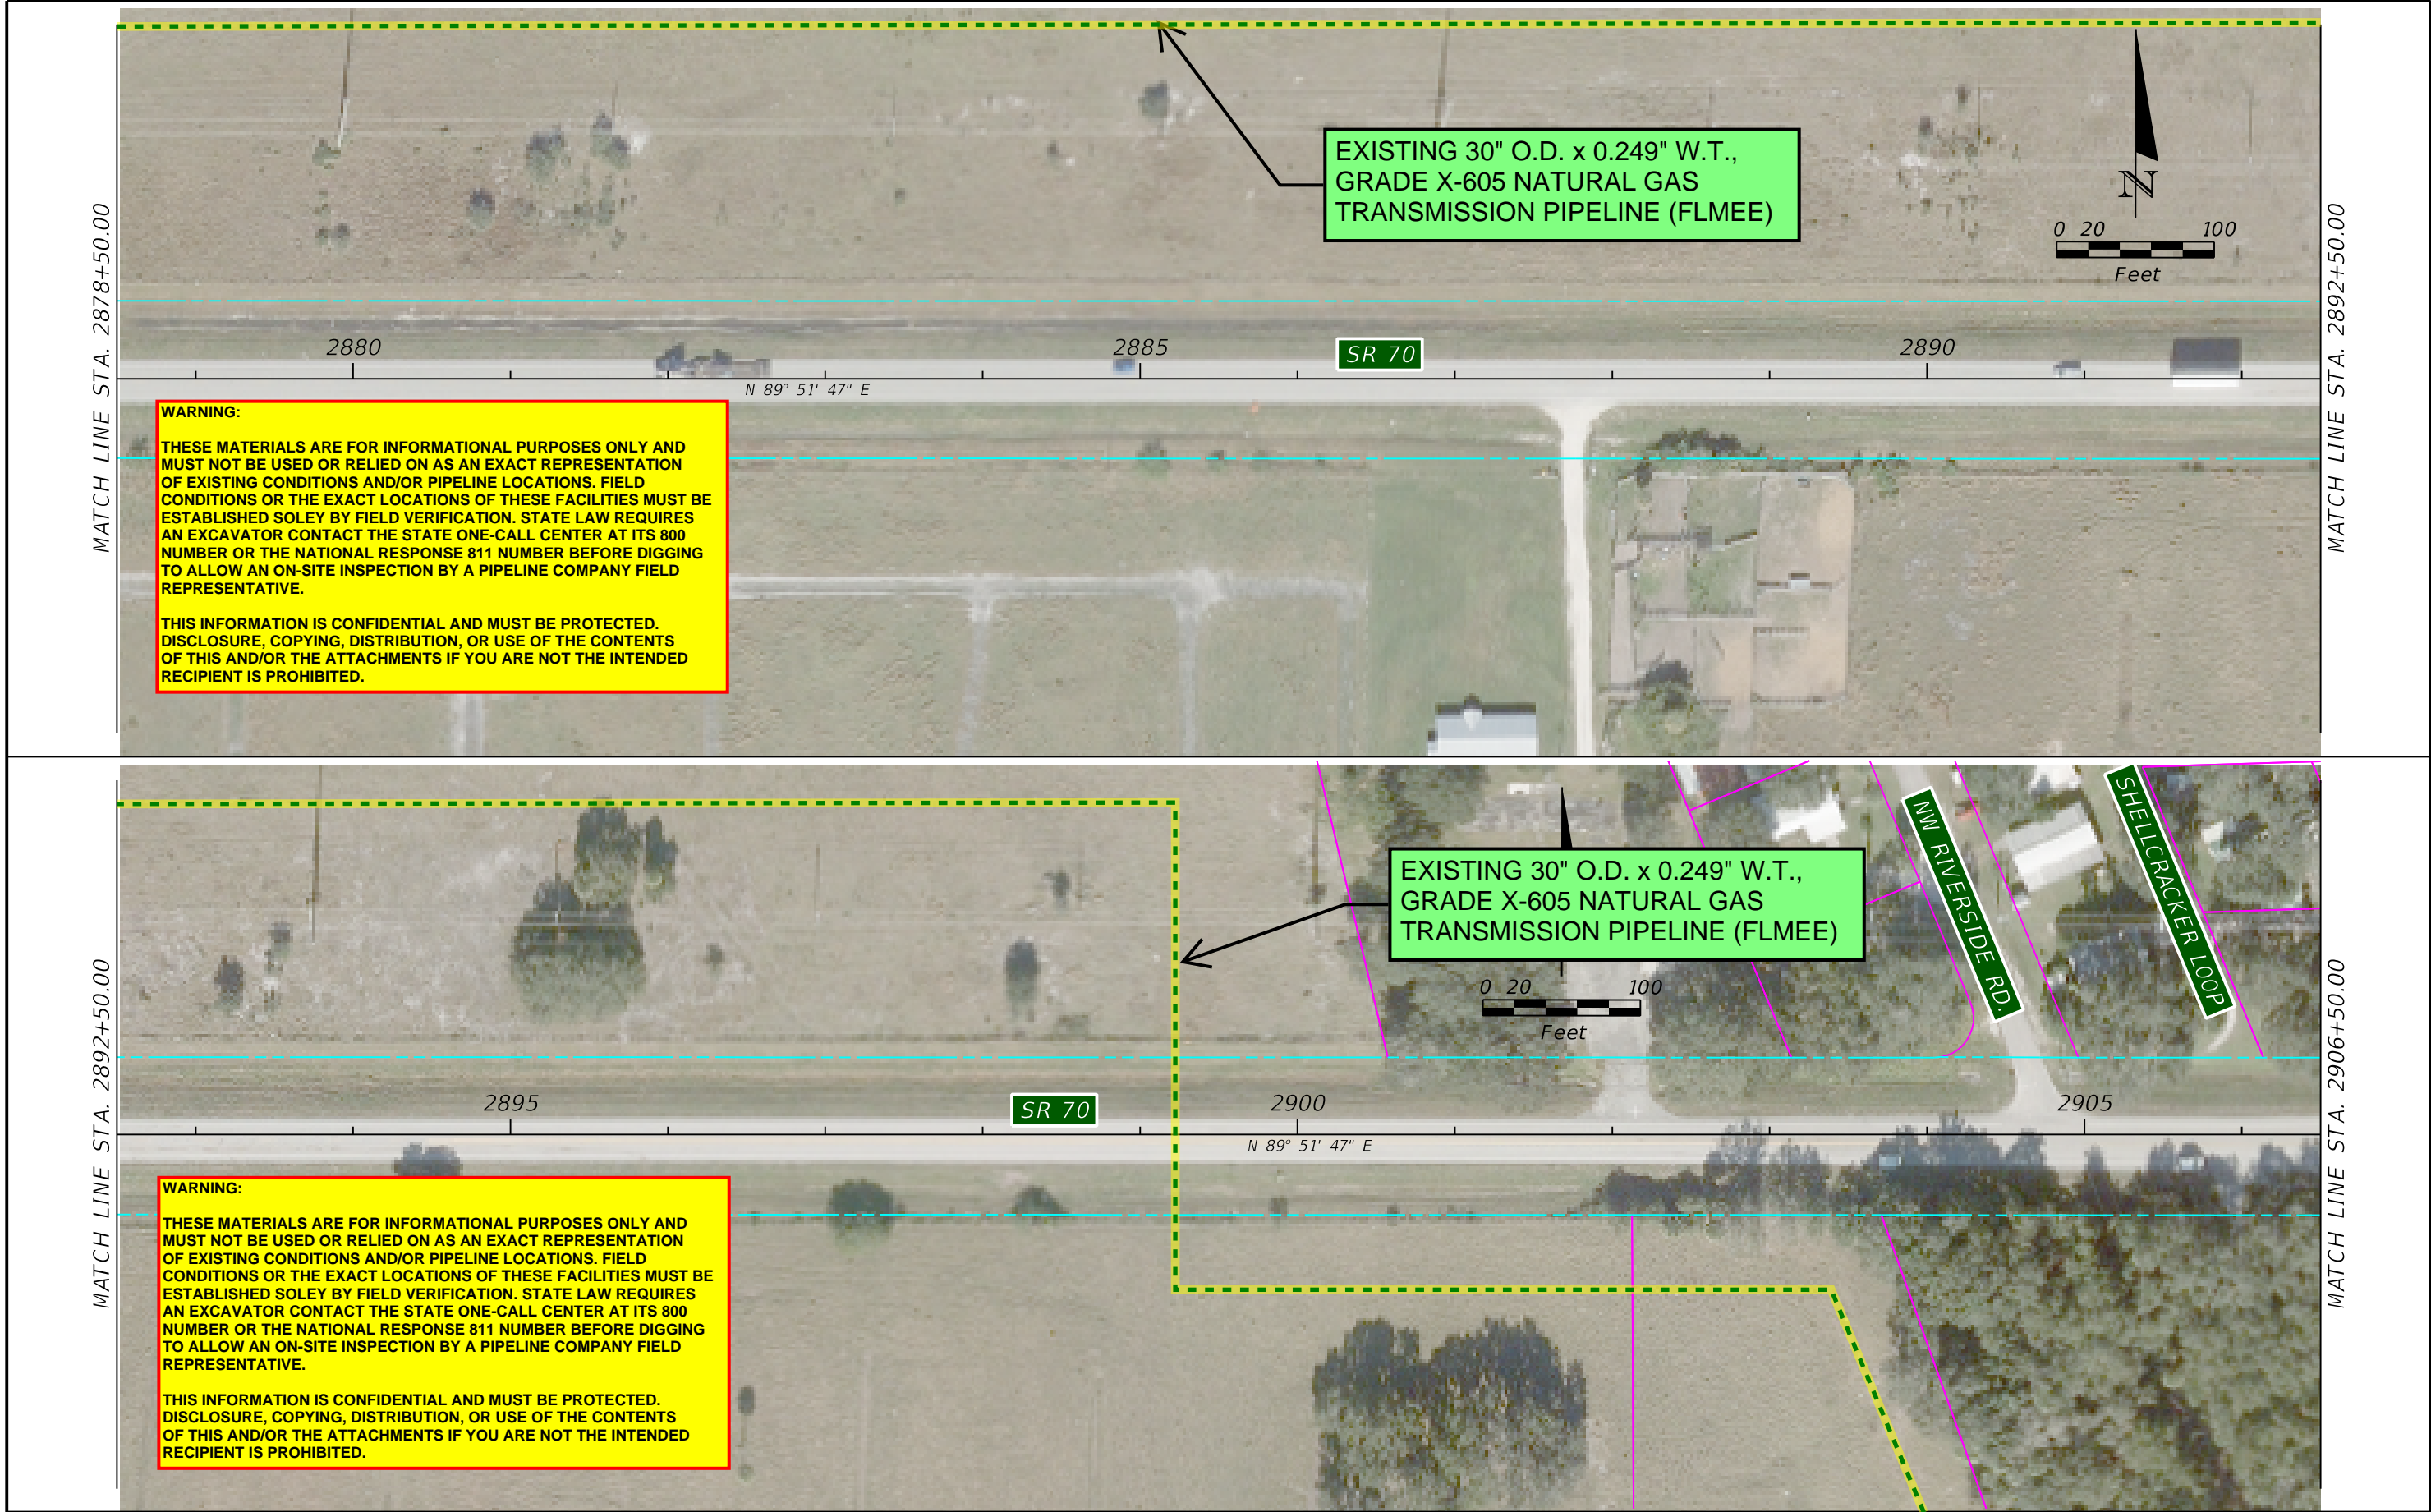

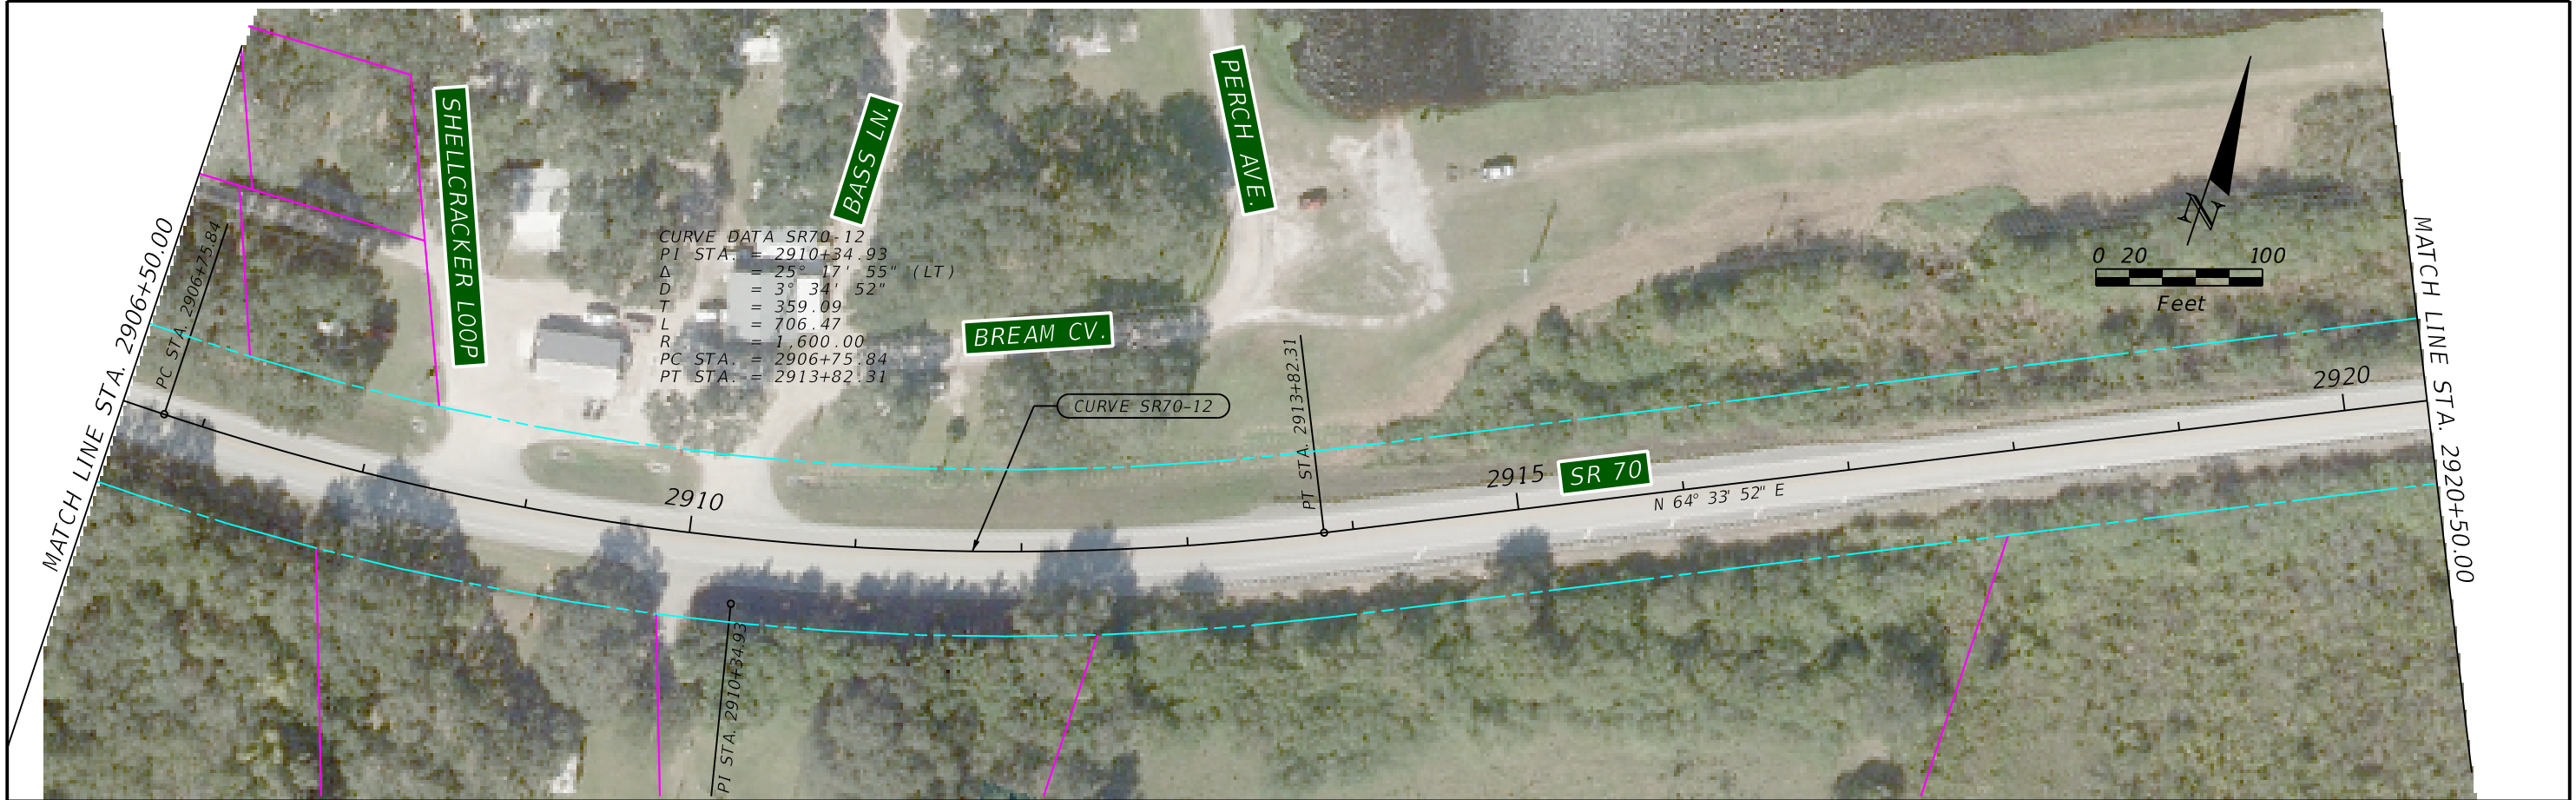

1000

CONSTRUCTION

EXIST. R/W LINE

PROP. R/W LINE

PROP. PERP. EASEMENT

PARCEL LINE

EXIST. EASEMENT

PROP. TEMP. EASEMENT

FPC SITE

SMF SITE

PROPOSED ROADWAY

MILLING AND RESURF.

BRIDGE

RK&K

Rummel, Klepper & Kahl, LLP

402 S. Kentucky Avenue

Suite 400

Lakeland, FL 33801

FBPR C.A. NO. 26879

JASON L. LYLE, P.E. 69009

STATE OF FLORIDA

DEPARTMENT OF TRANSPORTATION

ROAD NO.	COUNTY	FINANCIAL PROJECT ID
SR 70	GLADES HIGHLANDS OKEECHOBEE	414506-1-22-01

SR 70 PD&E STUDY

BASEMAP



SHEET NO.

69

rmarrero@gonzalez

4/7/2023 6:23:04 PM Default

\\ad.rkk.com\fs\Cloud\Projects\2020\20020_DICSCemo\Projects\DI 414506-1 SR 70 Jefferson Ave to CR 29\Eng\41450612201\Roadway\UAO\PLANRD69.dgn

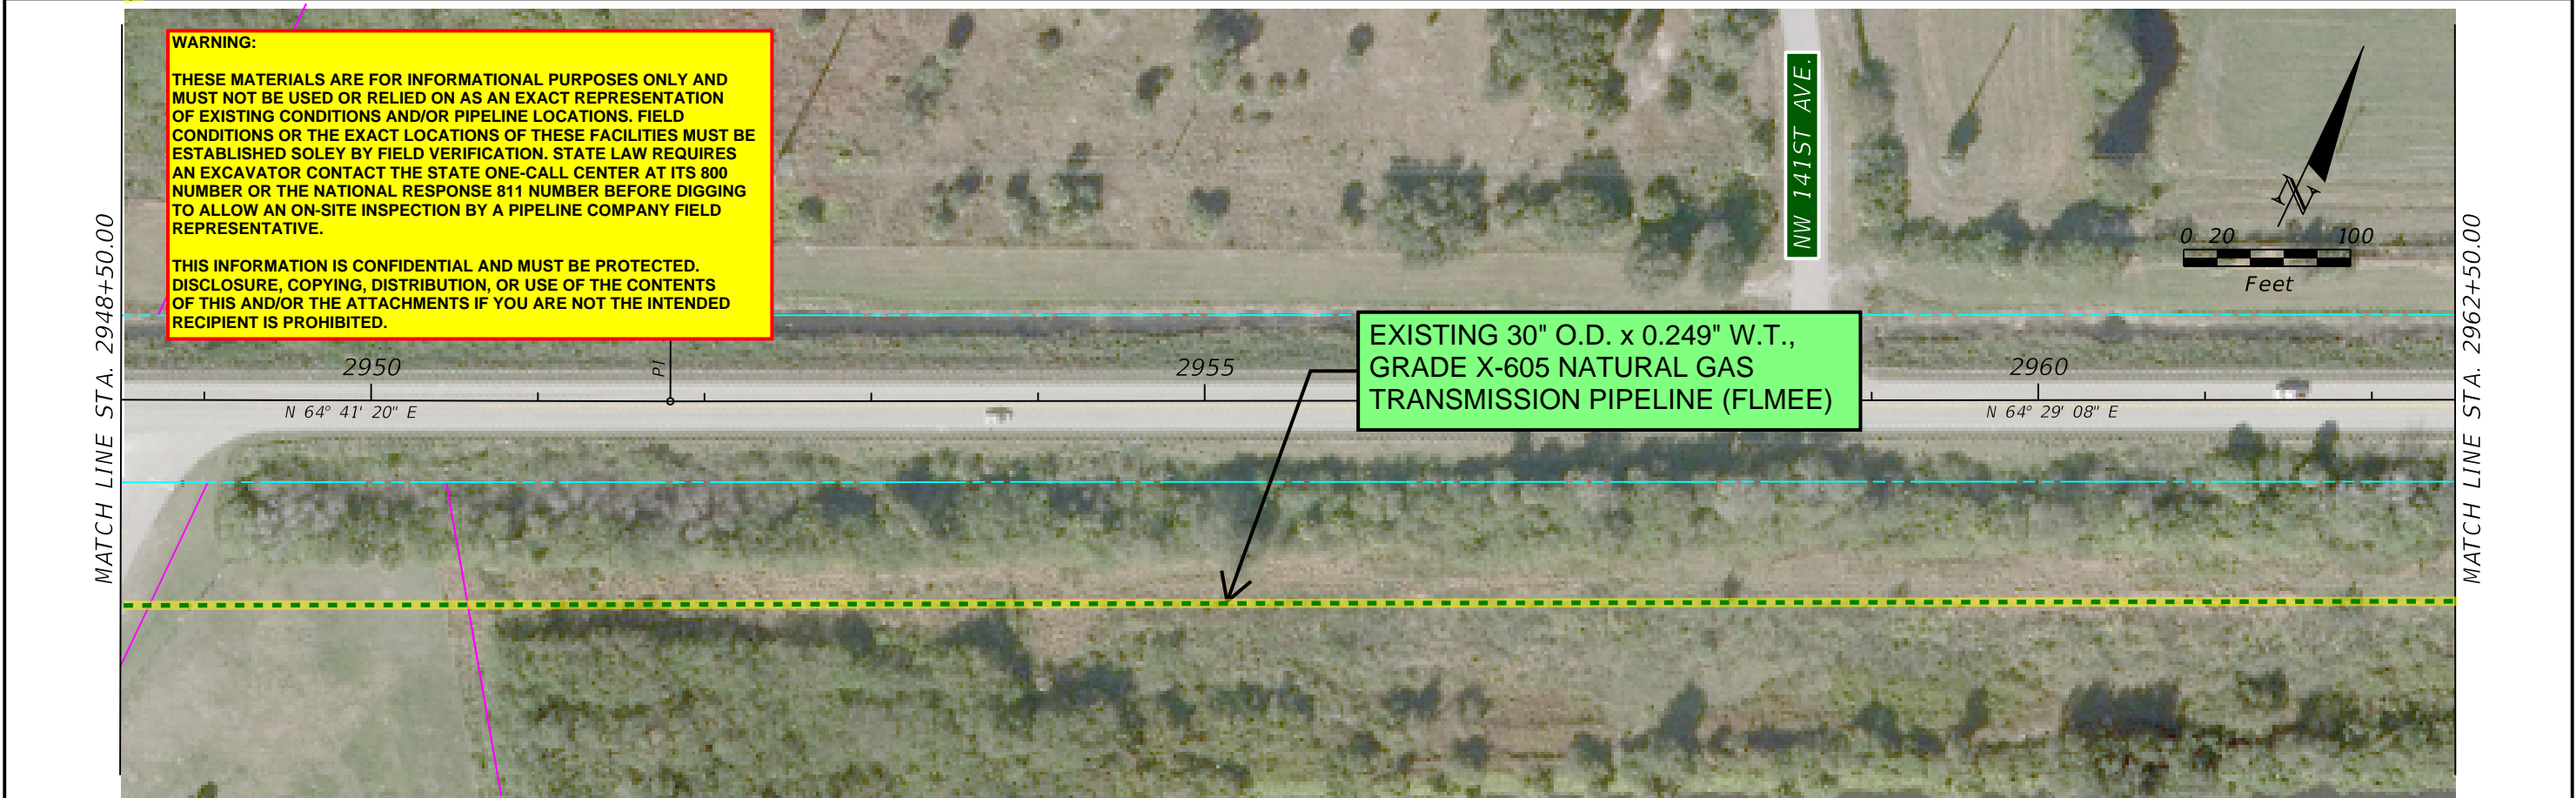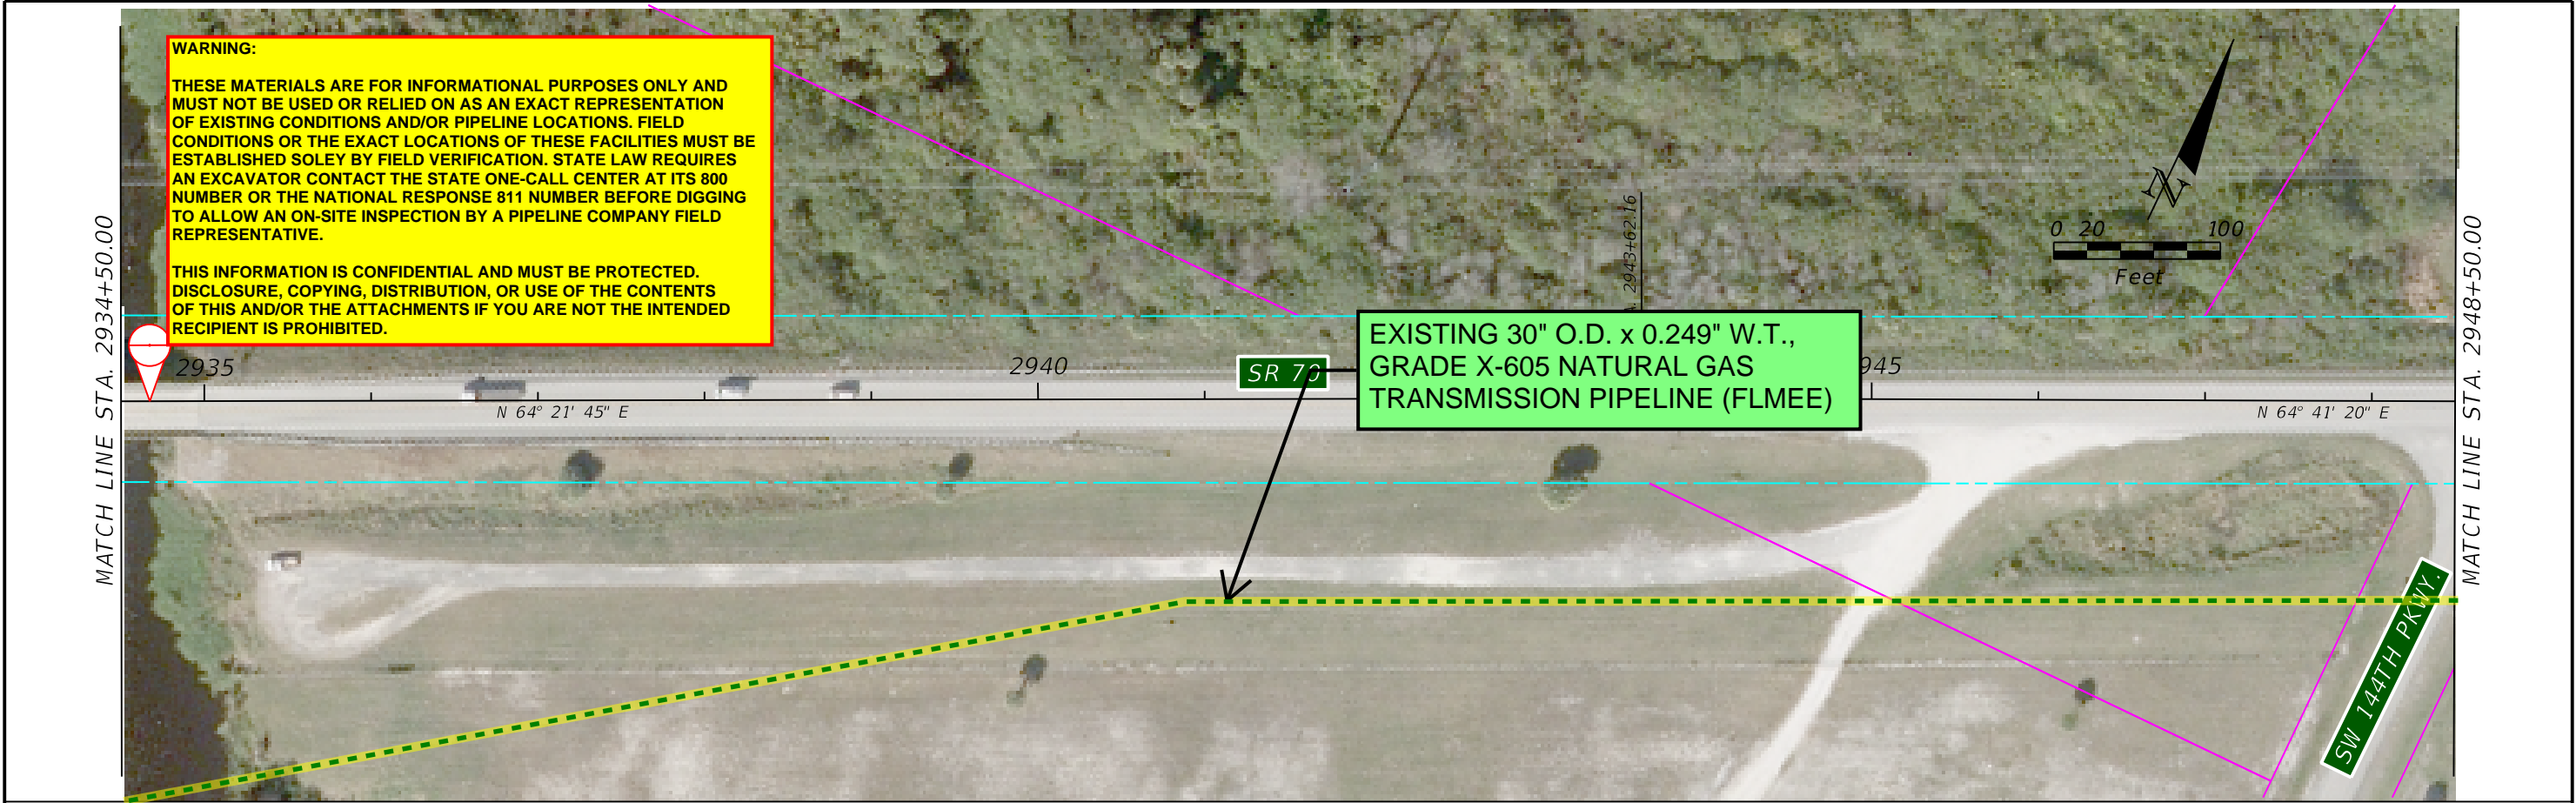

	 <p>Rummel, Klepper & Kahl, LLP 402 S. Kentucky Avenue Suite 400 Lakeland, FL 33801 FBPR C.A. NO. 26879 JASON L. LYLE, P.E. 69009</p>	<table><tr><th colspan="3">STATE OF FLORIDA DEPARTMENT OF TRANSPORTATION</th></tr><tr><th>ROAD NO.</th><th>COUNTY</th><th>FINANCIAL PROJECT ID</th></tr><tr><td>SR 70</td><td>GLADES HIGHLANDS OKEECHOBEE</td><td>414506-1-22-01</td></tr></table>	STATE OF FLORIDA DEPARTMENT OF TRANSPORTATION			ROAD NO.	COUNTY	FINANCIAL PROJECT ID	SR 70	GLADES HIGHLANDS OKEECHOBEE	414506-1-22-01	<p>SR 70 PD&E STUDY BASEMAP</p>	<table><tr><td>SHEET NO.</td></tr><tr><td>70</td></tr></table>	SHEET NO.	70
STATE OF FLORIDA DEPARTMENT OF TRANSPORTATION															
ROAD NO.	COUNTY	FINANCIAL PROJECT ID													
SR 70	GLADES HIGHLANDS OKEECHOBEE	414506-1-22-01													
SHEET NO.															
70															


rmarreroagonzalez 4/7/2023 6:23:17 PM Default \\ad.rkk.com\fs\Cloud\Projects\2020\20020_DICSCemo\Projects\DI 414506-1 SR 70 Jefferson Ave to CR 29\Eng\41450612201\Roadway\UAO\PLANRD70.dgn

THE OFFICIAL RECORD OF THIS SHEET IS THE ELECTRONIC FILE DIGITALLY SIGNED AND SEALED UNDER RULE 61G15-23.004, F.A.C.

WARNING:

THESE MATERIALS ARE FOR INFORMATIONAL PURPOSES ONLY AND MUST NOT BE USED OR RELIED ON AS AN EXACT REPRESENTATION OF EXISTING CONDITIONS AND/OR PIPELINE LOCATIONS. FIELD CONDITIONS OR THE EXACT LOCATIONS OF THESE FACILITIES MUST BE ESTABLISHED SOLEY BY FIELD VERIFICATION. STATE LAW REQUIRES AN EXCAVATOR CONTACT THE STATE ONE-CALL CENTER AT ITS 800 NUMBER OR THE NATIONAL RESPONSE 811 NUMBER BEFORE DIGGING TO ALLOW AN ON-SITE INSPECTION BY A PIPELINE COMPANY FIELD REPRESENTATIVE.

THIS INFORMATION IS CONFIDENTIAL AND MUST BE PROTECTED. DISCLOSURE, COPYING, DISTRIBUTION, OR USE OF THE CONTENTS OF THIS AND/OR THE ATTACHMENTS IF YOU ARE NOT THE INTENDED RECIPIENT IS PROHIBITED.

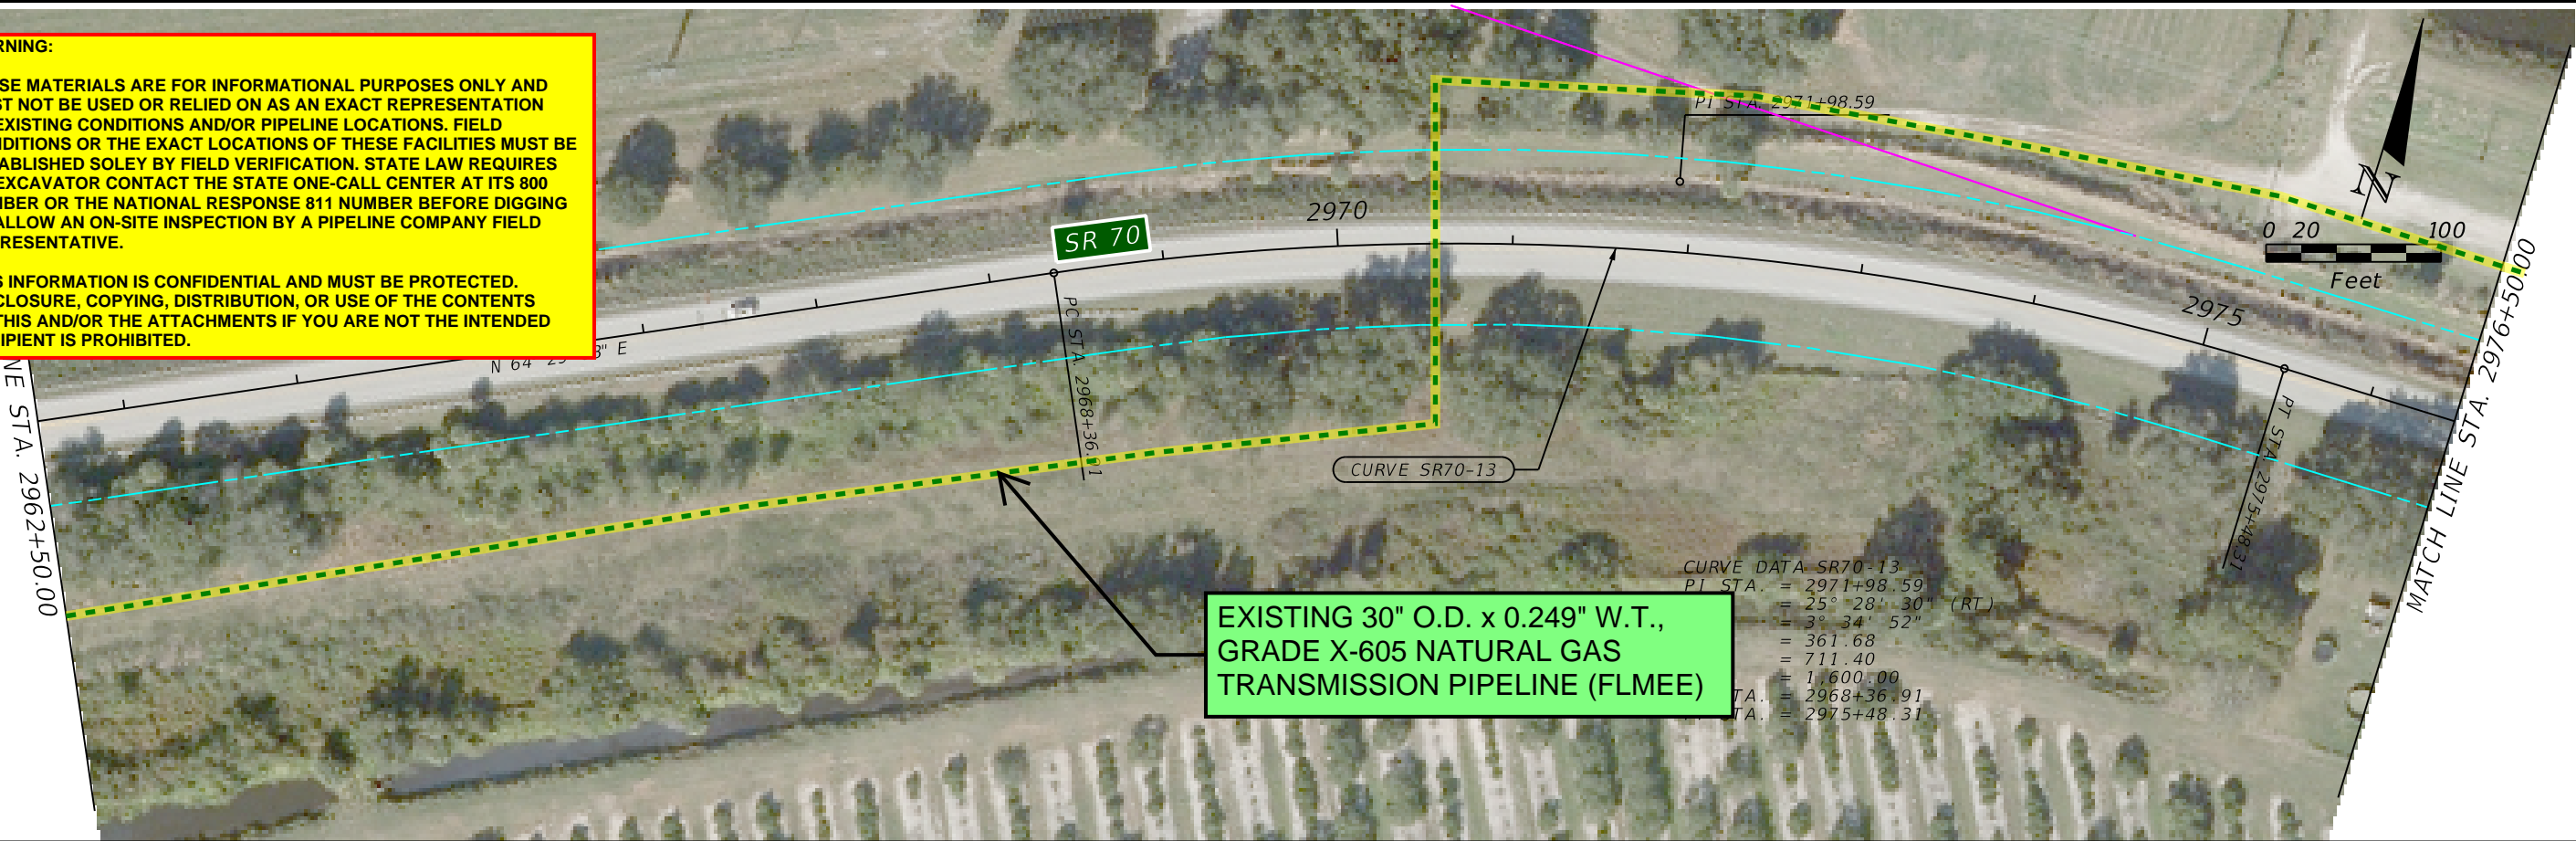


EXISTING 30" O.D. x 0.249" W.T.,
GRADE X-605 NATURAL GAS
TRANSMISSION PIPELINE (FLMEE)

CURVE DATA SR70-13
PI STA. = 2971+98.59
DELTA = 25° 28' 30" (RT)
RADIUS = 3° 34' 52"
CHORD BEARING = 361.68
CHORD DIST. = 711.40
PC STA. = 2968+36.91
PT STA. = 2975+48.31

WARNING:

THESE MATERIALS ARE FOR INFORMATIONAL PURPOSES ONLY AND MUST NOT BE USED OR RELIED ON AS AN EXACT REPRESENTATION OF EXISTING CONDITIONS AND/OR PIPELINE LOCATIONS. FIELD CONDITIONS OR THE EXACT LOCATIONS OF THESE FACILITIES MUST BE ESTABLISHED SOLEY BY FIELD VERIFICATION. STATE LAW REQUIRES AN EXCAVATOR CONTACT THE STATE ONE-CALL CENTER AT ITS 800 NUMBER OR THE NATIONAL RESPONSE 811 NUMBER BEFORE DIGGING TO ALLOW AN ON-SITE INSPECTION BY A PIPELINE COMPANY FIELD REPRESENTATIVE.

THIS INFORMATION IS CONFIDENTIAL AND MUST BE PROTECTED. DISCLOSURE, COPYING, DISTRIBUTION, OR USE OF THE CONTENTS OF THIS AND/OR THE ATTACHMENTS IF YOU ARE NOT THE INTENDED RECIPIENT IS PROHIBITED.

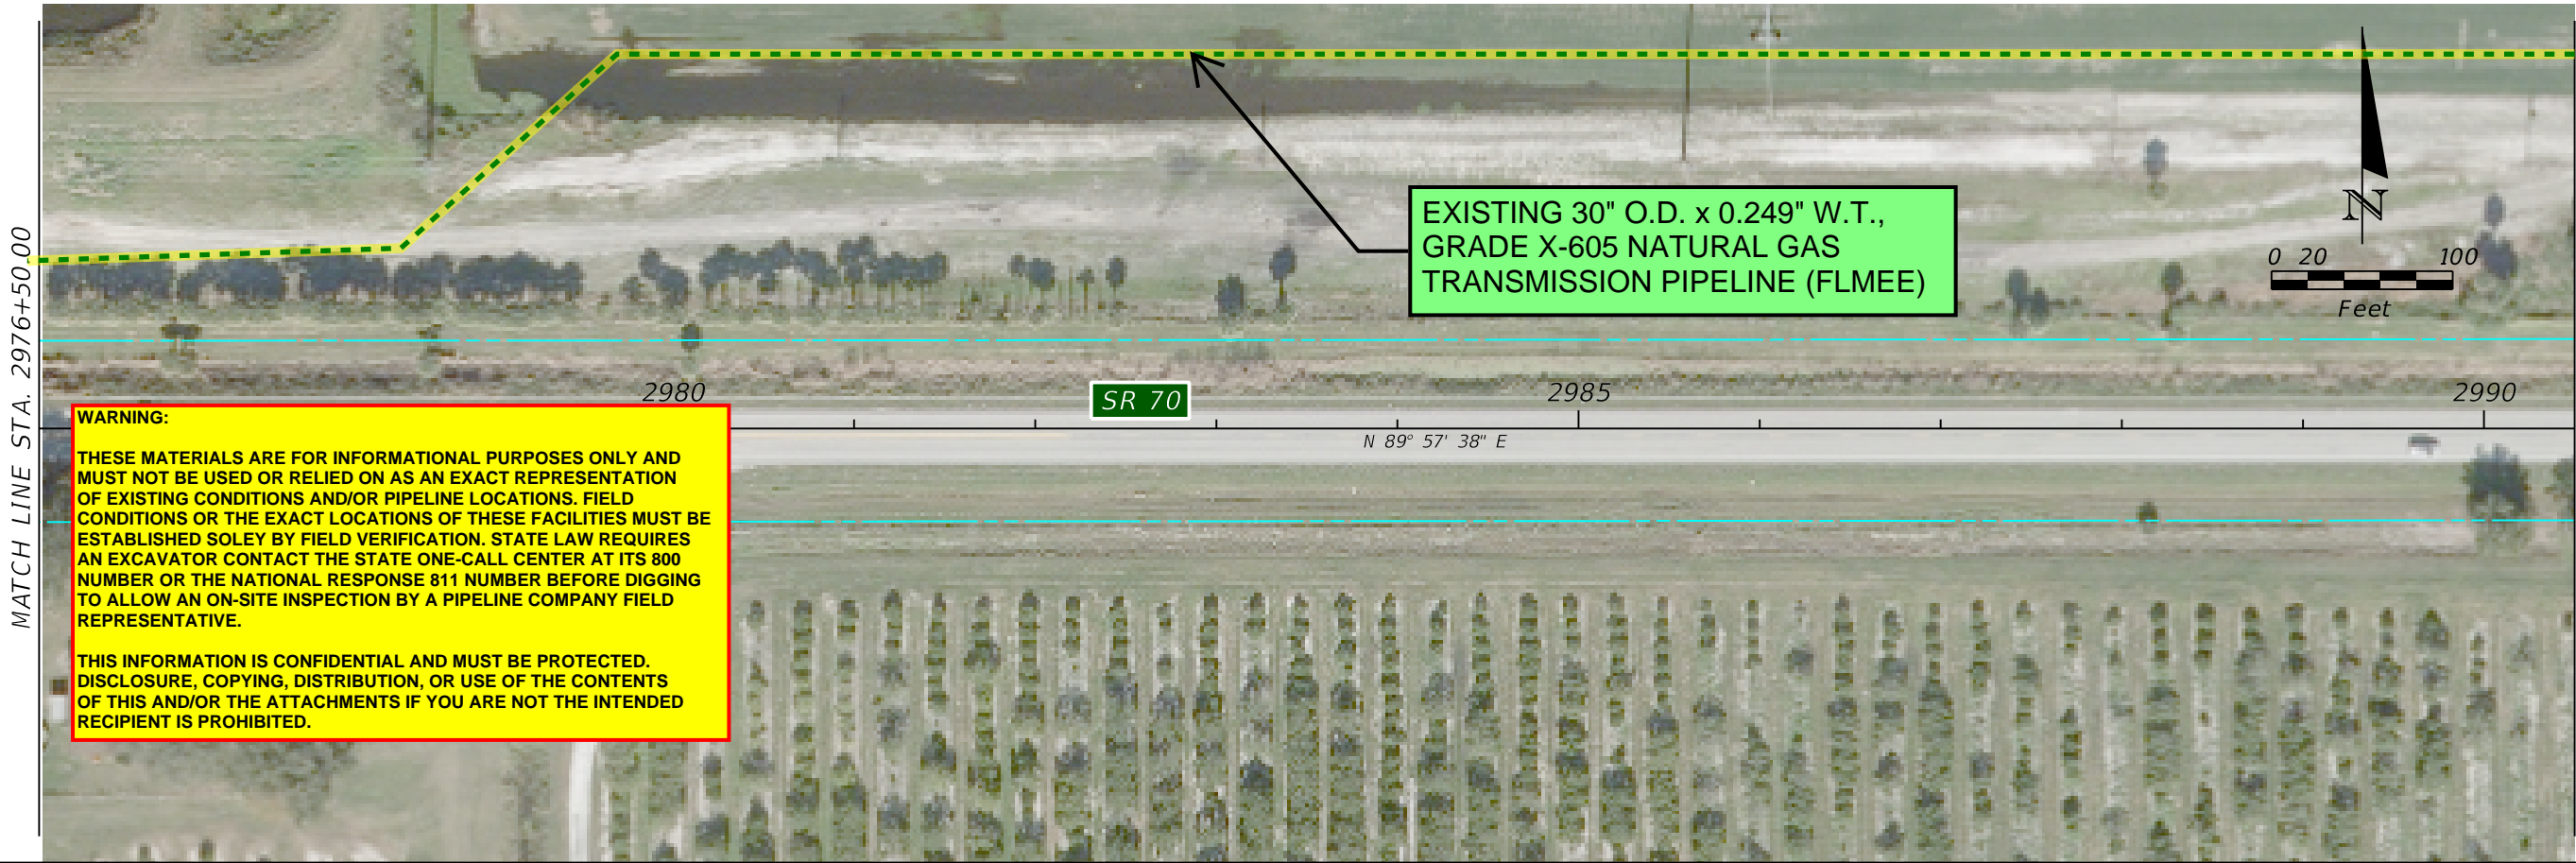

EXISTING 30" O.D. x 0.249" W.T.,
GRADE X-605 NATURAL GAS
TRANSMISSION PIPELINE (FLMEE)

1000	CONSTRUCTION	PARCEL LINE	FPC SITE
EXIST. R/W LINE	EXIST. EASEMENT	SMF SITE	
PROP. R/W LINE	PROP. TEMP. EASEMENT	PROPOSED ROADWAY	
PROP. PERP. EASEMENT	BRIDGE	MILLING AND RESURF.	




Rummel, Klepper & Kahl, LLP
402 S. Kentucky Avenue
Suite 400
Lakeland, FL 33801
FBPR C.A. NO. 26879
JASON L. LYLE, P.E. 69009

STATE OF FLORIDA DEPARTMENT OF TRANSPORTATION		
ROAD NO.	COUNTY	FINANCIAL PROJECT ID
SR 70	GLADES HIGHLANDS OKEECHOBEE	414506-1-22-01

SR 70 PD&E STUDY
BASEMAP

SHEET NO.
71

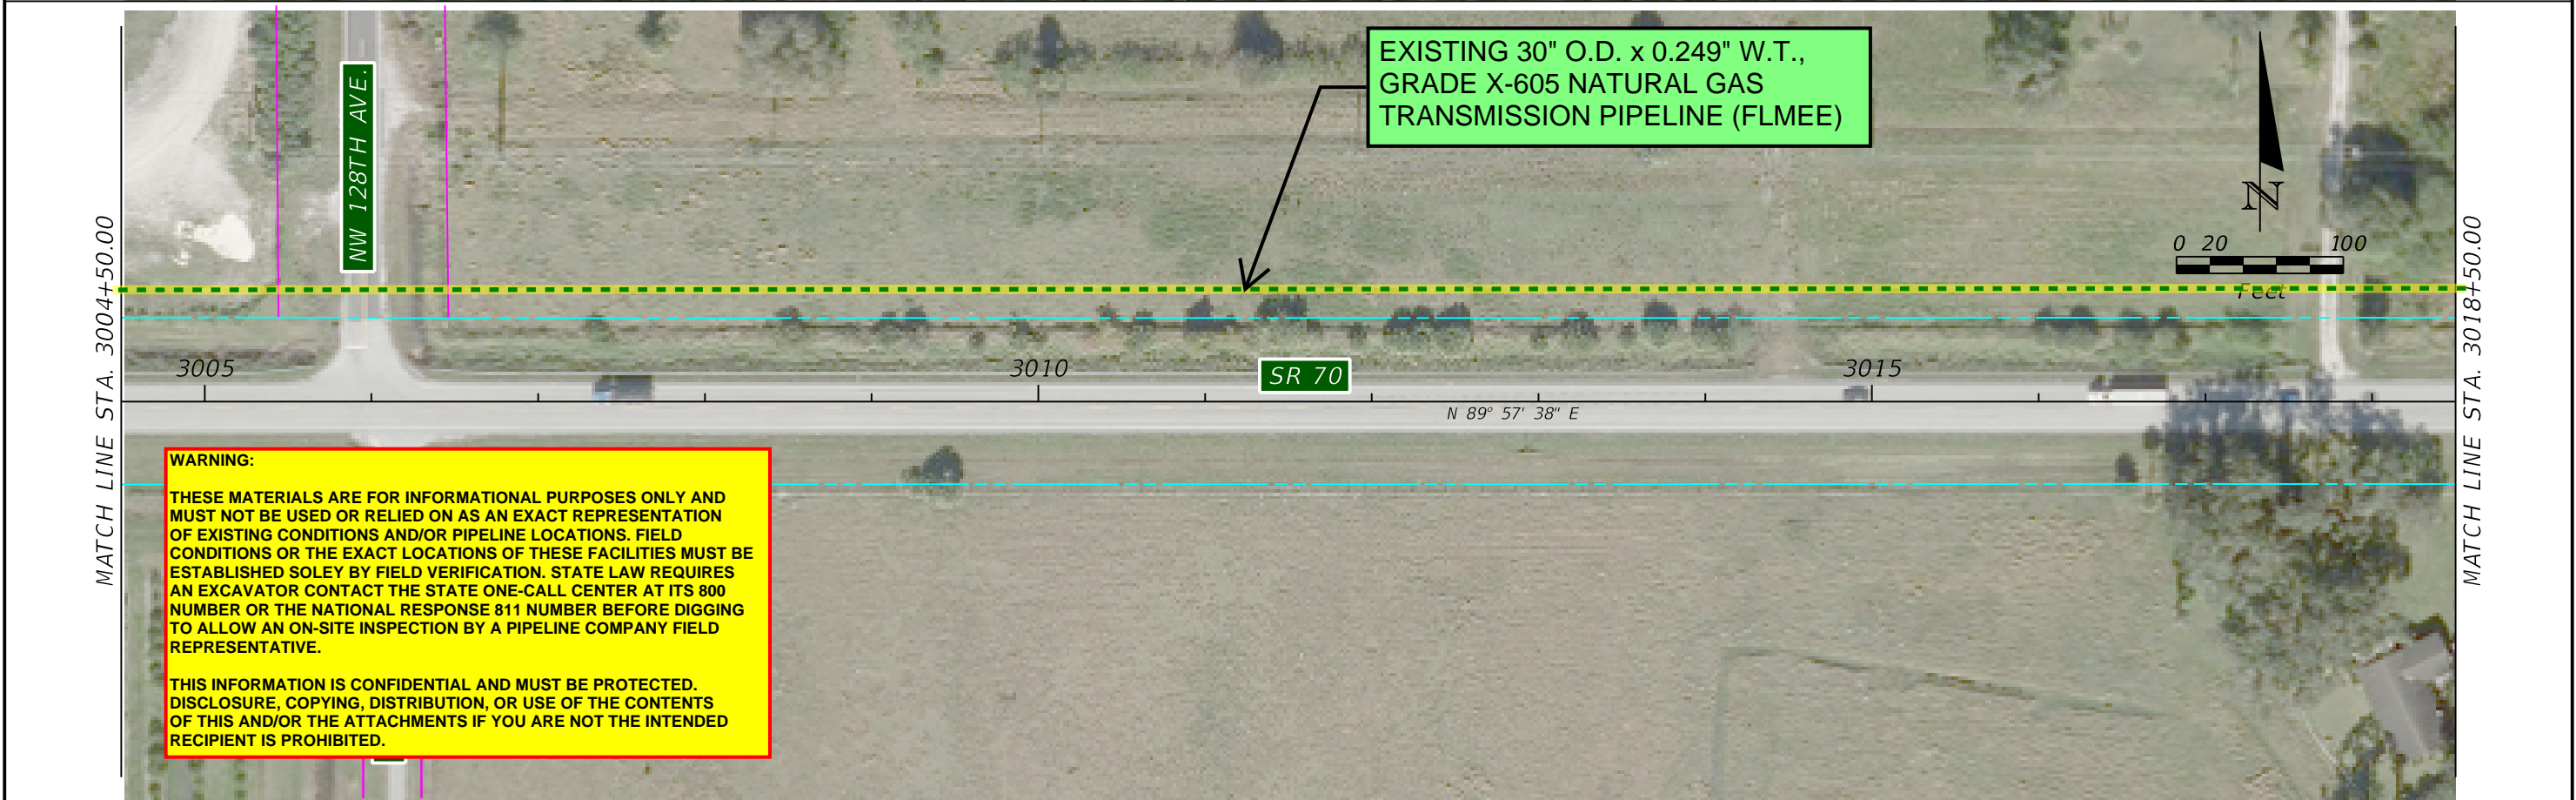

<p>1000</p> <p>Q CONSTRUCTION</p> <p>EXIST. R/W LINE</p> <p>PROP. R/W LINE</p> <p>PROP. PERP. EASEMENT</p>	<p>PARCEL LINE</p> <p>EXIST. EASEMENT</p> <p>PROP. TEMP. EASEMENT</p> <p>BRIDGE</p>	<p>FPC SITE</p> <p>SMF SITE</p> <p>PROPOSED ROADWAY</p> <p>MILLING AND RESURF.</p>	<p>RK&K</p> <p>Rummel, Klepper & Kahl, LLP 402 S. Kentucky Avenue Suite 400 Lakeland, FL 33801 FBPR C.A. NO. 26879</p> <p>JASON L. LYLE, P.E. 69009</p>	<p>STATE OF FLORIDA DEPARTMENT OF TRANSPORTATION</p> <table><tr><td>ROAD NO.</td><td>COUNTY</td><td>FINANCIAL PROJECT ID</td></tr><tr><td>SR 70</td><td>GLADES HIGHLANDS OKEECHOBEE</td><td>414506-1-22-01</td></tr></table>	ROAD NO.	COUNTY	FINANCIAL PROJECT ID	SR 70	GLADES HIGHLANDS OKEECHOBEE	414506-1-22-01	<p>SR 70 PD&E STUDY BASEMAP</p>	<p>SHEET NO.</p> <p>72</p>
ROAD NO.	COUNTY	FINANCIAL PROJECT ID										
SR 70	GLADES HIGHLANDS OKEECHOBEE	414506-1-22-01										

rmarrero@gonzalez

4/7/2023 6:23:41 PM Default

\\ad.rkk.com\fs\Cloud\Projects\2020\20020_DICSCMO\Projects\DI 414506-1 SR 70 Jefferson Ave to CR 29\Eng\41450612201\Roadway\UAO\PLANRD72.dgn

THE OFFICIAL RECORD OF THIS SHEET IS THE ELECTRONIC FILE DIGITALLY SIGNED AND SEALED UNDER RULE 61G15-23.004, F.A.C.

FLORIDA POWER & LIGHT DISTRIBUTION



1000	Q CONSTRUCTION	PARCEL LINE	FPC SITE
---	EXIST. R/W LINE	EXIST. EASEMENT	SMF SITE
---	PROP. R/W LINE	PROP. TEMP. EASEMENT	PROPOSED ROADWAY
---	PROP. PERP. EASEMENT	BRIDGE	MILLING AND RESURF.

Rummel, Klepper & Kahl, LLP
402 S. Kentucky Avenue
Suite 400
Lakeland, FL 33801
FBPR C.A. NO. 26879

JASON L. LYLE, P.E. 69009

STATE OF FLORIDA DEPARTMENT OF TRANSPORTATION		
ROAD NO.	COUNTY	FINANCIAL PROJECT ID
SR 70	HIGHLANDS	449851-1-22-01 450334-1-22-01

SR 70 PD&E STUDY
BASEMAP

SHEET NO.
56



1000

Q CONSTRUCTION

EXIST. R/W LINE

PROP. R/W LINE

PROP. PERP. EASEMENT

PARCEL LINE

EXIST. EASEMENT

PROP. TEMP. EASEMENT

⬮

BRIDGE

■

FPC SITE

■

SMF SITE

PROPOSED ROADWAY

▨

MILLING AND RESURF.

RK&K

Rummel, Klepper & Kahl, LLP
402 S. Kentucky Avenue
Suite 400
Lakeland, FL 33801
FBPR C.A. NO. 26879

JASON L. LYLE, P.E. 69009

STATE OF FLORIDA DEPARTMENT OF TRANSPORTATION		
ROAD NO.	COUNTY	FINANCIAL PROJECT ID
SR 70	HIGHLANDS	450334-1-22-01

SR 70 PD&E STUDY
BASEMAP

SHEET NO.

57

jgalgano


6/29/2023 3:27:32 PM Default

\\ad.rkk.com\fs\Cloud\Projects\2020\20020_DIC5CEMO\Projects\DI 414506-1 SR 70 Jefferson Ave to CR 29\Eng\41450612201\Roadway\UAO\PLANRD57.dgn


THE OFFICIAL RECORD OF THIS SHEET IS THE ELECTRONIC FILE DIGITALLY SIGNED AND SEALED UNDER RULE 61G15-23.004, F.A.C.



<div>1000</div> <div>Q CONSTRUCTION</div> <div>EXIST. R/W LINE</div> <div>PROP. R/W LINE</div> <div>PROP. PERP. EASEMENT</div>	<div>PARCEL LINE</div> <div>EXIST. EASEMENT</div> <div>PROP. TEMP. EASEMENT</div> <div>BRIDGE</div>	<div>FPC SITE</div> <div>SMF SITE</div> <div>PROPOSED ROADWAY</div> <div>MILLING AND RESURF.</div>	<div>RK&K</div> <div>Rummel, Klepper & Kahl, LLP 402 S. Kentucky Avenue Suite 400 Lakeland, FL 33801 FBPR C.A. NO. 26879</div> <div>JASON L. LYLE, P.E. 69009</div>	<div>STATE OF FLORIDA</div> <div>DEPARTMENT OF TRANSPORTATION</div> <table border="1"><tr><th>ROAD NO.</th><th>COUNTY</th><th>FINANCIAL PROJECT ID</th></tr><tr><td>SR 70</td><td>HIGHLANDS</td><td>450334-1-22-01</td></tr></table>	ROAD NO.	COUNTY	FINANCIAL PROJECT ID	SR 70	HIGHLANDS	450334-1-22-01	<div>SR 70 PD&E STUDY</div> <div>BASEMAP</div>	<div>SHEET NO.</div> <div>59</div>
ROAD NO.	COUNTY	FINANCIAL PROJECT ID										
SR 70	HIGHLANDS	450334-1-22-01										

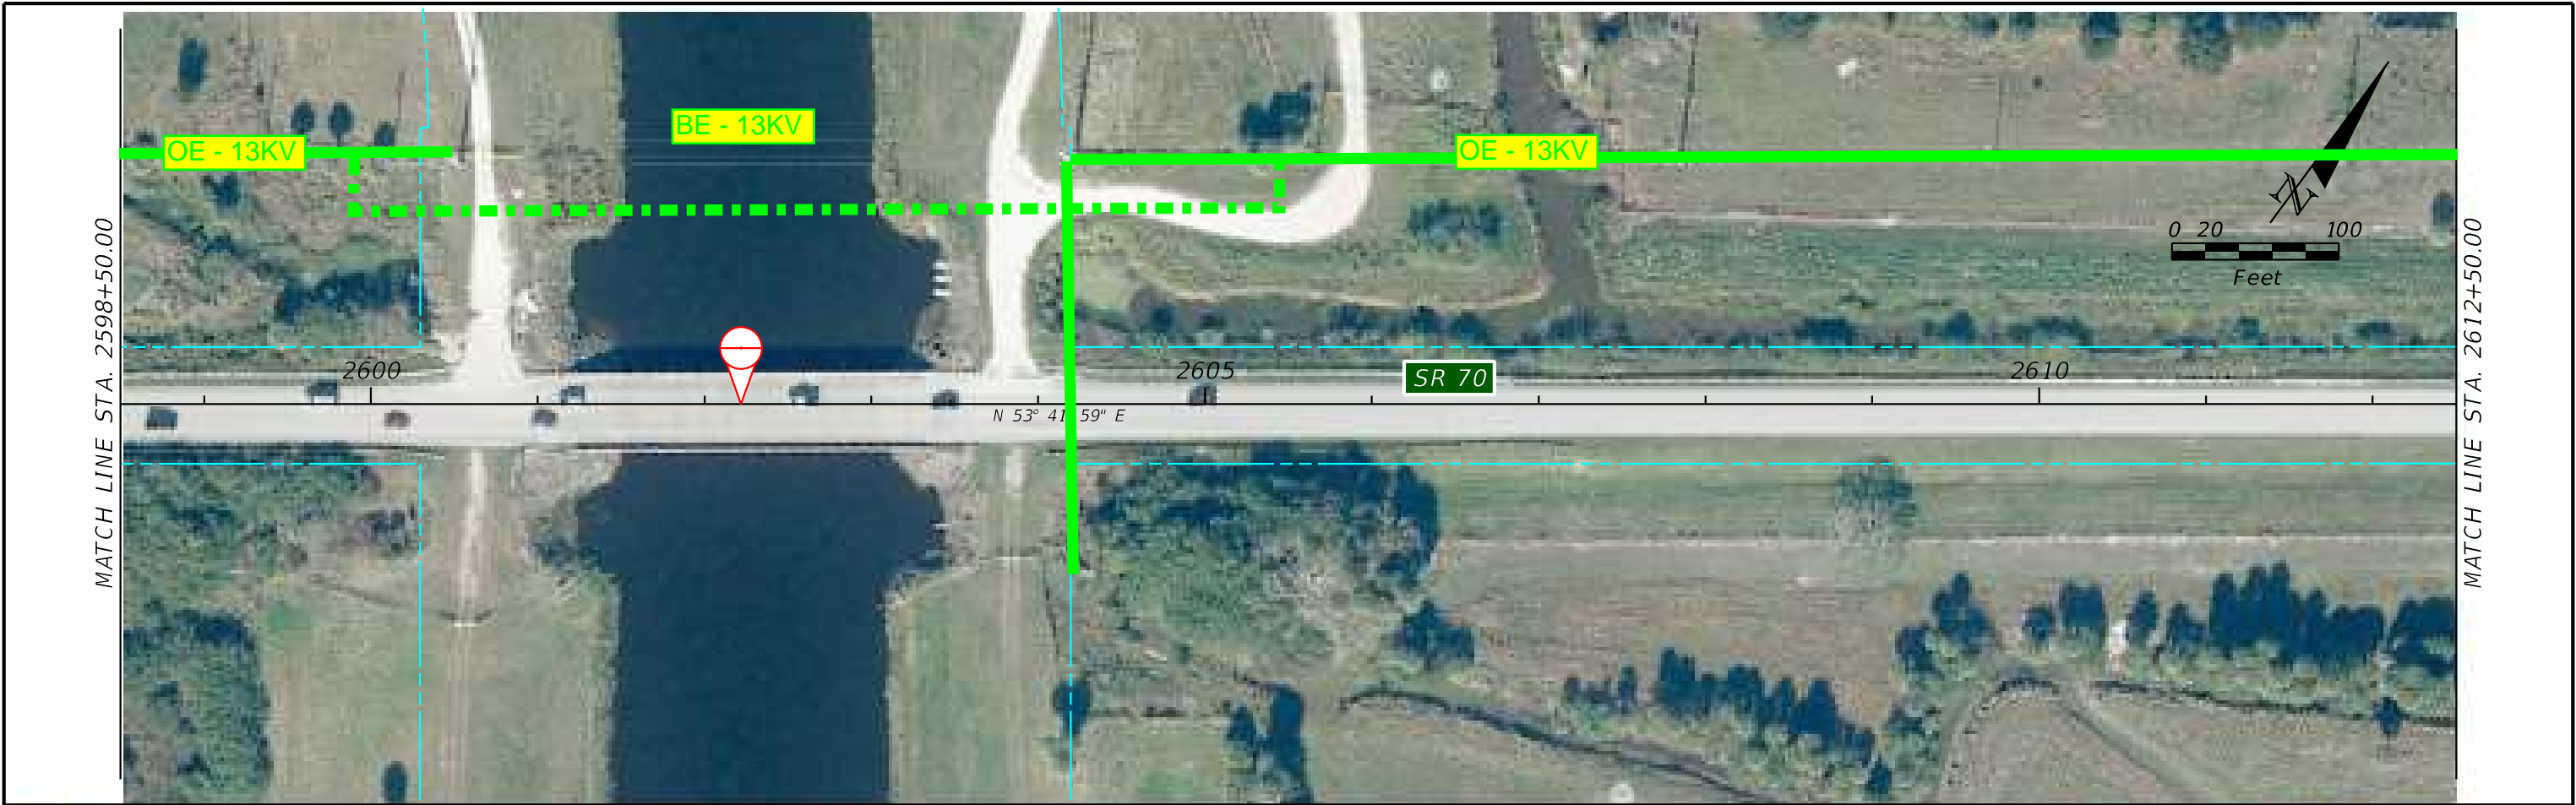

<div><div><div>1000</div><div>Q CONSTRUCTION</div></div><div><div>---</div><div>EXIST. R/W LINE</div></div><div><div>---</div><div>PROP. R/W LINE</div></div><div><div>---</div><div>PROP. PERP. EASEMENT</div></div></div> <div><div><div>---</div><div>PARCEL LINE</div></div><div><div>---</div><div>EXIST. EASEMENT</div></div><div><div>---</div><div>PROP. TEMP. EASEMENT</div></div><div><div></div><div>BRIDGE</div></div></div> <div><div><div></div><div>FPC SITE</div></div><div><div></div><div>SMF SITE</div></div><div><div></div><div>PROPOSED ROADWAY</div></div><div><div></div><div>MILLING AND RESURF.</div></div></div>				<div><div><div><div><div>RK&K</div><div>Rummel, Klepper & Kahl, LLP</div><div>402 S. Kentucky Avenue</div><div>Suite 400</div><div>Lakeland, FL 33801</div><div>FBPR C.A. NO. 26879</div></div><div><div>JASON L. LYLE, P.E. 69009</div><div>6/29/2023 3:27:38 PM Default</div></div></div><div><div>STATE OF FLORIDA</div><div>DEPARTMENT OF TRANSPORTATION</div><table><tr><th>ROAD NO.</th><th>COUNTY</th><th>FINANCIAL PROJECT ID</th></tr><tr><td>SR 70</td><td>HIGHLANDS</td><td>450334-1-22-01</td></tr></table></div></div></div>		ROAD NO.	COUNTY	FINANCIAL PROJECT ID	SR 70	HIGHLANDS	450334-1-22-01	<div><div>SR 70 PD&E STUDY</div><div>BASEMAP</div></div>		<div><div>SHEET NO.</div><div>58</div></div>
ROAD NO.	COUNTY	FINANCIAL PROJECT ID												
SR 70	HIGHLANDS	450334-1-22-01												

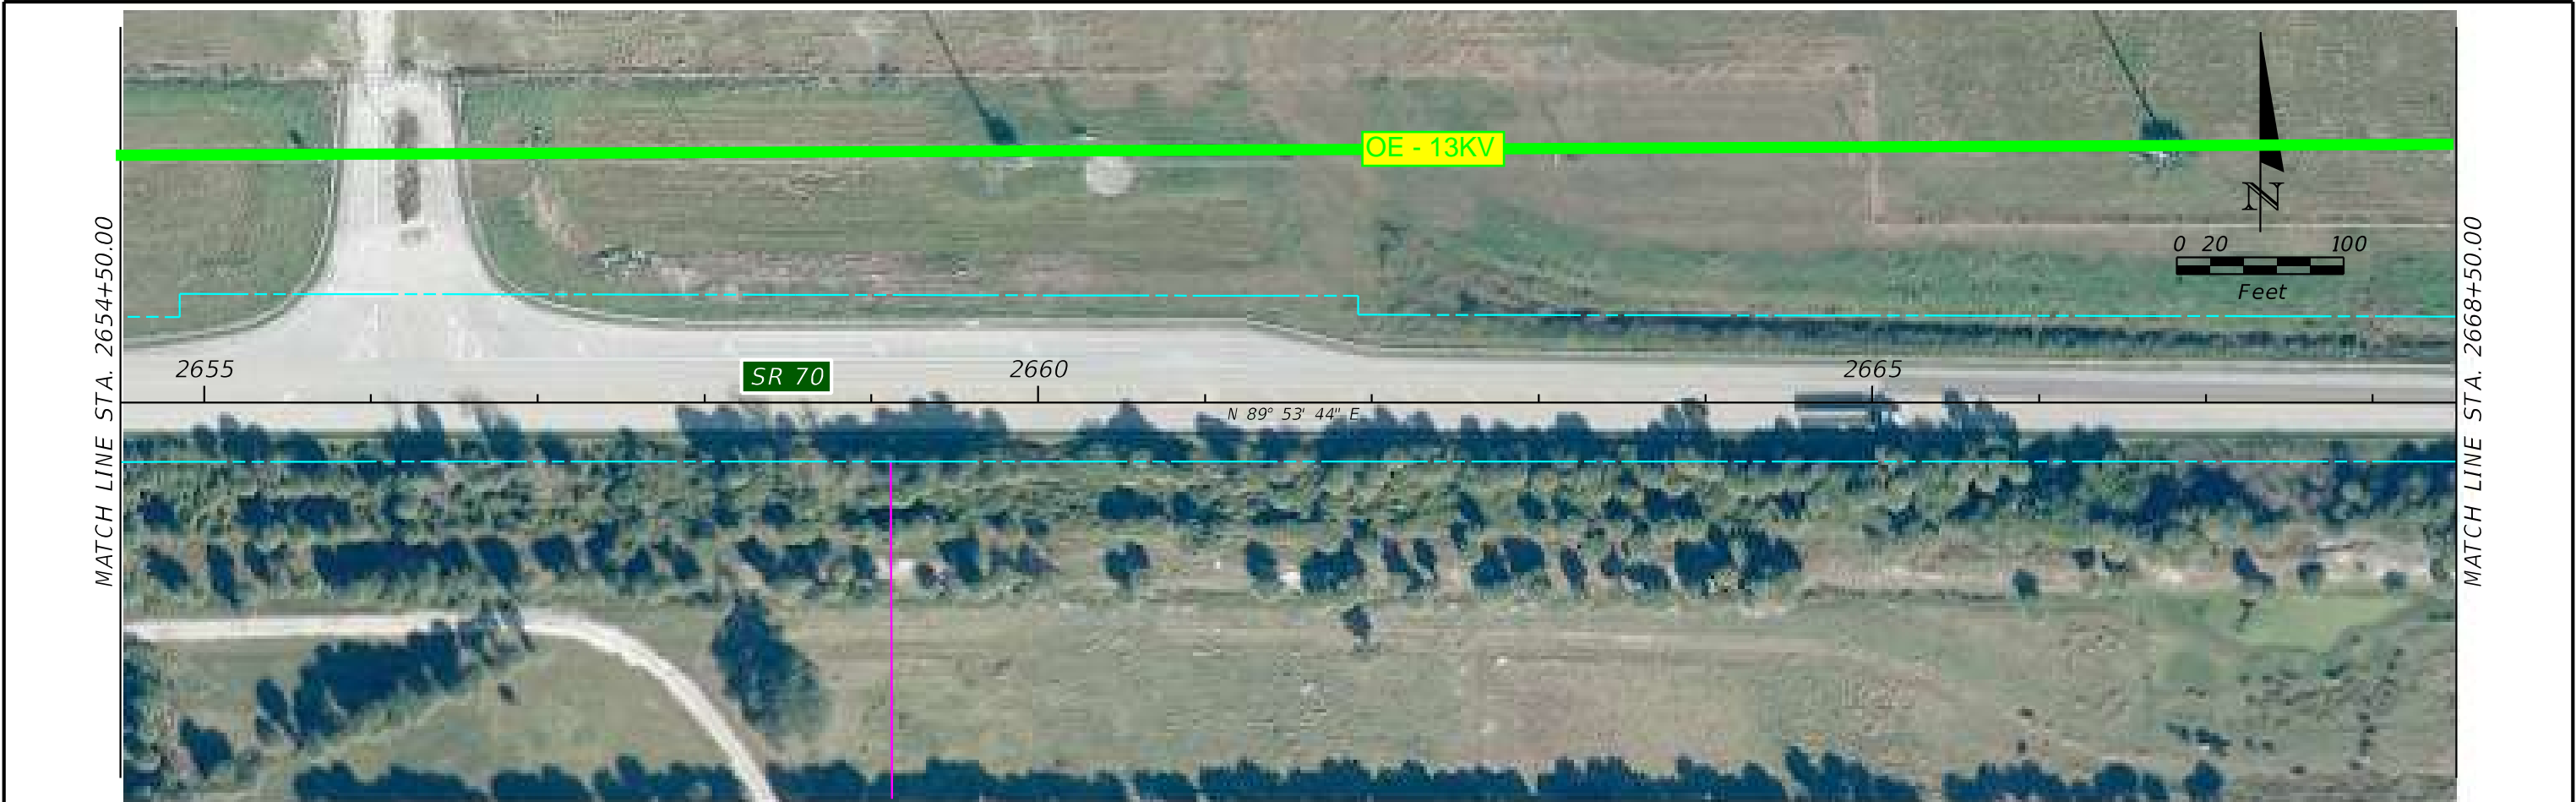

	Q CONSTRUCTION		PARCEL LINE		FPC SITE
	EXIST. R/W LINE		EXIST. EASEMENT		SMF SITE
	PROP. R/W LINE		PROP. TEMP. EASEMENT		PROPOSED ROADWAY
	PROP. PERP. EASEMENT		BRIDGE		MILLING AND RESURF.


Rummel, Klepper & Kahl, LLP
402 S. Kentucky Avenue
Suite 400
Lakeland, FL 33801
FBPR C.A. NO. 26879

JASON L. LYLE, P.E. 69009


STATE OF FLORIDA DEPARTMENT OF TRANSPORTATION		
ROAD NO.	COUNTY	FINANCIAL PROJECT ID
SR 70	HIGHLANDS	450334-1-22-01

SR 70 PD&E STUDY
BASEMAP

SHEET NO.
60

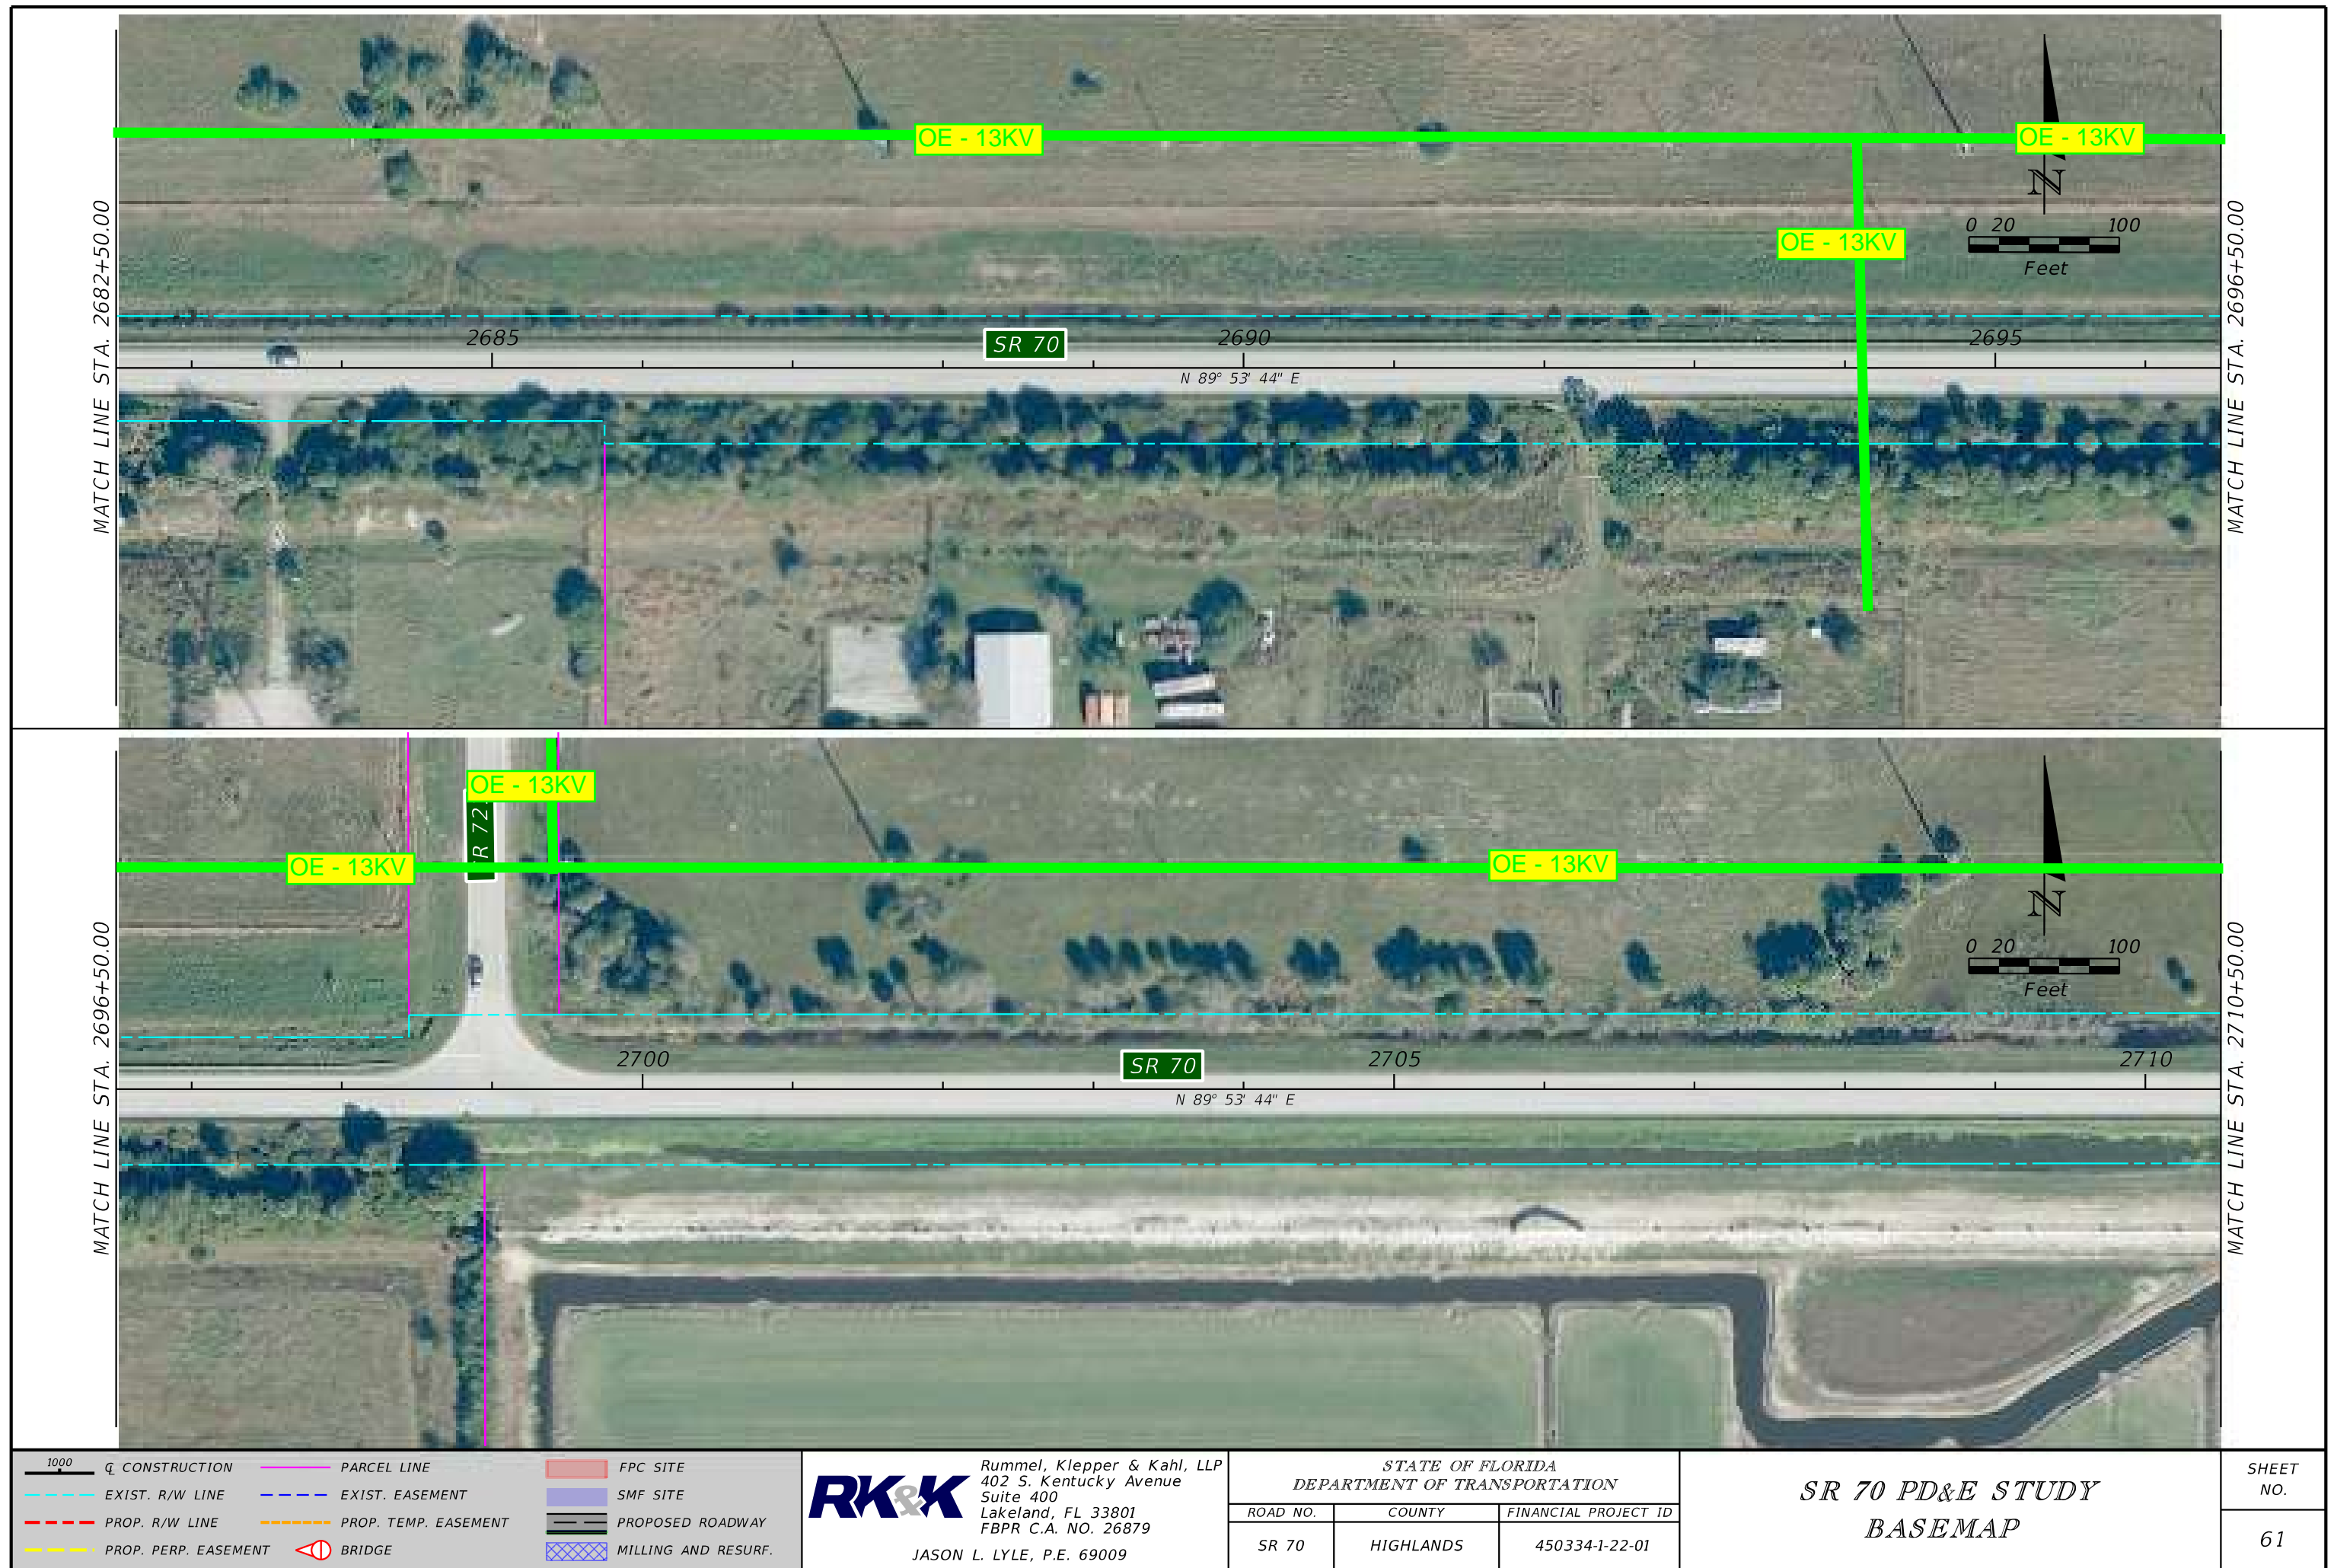


THE OFFICIAL RECORD OF THIS SHEET IS THE ELECTRONIC FILE DIGITALLY SIGNED AND SEALED UNDER RULE 61G15-23.004, F.A.C.

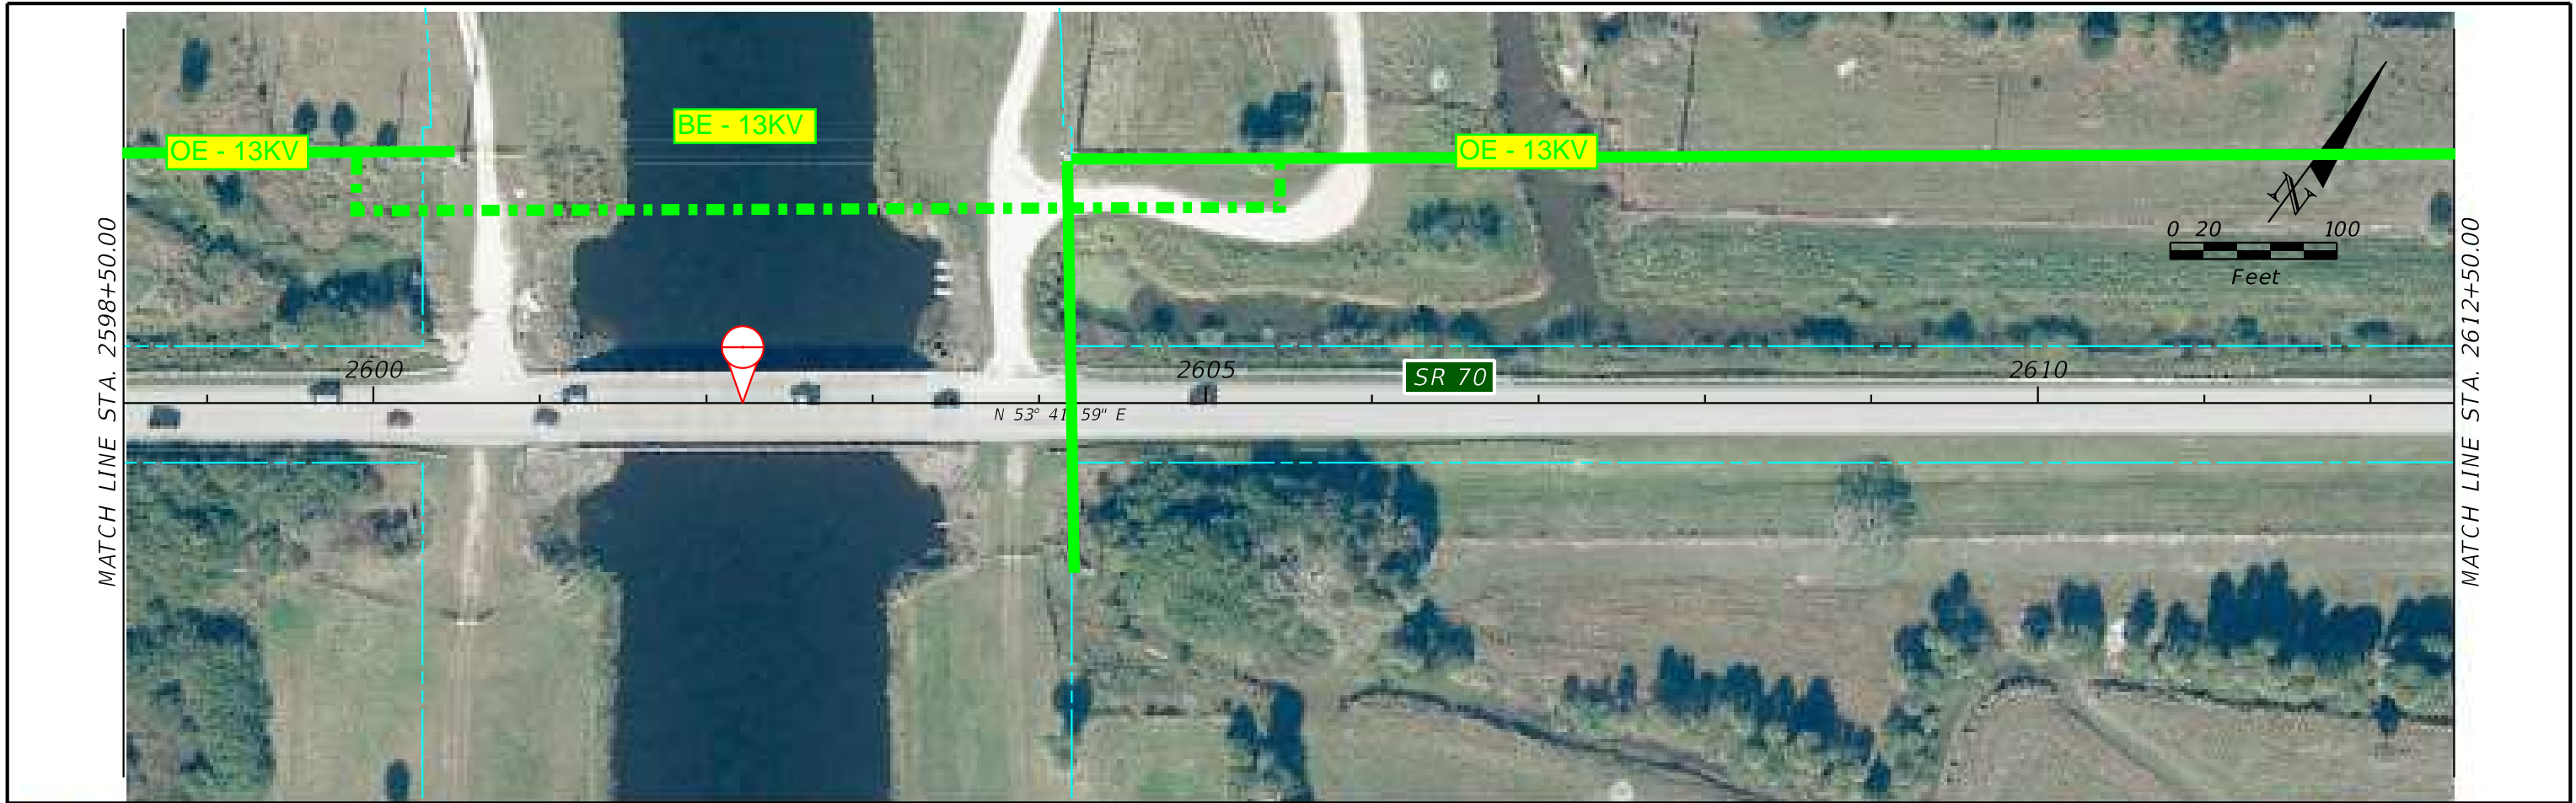

 1000' Q CONSTRUCTION --- EXIST. R/W LINE --- PROP. R/W LINE --- PROP. PERP. EASEMENT --- PARCEL LINE --- EXIST. EASEMENT --- PROP. TEMP. EASEMENT BRIDGE FPC SITE SMF SITE PROPOSED ROADWAY MILLING AND RESURF.		 Rummel, Klepper & Kahl, LLP 402 S. Kentucky Avenue Suite 400 Lakeland, FL 33801 FBPR C.A. NO. 26879 JASON L. LYLE, P.E. 69009	STATE OF FLORIDA DEPARTMENT OF TRANSPORTATION <table border="1"><tr><th>ROAD NO.</th><th>COUNTY</th><th>FINANCIAL PROJECT ID</th></tr><tr><td>SR 70</td><td>HIGHLANDS</td><td>450334-1-22-01</td></tr></table>	ROAD NO.	COUNTY	FINANCIAL PROJECT ID	SR 70	HIGHLANDS	450334-1-22-01	SR 70 PD&E STUDY BASEMAP	SHEET NO. 58
ROAD NO.	COUNTY	FINANCIAL PROJECT ID									
SR 70	HIGHLANDS	450334-1-22-01									

6/29/2023 3:27:38 PM Default \\ad.rkk.com\fs\Cloud\Projects\2020\20020_DICSCemo\Projects\DI 414506-1 SR 70 Jefferson Ave to CR 29\Eng\41450612201\Roadway\UAO\PLANRD58.dgn

THE OFFICIAL RECORD OF THIS SHEET IS THE ELECTRONIC FILE DIGITALLY SIGNED AND SEALED UNDER RULE 61G15-23.004, F.A.C.

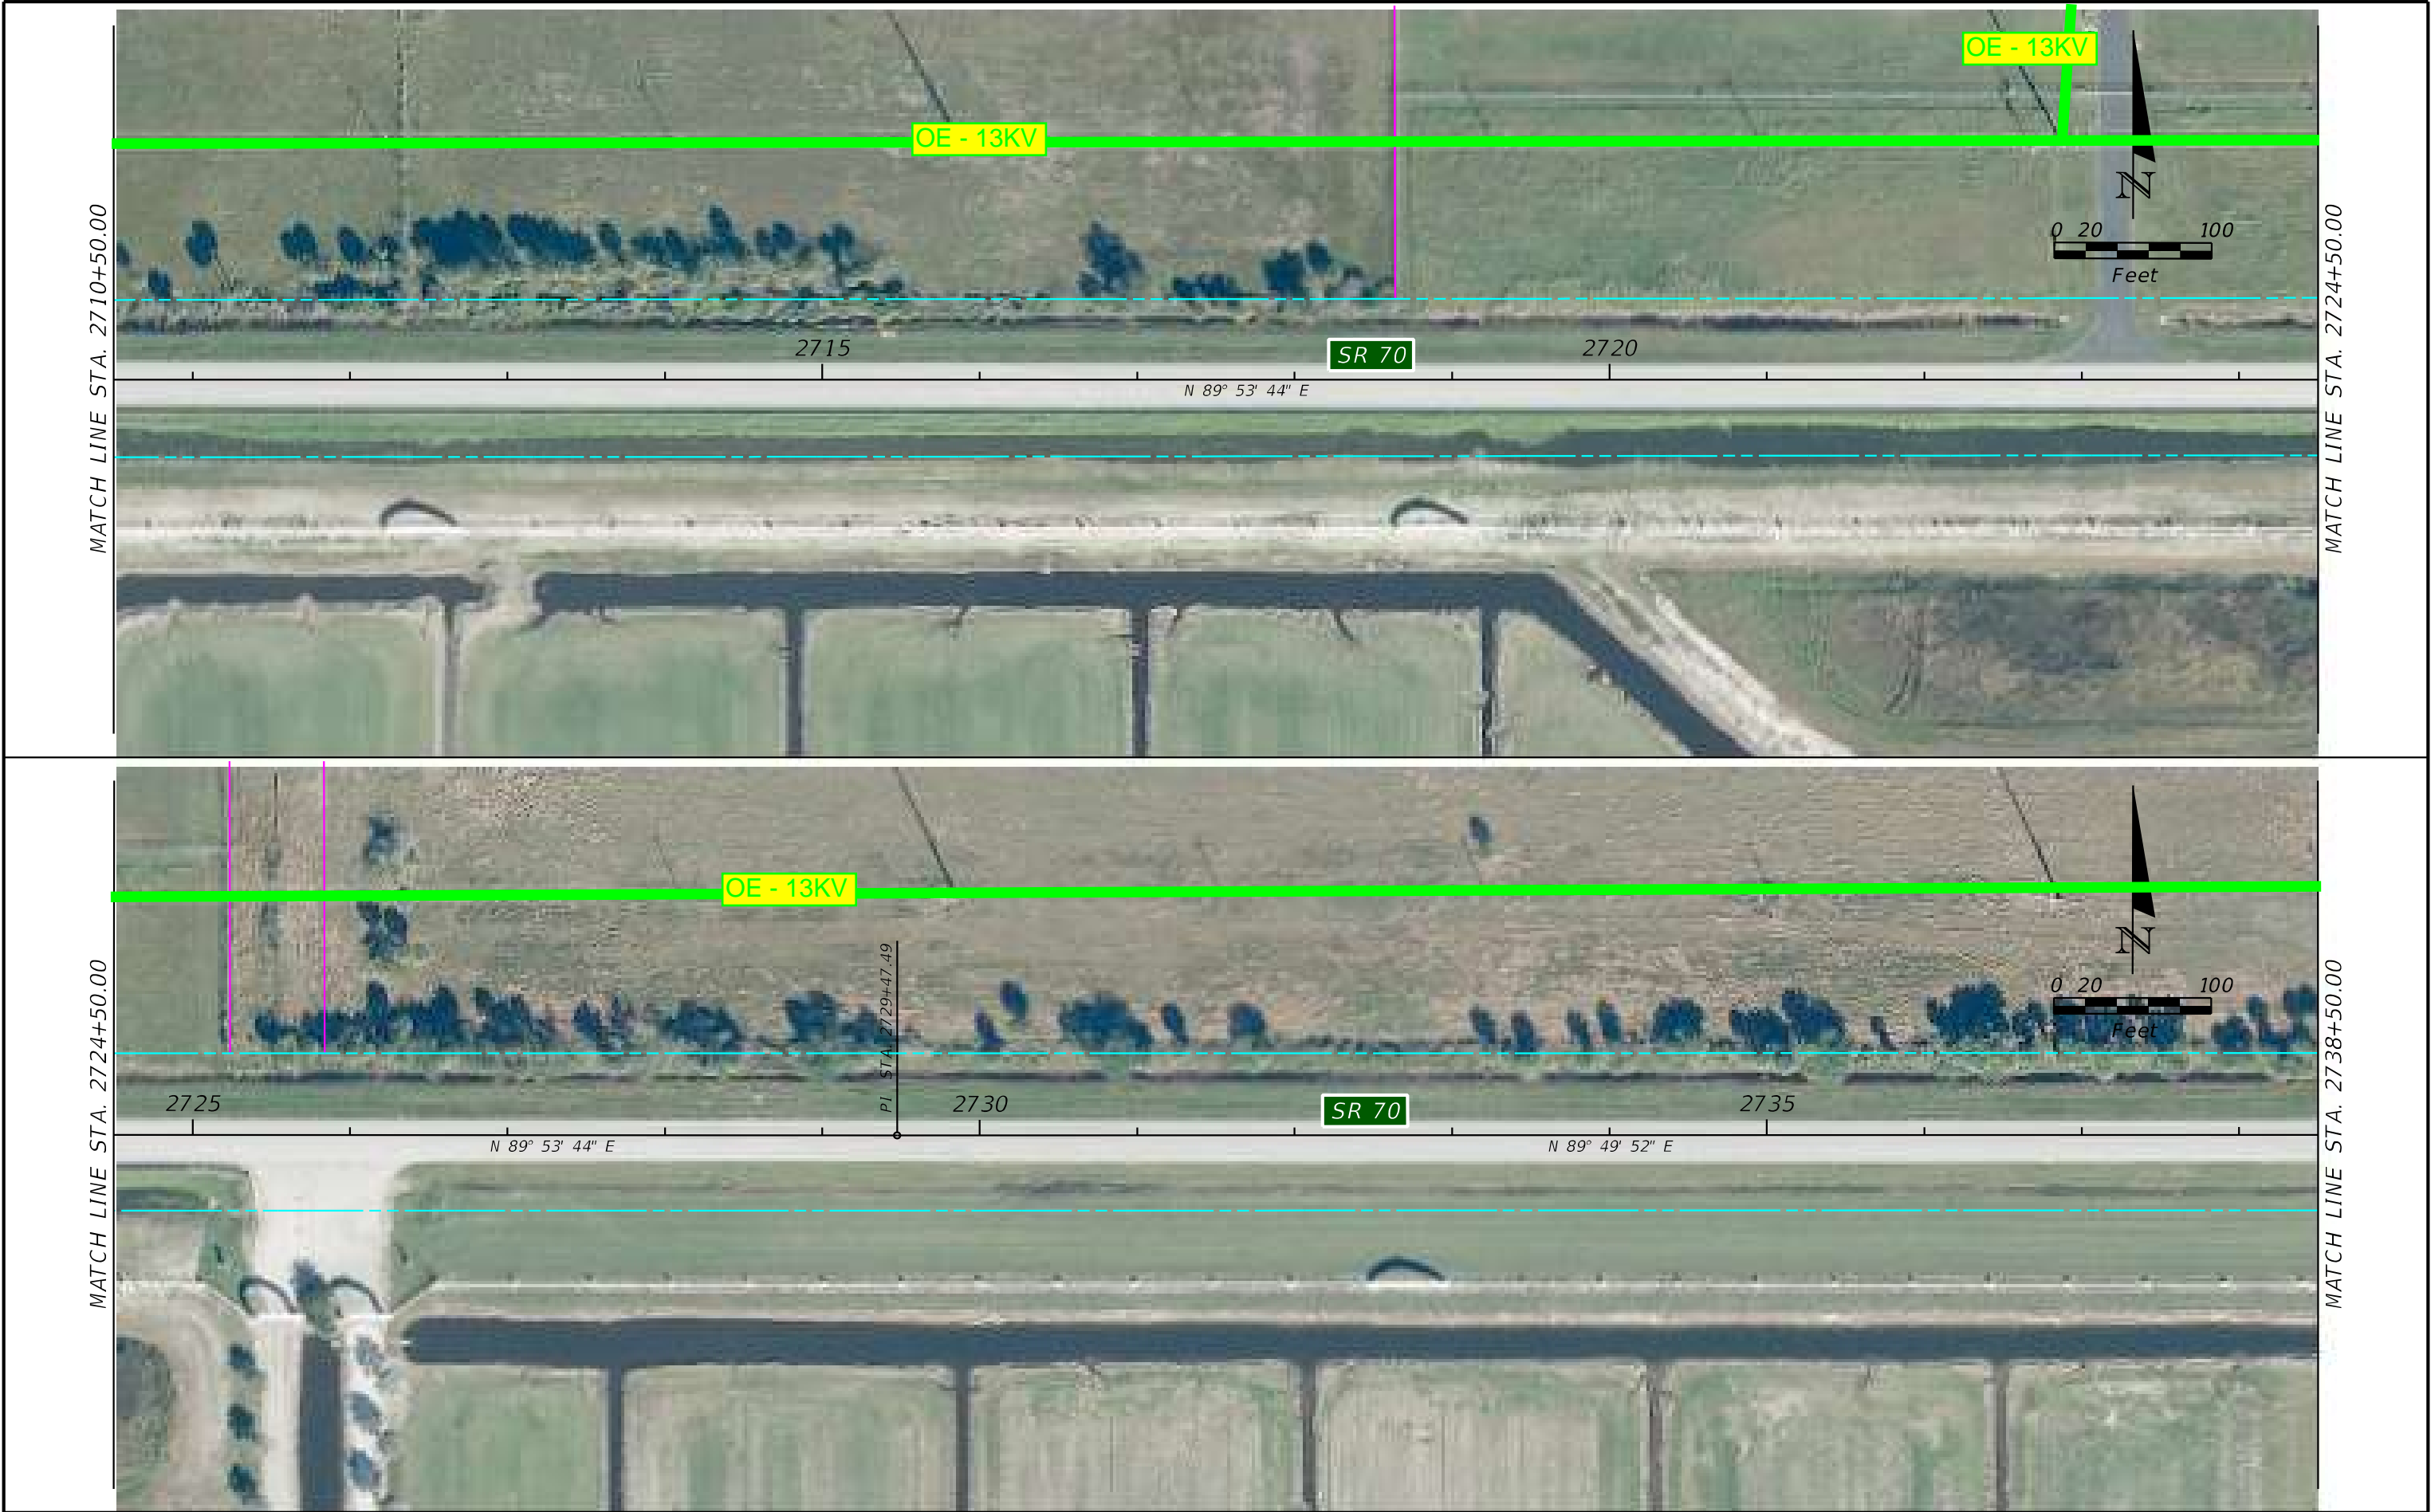

1000

Q CONSTRUCTION

EXIST. R/W LINE

PROP. R/W LINE

PROP. PERP. EASEMENT

PARCEL LINE

EXIST. EASEMENT

PROP. TEMP. EASEMENT

⬮

BRIDGE

■

FPC SITE

■

SMF SITE

PROPOSED ROADWAY

▨

MILLING AND RESURF.

RK&K

Rummel, Klepper & Kahl, LLP
402 S. Kentucky Avenue
Suite 400
Lakeland, FL 33801
FBPR C.A. NO. 26879

JASON L. LYLE, P.E. 69009

6/29/2023 3:27:56 PM Default

STATE OF FLORIDA DEPARTMENT OF TRANSPORTATION		
ROAD NO.	COUNTY	FINANCIAL PROJECT ID
SR 70	HIGHLANDS	450334-1-22-01


SR 70 PD&E STUDY
BASEMAP

SHEET NO.
62

jgalgano

\\ad.rkk.com\fs\Cloud\Projects\2020\20020_DICSCemo\Projects\DI 414506-1 SR 70 Jefferson Ave to CR 29\Eng\41450612201\Roadway\UAO\PLANRD62.dgn

THE OFFICIAL RECORD OF THIS SHEET IS THE ELECTRONIC FILE DIGITALLY SIGNED AND SEALED UNDER RULE 61G15-23.004, F.A.C.

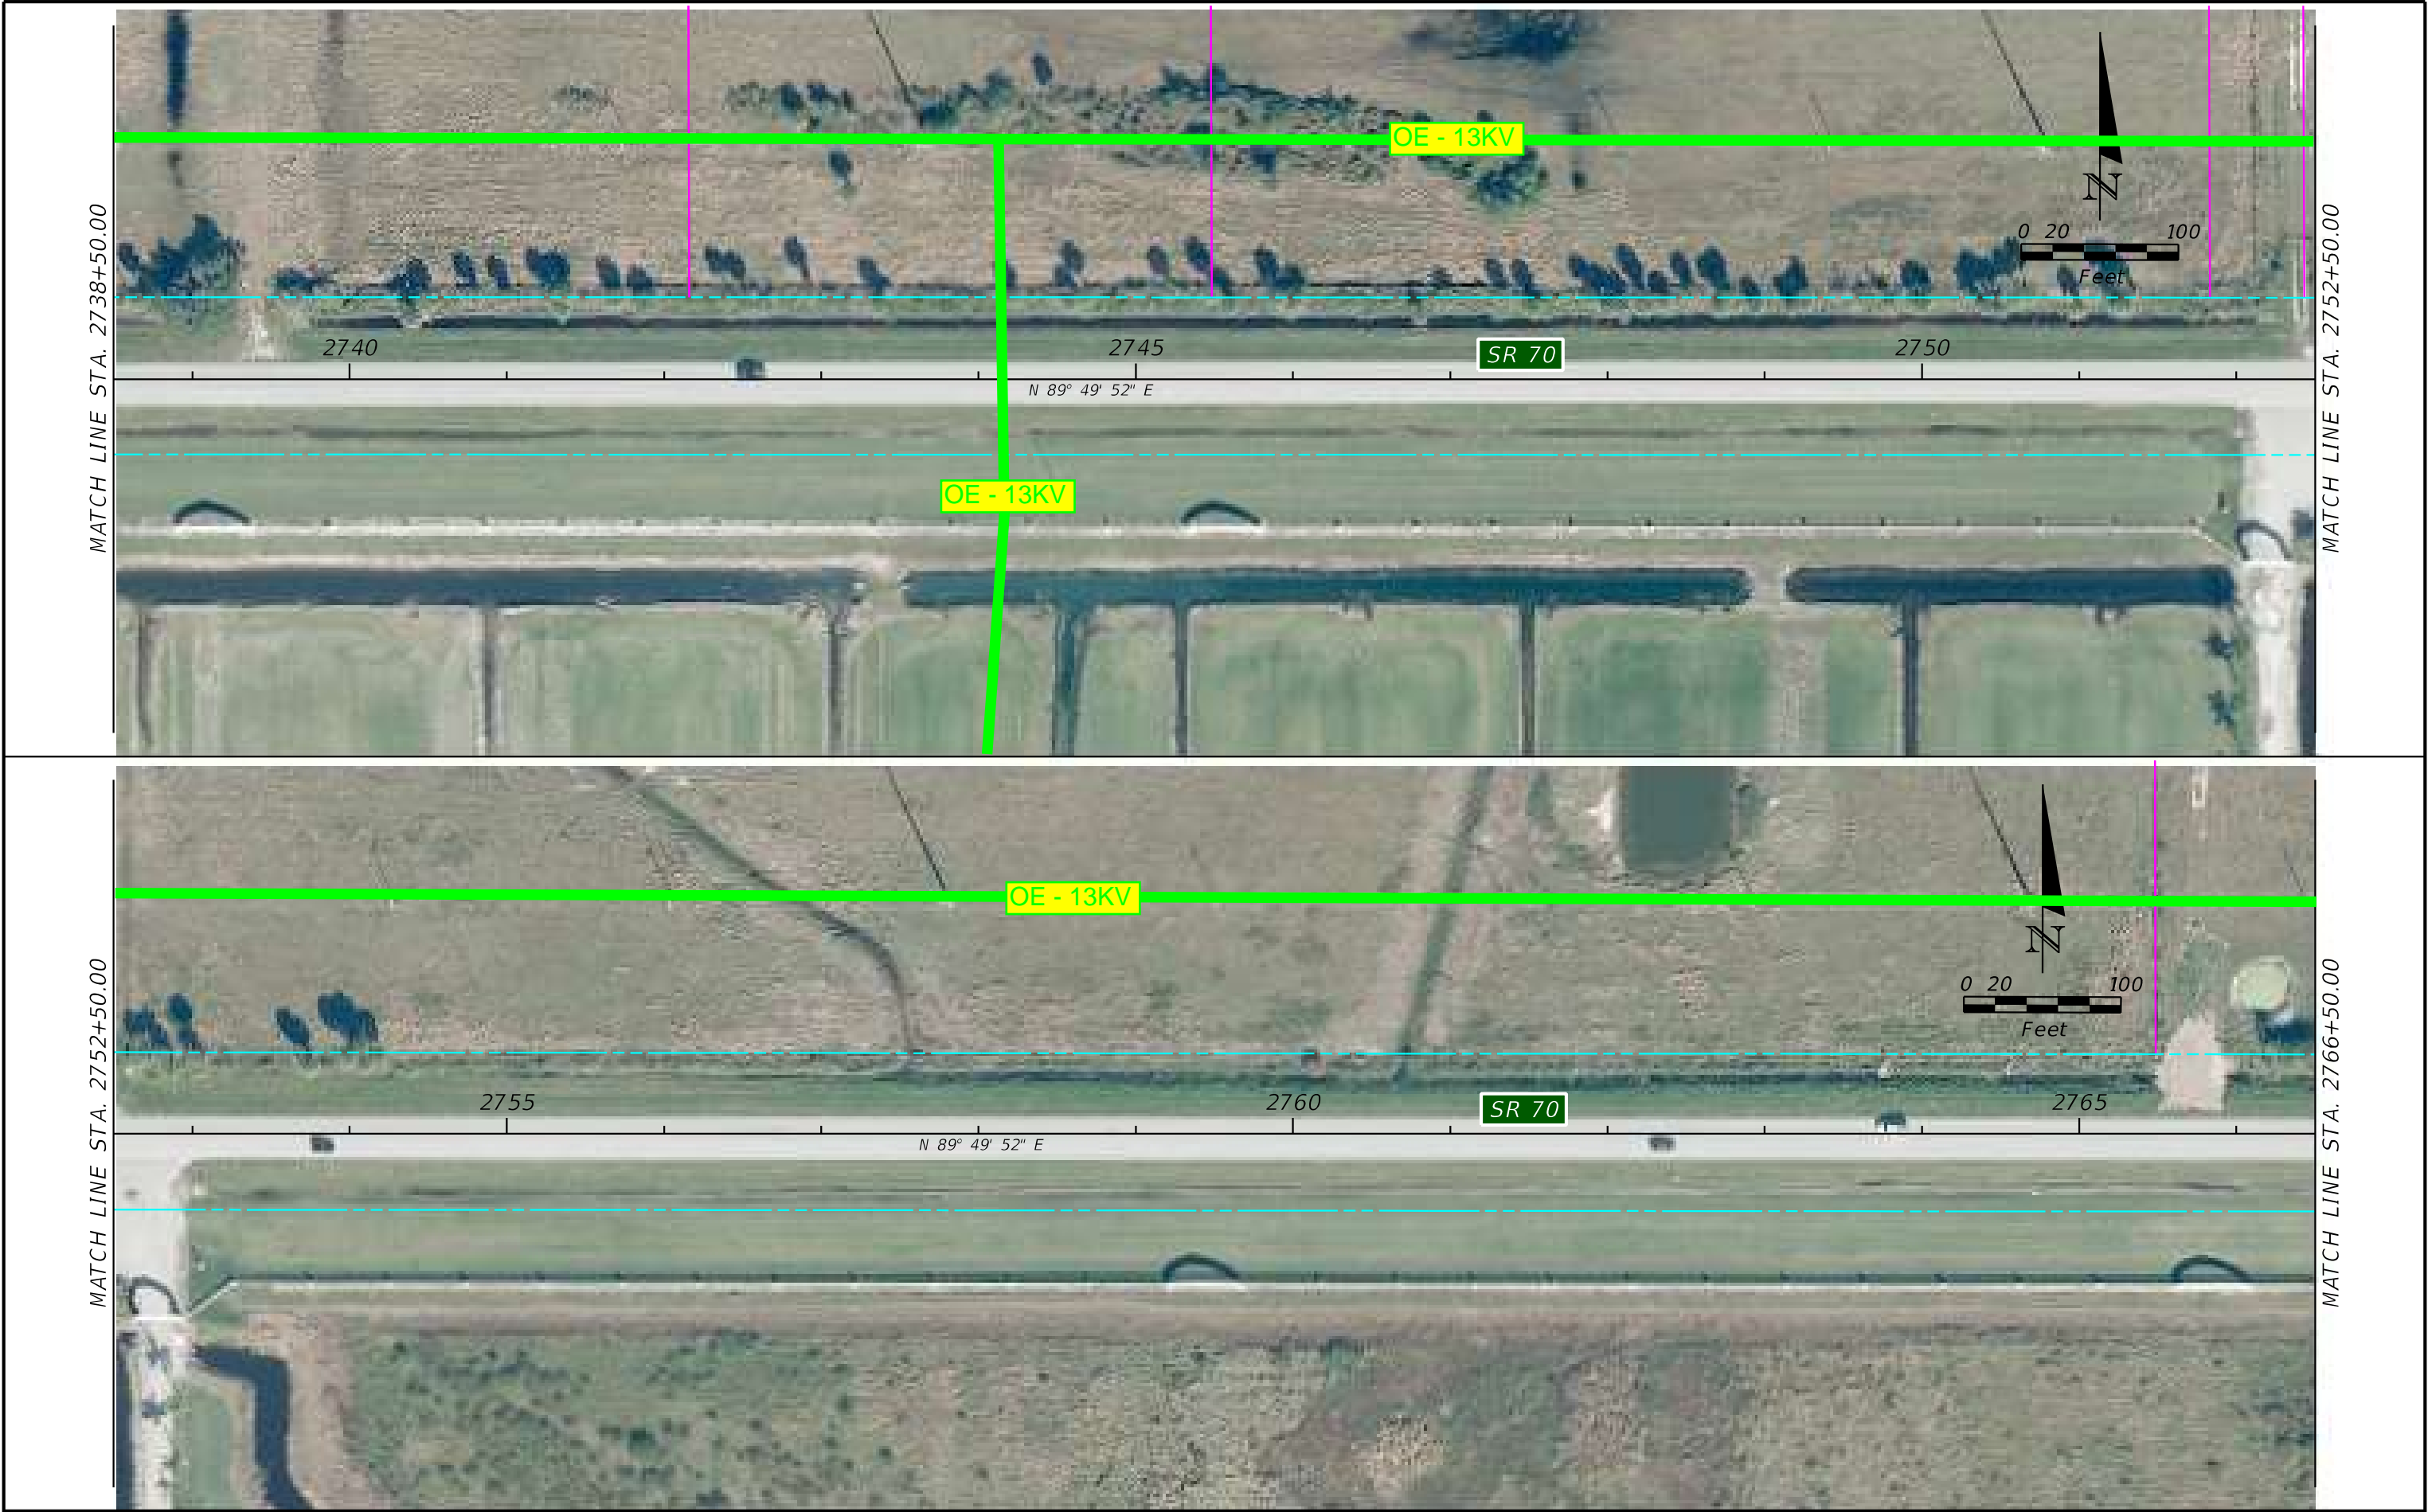

<div><div>1000</div><div>Q CONSTRUCTION</div><div>EXIST. R/W LINE</div><div>PROP. R/W LINE</div><div>PROP. PERP. EASEMENT</div></div> <div><div>PARCEL LINE</div><div>EXIST. EASEMENT</div><div>PROP. TEMP. EASEMENT</div><div>BRIDGE</div></div> <div><div>FPC SITE</div><div>SMF SITE</div><div>PROPOSED ROADWAY</div><div>MILLING AND RESURF.</div></div>	<div><div>RK&K</div><div>Rummel, Klepper & Kahl, LLP 402 S. Kentucky Avenue Suite 400 Lakeland, FL 33801 FBPR C.A. NO. 26879</div><div>JASON L. LYLE, P.E. 69009</div></div> <div><div>STATE OF FLORIDA</div><div>DEPARTMENT OF TRANSPORTATION</div><table><tr><th>ROAD NO.</th><th>COUNTY</th><th>FINANCIAL PROJECT ID</th></tr><tr><td>SR 70</td><td>HIGHLANDS</td><td>450334-1-22-01</td></tr></table></div> <div><div>SR 70 PD&E STUDY</div><div>BASEMAP</div></div>	ROAD NO.	COUNTY	FINANCIAL PROJECT ID	SR 70	HIGHLANDS	450334-1-22-01	<div>SHEET NO.</div> <div>63</div>
ROAD NO.	COUNTY	FINANCIAL PROJECT ID						
SR 70	HIGHLANDS	450334-1-22-01						



1000

Q CONSTRUCTION

EXIST. R/W LINE

PROP. R/W LINE

PROP. PERP. EASEMENT

PARCEL LINE

EXIST. EASEMENT

PROP. TEMP. EASEMENT

BRIDGE

FPC SITE

SMF SITE

PROPOSED ROADWAY

MILLING AND RESURF.

Rummel, Klepper & Kahl, LLP
402 S. Kentucky Avenue
Suite 400
Lakeland, FL 33801
FBPR C.A. NO. 26879

JASON L. LYLE, P.E. 69009

STATE OF FLORIDA
DEPARTMENT OF TRANSPORTATION

ROAD NO.	COUNTY	FINANCIAL PROJECT ID
SR 70	HIGHLANDS	450334-1-22-01

SR 70 PD&E STUDY
BASEMAP


SHEET
NO.

64

6/29/2023 3:28:05 PM Default

\\ad.rkk.com\fs\Cloud\Projects\2020\20020_DICSEMO\Projects\DI 414506-1 SR 70 Jefferson Ave to CR 29\Eng\41450612201\Roadway\UAO\PLANRD64.dgn

THE OFFICIAL RECORD OF THIS SHEET IS THE ELECTRONIC FILE DIGITALLY SIGNED AND SEALED UNDER RULE 61G15-23.004, F.A.C.

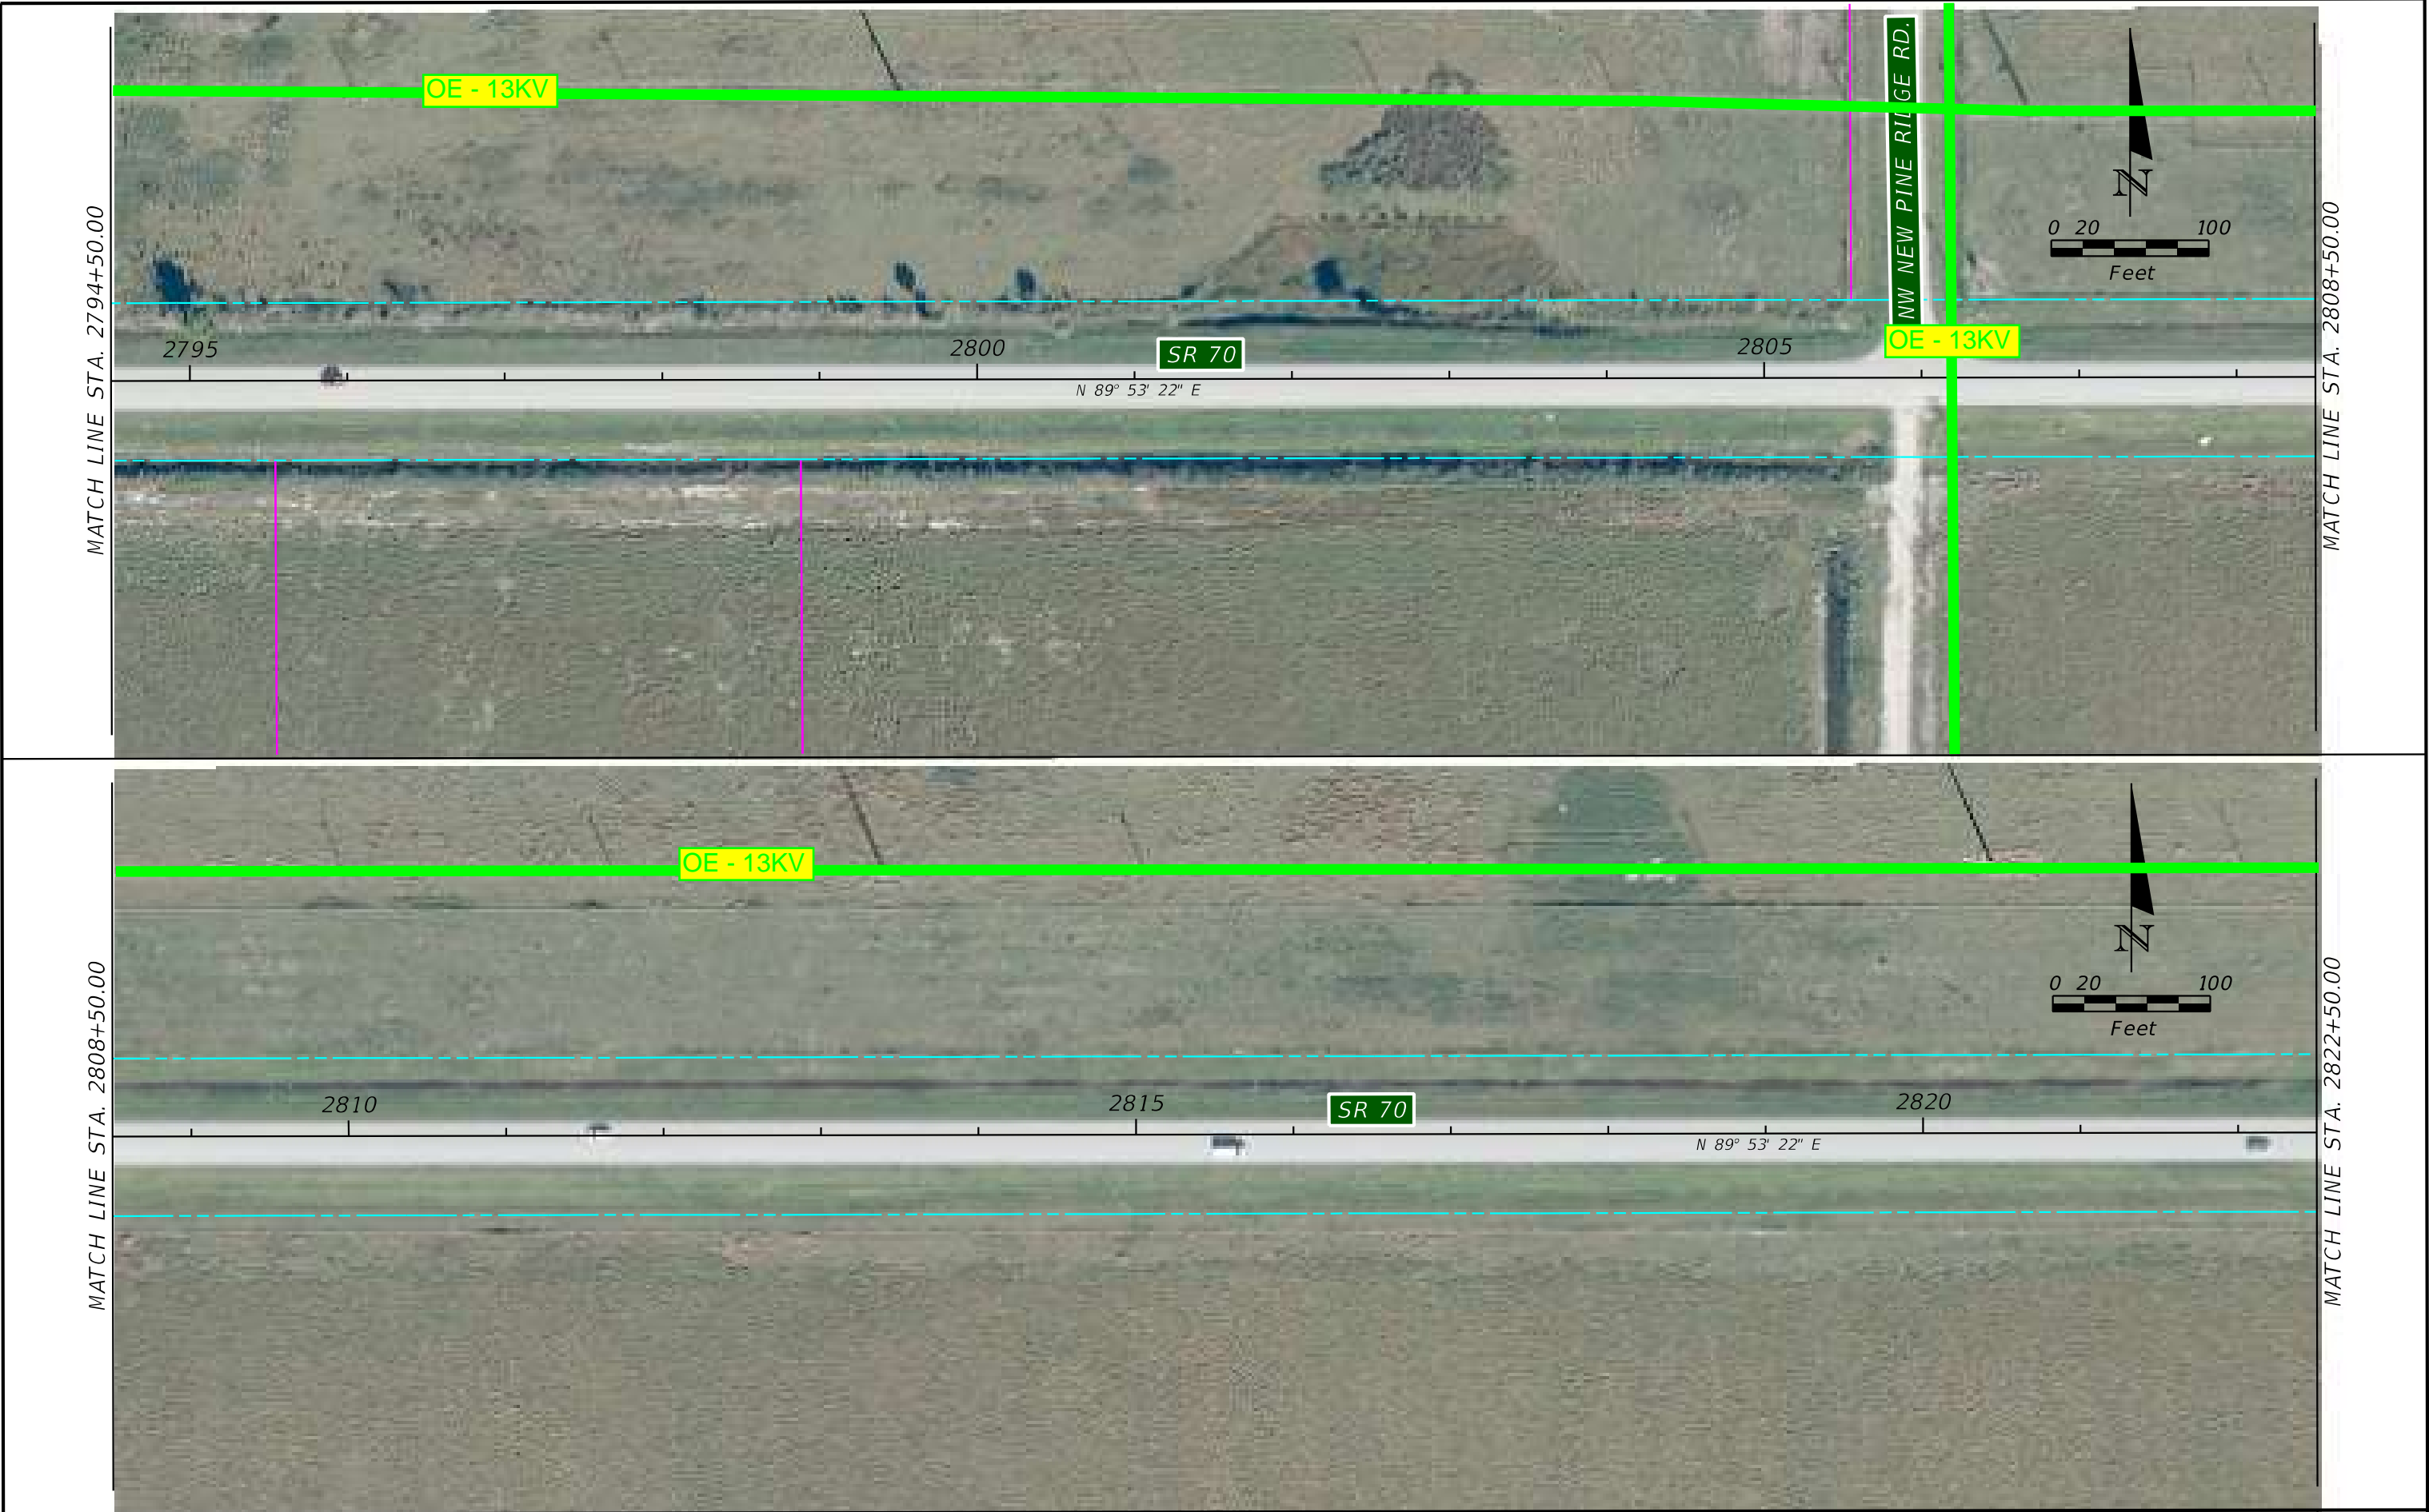

1000

Q CONSTRUCTION

EXIST. R/W LINE

PROP. R/W LINE

PROP. PERP. EASEMENT

PARCEL LINE

EXIST. EASEMENT

PROP. TEMP. EASEMENT

⬮

BRIDGE

■

FPC SITE

■

SMF SITE

PROPOSED ROADWAY

▨

MILLING AND RESURF.

RK&K

Rummel, Klepper & Kahl, LLP
402 S. Kentucky Avenue
Suite 400
Lakeland, FL 33801
FBPR C.A. NO. 26879

JASON L. LYLE, P.E. 69009

STATE OF FLORIDA
DEPARTMENT OF TRANSPORTATION

ROAD NO.	COUNTY	FINANCIAL PROJECT ID
SR 70	HIGHLANDS	450334-1-22-01

SR 70 PD&E STUDY
BASEMAP

SHEET NO.

65

6/29/2023 3:28:09 PM Default

\\ad.rkk.com\fs\Cloud\Projects\2020\20020_DICSCEMO\Projects\DI 414506-1 SR 70 Jefferson Ave to CR 29\Eng\41450612201\Roadway\UAO\PLANRD65.dgn



	Q CONSTRUCTION		PARCEL LINE		FPC SITE
	EXIST. R/W LINE		EXIST. EASEMENT		SMF SITE
	PROP. R/W LINE		PROP. TEMP. EASEMENT		PROPOSED ROADWAY
	PROP. PERP. EASEMENT		BRIDGE		MILLING AND RESURF.

Rummel, Klepper & Kahl, LLP
402 S. Kentucky Avenue
Suite 400
Lakeland, FL 33801
FBPR C.A. NO. 26879

JASON L. LYLE, P.E. 69009


6/29/2023 3:28:14 PM Default

STATE OF FLORIDA DEPARTMENT OF TRANSPORTATION		
ROAD NO.	COUNTY	FINANCIAL PROJECT ID
SR 70	HIGHLANDS	450334-1-22-01

SR 70 PD&E STUDY
BASEMAP

SHEET NO.
66

THE OFFICIAL RECORD OF THIS SHEET IS THE ELECTRONIC FILE DIGITALLY SIGNED AND SEALED UNDER RULE 61G15-23.004, F.A.C.

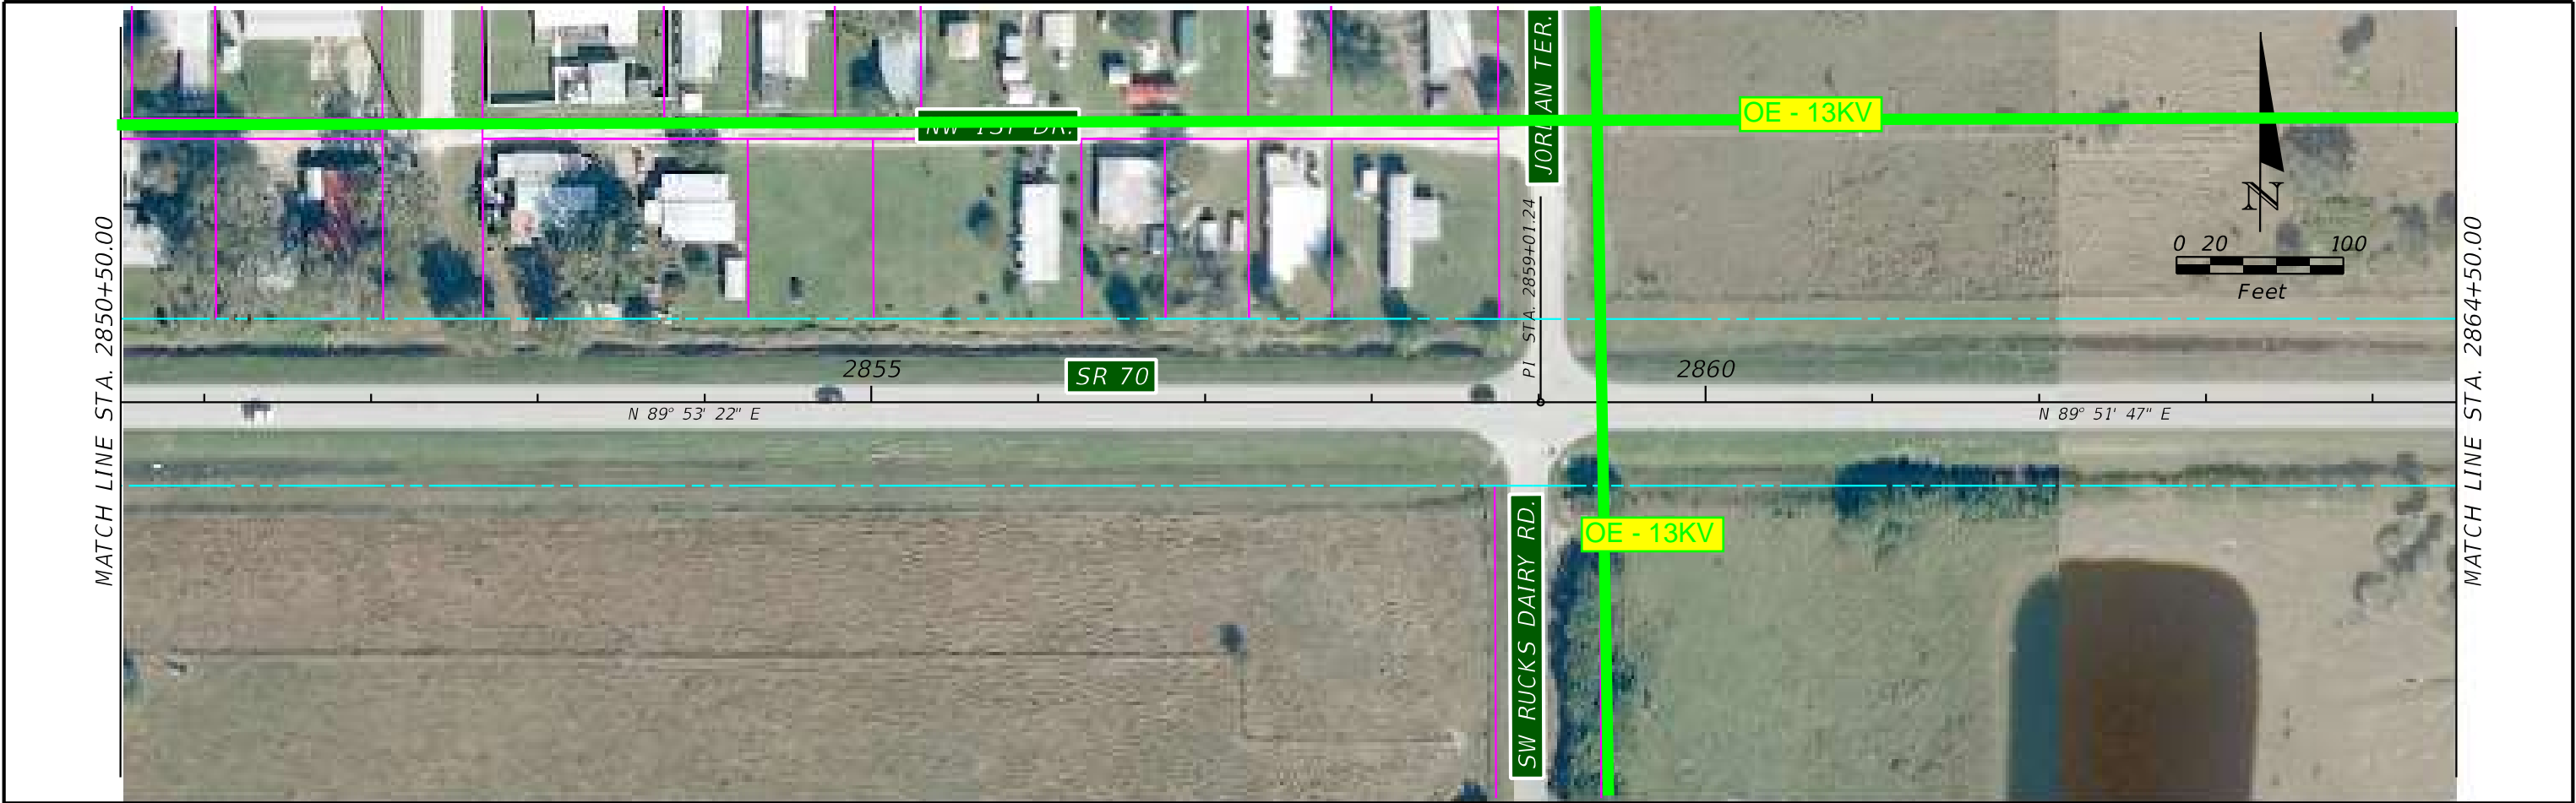

	Q CONSTRUCTION		PARCEL LINE		FPC SITE
	EXIST. R/W LINE		EXIST. EASEMENT		SMF SITE
	PROP. R/W LINE		PROP. TEMP. EASEMENT		PROPOSED ROADWAY
	PROP. PERP. EASEMENT		BRIDGE		MILLING AND RESURF.

Rummel, Klepper & Kahl, LLP
402 S. Kentucky Avenue
Suite 400
Lakeland, FL 33801
FBPR C.A. NO. 26879

JASON L. LYLE, P.E. 69009


6/29/2023 3:28:19 PM Default

STATE OF FLORIDA DEPARTMENT OF TRANSPORTATION		
ROAD NO.	COUNTY	FINANCIAL PROJECT ID
SR 70	HIGHLANDS	450334-1-22-01


SR 70 PD&E STUDY
BASEMAP

SHEET NO.
67

THE OFFICIAL RECORD OF THIS SHEET IS THE ELECTRONIC FILE DIGITALLY SIGNED AND SEALED UNDER RULE 61G15-23.004, F.A.C.

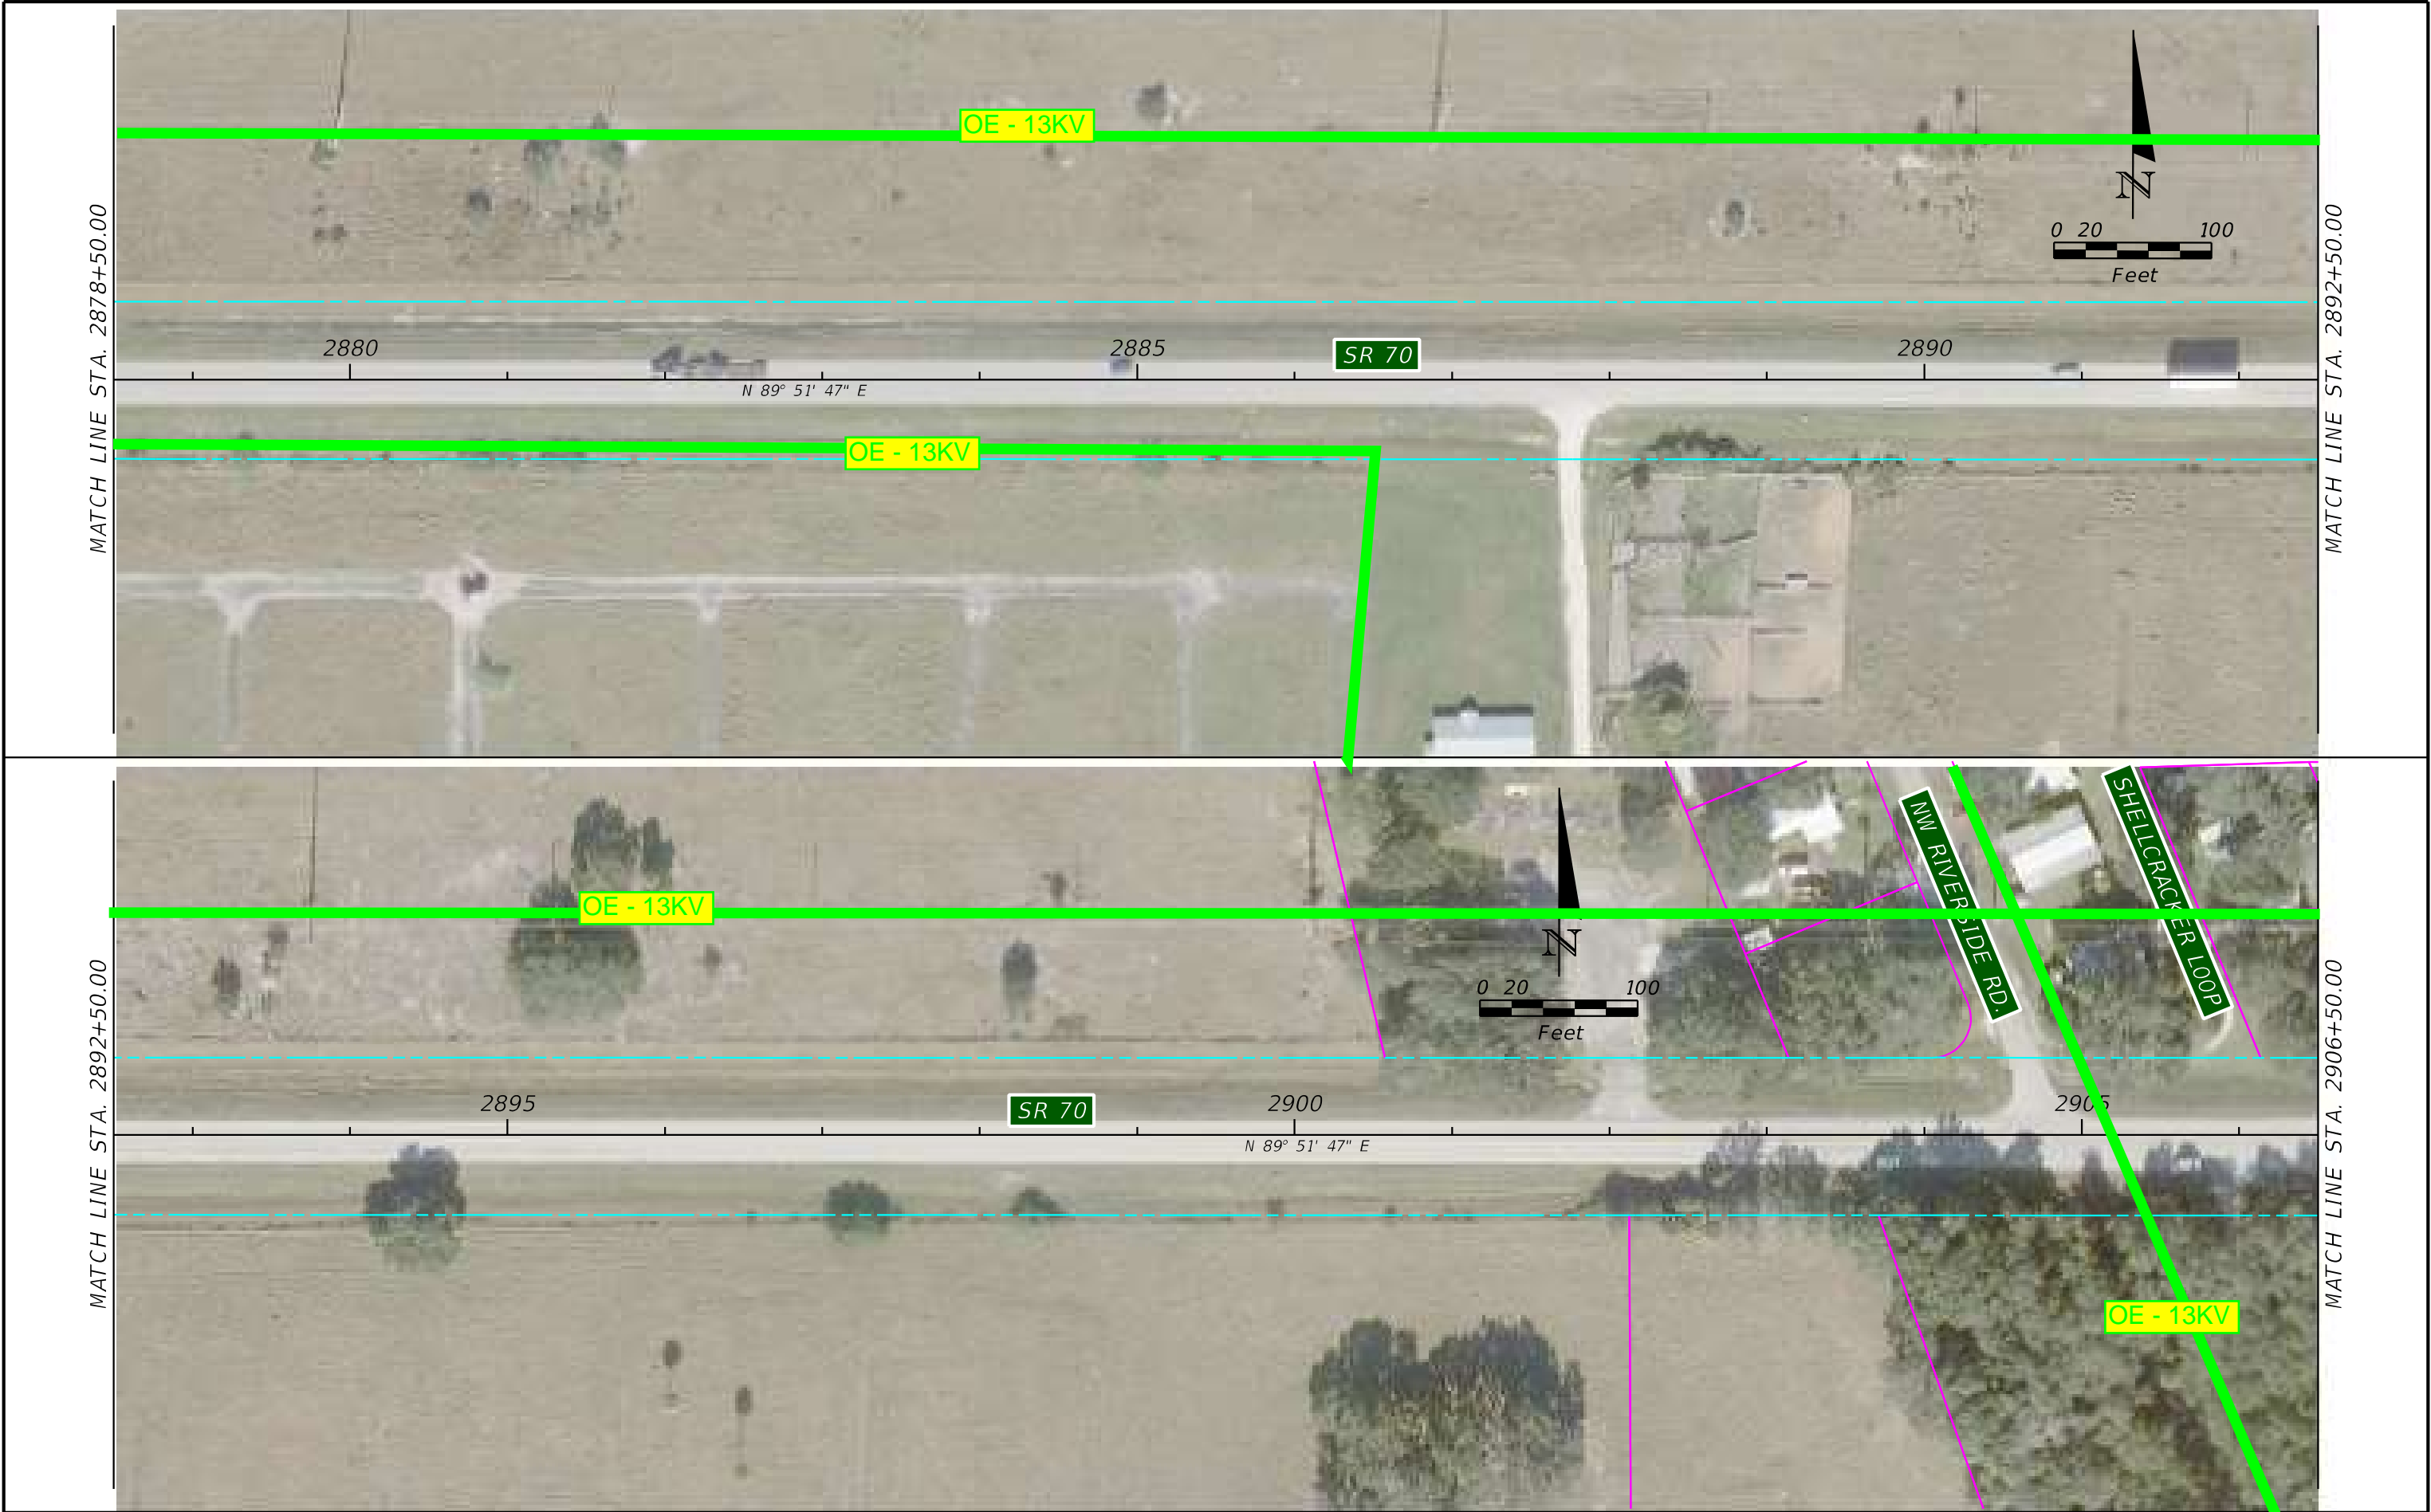


<p>1000 Q CONSTRUCTION --- EXIST. R/W LINE --- PROP. R/W LINE --- PROP. PERP. EASEMENT</p>		<p>--- PARCEL LINE --- EXIST. EASEMENT --- PROP. TEMP. EASEMENT BRIDGE</p>		<p>FPC SITE SMF SITE PROPOSED ROADWAY MILLING AND RESURF.</p>		<p>Rummel, Klepper & Kahl, LLP 402 S. Kentucky Avenue Suite 400 Lakeland, FL 33801 FBPR C.A. NO. 26879 JASON L. LYLE, P.E. 69009</p>		<table border="1"><tr><th colspan="3">STATE OF FLORIDA DEPARTMENT OF TRANSPORTATION</th></tr><tr><th>ROAD NO.</th><th>COUNTY</th><th>FINANCIAL PROJECT ID</th></tr><tr><td>SR 70</td><td>HIGHLANDS</td><td>450334-1-22-01</td></tr></table>		STATE OF FLORIDA DEPARTMENT OF TRANSPORTATION			ROAD NO.	COUNTY	FINANCIAL PROJECT ID	SR 70	HIGHLANDS	450334-1-22-01	<p>SR 70 PD&E STUDY BASEMAP</p>		<table border="1"><tr><td>SHEET NO.</td></tr><tr><td>68</td></tr></table>		SHEET NO.	68
STATE OF FLORIDA DEPARTMENT OF TRANSPORTATION																								
ROAD NO.	COUNTY	FINANCIAL PROJECT ID																						
SR 70	HIGHLANDS	450334-1-22-01																						
SHEET NO.																								
68																								

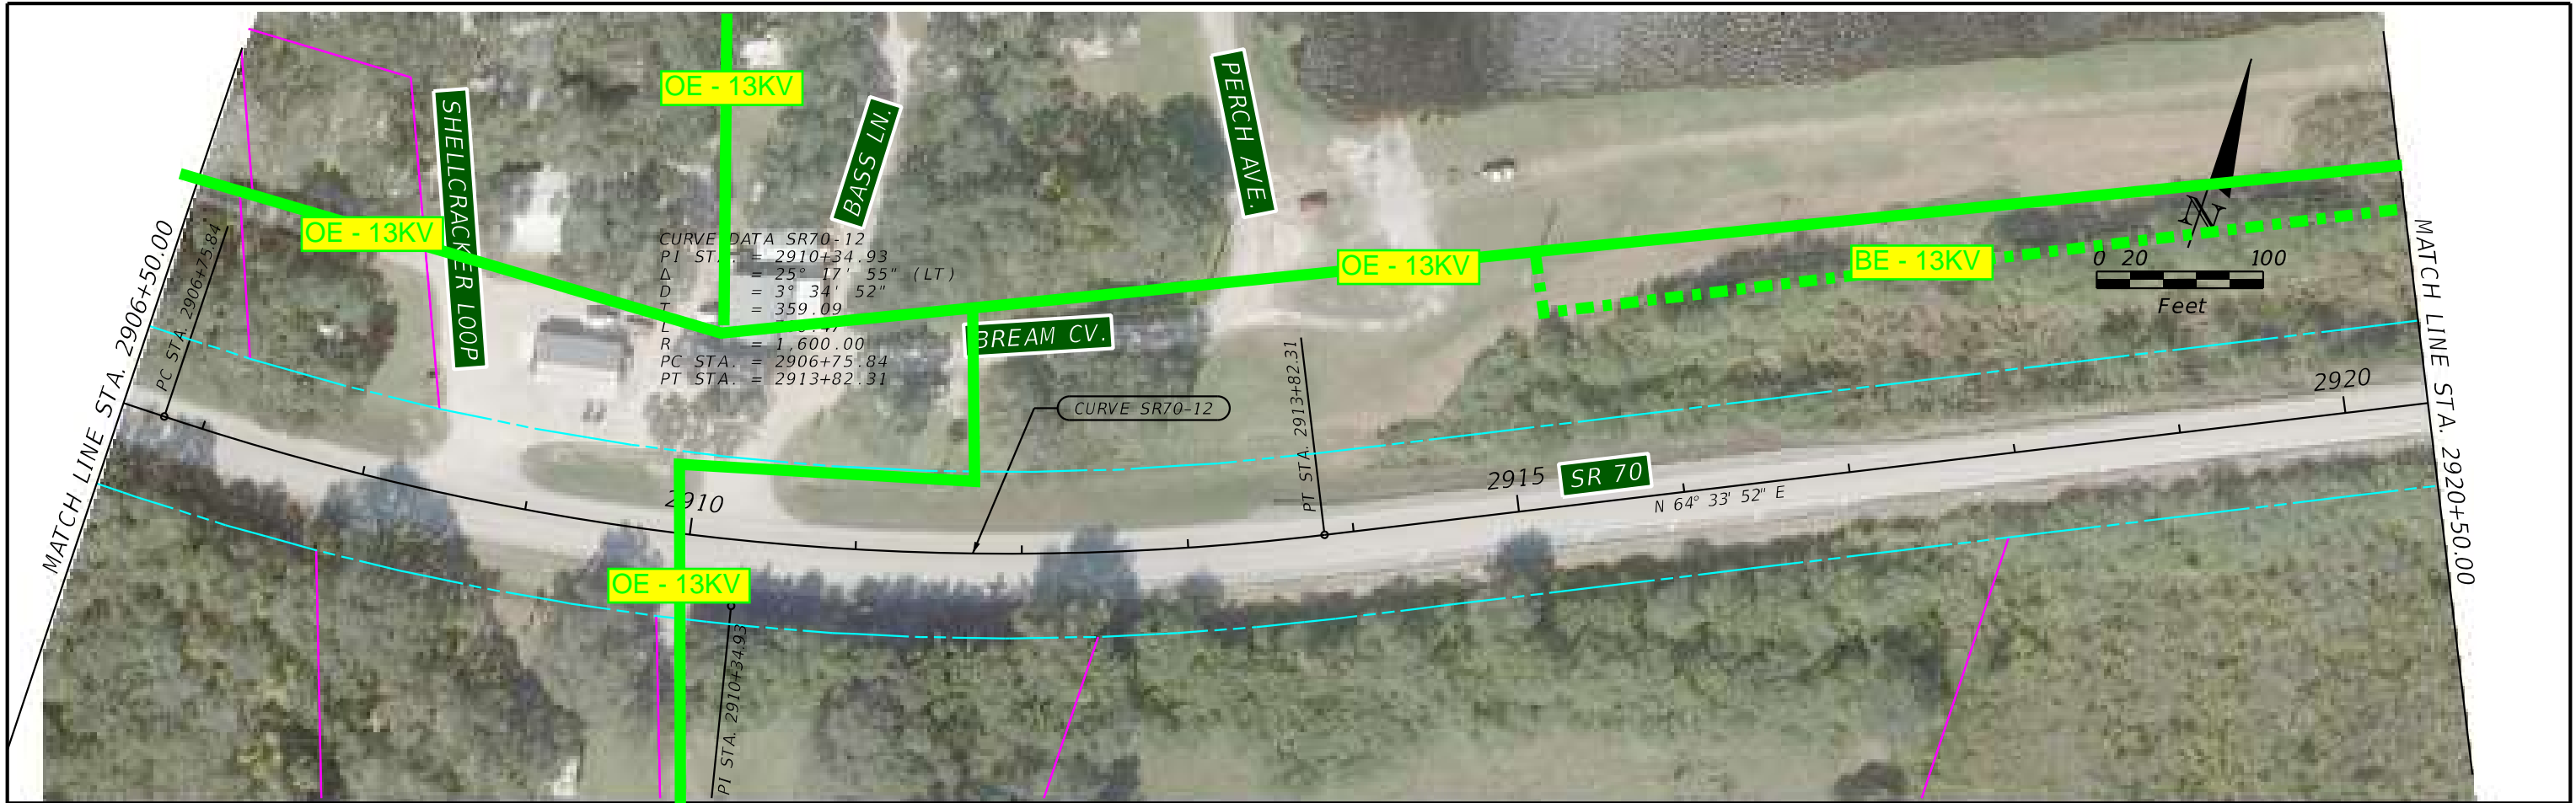

<p>1000 Q CONSTRUCTION EXIST. R/W LINE PROP. R/W LINE PROP. PERP. EASEMENT PARCEL LINE EXIST. EASEMENT PROP. TEMP. EASEMENT BRIDGE FPC SITE SMF SITE PROPOSED ROADWAY MILLING AND RESURF.</p>		<p>Rummel, Klepper & Kahl, LLP 402 S. Kentucky Avenue Suite 400 Lakeland, FL 33801 FBPR C.A. NO. 26879 JASON L. LYLE, P.E. 69009</p>	<table border="1"><tr><th colspan="3">STATE OF FLORIDA DEPARTMENT OF TRANSPORTATION</th></tr><tr><th>ROAD NO.</th><th>COUNTY</th><th>FINANCIAL PROJECT ID</th></tr><tr><td>SR 70</td><td>HIGHLANDS OKEECHOBEE</td><td>450334-1-22-01</td></tr></table>	STATE OF FLORIDA DEPARTMENT OF TRANSPORTATION			ROAD NO.	COUNTY	FINANCIAL PROJECT ID	SR 70	HIGHLANDS OKEECHOBEE	450334-1-22-01	<p>SR 70 PD&E STUDY BASEMAP</p>	<table border="1"><tr><td>SHEET NO.</td></tr><tr><td>69</td></tr></table>	SHEET NO.	69
STATE OF FLORIDA DEPARTMENT OF TRANSPORTATION																
ROAD NO.	COUNTY	FINANCIAL PROJECT ID														
SR 70	HIGHLANDS OKEECHOBEE	450334-1-22-01														
SHEET NO.																
69																

THE OFFICIAL RECORD OF THIS SHEET IS THE ELECTRONIC FILE DIGITALLY SIGNED AND SEALED UNDER RULE 61G15-23.004, F.A.C.

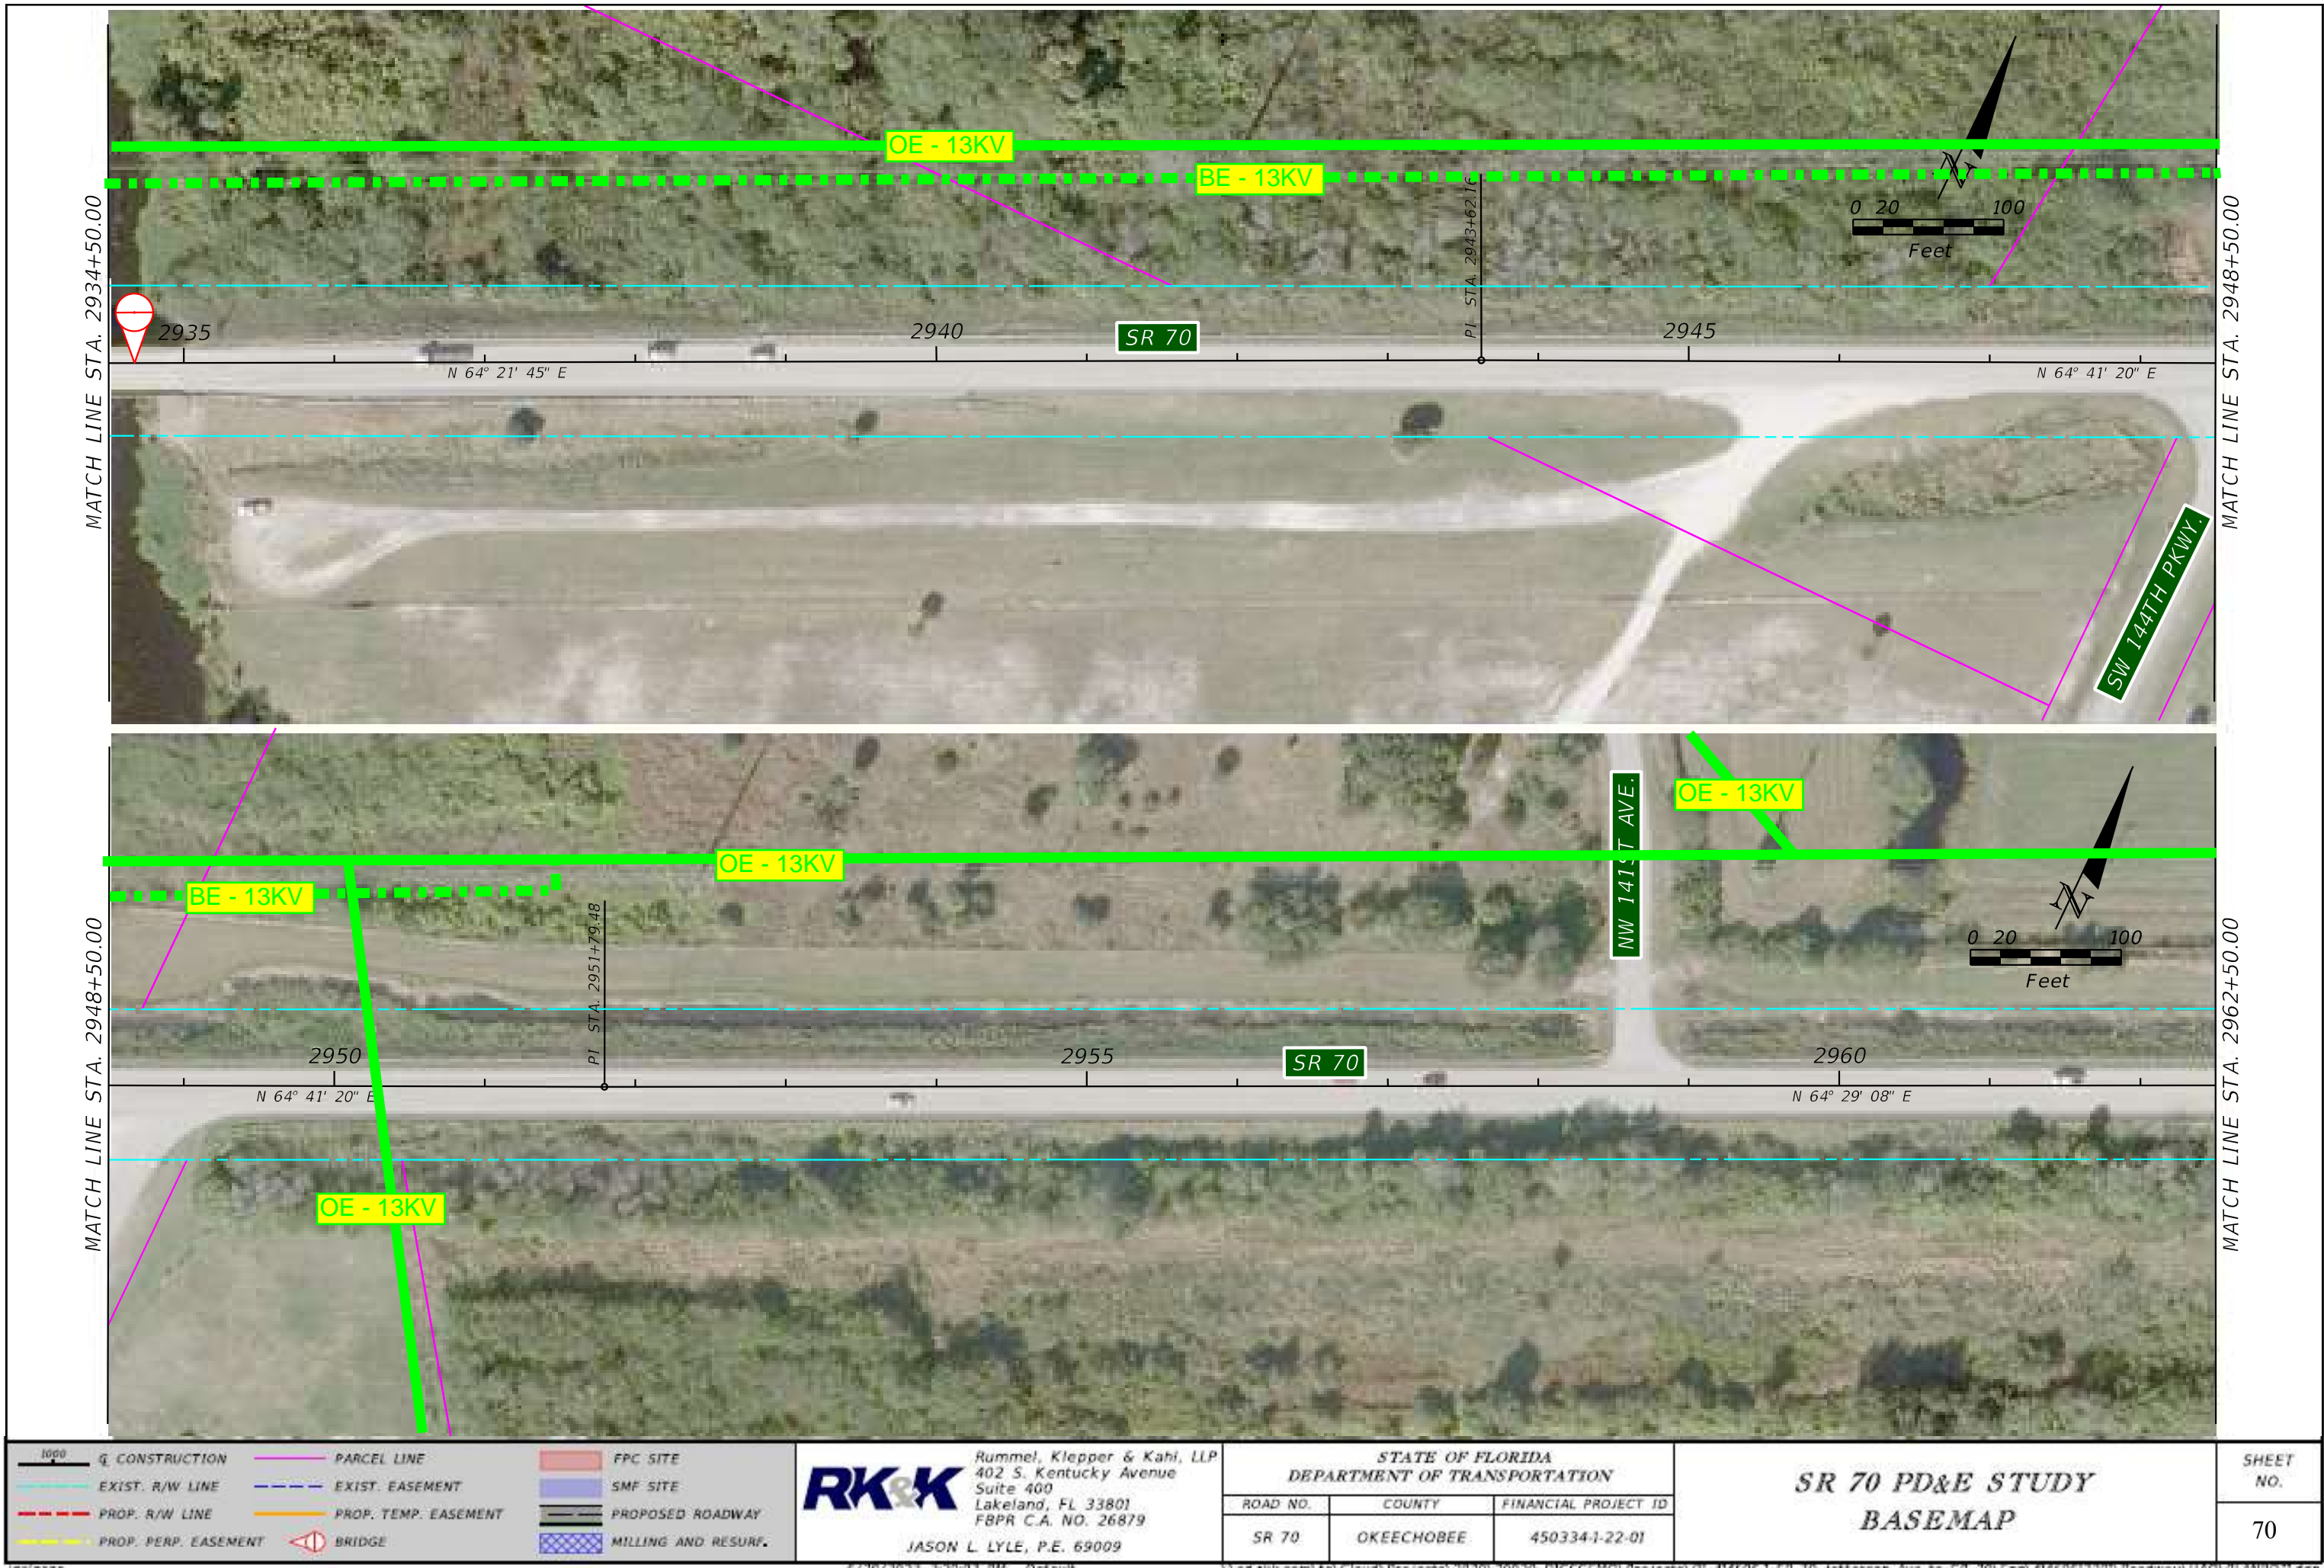



1000		Q CONSTRUCTION	PARCEL LINE	FPC SITE
---	---	EXIST. R/W LINE	EXIST. EASEMENT	SMF SITE
---	---	PROP. R/W LINE	PROP. TEMP. EASEMENT	PROPOSED ROADWAY
---	---	PROP. PERP. EASEMENT	BRIDGE	MILLING AND RESURF.

RK&K Rummel, Klepper & Kahl, LLP 402 S. Kentucky Avenue Suite 400 Lakeland, FL 33801 FBPR C.A. NO. 26879 JASON L. LYLE, P.E. 69009			STATE OF FLORIDA DEPARTMENT OF TRANSPORTATION		SR 70 PD&E STUDY BASEMAP		SHEET NO. 71
ROAD NO.		COUNTY	FINANCIAL PROJECT ID				
SR 70		OKEECHOBEE	450334-1-22-01				



1000

Q CONSTRUCTION

EXIST. R/W LINE

PROP. R/W LINE

PROP. PERP. EASEMENT

PARCEL LINE

EXIST. EASEMENT

PROP. TEMP. EASEMENT

⬮

BRIDGE

■

FPC SITE

■

SMF SITE

PROPOSED ROADWAY

▨

MILLING AND RESURF.

RK&K

Rummel, Klepper & Kahl, LLP
402 S. Kentucky Avenue
Suite 400
Lakeland, FL 33801
FBPR C.A. NO. 26879

JASON L. LYLE, P.E. 69009

STATE OF FLORIDA
DEPARTMENT OF TRANSPORTATION

ROAD NO.	COUNTY	FINANCIAL PROJECT ID
SR 70	OKEECHOBEE	450334-1-22-01

SR 70 PD&E STUDY
BASEMAP

SHEET NO.

72


jgalgano


6/29/2023 3:29:12 PM Default

\\ad.rkk.com\fs\Cloud\Projects\2020\20020_DICSCMO\Projects\DI 414506-1 SR 70 Jefferson Ave to CR 29\Eng\41450612201\Roadway\UAO\PLANRD72.dgn


THE OFFICIAL RECORD OF THIS SHEET IS THE ELECTRONIC FILE DIGITALLY SIGNED AND SEALED UNDER RULE 61G15-23.004, F.A.C.

FLORIDA POWER & LIGHT TRANSMISSION

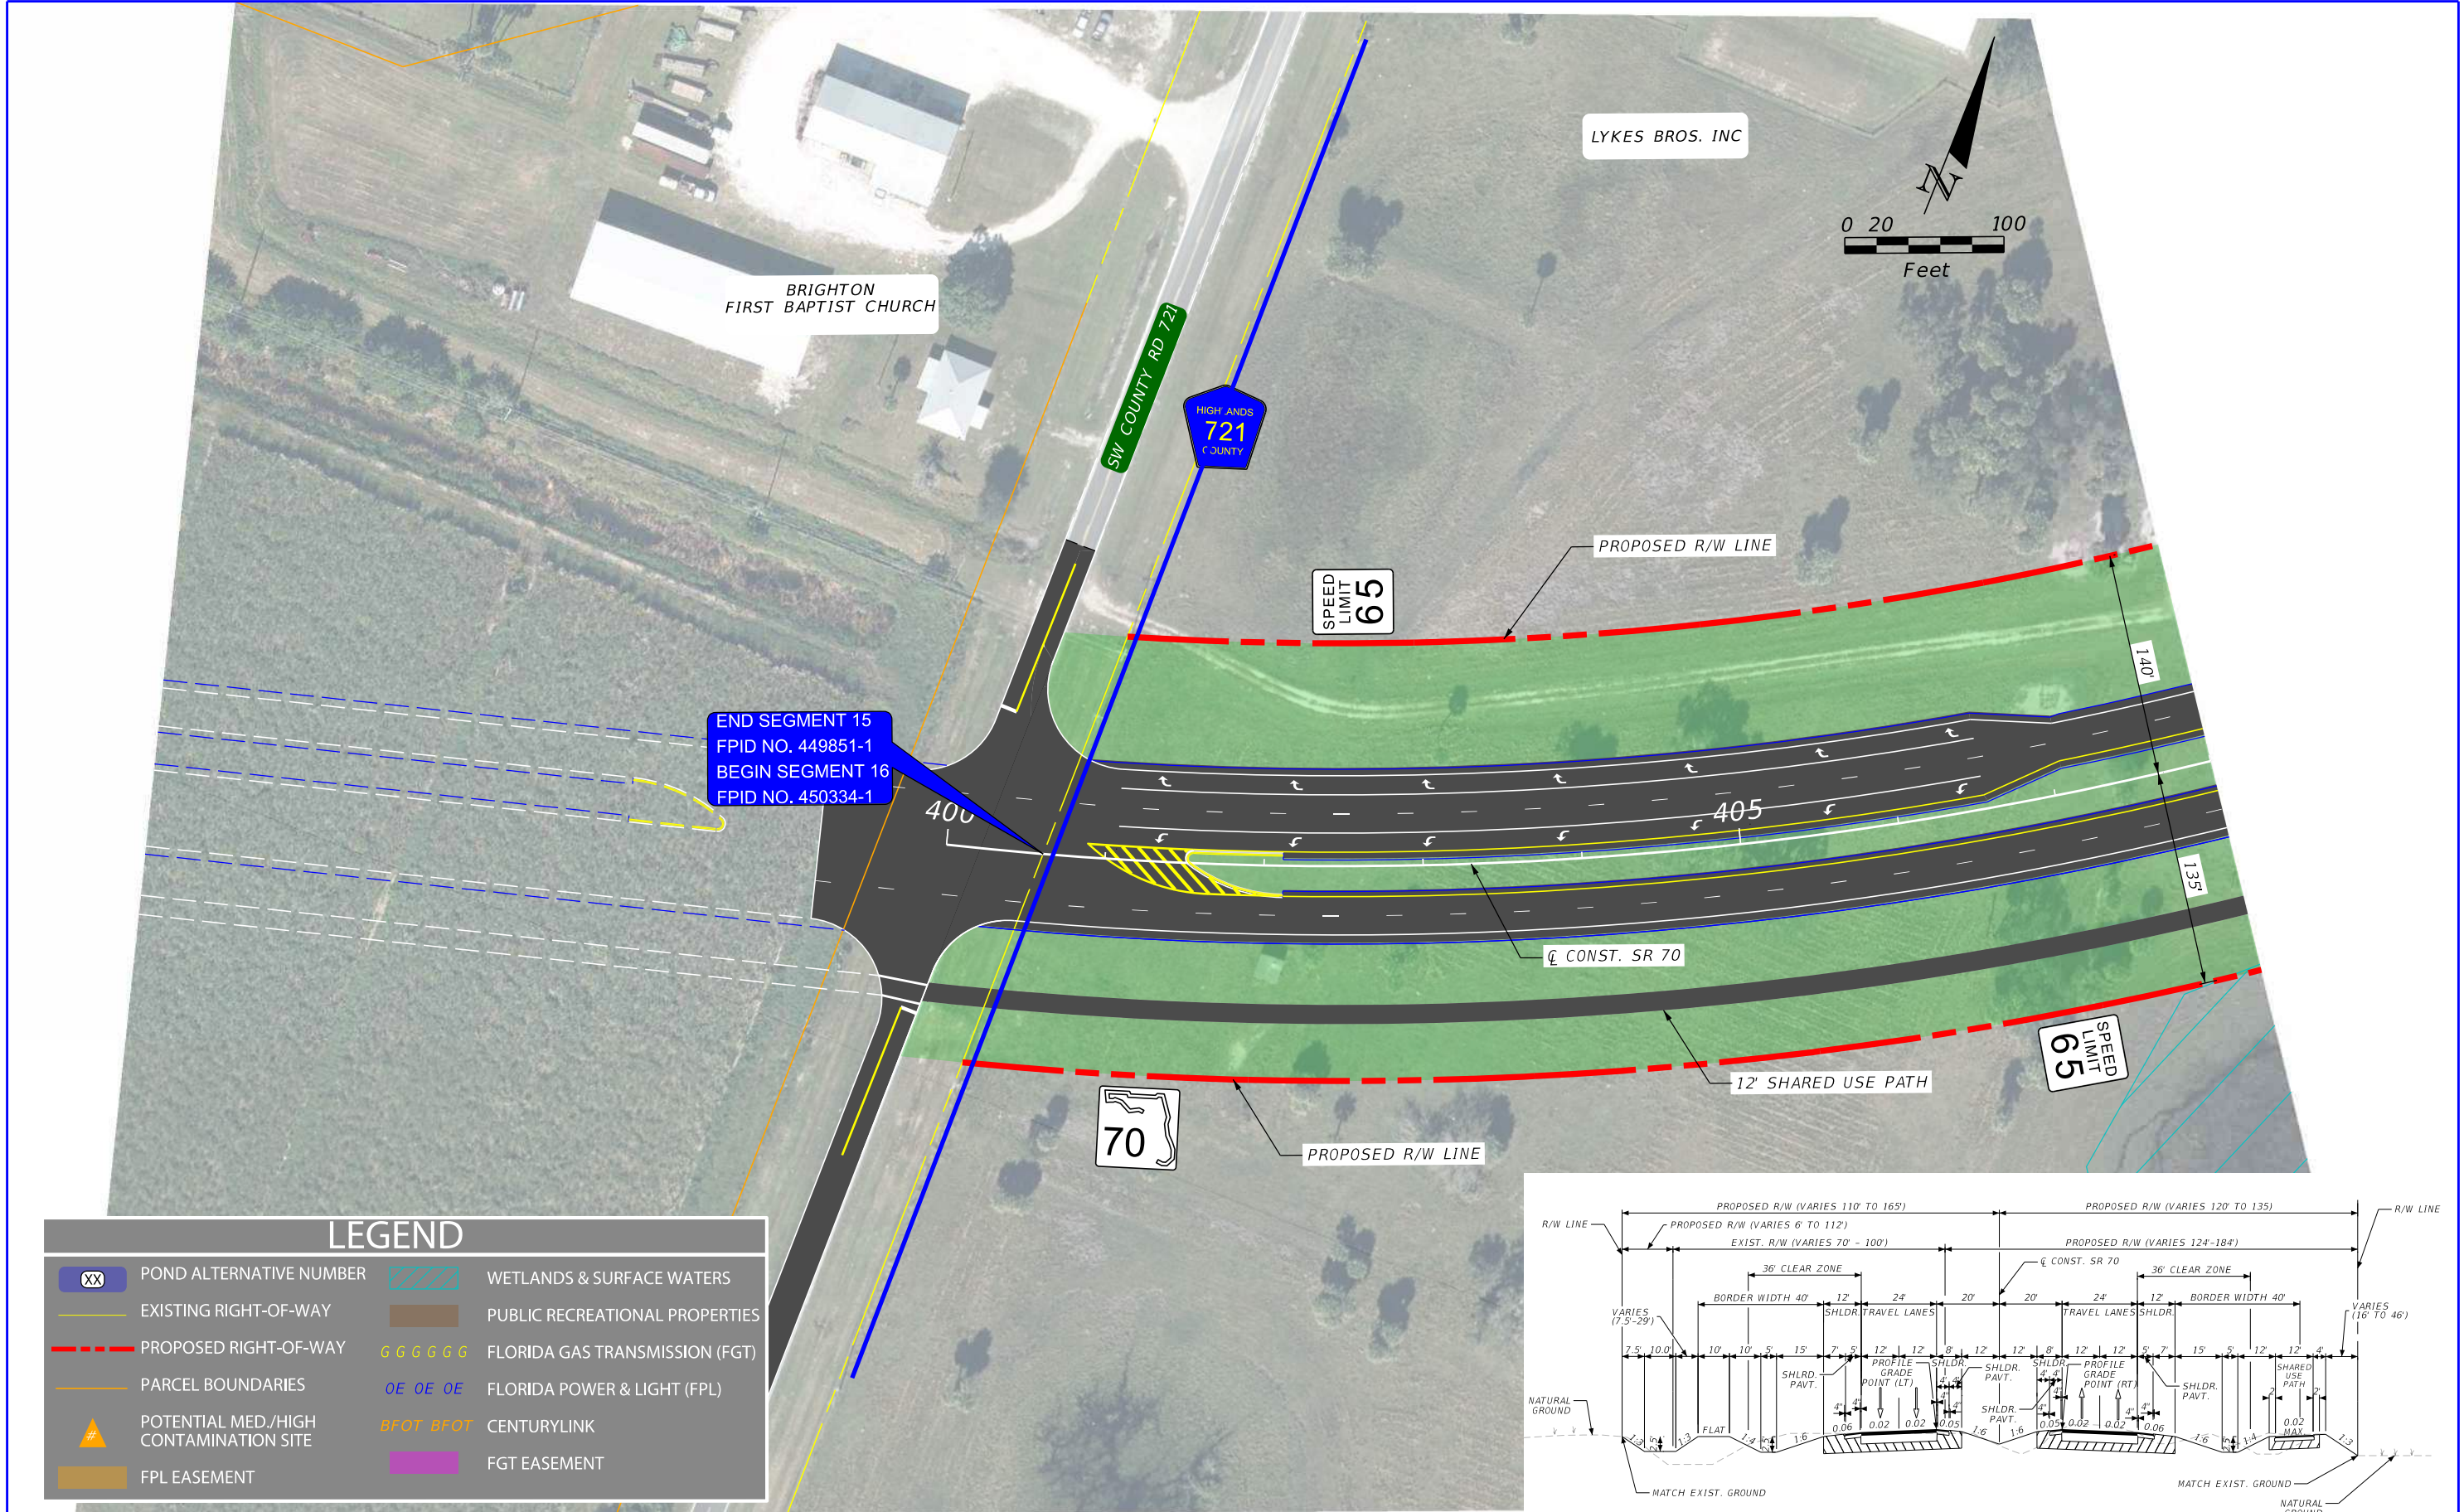

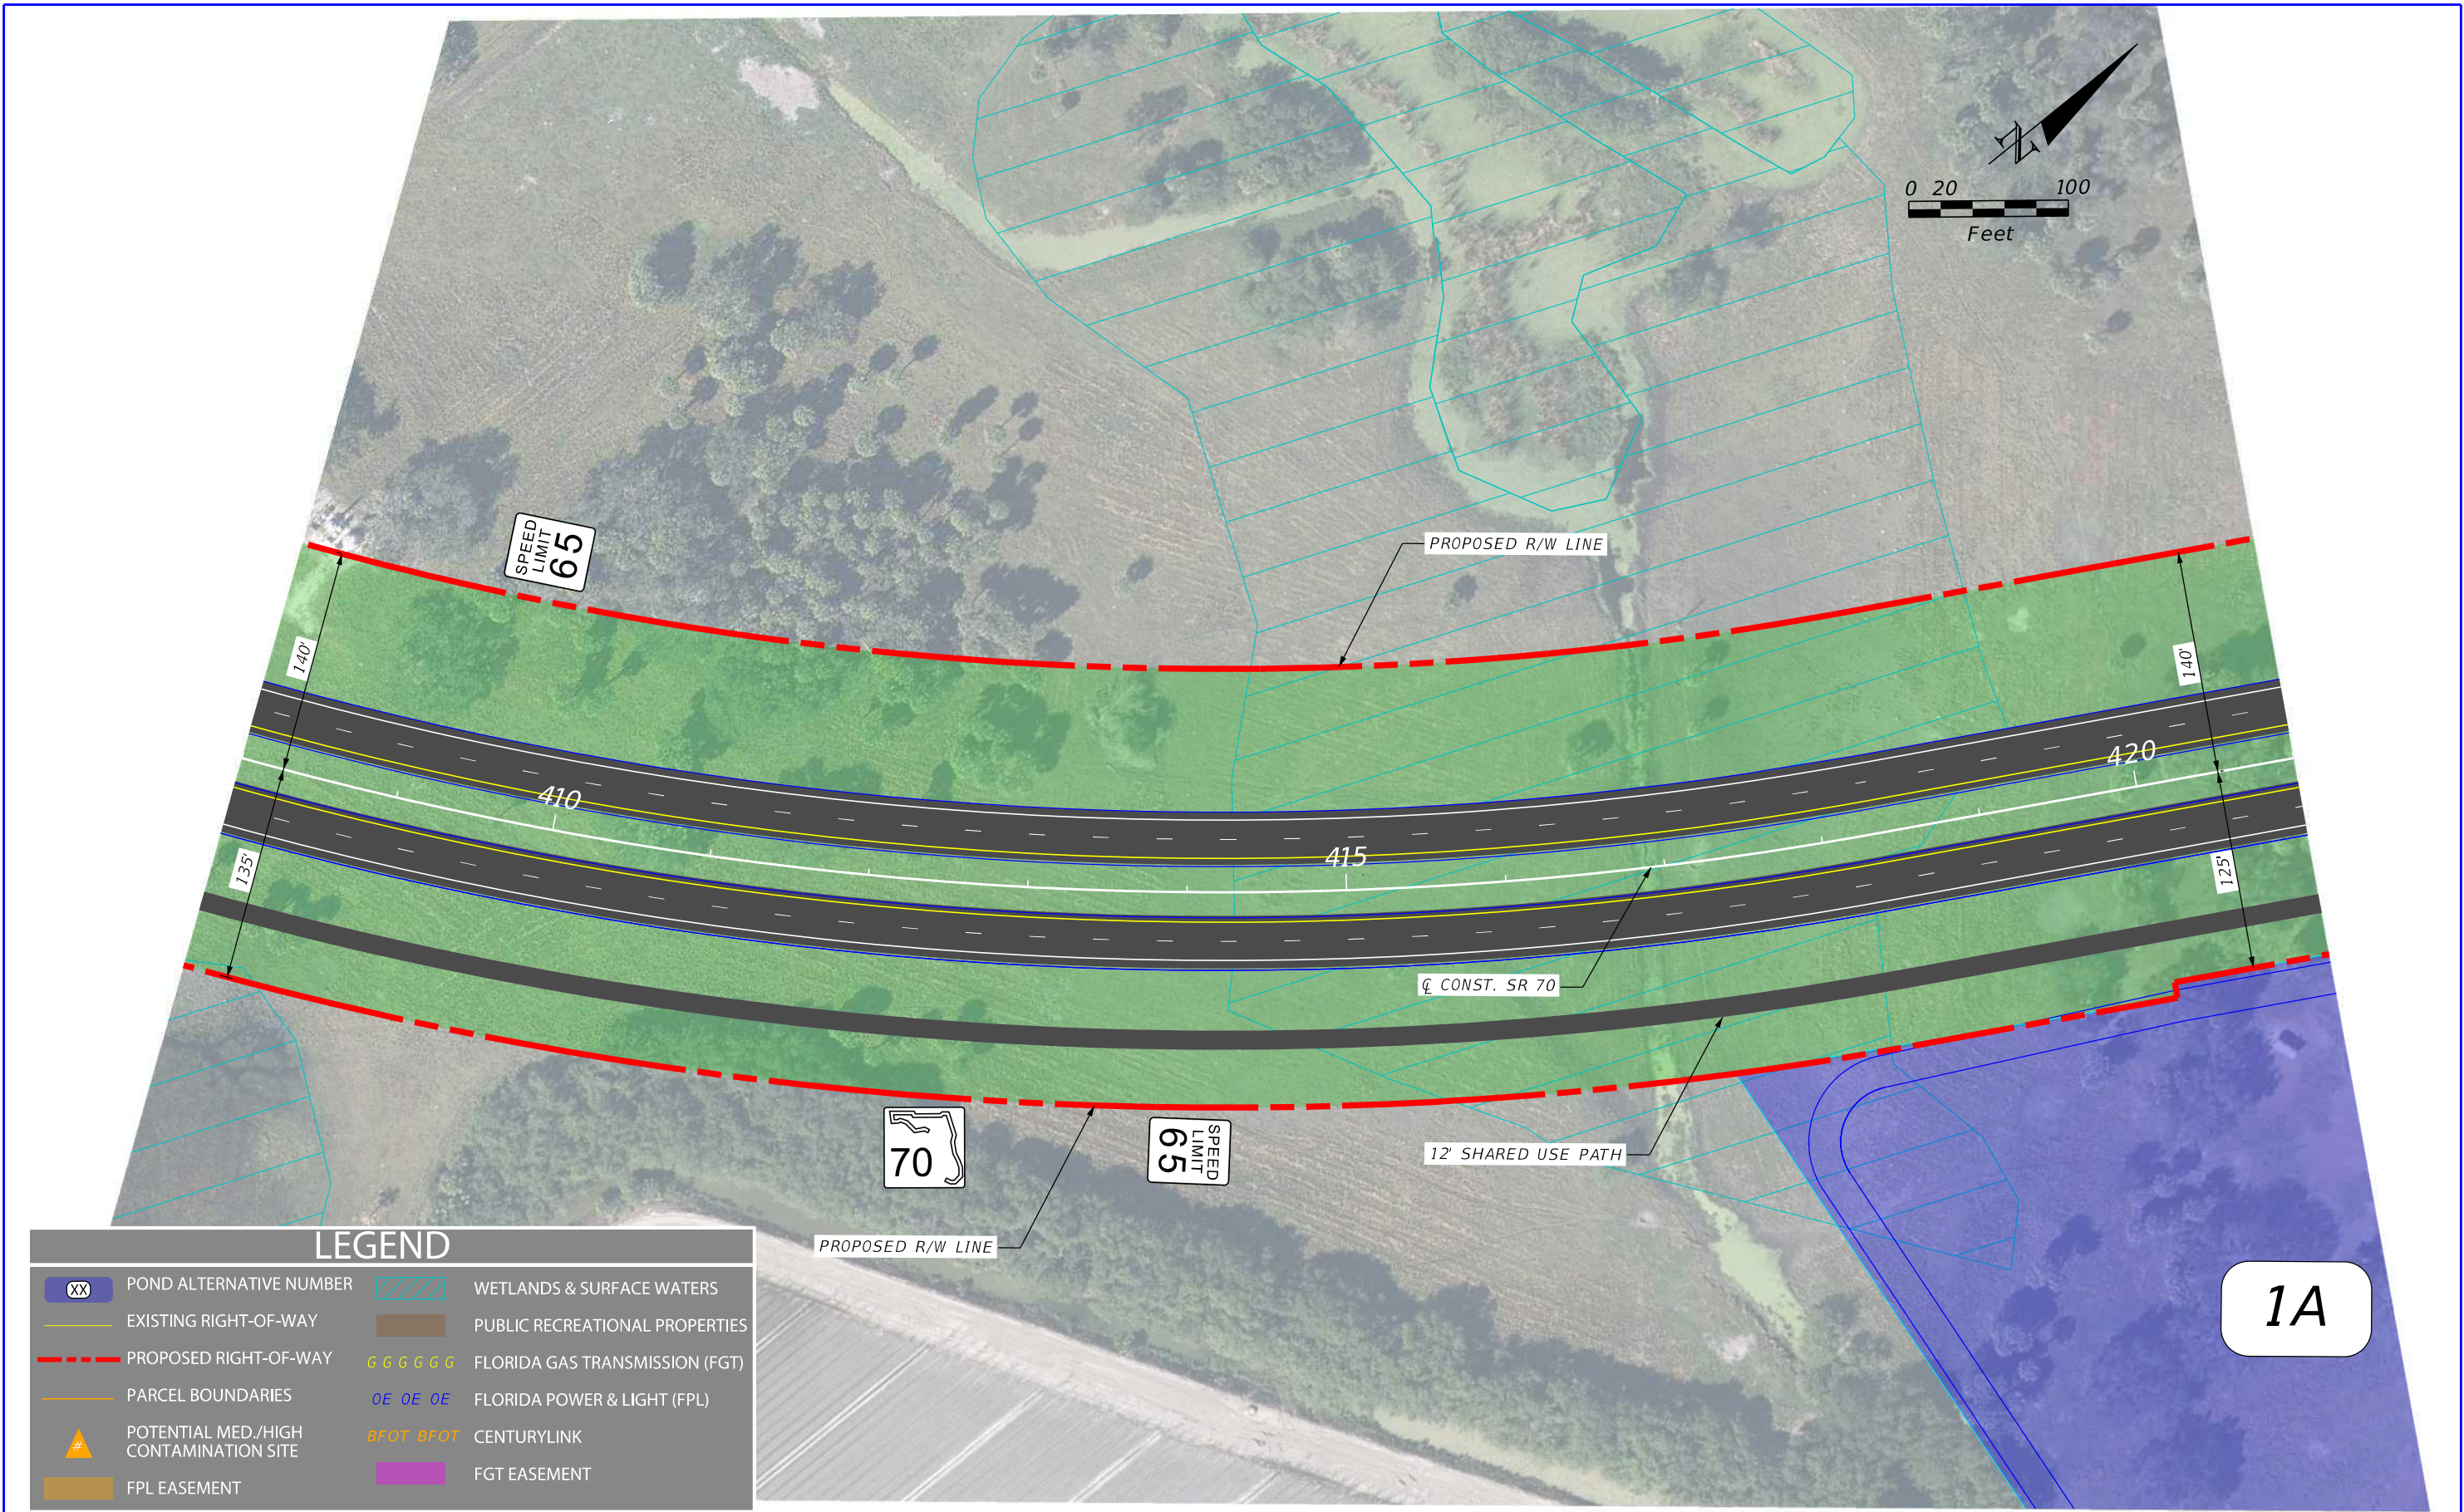

REVISIONS				ENGINEER OF RECORD		STATE OF FLORIDA DEPARTMENT OF TRANSPORTATION		ALTERNATIVE 1 CONCEPT PLAN	SHEET NO. 2
DATE	DESCRIPTION	DATE	DESCRIPTION	NICHOLAS JOHN CLAVELO LICENSE NUMBER: 84366 SCALAR CONSULTING GROUP INC. 5713 CORPORATE WAY, SUITE 200 WEST PALM BEACH, FLORIDA 33407		ROAD NO.	COUNTY		
						SR 70	HIGHLANDS OKEECHOBEE	FINANCIAL PROJECT ID 450334-1-22-01	

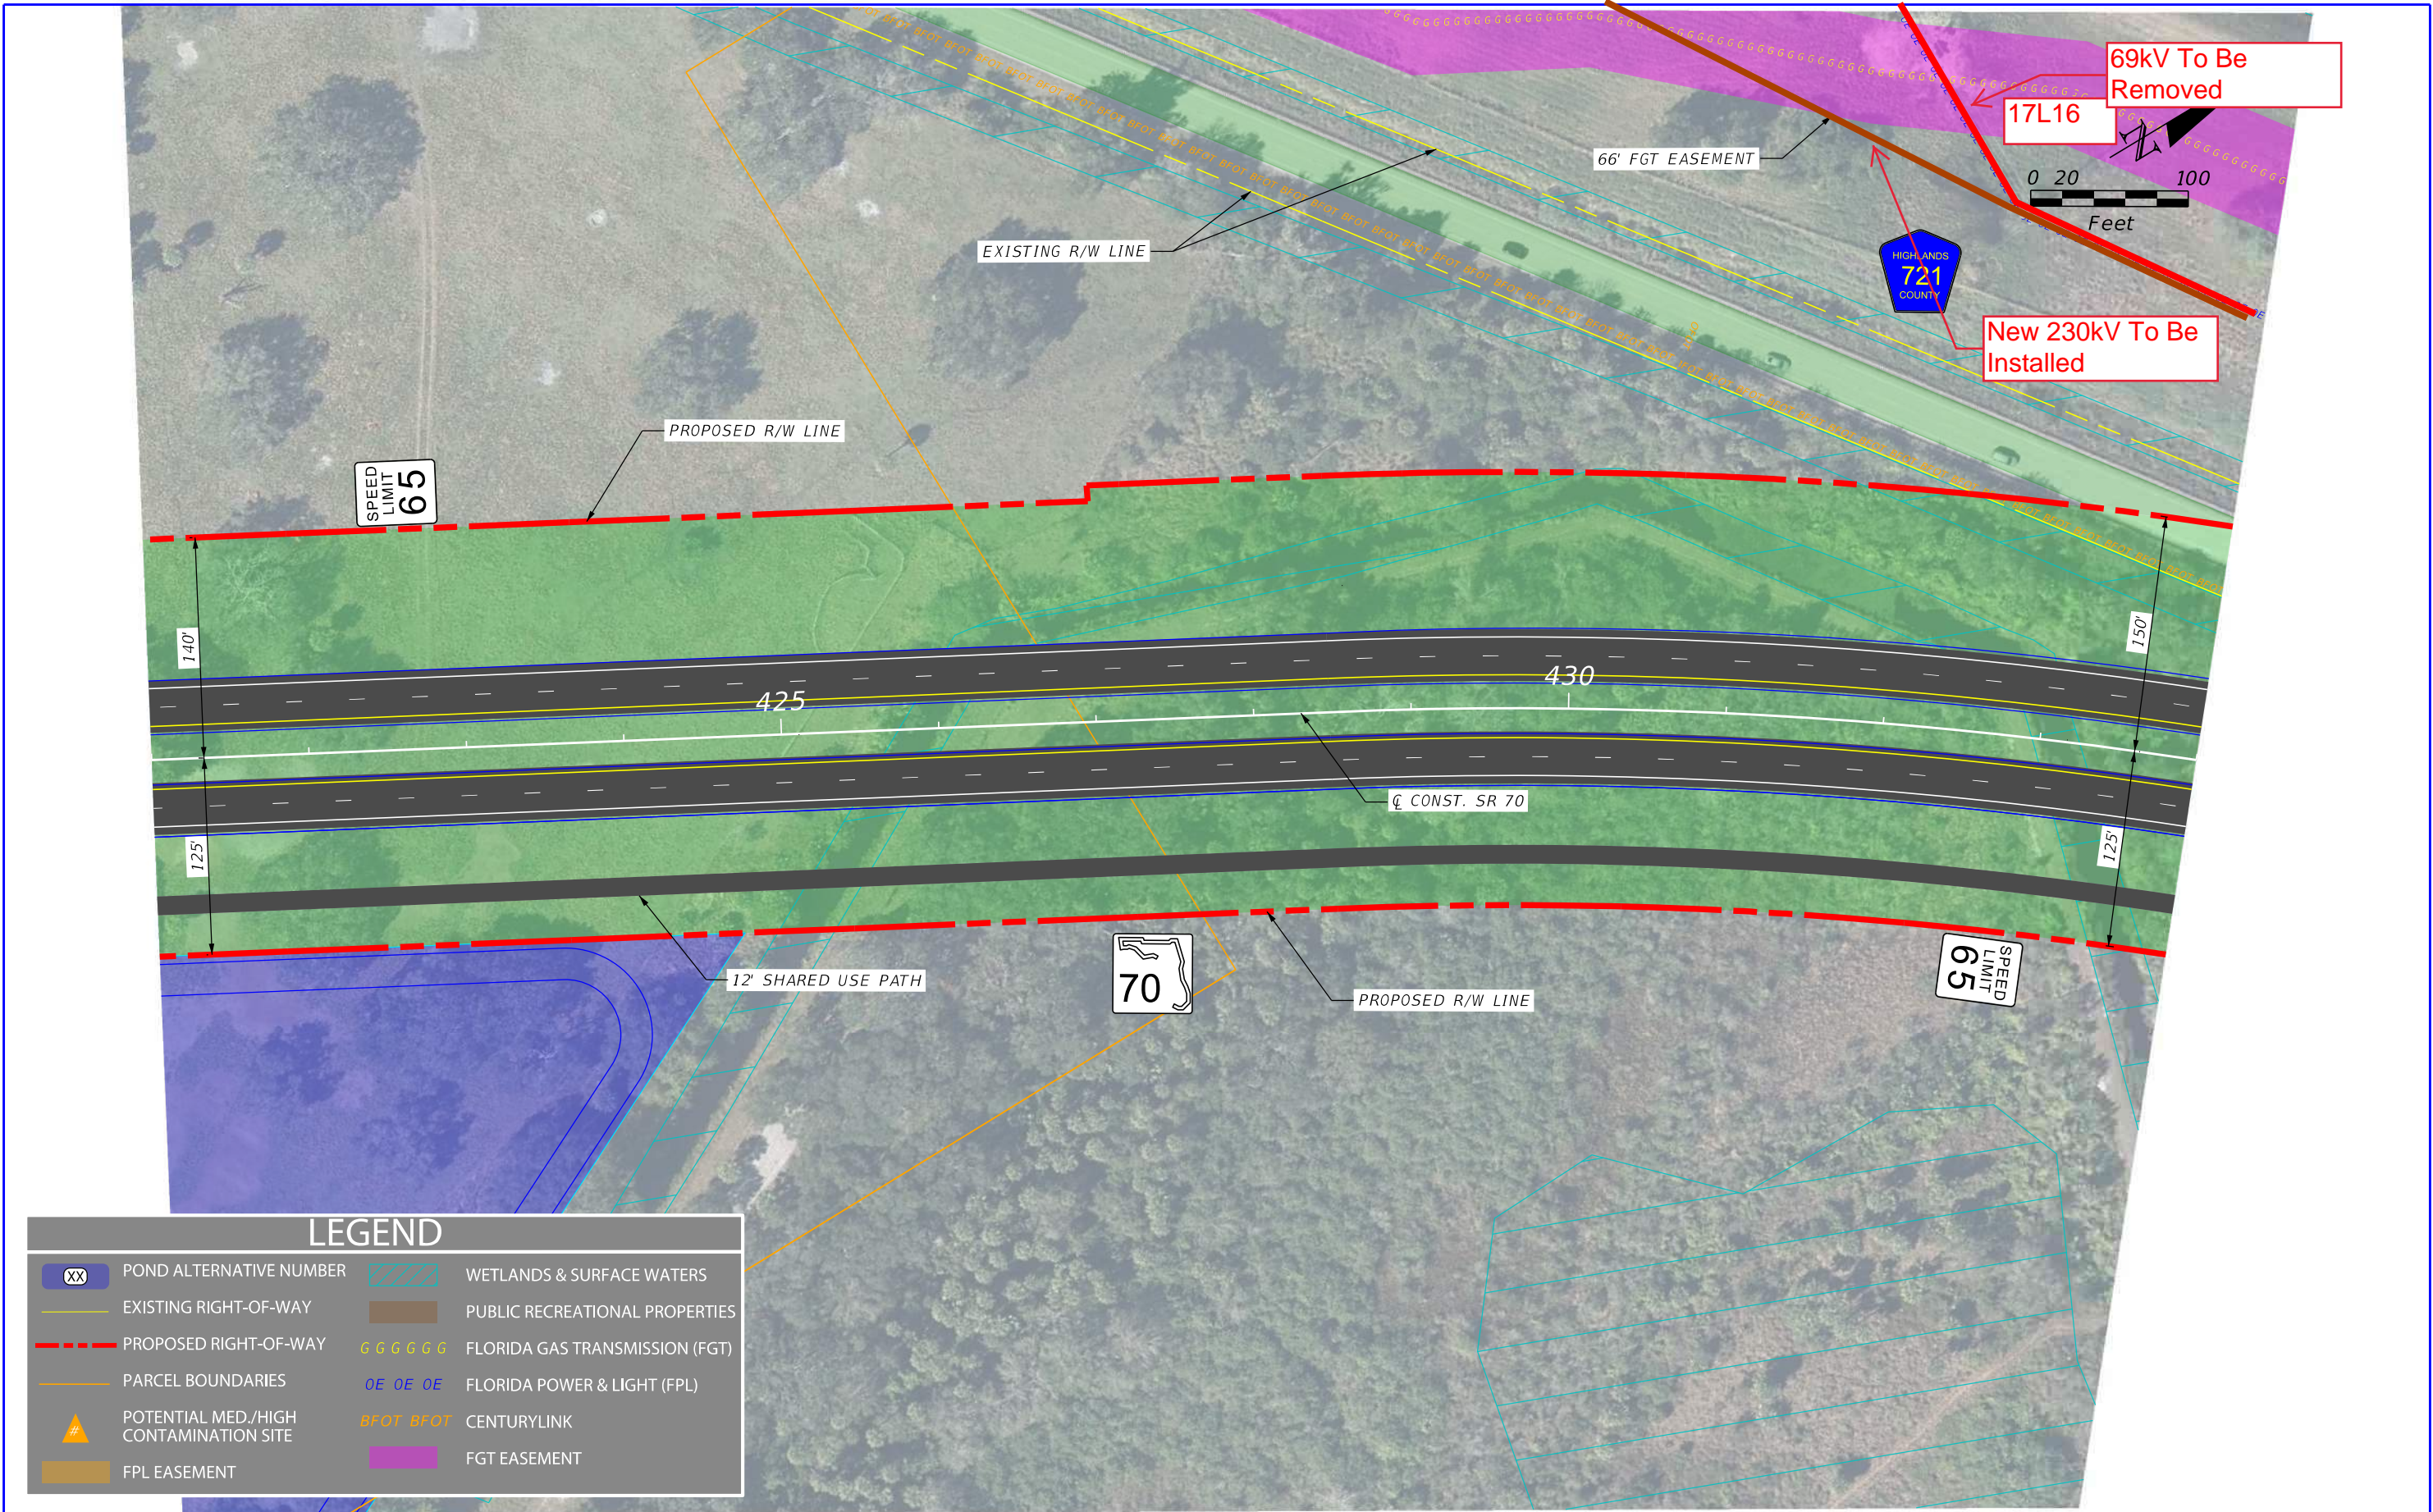

LEGEND

XX

POND ALTERNATIVE NUMBER

EXISTING RIGHT-OF-WAY

PROPOSED RIGHT-OF-WAY

PARCEL BOUNDARIES

#

POTENTIAL MED./HIGH CONTAMINATION SITE

FPL EASEMENT

WETLANDS & SURFACE WATERS

PUBLIC RECREATIONAL PROPERTIES

G G G G G G

FLORIDA GAS TRANSMISSION (FGT)

OE OE OE


FLORIDA POWER & LIGHT (FPL)

BFOT BFOT

CENTURYLINK

FGT EASEMENT

REVISIONS				ENGINEER OF RECORD		STATE OF FLORIDA DEPARTMENT OF TRANSPORTATION		ALTERNATIVE 1 CONCEPT PLAN	SHEET NO. 3
DATE	DESCRIPTION	DATE	DESCRIPTION	NICHOLAS JOHN CLAVELO LICENSE NUMBER: 84366 SCALAR CONSULTING GROUP INC. 5713 CORPORATE WAY, SUITE 200 WEST PALM BEACH, FLORIDA 33407		ROAD NO.	COUNTY		
						SR 70	HIGHLANDS OKEECHOBEE	FINANCIAL PROJECT ID 450334-1-22-01	

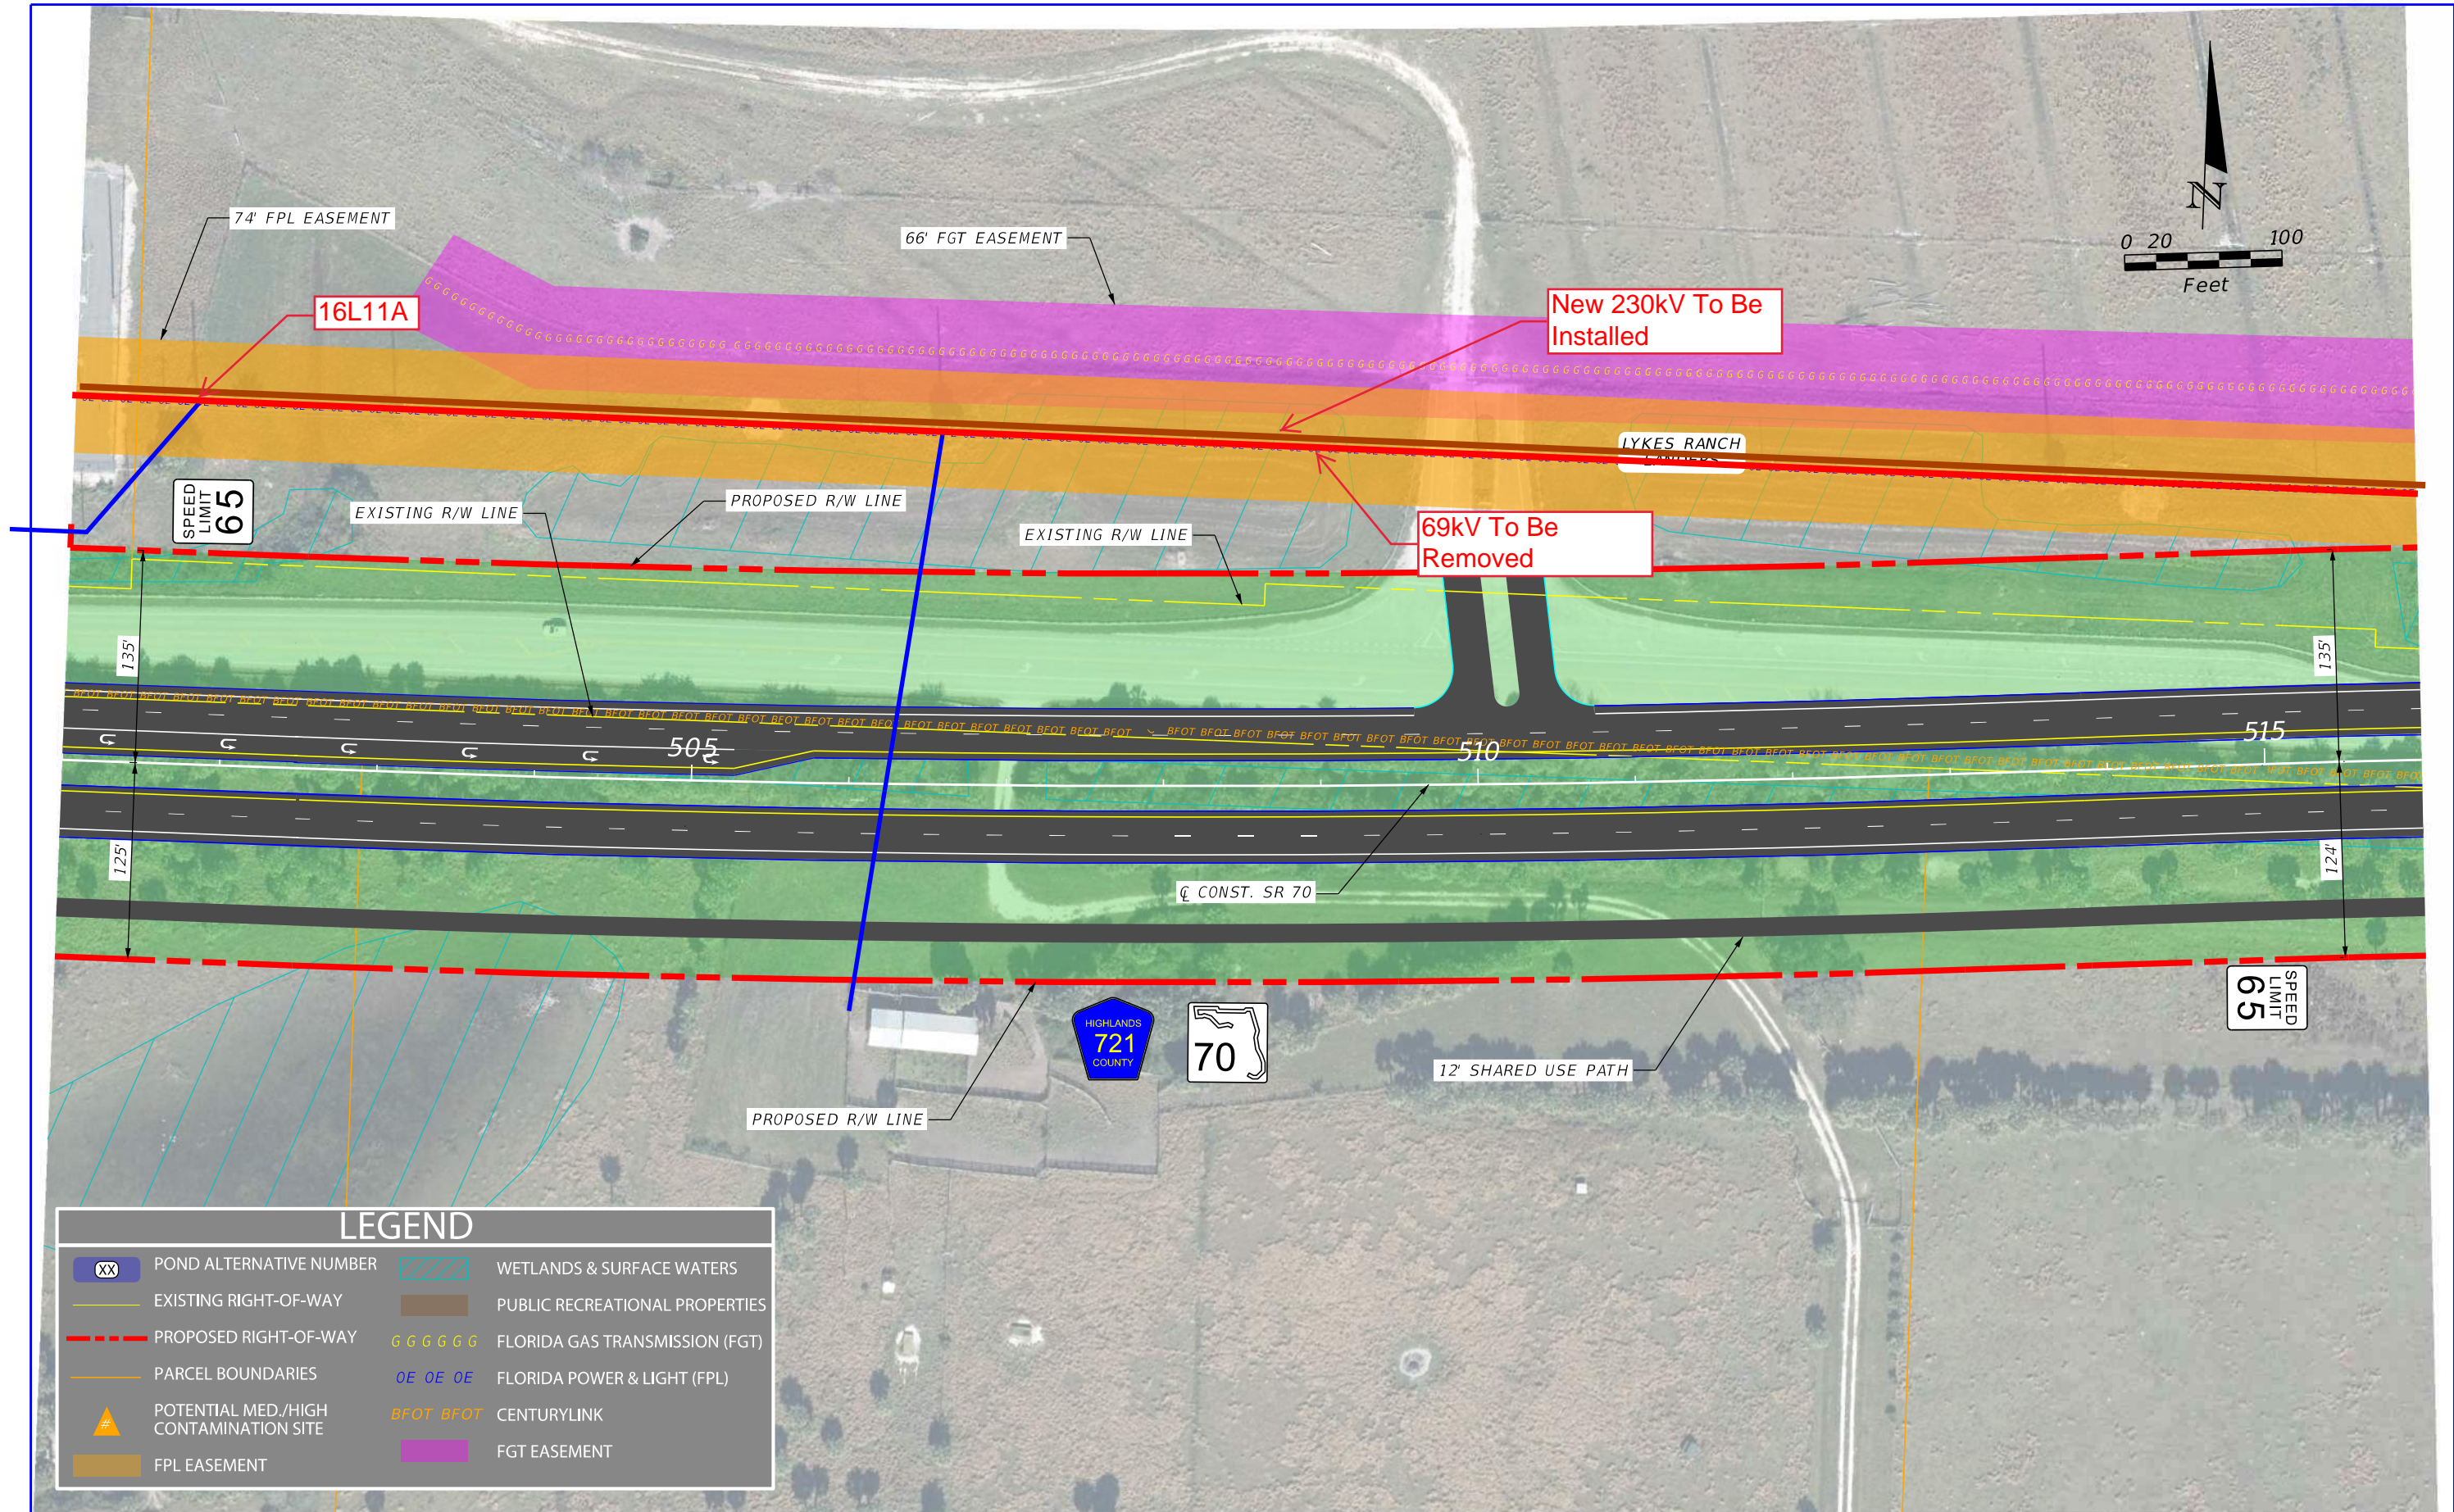

LEGEND

XX

POND ALTERNATIVE NUMBER

EXISTING RIGHT-OF-WAY

PROPOSED RIGHT-OF-WAY

PARCEL BOUNDARIES

POTENTIAL MED/HIGH CONTAMINATION SITE

FPL EASEMENT

WETLANDS & SURFACE WATERS

PUBLIC RECREATIONAL PROPERTIES

GGGGGG

FLORIDA GAS TRANSMISSION (FGT)

OE OE OE


FLORIDA POWER & LIGHT (FPL)

BFOT BFOT

CENTURYLINK

FGT EASEMENT

REVISIONS				ENGINEER OF RECORD		STATE OF FLORIDA DEPARTMENT OF TRANSPORTATION		ALTERNATIVE 1 CONCEPT PLAN	SHEET NO. 9
DATE	DESCRIPTION	DATE	DESCRIPTION	NICHOLAS JOHN CLAVELO LICENSE NUMBER: 84366 SCALAR CONSULTING GROUP INC. 5713 CORPORATE WAY, SUITE 200 WEST PALM BEACH, FLORIDA 33407		ROAD NO.	COUNTY		
						SR 70	HIGHLANDS OKEECHOBEE	FINANCIAL PROJECT ID 450334-1-22-01	

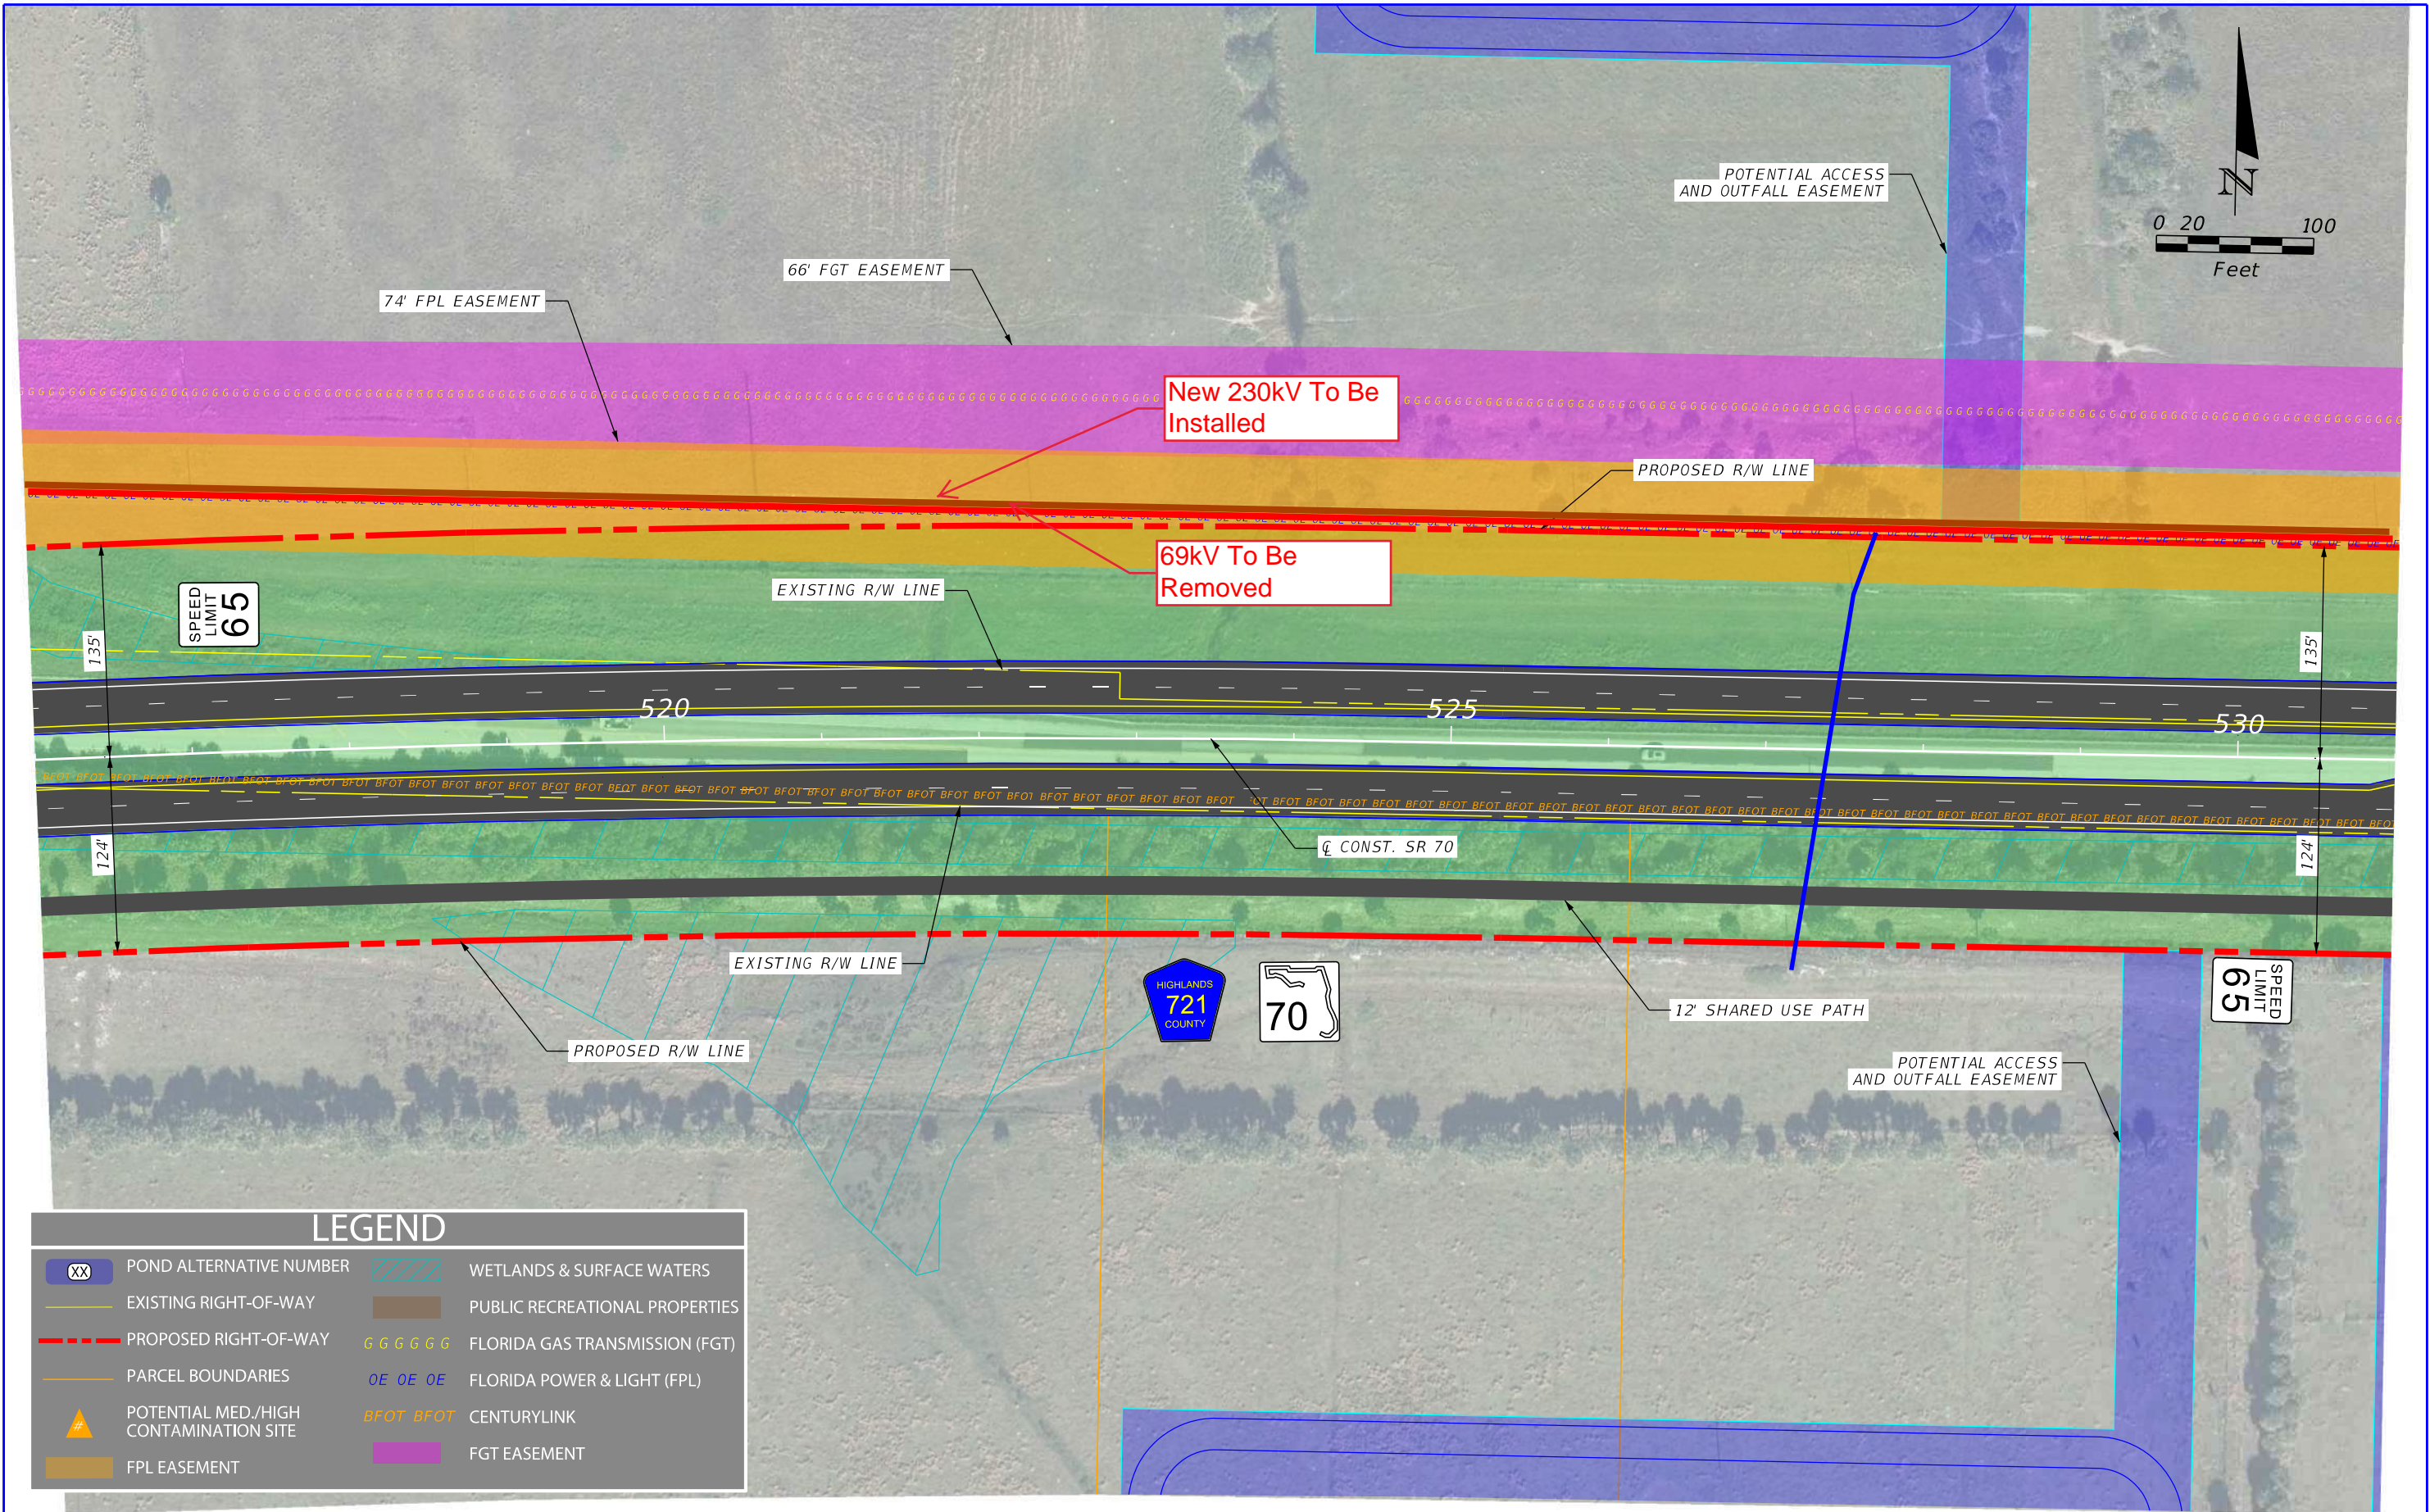

XX

POND ALTERNATIVE NUMBER

EXISTING RIGHT-OF-WAY

PROPOSED RIGHT-OF-WAY

PARCEL BOUNDARIES

#

POTENTIAL MED./HIGH CONTAMINATION SITE

FPL EASEMENT

WETLANDS & SURFACE WATERS

PUBLIC RECREATIONAL PROPERTIES

GGGGGG

FLORIDA GAS TRANSMISSION (FGT)

OE OE OE


FLORIDA POWER & LIGHT (FPL)

BFOT BFOT


CENTURYLINK

FGT EASEMENT


REVISIONS				ENGINEER OF RECORD		STATE OF FLORIDA DEPARTMENT OF TRANSPORTATION		ALTERNATIVE 1 CONCEPT PLAN	SHEET NO. 10
DATE	DESCRIPTION	DATE	DESCRIPTION	NICHOLAS JOHN CLAVELO LICENSE NUMBER: 84366 SCALAR CONSULTING GROUP INC. 5713 CORPORATE WAY, SUITE 200 WEST PALM BEACH, FLORIDA 33407		ROAD NO.	COUNTY		
						SR 70	HIGHLANDS OKEECHOBEE	FINANCIAL PROJECT ID 450334-1-22-01	

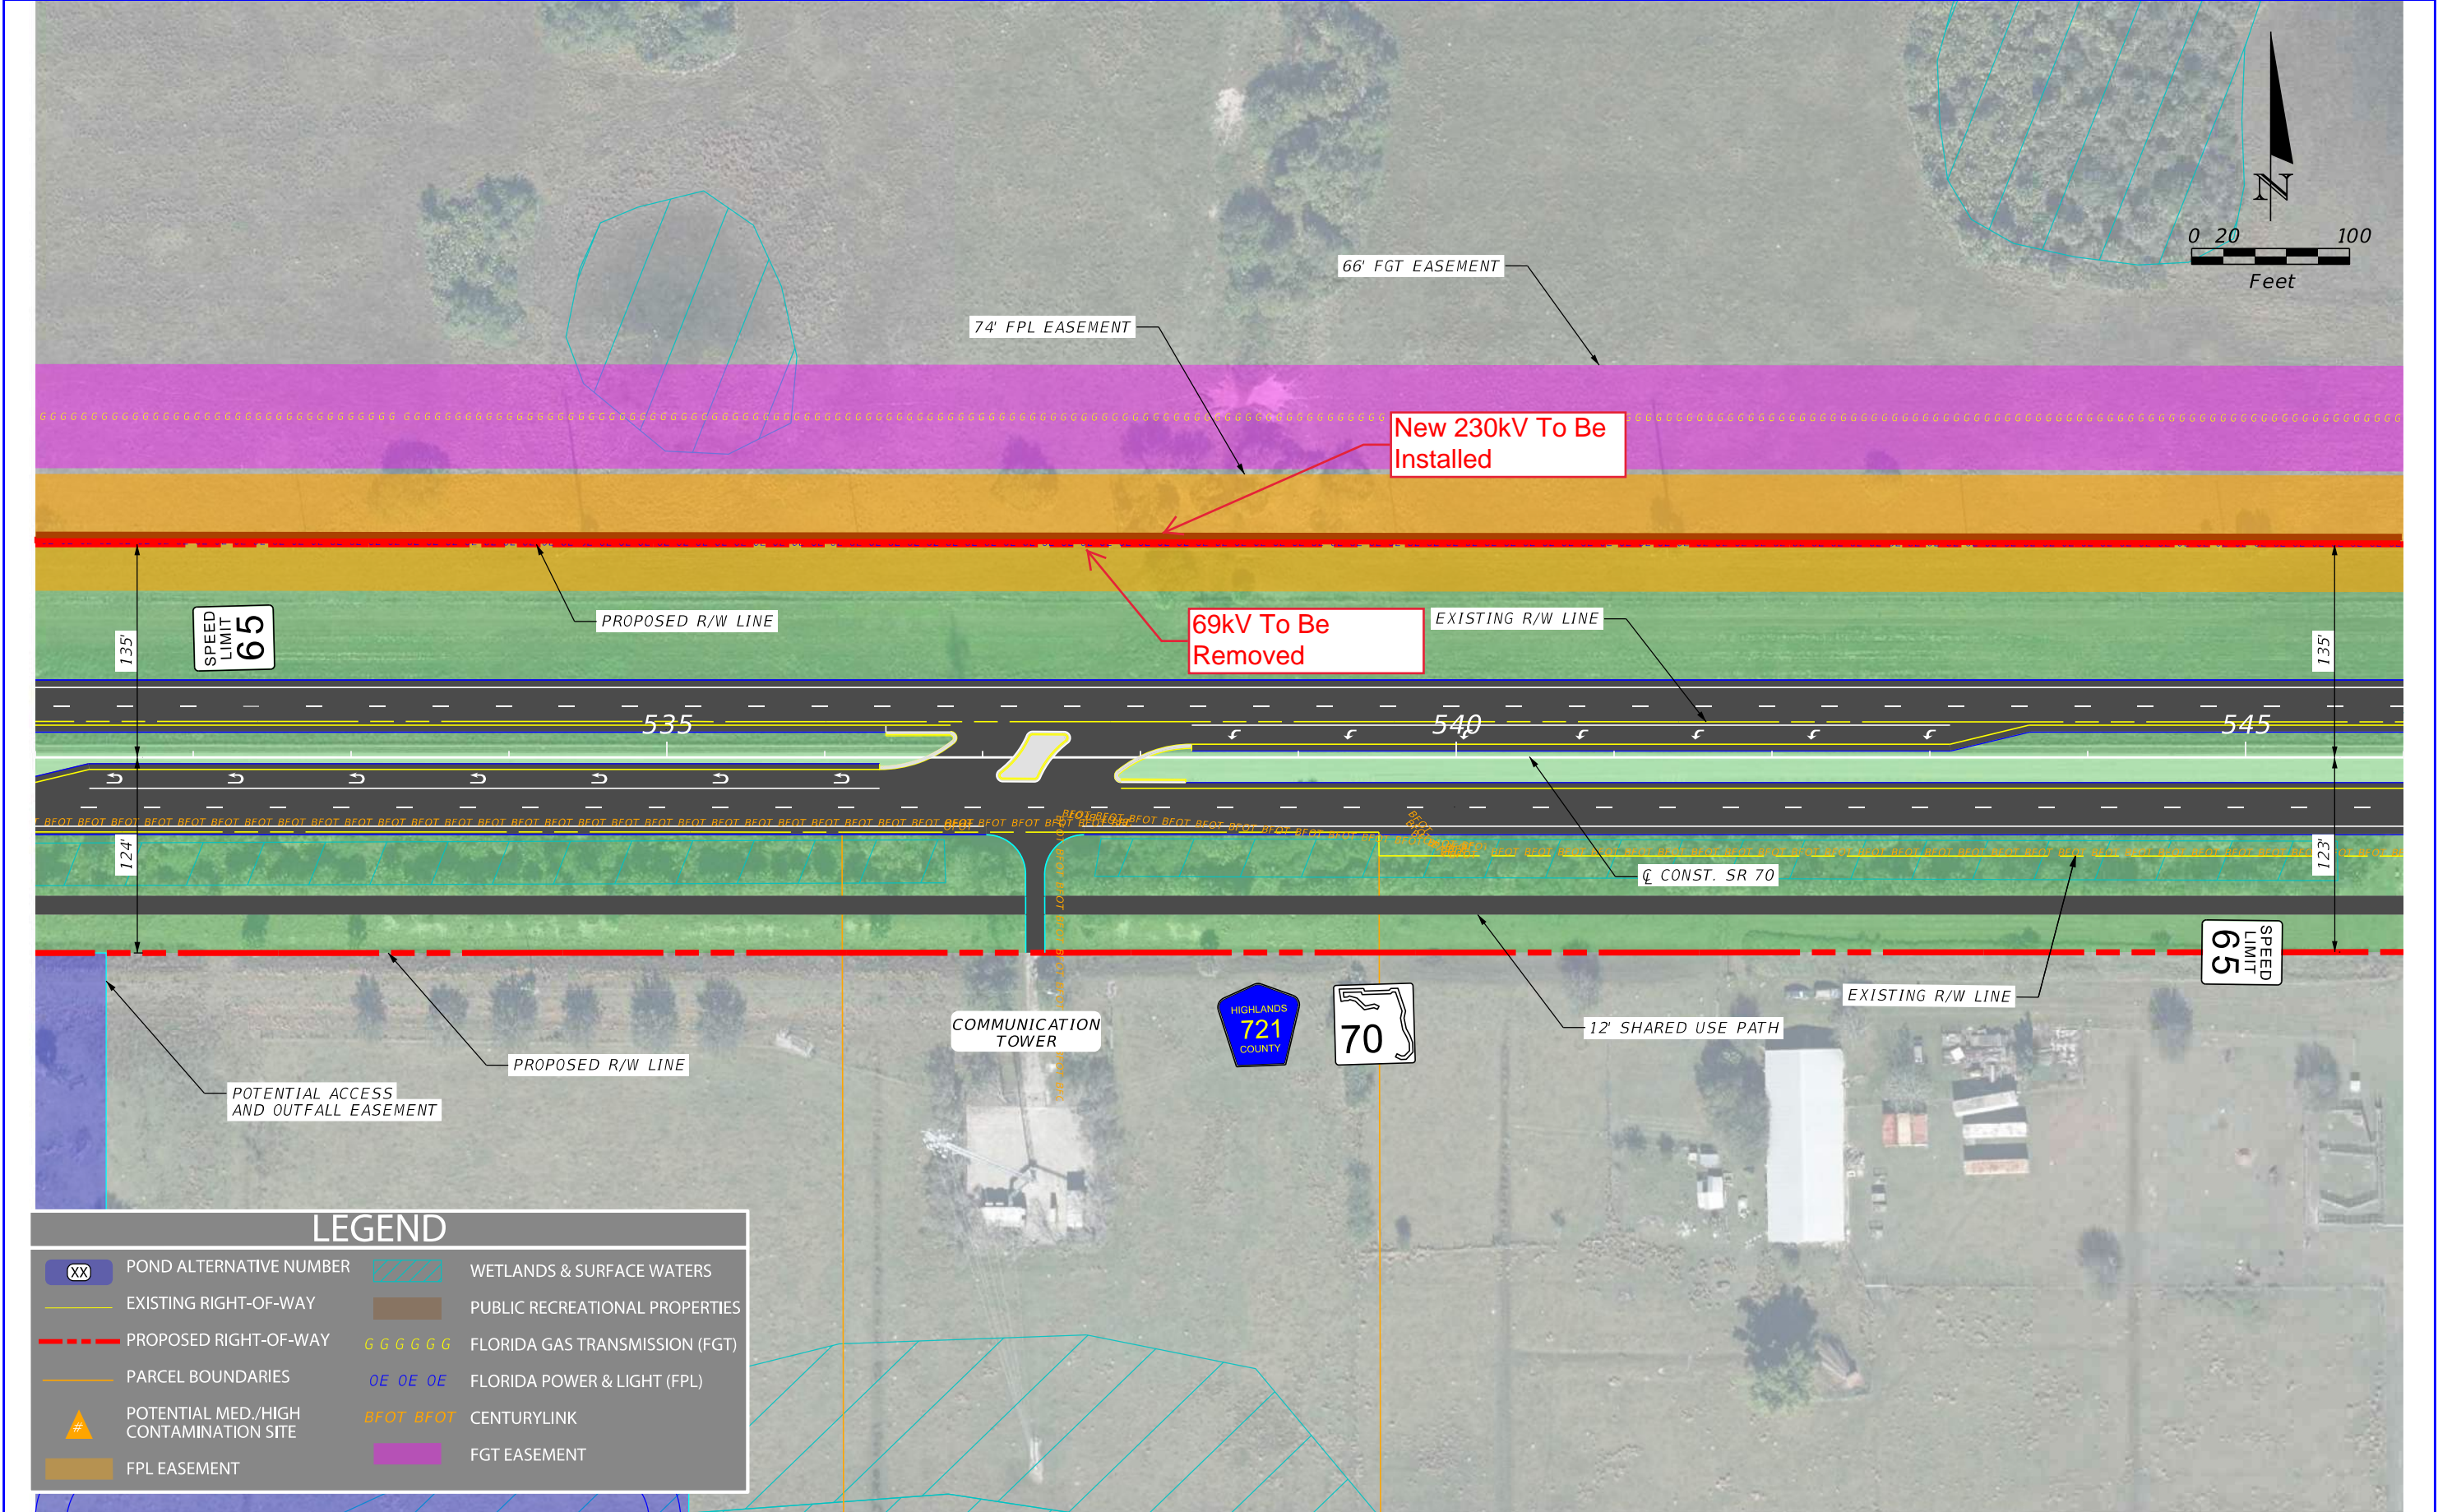

REVISIONS				ENGINEER OF RECORD		STATE OF FLORIDA DEPARTMENT OF TRANSPORTATION		ALTERNATIVE 1 CONCEPT PLAN	SHEET NO. 11
DATE	DESCRIPTION	DATE	DESCRIPTION	NICHOLAS JOHN CLAVELO LICENSE NUMBER: 84366 SCALAR CONSULTING GROUP INC. 5713 CORPORATE WAY, SUITE 200 WEST PALM BEACH, FLORIDA 33407		ROAD NO.	COUNTY		
						SR 70	HIGHLANDS OKEECHOBEE	FINANCIAL PROJECT ID 450334-1-22-01	

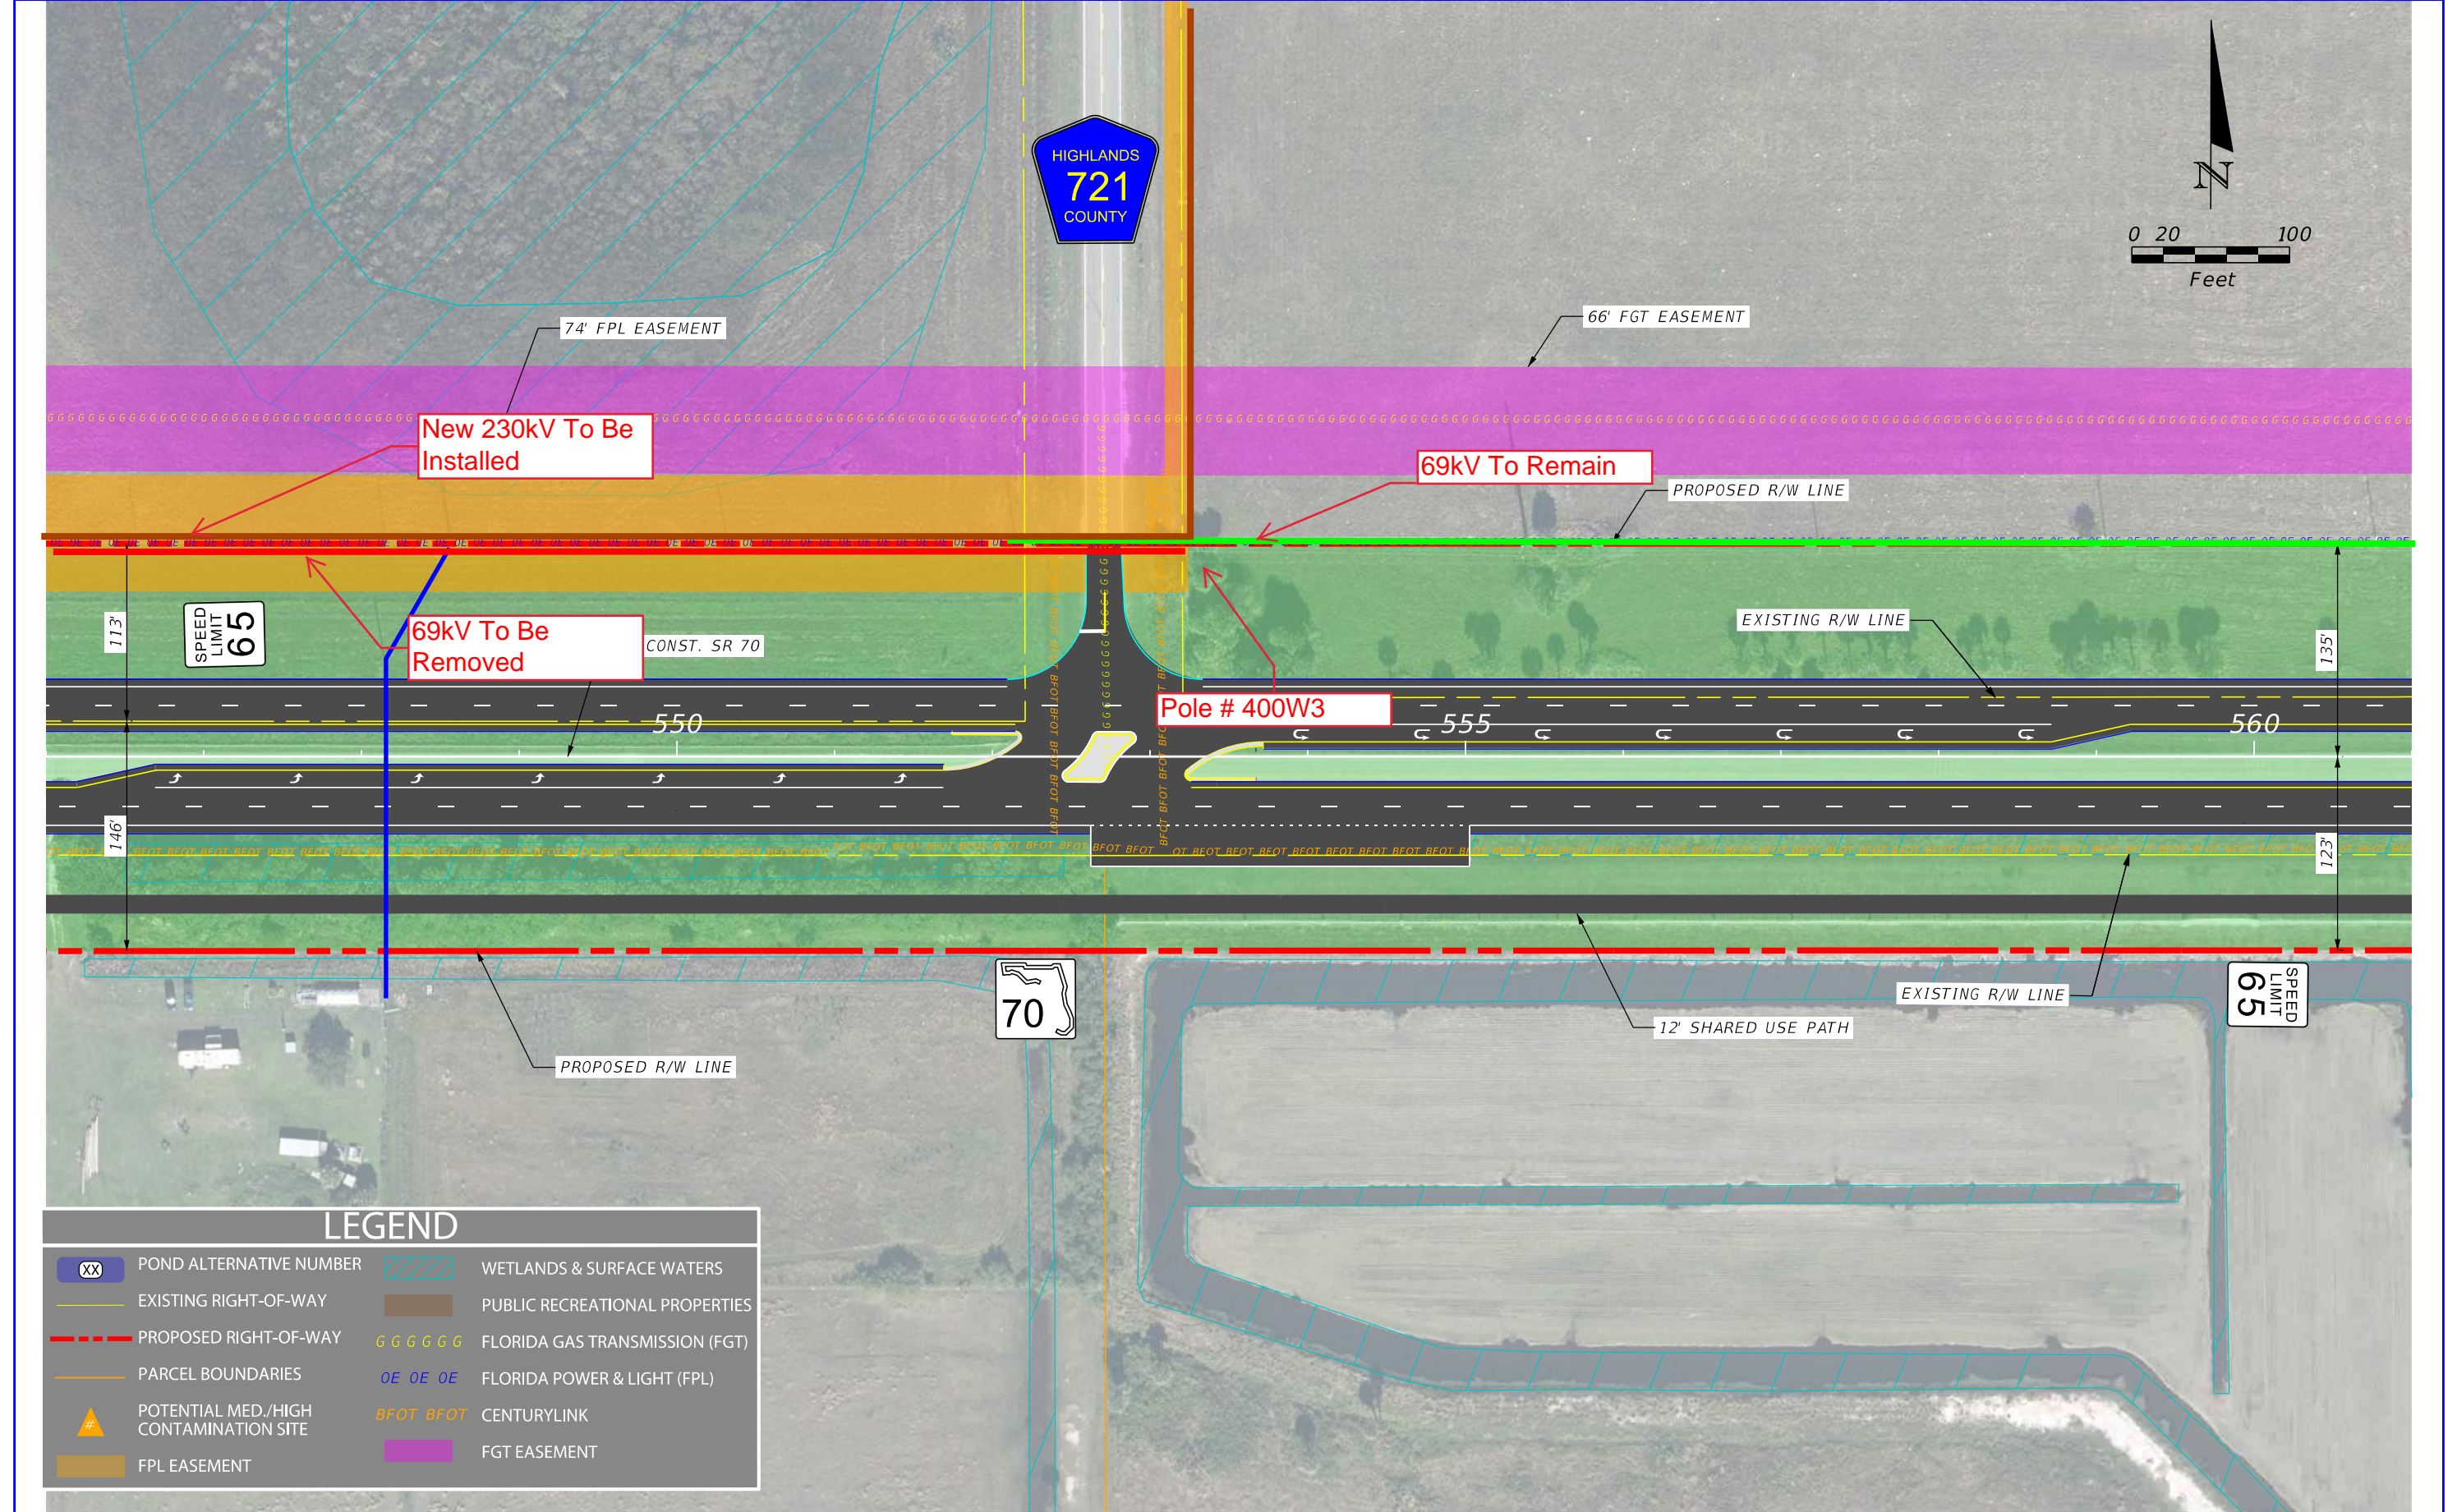

REVISIONS				ENGINEER OF RECORD		STATE OF FLORIDA DEPARTMENT OF TRANSPORTATION		ALTERNATIVE 1 CONCEPT PLAN	SHEET NO. 12
DATE	DESCRIPTION	DATE	DESCRIPTION	NICHOLAS JOHN CLAVELO LICENSE NUMBER: 84366 SCALAR CONSULTING GROUP INC. 5713 CORPORATE WAY, SUITE 200 WEST PALM BEACH, FLORIDA 33407		ROAD NO.	COUNTY		
						SR 70	HIGHLANDS OKEECHOBEE	FINANCIAL PROJECT ID 450334-1-22-01	

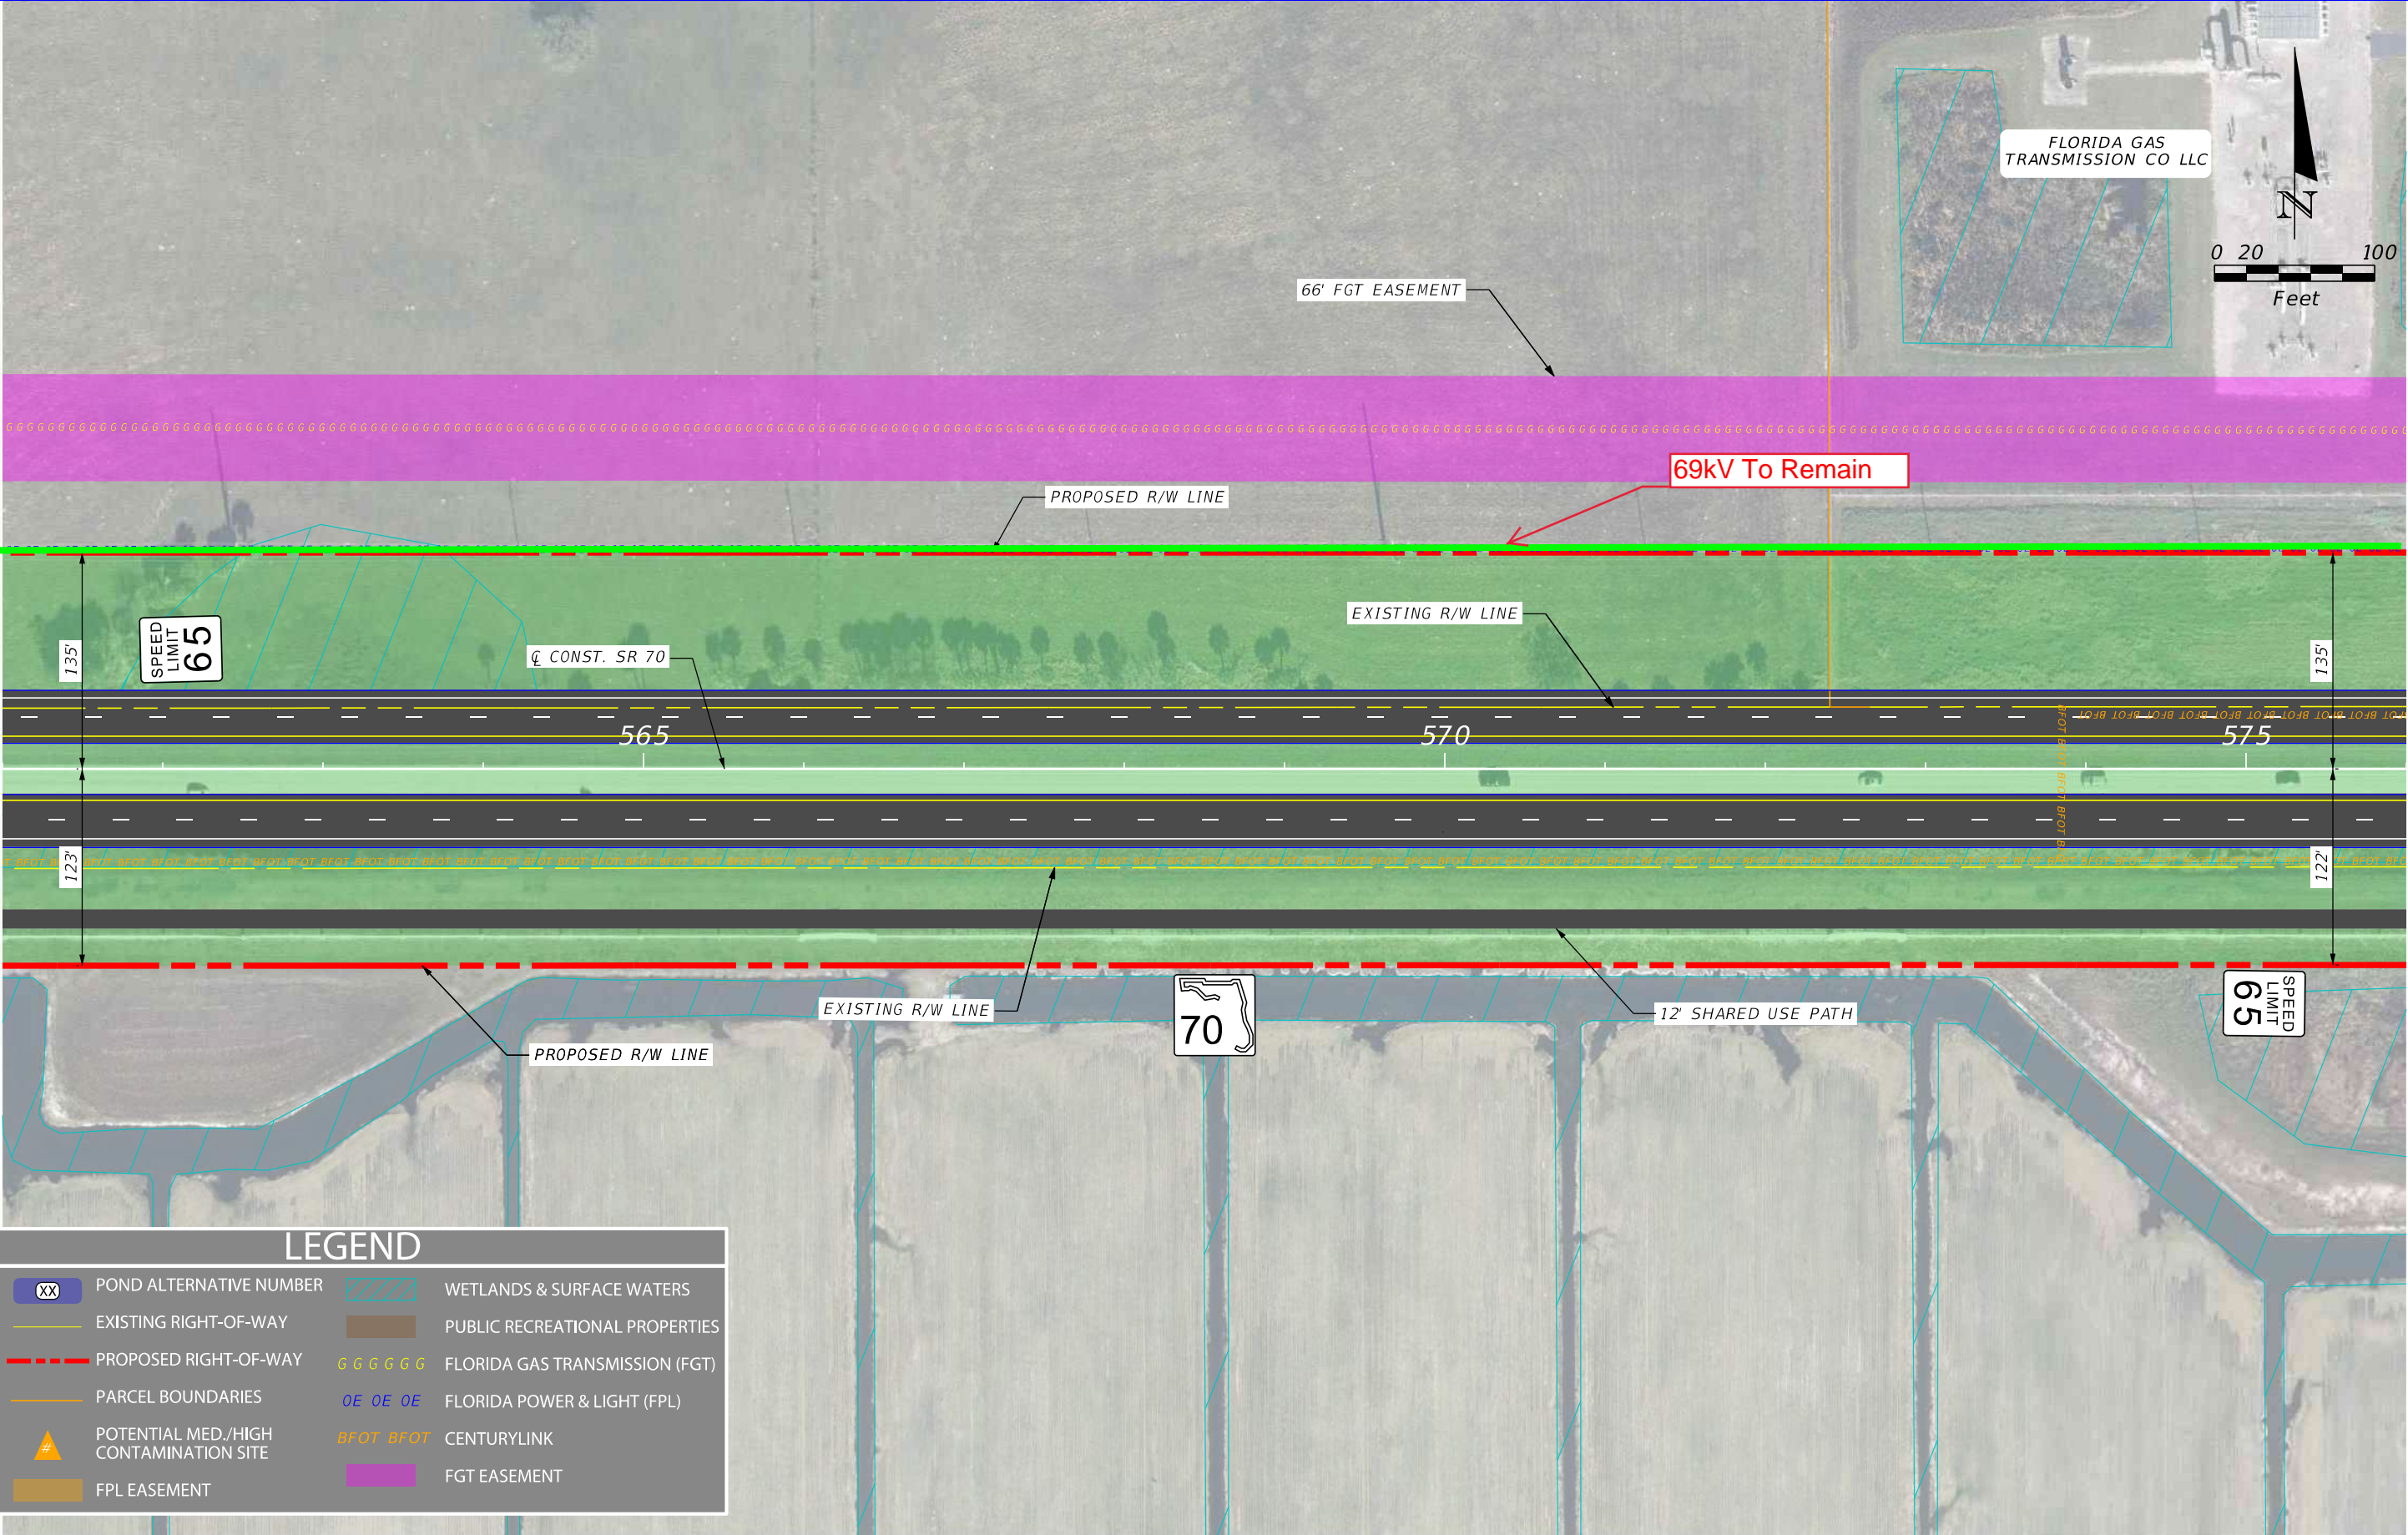

LEGEND

XX

POND ALTERNATIVE NUMBER

EXISTING RIGHT-OF-WAY

PROPOSED RIGHT-OF-WAY

PARCEL BOUNDARIES

POTENTIAL MED./HIGH CONTAMINATION SITE

FPL EASEMENT

WETLANDS & SURFACE WATERS

PUBLIC RECREATIONAL PROPERTIES


FLORIDA GAS TRANSMISSION (FGT)

FLORIDA POWER & LIGHT (FPL)


CENTURYLINK

FGT EASEMENT


REVISIONS				ENGINEER OF RECORD	STATE OF FLORIDA DEPARTMENT OF TRANSPORTATION			ALTERNATIVE 1 CONCEPT PLAN	SHEET NO.
DATE	DESCRIPTION	DATE	DESCRIPTION	NICHOLAS JOHN CLAVELO LICENSE NUMBER: 84366 SCALAR CONSULTING GROUP INC. 5713 CORPORATE WAY, SUITE 200 WEST PALM BEACH, FLORIDA 33407	ROAD NO.	COUNTY	FINANCIAL PROJECT ID		13
					SR 70	HIGHLANDS OKEECHOBEE	450334-1-22-01		

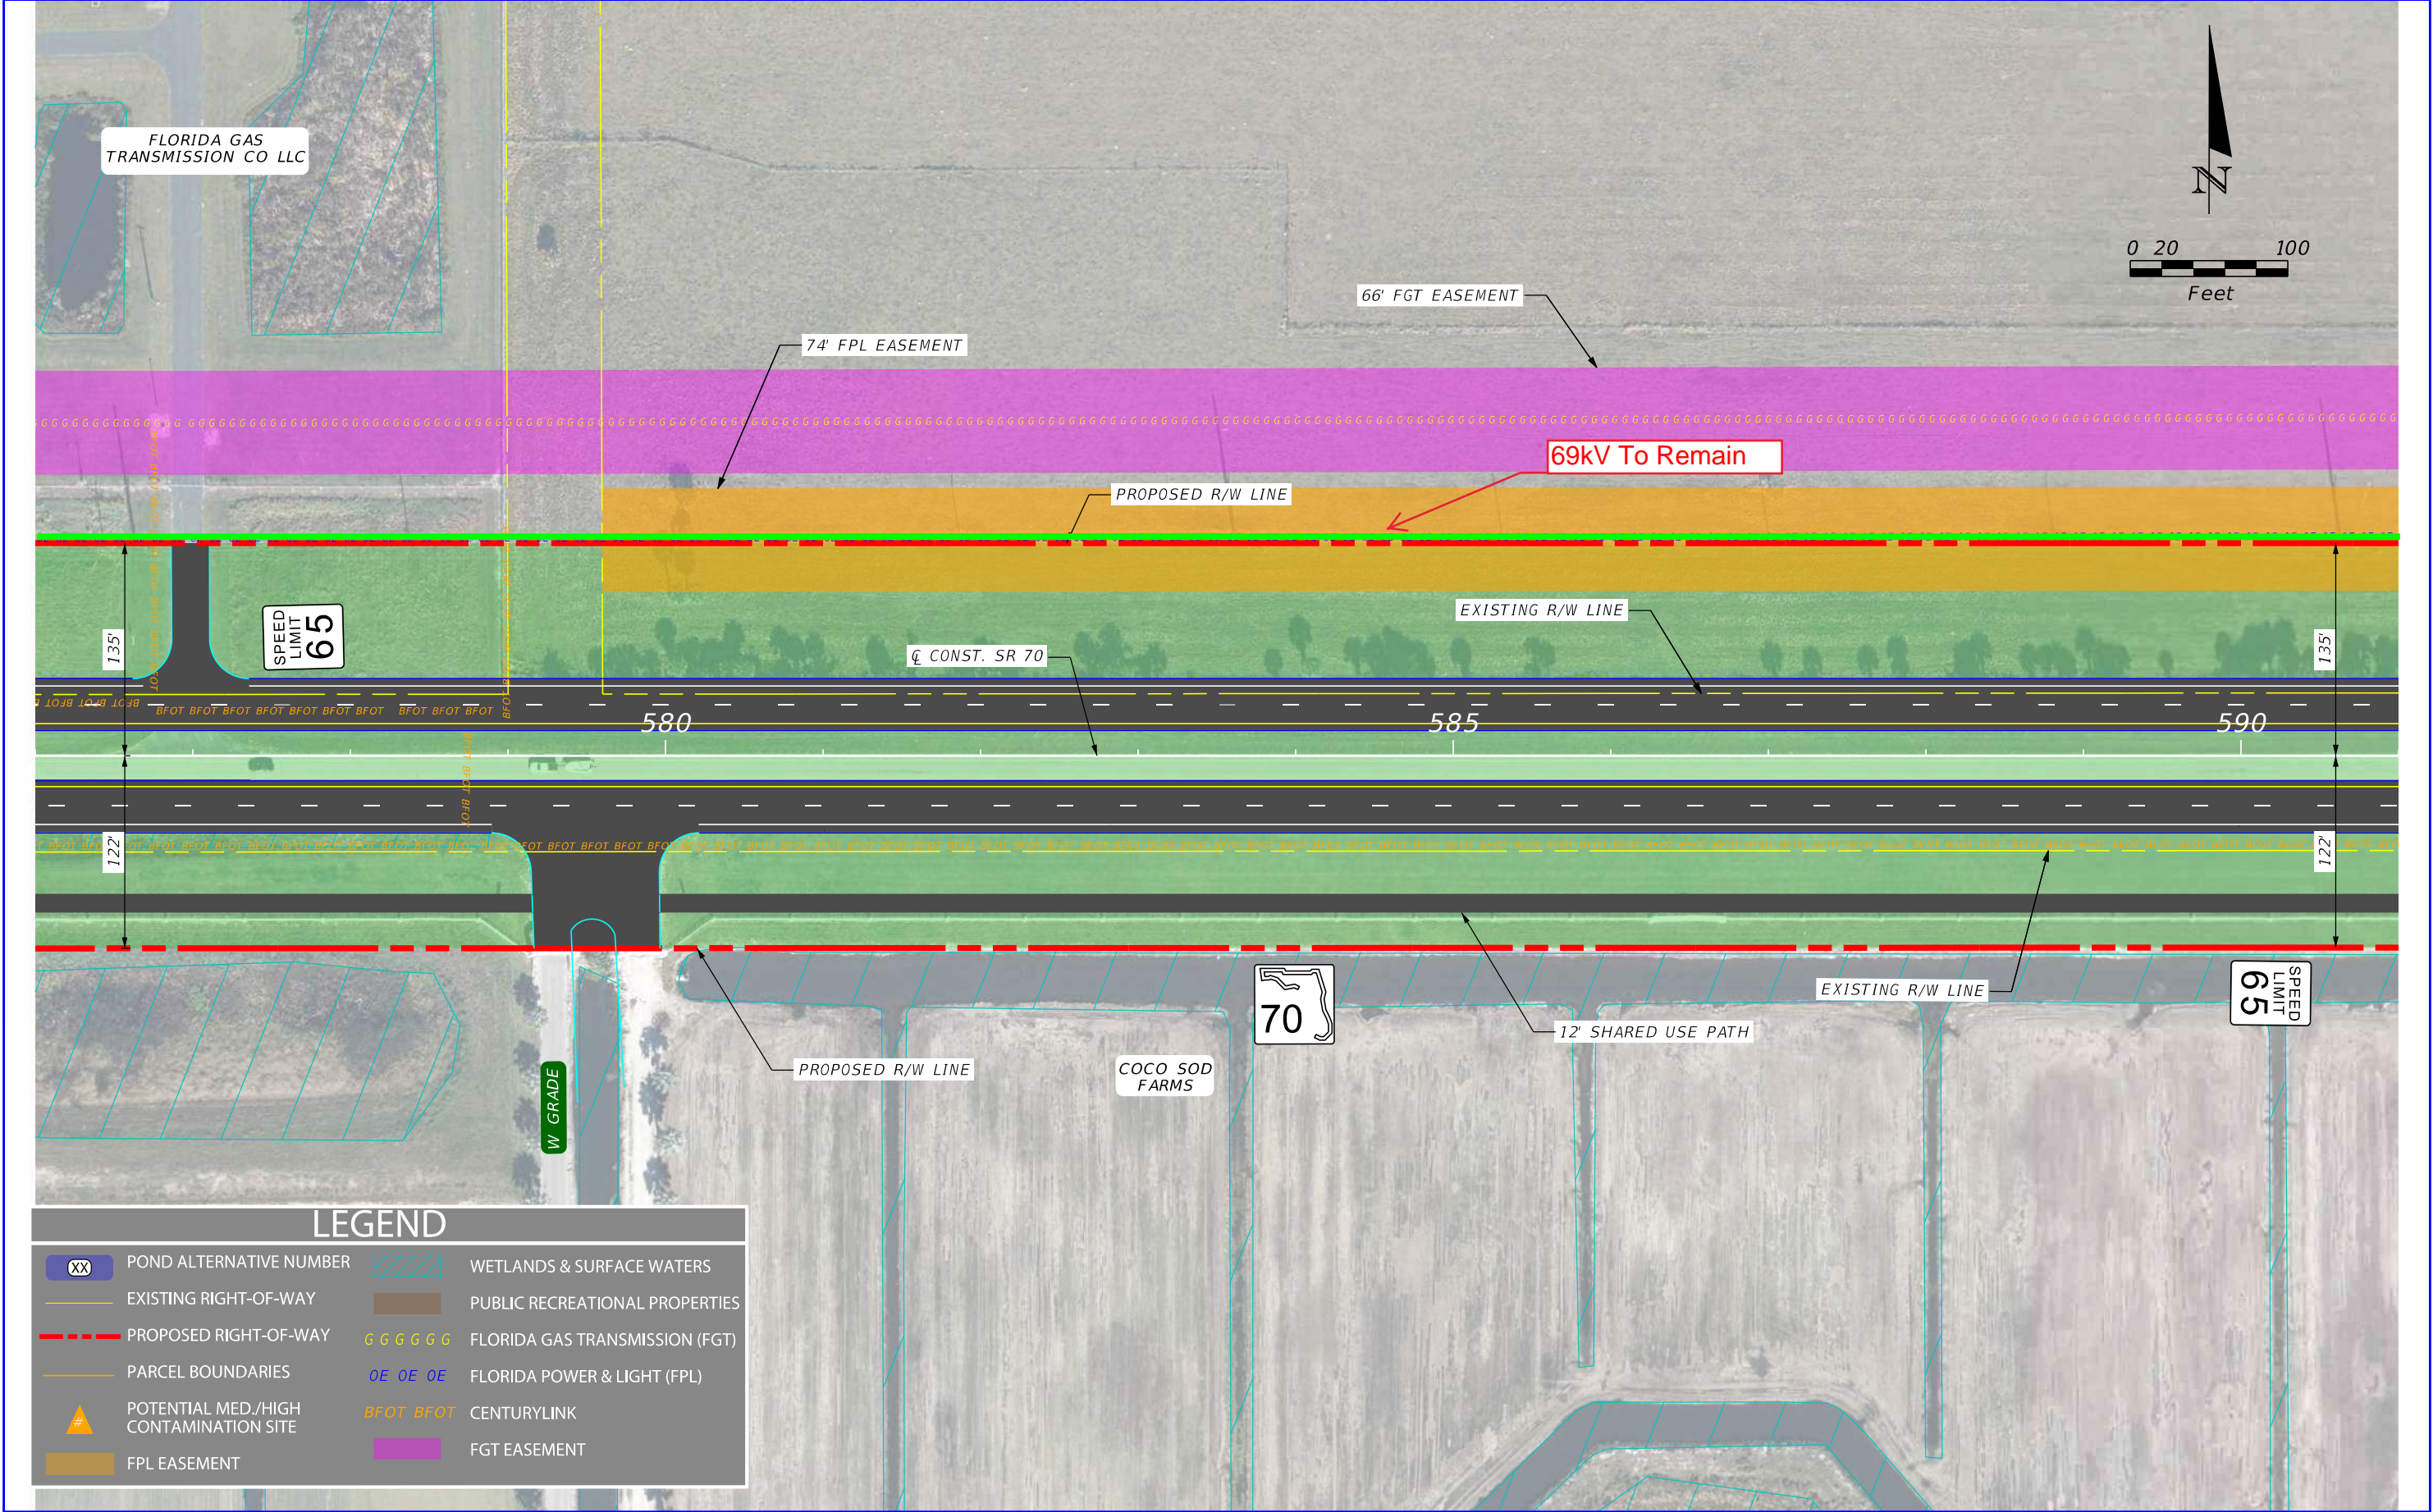

REVISIONS				ENGINEER OF RECORD		STATE OF FLORIDA DEPARTMENT OF TRANSPORTATION		ALTERNATIVE 1 CONCEPT PLAN	SHEET NO. 14
DATE	DESCRIPTION	DATE	DESCRIPTION	NICHOLAS JOHN CLAVELO LICENSE NUMBER: 84366 SCALAR CONSULTING GROUP INC. 5713 CORPORATE WAY, SUITE 200 WEST PALM BEACH, FLORIDA 33407		ROAD NO.	COUNTY		
						SR 70	HIGHLANDS OKEECHOBEE	FINANCIAL PROJECT ID 450334-1-22-01	

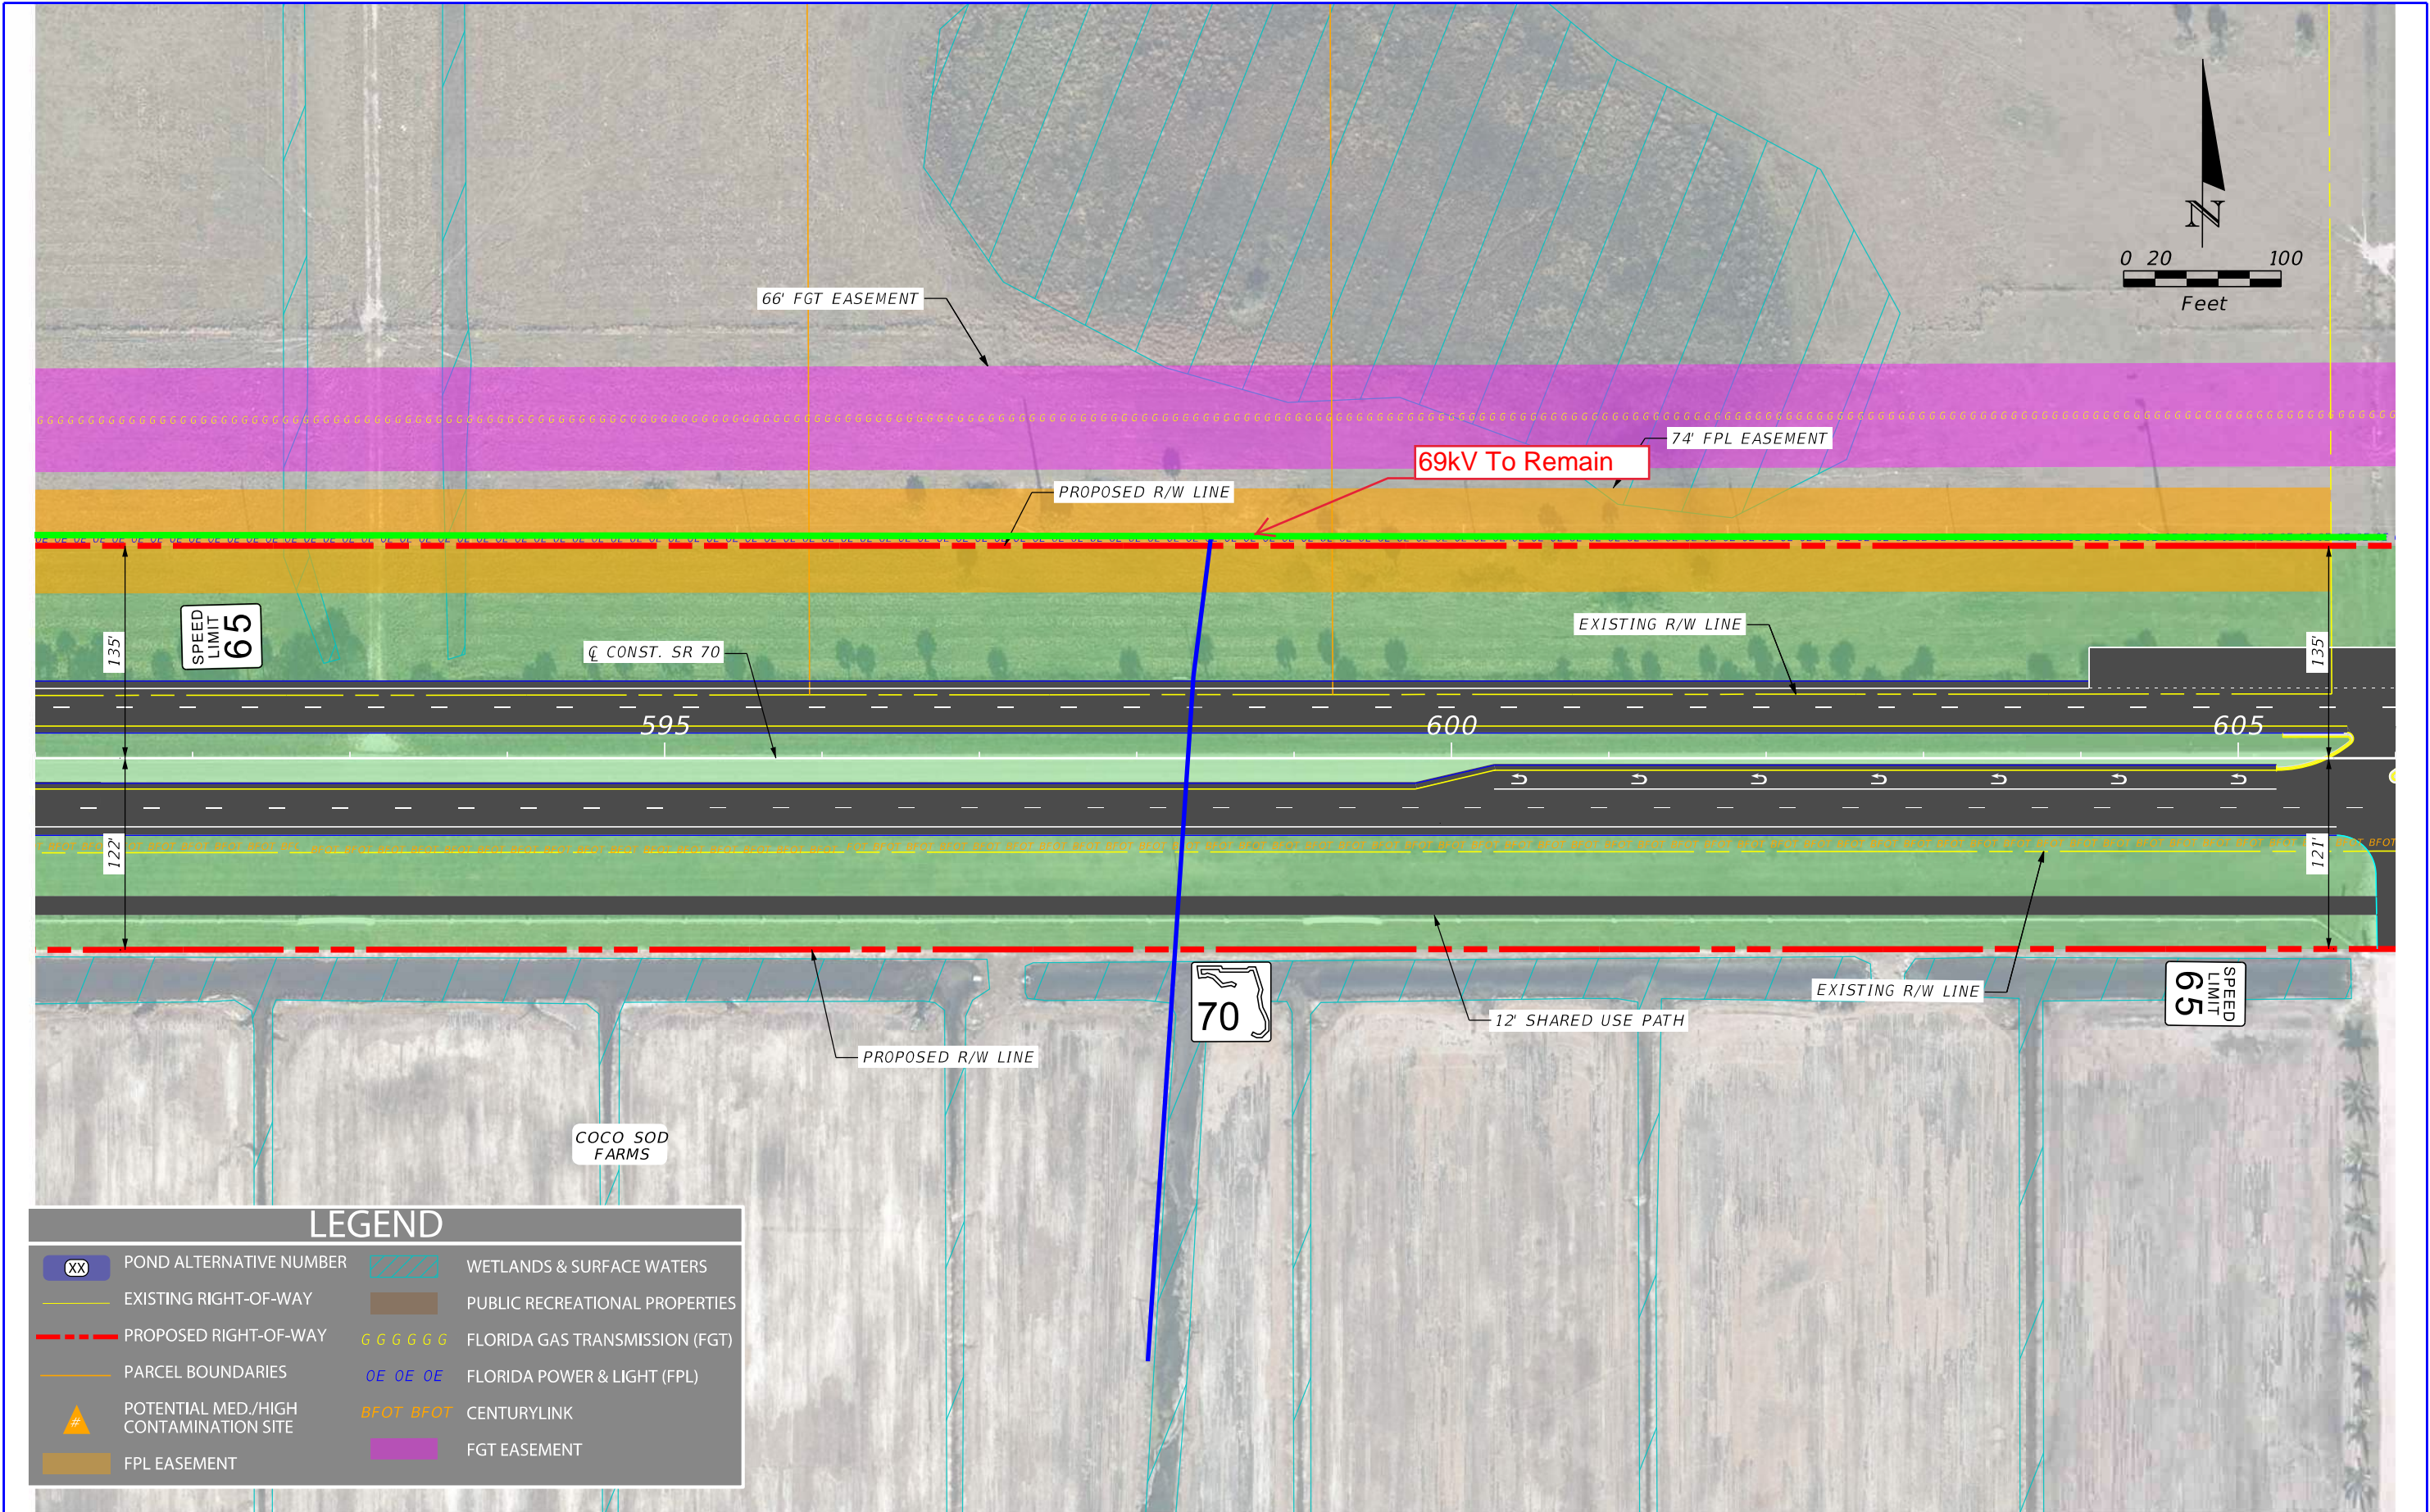

REVISIONS				ENGINEER OF RECORD		STATE OF FLORIDA DEPARTMENT OF TRANSPORTATION		ALTERNATIVE 1 CONCEPT PLAN	SHEET NO. 15
DATE	DESCRIPTION	DATE	DESCRIPTION	NICHOLAS JOHN CLAVELO LICENSE NUMBER: 84366 SCALAR CONSULTING GROUP INC. 5713 CORPORATE WAY, SUITE 200 WEST PALM BEACH, FLORIDA 33407		ROAD NO.	COUNTY		
						SR 70	HIGHLANDS OKEECHOBEE	FINANCIAL PROJECT ID 450334-1-22-01	

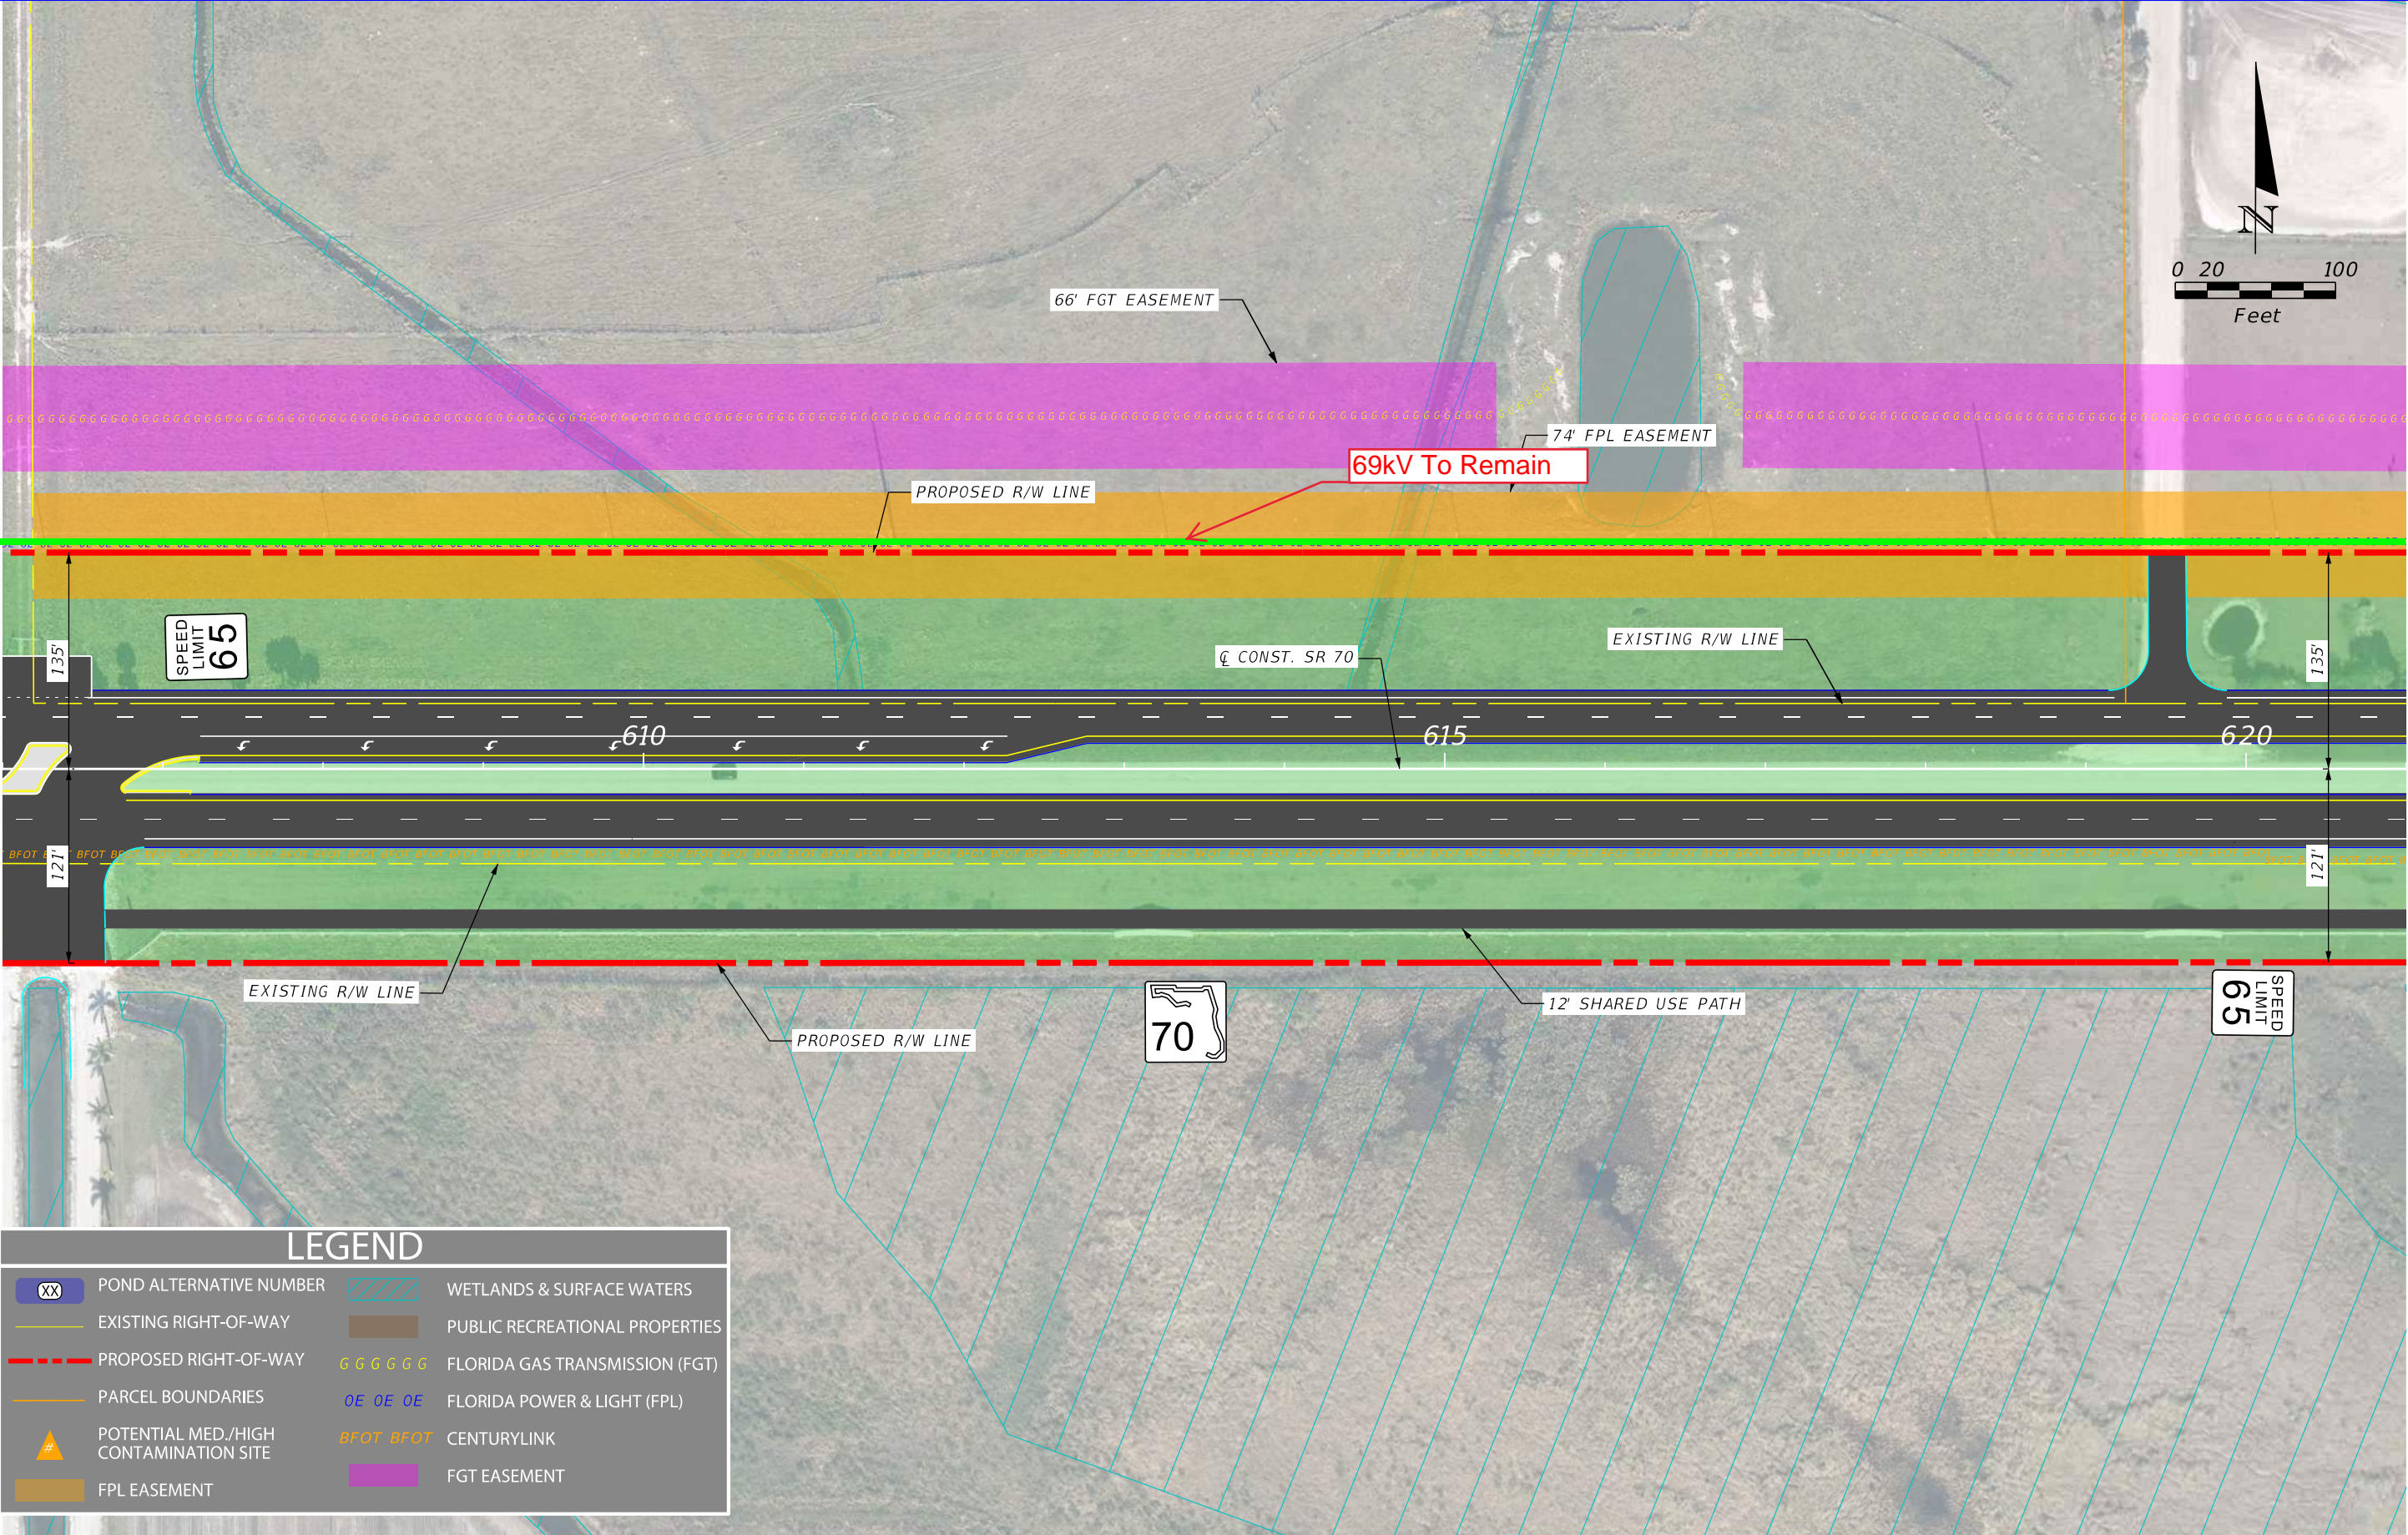

LEGEND

XX

POND ALTERNATIVE NUMBER

EXISTING RIGHT-OF-WAY

PROPOSED RIGHT-OF-WAY

PARCEL BOUNDARIES

#

POTENTIAL MED/HIGH CONTAMINATION SITE

FPL EASEMENT

WETLANDS & SURFACE WATERS

PUBLIC RECREATIONAL PROPERTIES

GGGGGG

FLORIDA GAS TRANSMISSION (FGT)

OE OE OE

FLORIDA POWER & LIGHT (FPL)


BFOT BFOT

CENTURYLINK

FGT EASEMENT

REVISIONS				ENGINEER OF RECORD		STATE OF FLORIDA DEPARTMENT OF TRANSPORTATION		ALTERNATIVE 1 CONCEPT PLAN	SHEET NO.
DATE	DESCRIPTION	DATE	DESCRIPTION	NICHOLAS JOHN CLAVELO LICENSE NUMBER: 84366 SCALAR CONSULTING GROUP INC. 5713 CORPORATE WAY, SUITE 200 WEST PALM BEACH, FLORIDA 33407		ROAD NO.	COUNTY		
						SR 70	HIGHLANDS OKEECHOBEE	FINANCIAL PROJECT ID 450334-1-22-01	16

P:\FL23010.00 SR 70 PD&E Study\45033412201\roadway\PLANRD01.dgn : CL11 - PLAN 16 [SHEET]
USER: areginato 11/27/2024 4:57:43 PM

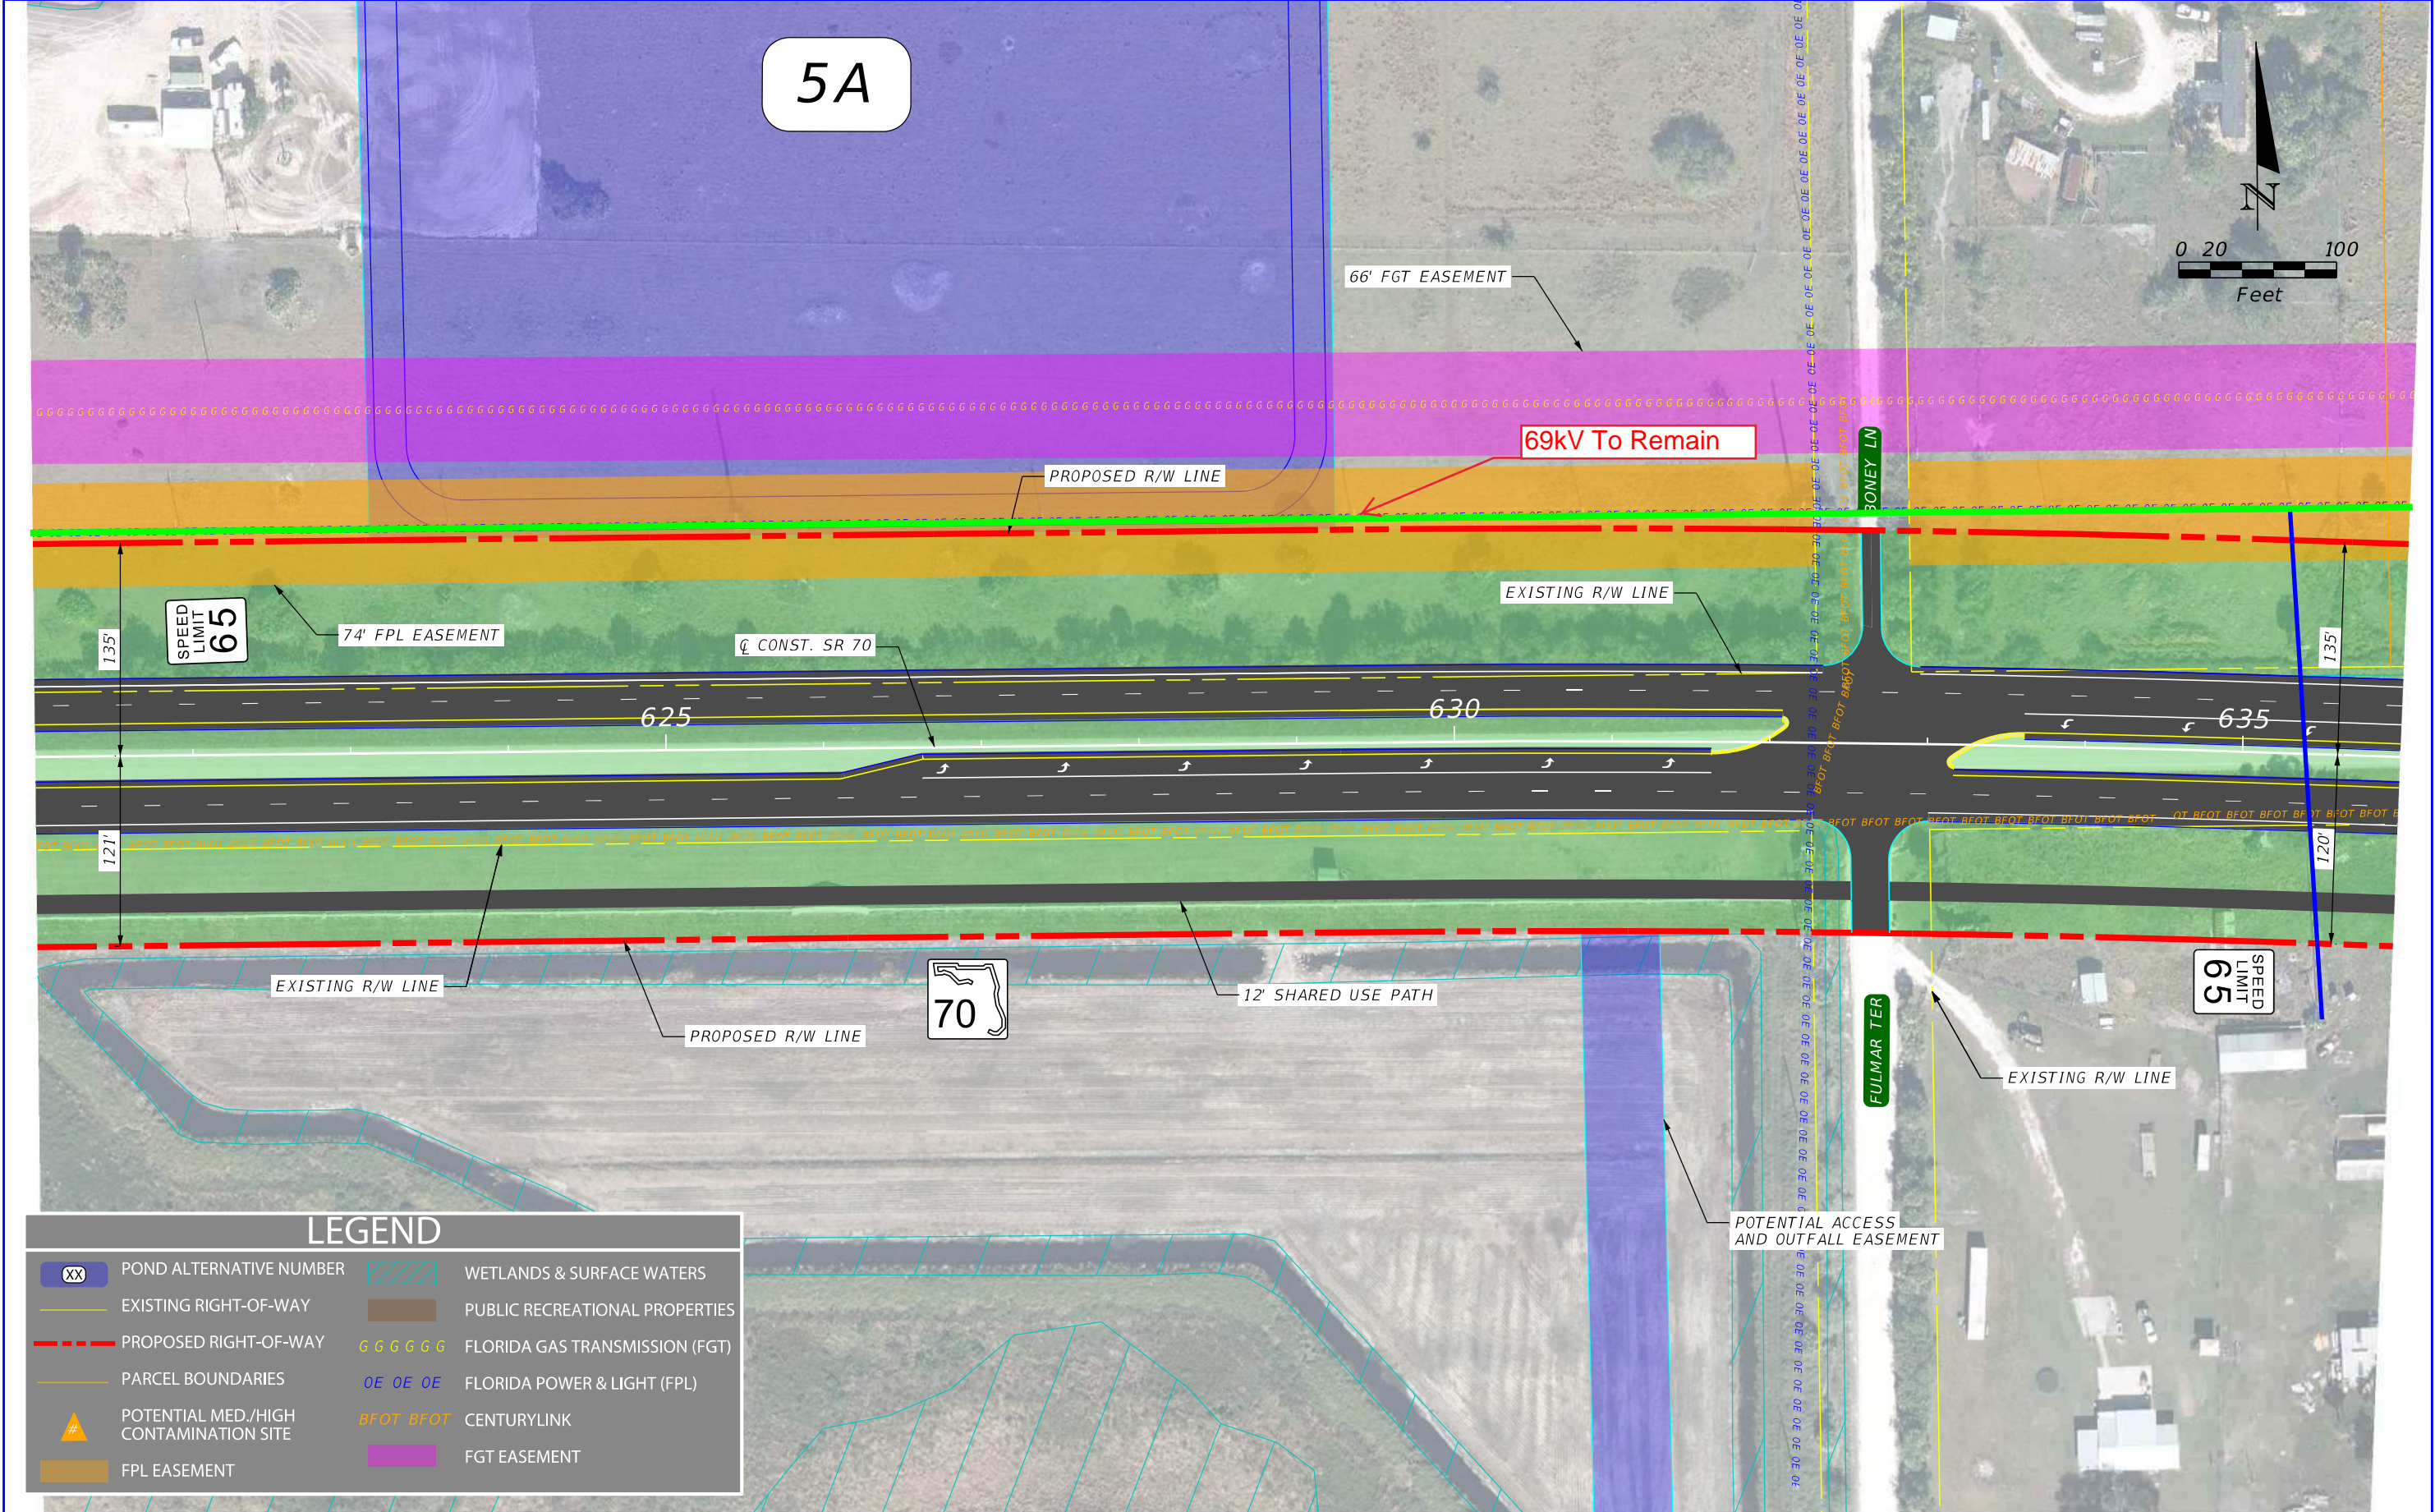

LEGEND

XX

POND ALTERNATIVE NUMBER

EXISTING RIGHT-OF-WAY

PROPOSED RIGHT-OF-WAY

PARCEL BOUNDARIES

#

POTENTIAL MED./HIGH CONTAMINATION SITE

FPL EASEMENT

WETLANDS & SURFACE WATERS

PUBLIC RECREATIONAL PROPERTIES

GGGGG

FLORIDA GAS TRANSMISSION (FGT)

OE OE OE


FLORIDA POWER & LIGHT (FPL)

BFOT BFOT

CENTURYLINK

FGT EASEMENT

REVISIONS				ENGINEER OF RECORD		STATE OF FLORIDA DEPARTMENT OF TRANSPORTATION		ALTERNATIVE 1 CONCEPT PLAN	SHEET NO. 17
DATE	DESCRIPTION	DATE	DESCRIPTION	NICHOLAS JOHN CLAVELO LICENSE NUMBER: 84366 SCALAR CONSULTING GROUP INC. 5713 CORPORATE WAY, SUITE 200 WEST PALM BEACH, FLORIDA 33407		ROAD NO.	COUNTY		
						SR 70	HIGHLANDS OKEECHOBEE	FINANCIAL PROJECT ID 450334-1-22-01	

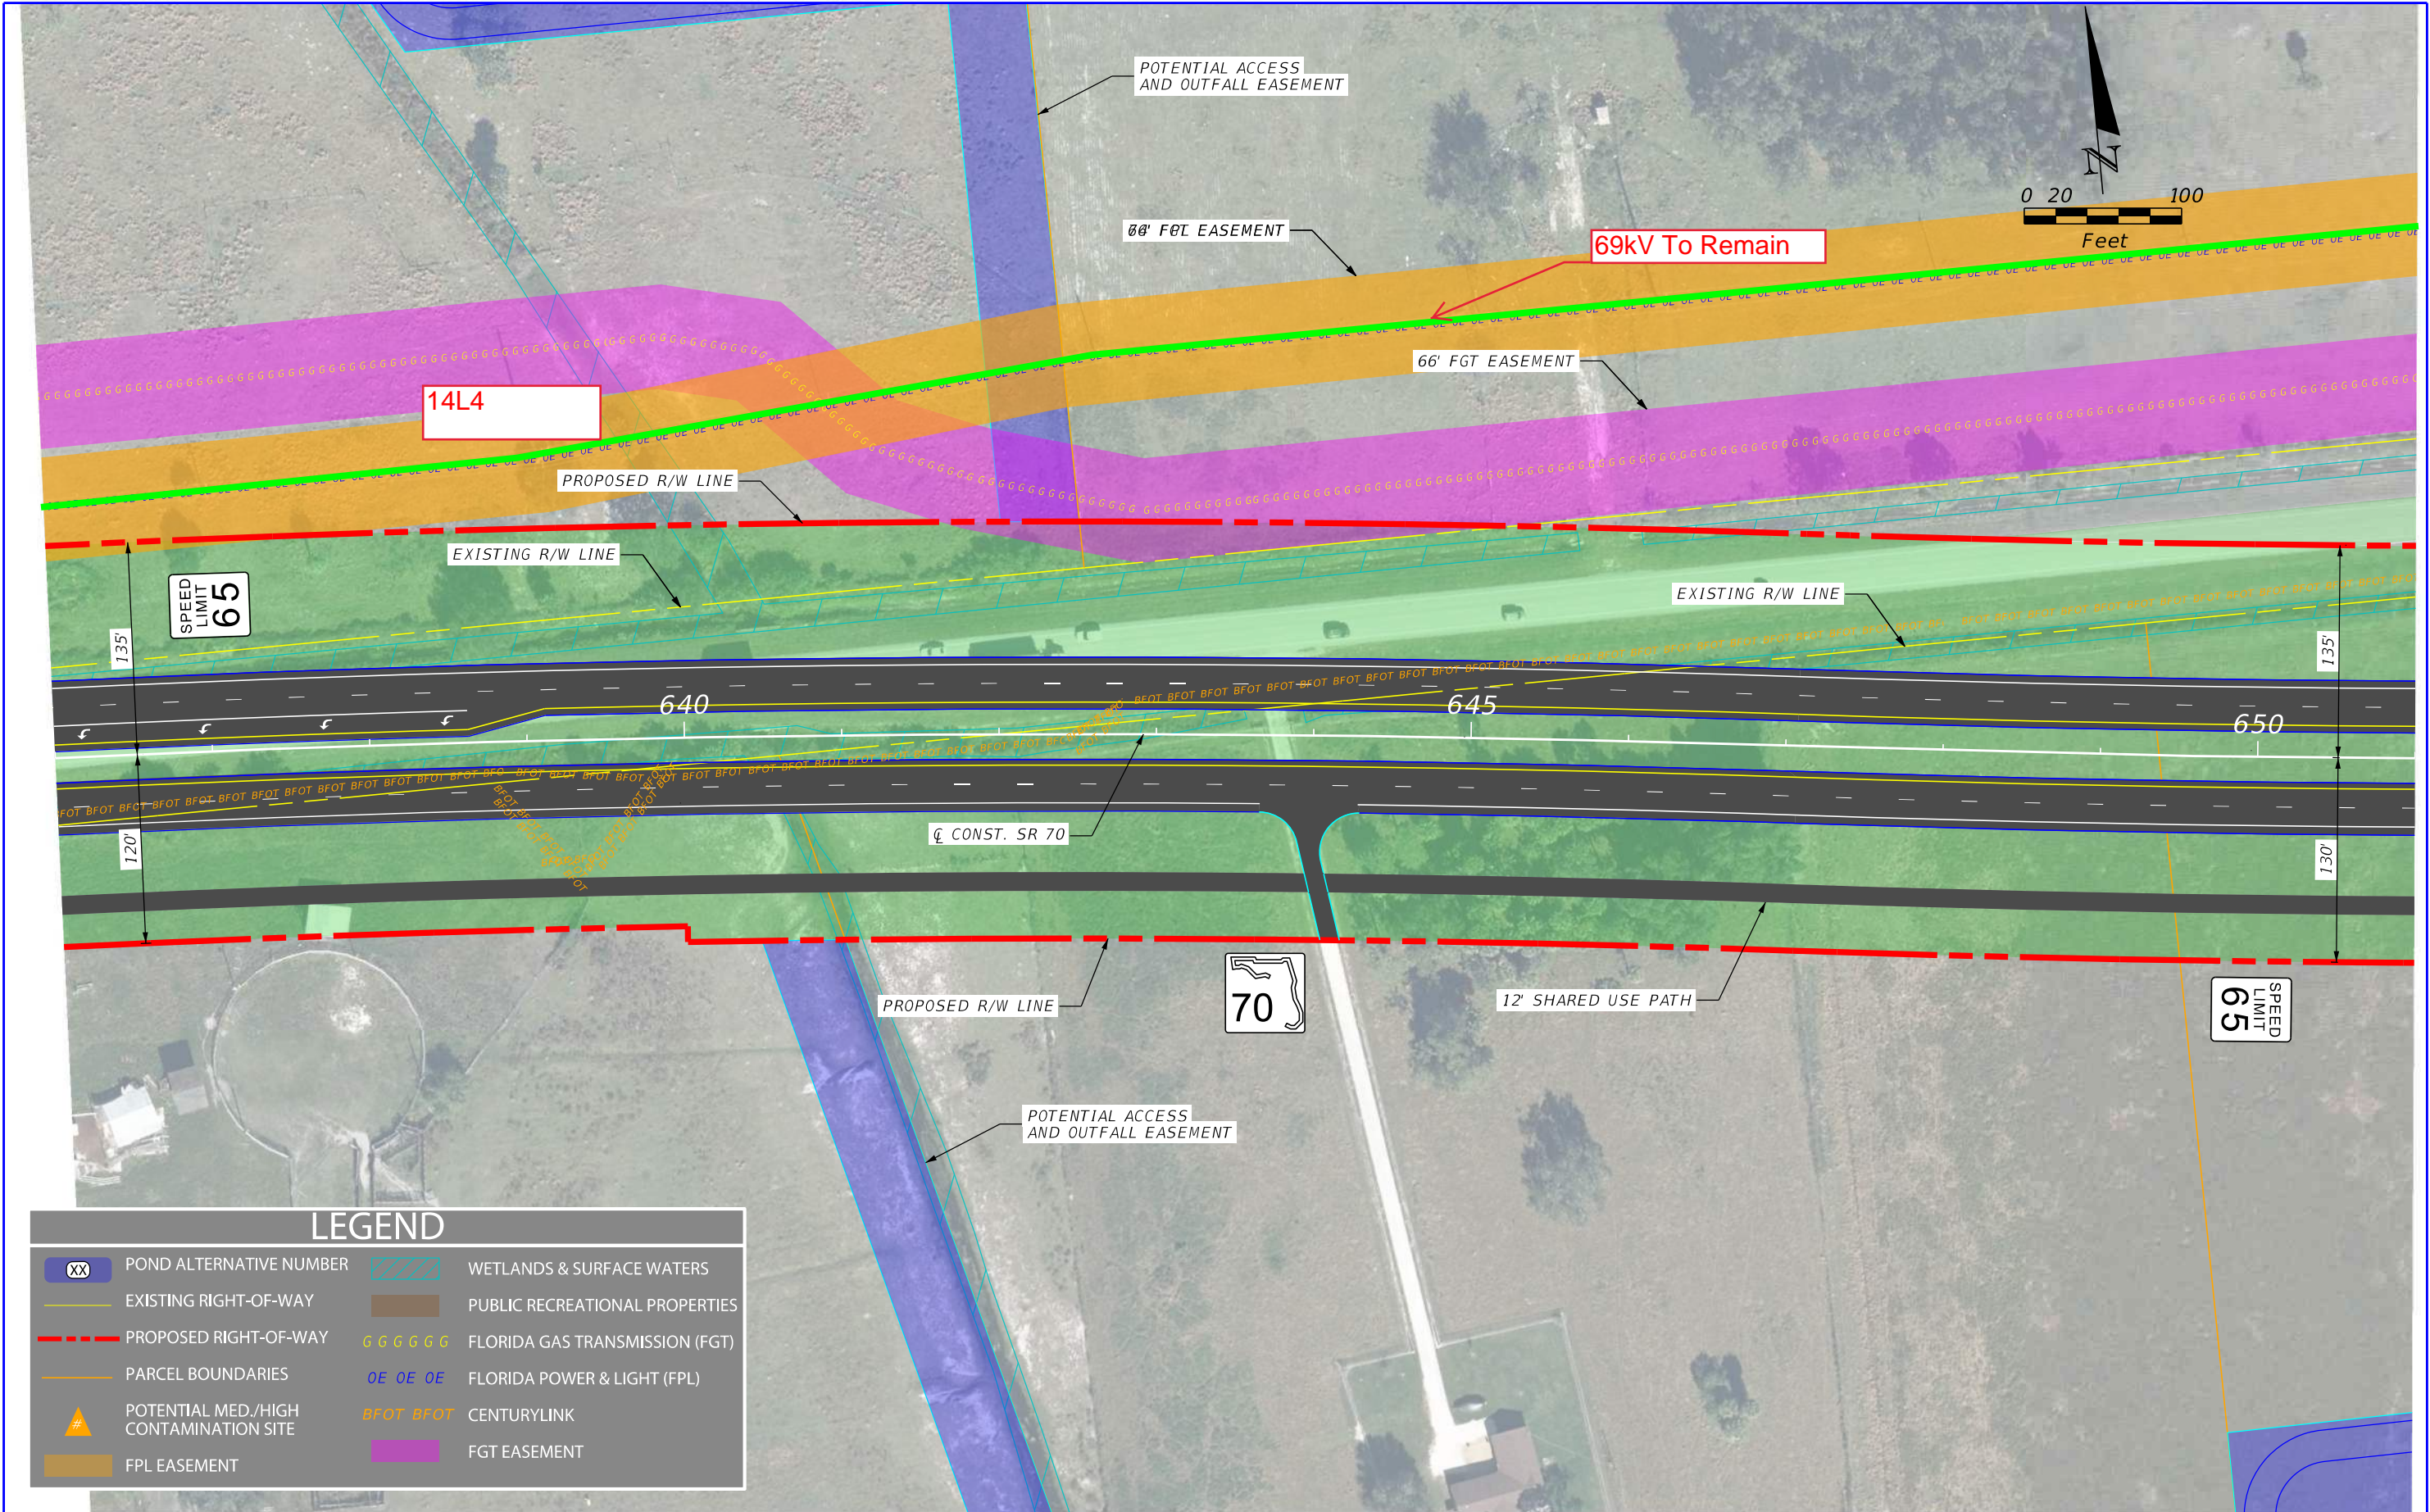

LEGEND

XX

POND ALTERNATIVE NUMBER

EXISTING RIGHT-OF-WAY

PROPOSED RIGHT-OF-WAY

PARCEL BOUNDARIES

#

POTENTIAL MED./HIGH CONTAMINATION SITE

FPL EASEMENT

WETLANDS & SURFACE WATERS

PUBLIC RECREATIONAL PROPERTIES

GGGGGG

FLORIDA GAS TRANSMISSION (FGT)

OE OE OE


FLORIDA POWER & LIGHT (FPL)

BFOT BFOT


CENTURYLINK

FGT EASEMENT

REVISIONS				ENGINEER OF RECORD		STATE OF FLORIDA DEPARTMENT OF TRANSPORTATION		ALTERNATIVE 1 CONCEPT PLAN	SHEET NO. 18
DATE	DESCRIPTION	DATE	DESCRIPTION	NICHOLAS JOHN CLAVELLO LICENSE NUMBER: 84366 SCALAR CONSULTING GROUP INC. 5713 CORPORATE WAY, SUITE 200 WEST PALM BEACH, FLORIDA 33407		ROAD NO.	COUNTY		
						SR 70	HIGHLANDS OKEECHOBEE	FINANCIAL PROJECT ID 450334-1-22-01	

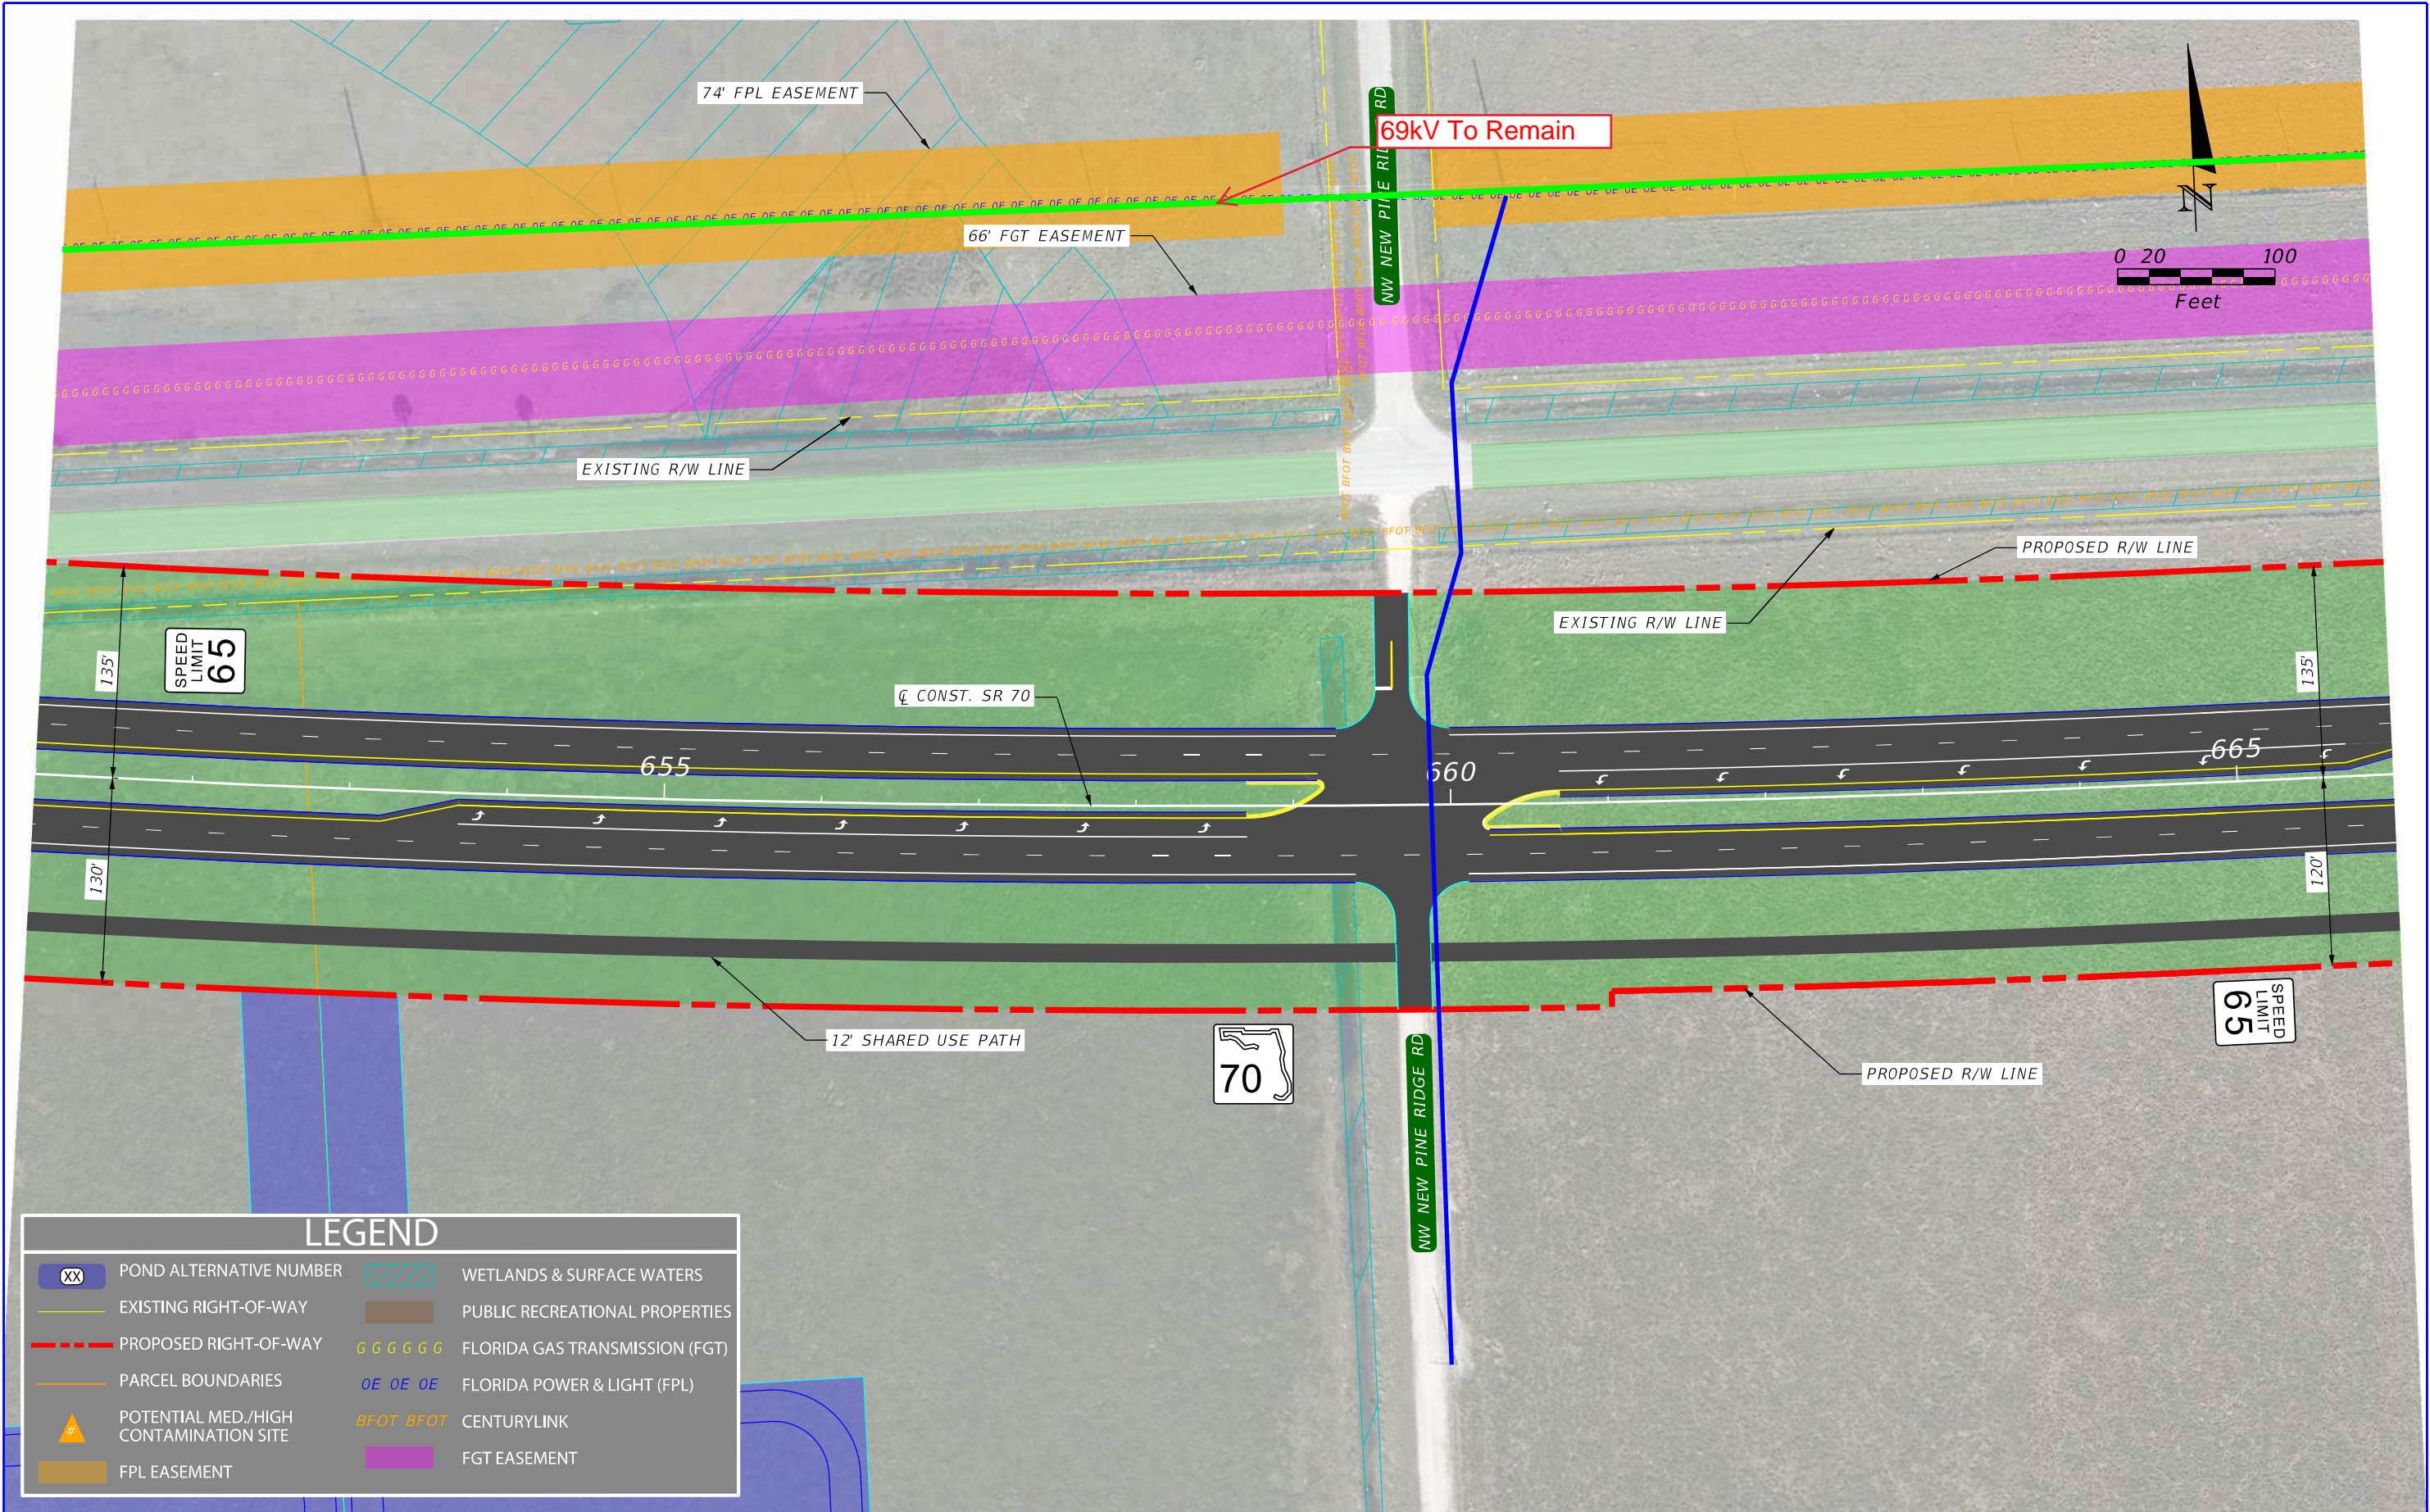

REVISIONS				ENGINEER OF RECORD		STATE OF FLORIDA DEPARTMENT OF TRANSPORTATION		SHEET NO.
DATE	DESCRIPTION	DATE	DESCRIPTION	NICHOLAS JOHN CLAVELO LICENSE NUMBER: 84366 SCALAR CONSULTING GROUP INC. 5713 CORPORATE WAY, SUITE 200 WEST PALM BEACH, FLORIDA 33407		ROAD NO.	COUNTY	
						SR 70	HIGHLANDS OKEECHOBEE	
							FINANCIAL PROJECT ID 450334-1-22-01	19

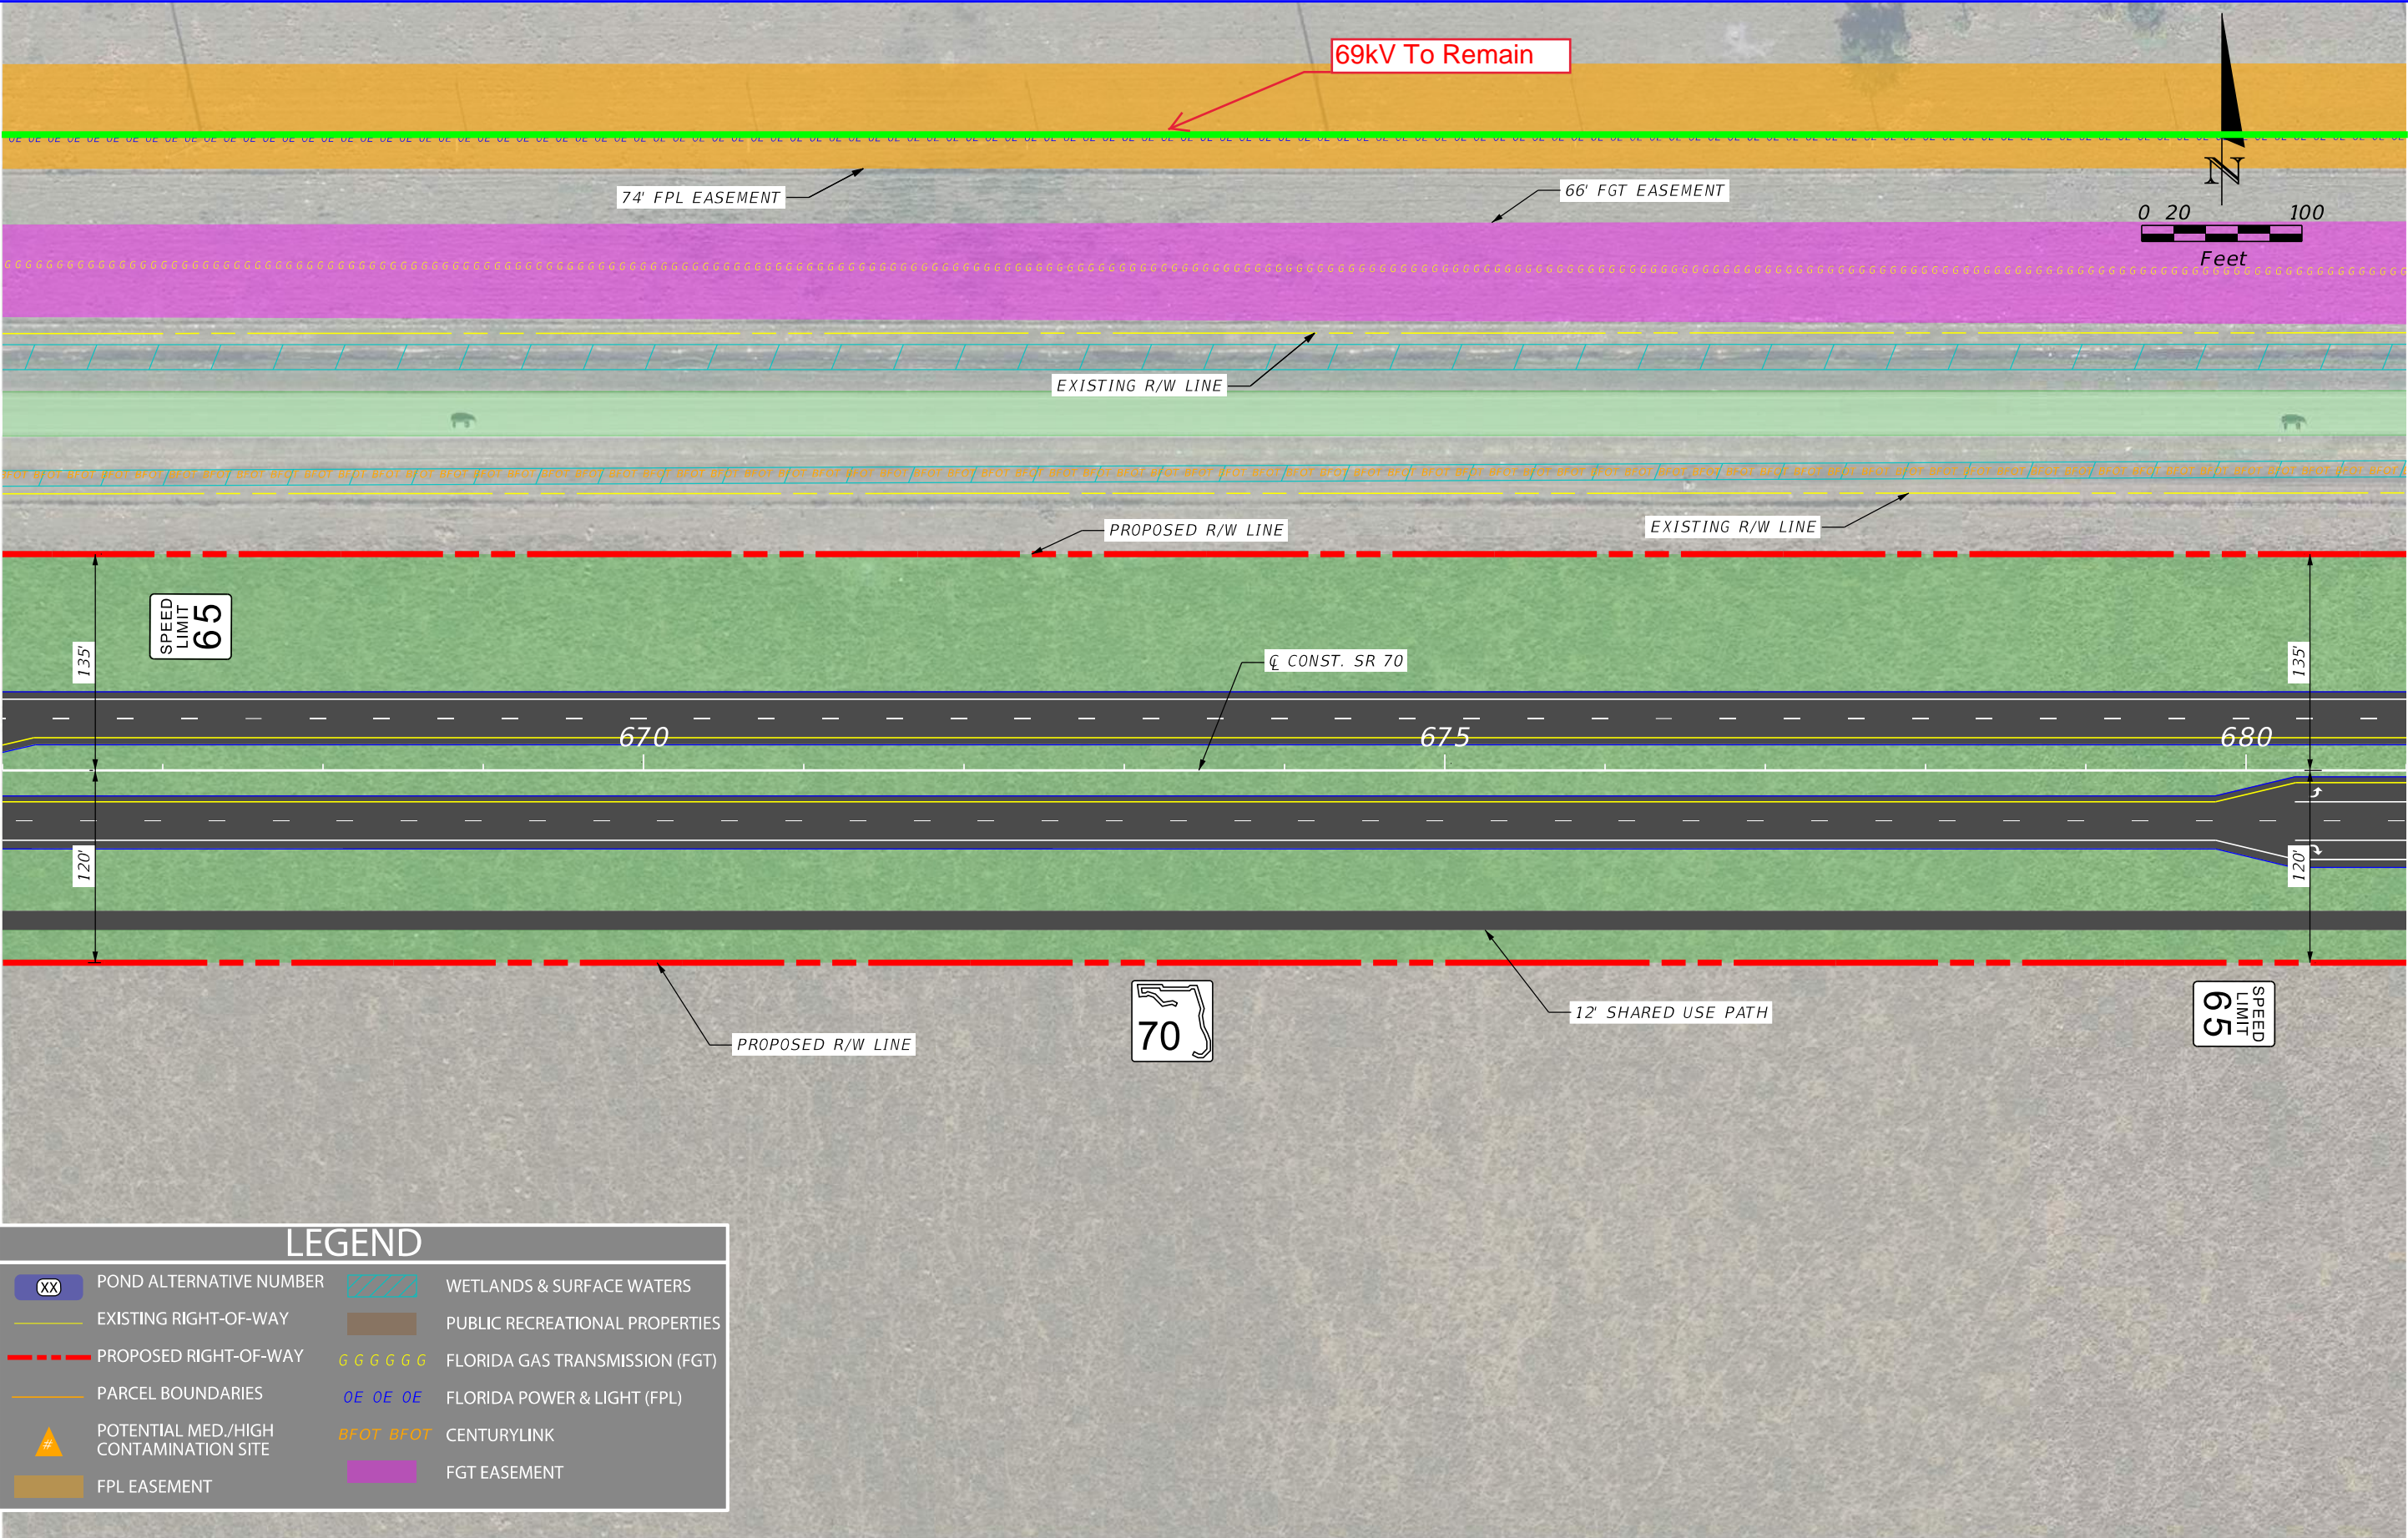

LEGEND

XX

POND ALTERNATIVE NUMBER

EXISTING RIGHT-OF-WAY

PROPOSED RIGHT-OF-WAY

PARCEL BOUNDARIES

#

POTENTIAL MED./HIGH CONTAMINATION SITE

FPL EASEMENT

WETLANDS & SURFACE WATERS

PUBLIC RECREATIONAL PROPERTIES

GGGGGG

FLORIDA GAS TRANSMISSION (FGT)

OE OE OE

FLORIDA POWER & LIGHT (FPL)


BFOT BFOT

CENTURYLINK


FGT EASEMENT

REVISIONS				ENGINEER OF RECORD			STATE OF FLORIDA DEPARTMENT OF TRANSPORTATION			ALTERNATIVE 1 CONCEPT PLAN	SHEET NO.
DATE	DESCRIPTION	DATE	DESCRIPTION	NICHOLAS JOHN CLAVELO LICENSE NUMBER: 84366 SCALAR CONSULTING GROUP INC. 5713 CORPORATE WAY, SUITE 200 WEST PALM BEACH, FLORIDA 33407			ROAD NO.	COUNTY	FINANCIAL PROJECT ID		
							SR 70	HIGHLANDS OKEECHOBEE	450334-1-22-01		


P:\FL23010.00 SR 70 PD&E Study\45033412201\roadway\PLANRD01.dgn : CL11 - PLAN 20 [SHEET]
USER: areginato 11/27/2024 4:58:05 PM

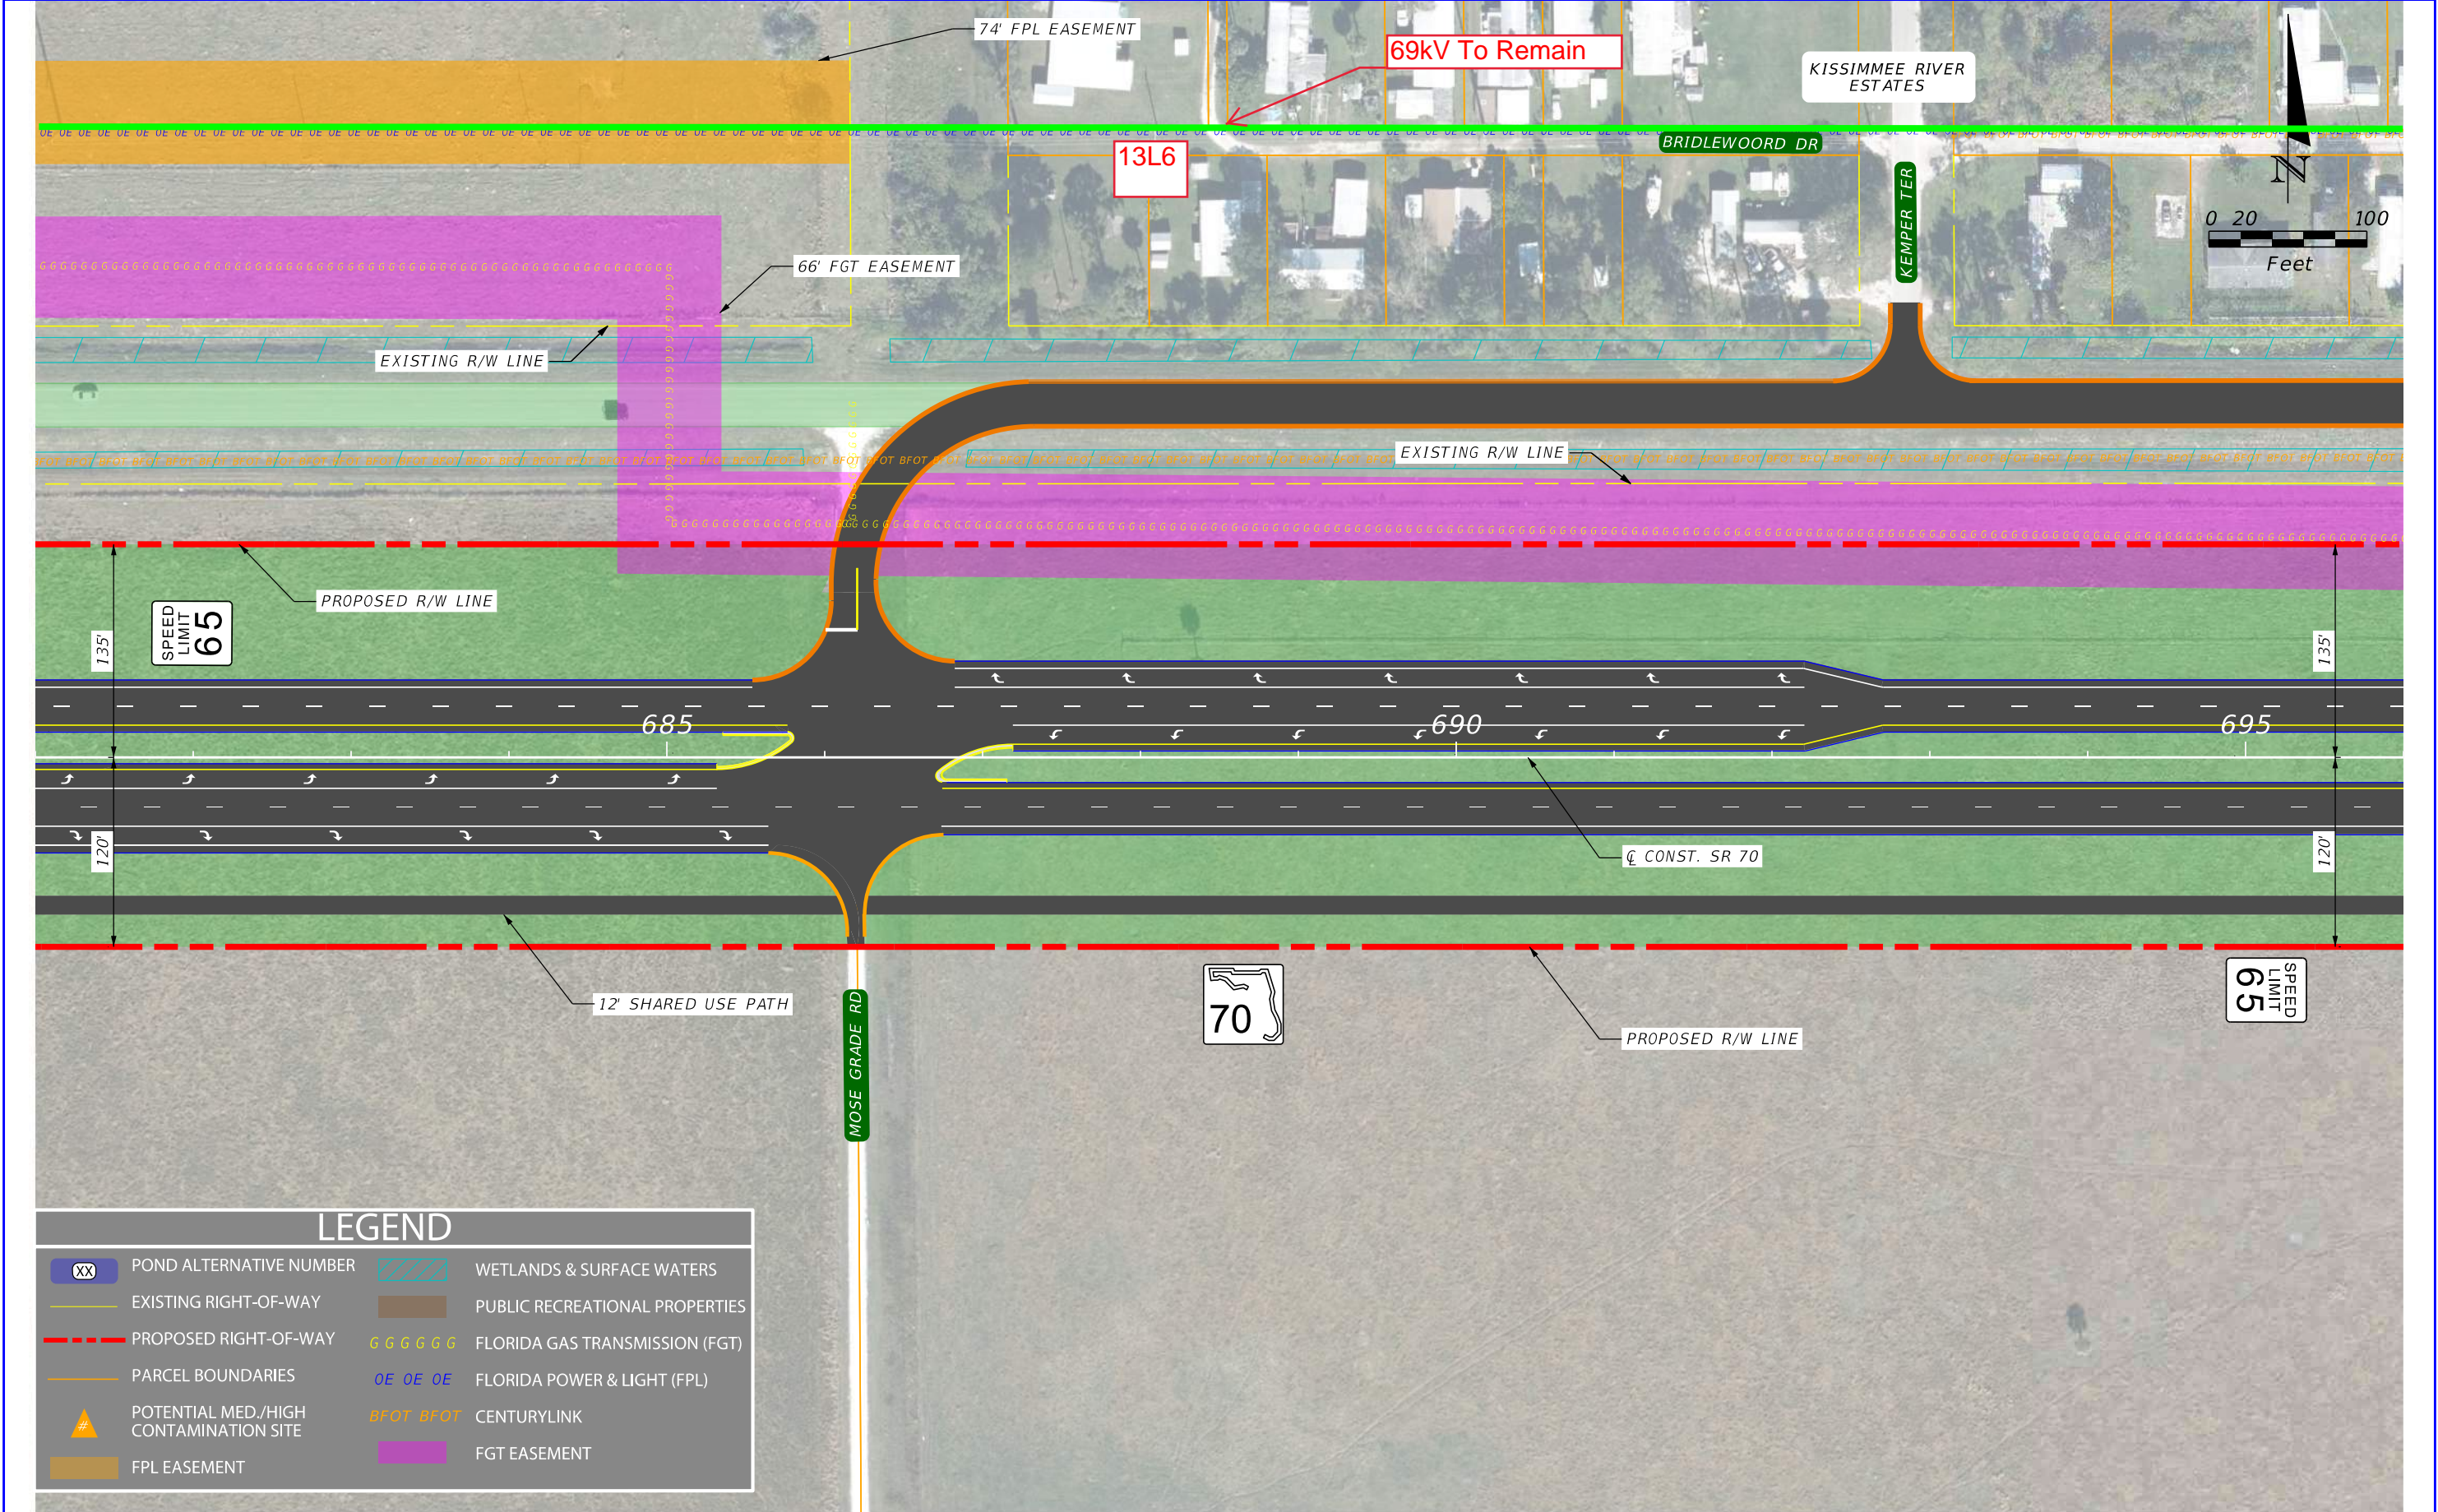


REVISIONS				ENGINEER OF RECORD		STATE OF FLORIDA DEPARTMENT OF TRANSPORTATION		ALTERNATIVE 1 CONCEPT PLAN	SHEET NO.
DATE	DESCRIPTION	DATE	DESCRIPTION	NICHOLAS JOHN CLAVELO LICENSE NUMBER: 84366 SCALAR CONSULTING GROUP INC. 5713 CORPORATE WAY, SUITE 200 WEST PALM BEACH, FLORIDA 33407		ROAD NO.	COUNTY		
						SR 70	HIGHLANDS OKEECHOBEE	FINANCIAL PROJECT ID 450334-1-22-01	21

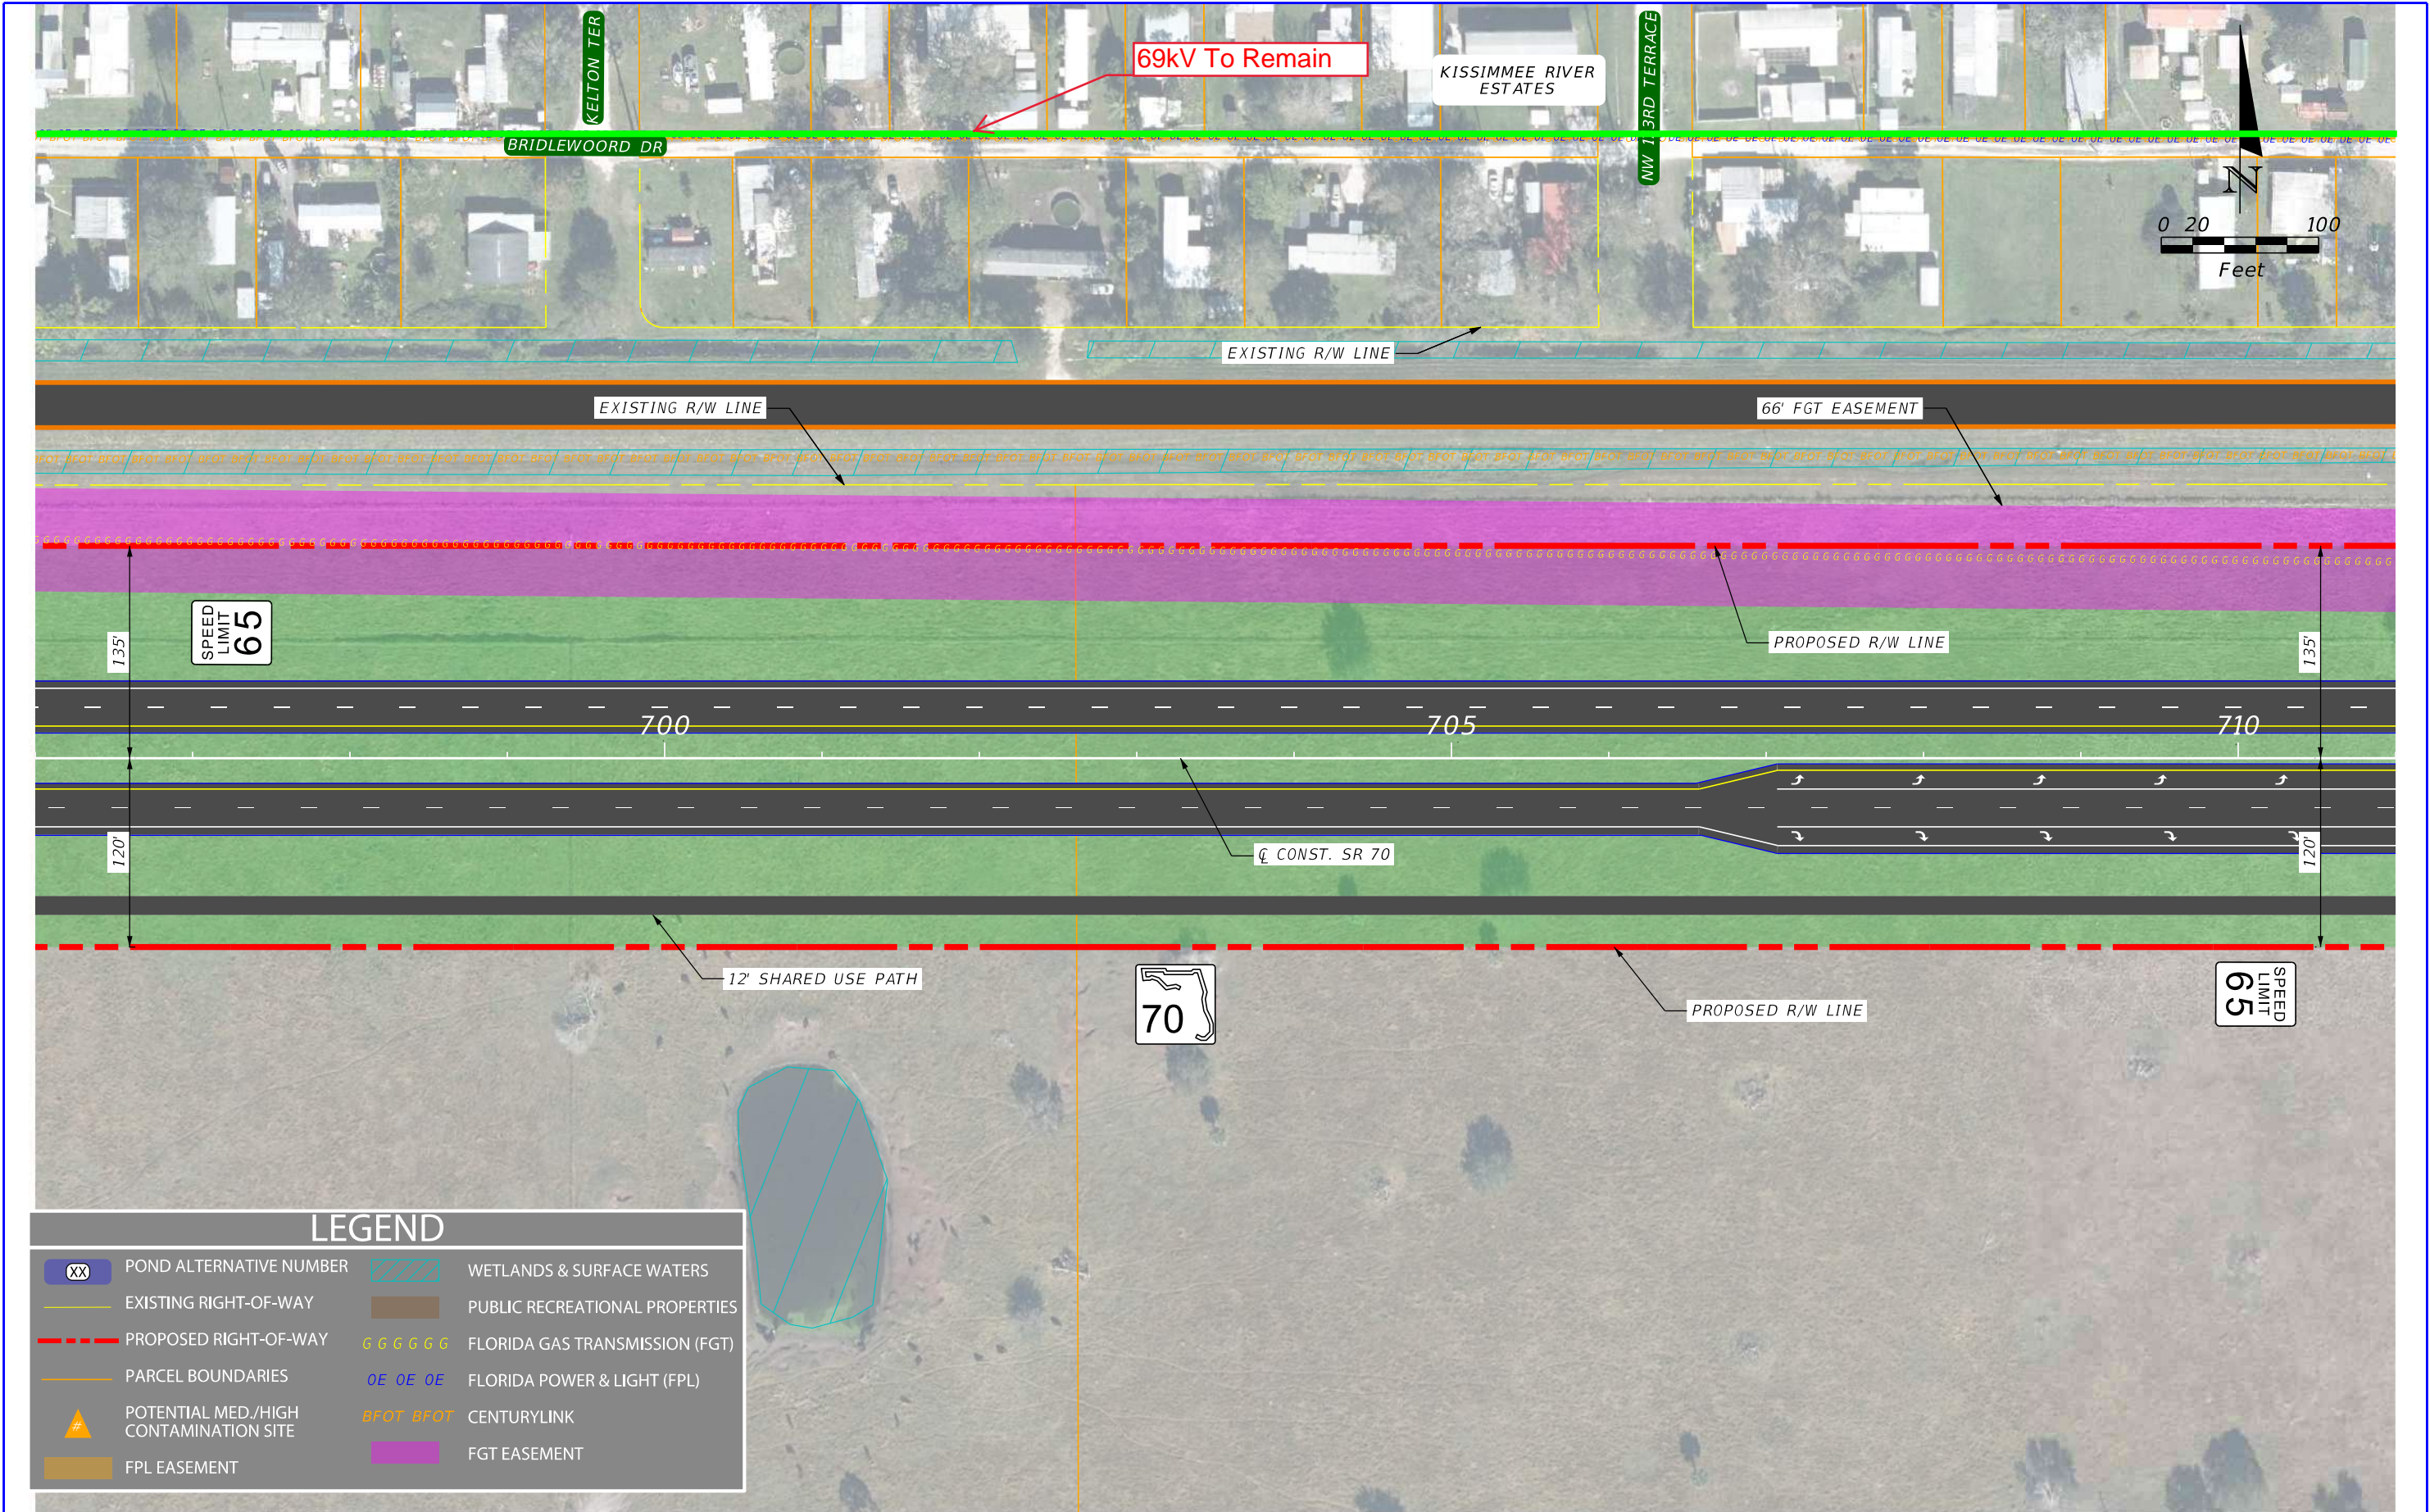


REVISIONS				ENGINEER OF RECORD		STATE OF FLORIDA DEPARTMENT OF TRANSPORTATION		ALTERNATIVE 1 CONCEPT PLAN	SHEET NO.
DATE	DESCRIPTION	DATE	DESCRIPTION	NICHOLAS JOHN CLAVELLO LICENSE NUMBER: 84366 SCALAR CONSULTING GROUP INC. 5713 CORPORATE WAY, SUITE 200 WEST PALM BEACH, FLORIDA 33407		ROAD NO.	COUNTY		
						SR 70	HIGHLANDS OKEECHOBEE	FINANCIAL PROJECT ID 450334-1-22-01	22

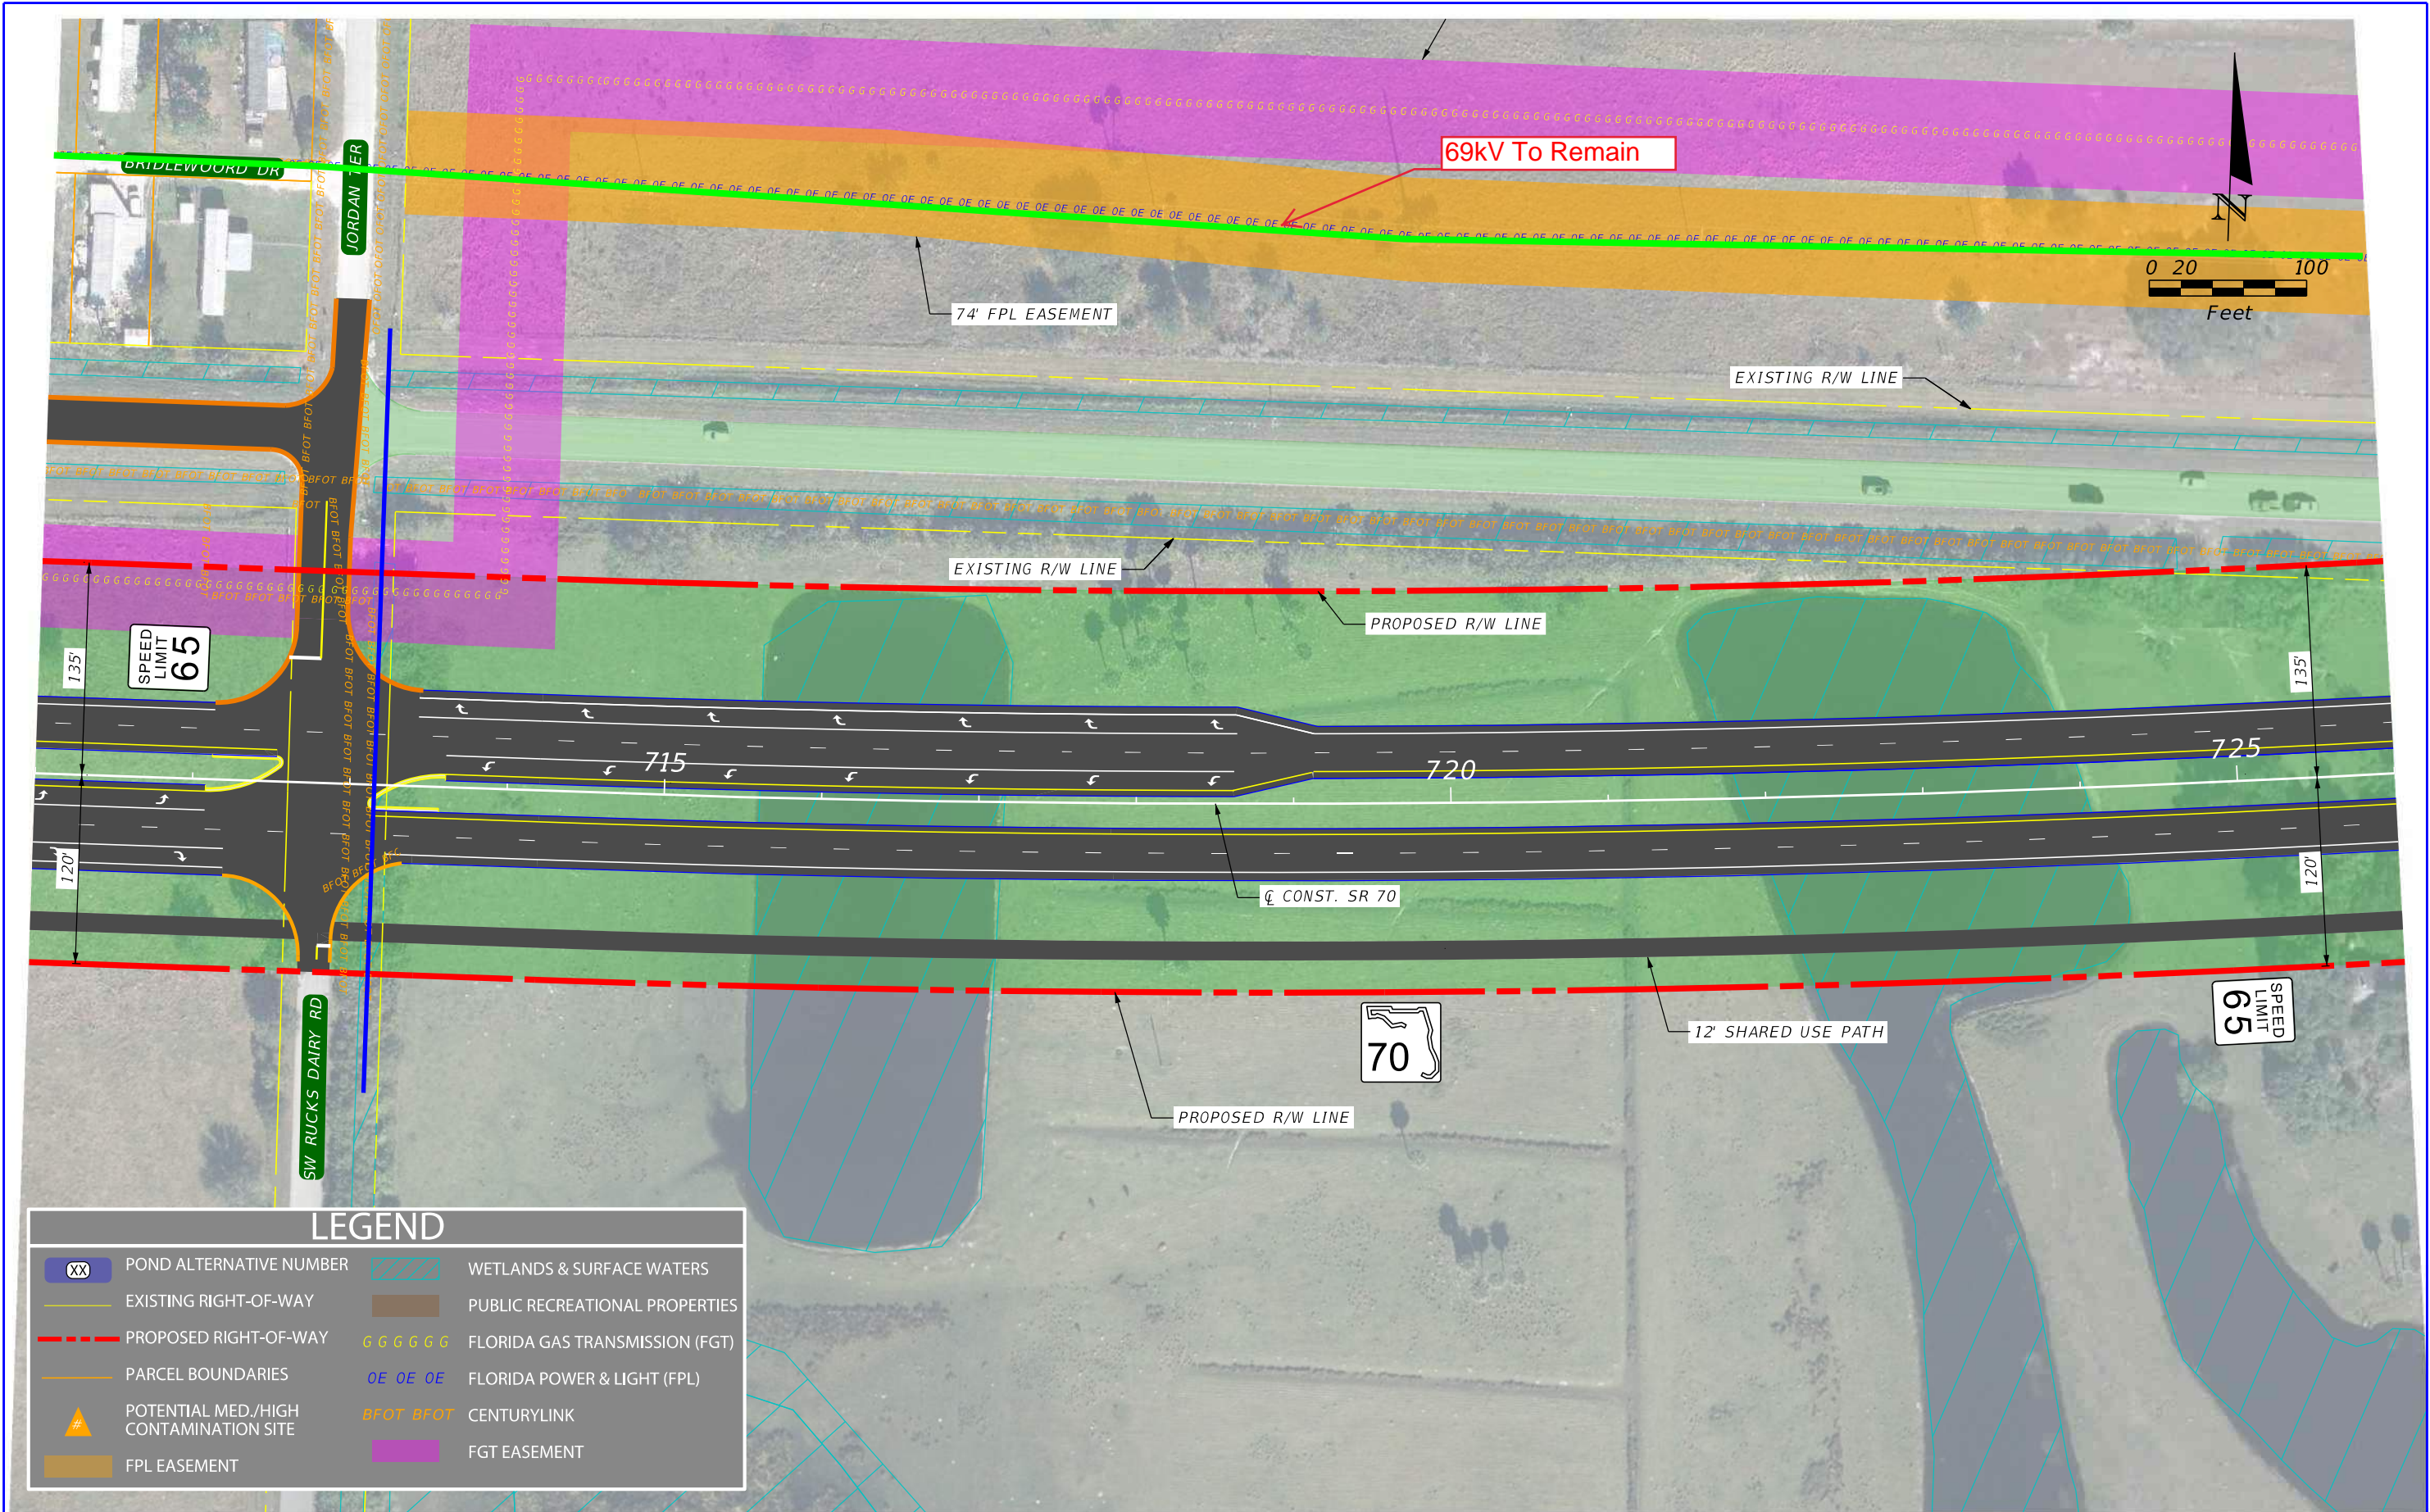

REVISIONS				ENGINEER OF RECORD		STATE OF FLORIDA DEPARTMENT OF TRANSPORTATION		ALTERNATIVE 1 CONCEPT PLAN	SHEET NO. 23
DATE	DESCRIPTION	DATE	DESCRIPTION	NICHOLAS JOHN CLAVELO LICENSE NUMBER: 84366 SCALAR CONSULTING GROUP INC. 5713 CORPORATE WAY, SUITE 200 WEST PALM BEACH, FLORIDA 33407		ROAD NO.	COUNTY		
						SR 70	HIGHLANDS OKEECHOBEE	FINANCIAL PROJECT ID 450334-1-22-01	

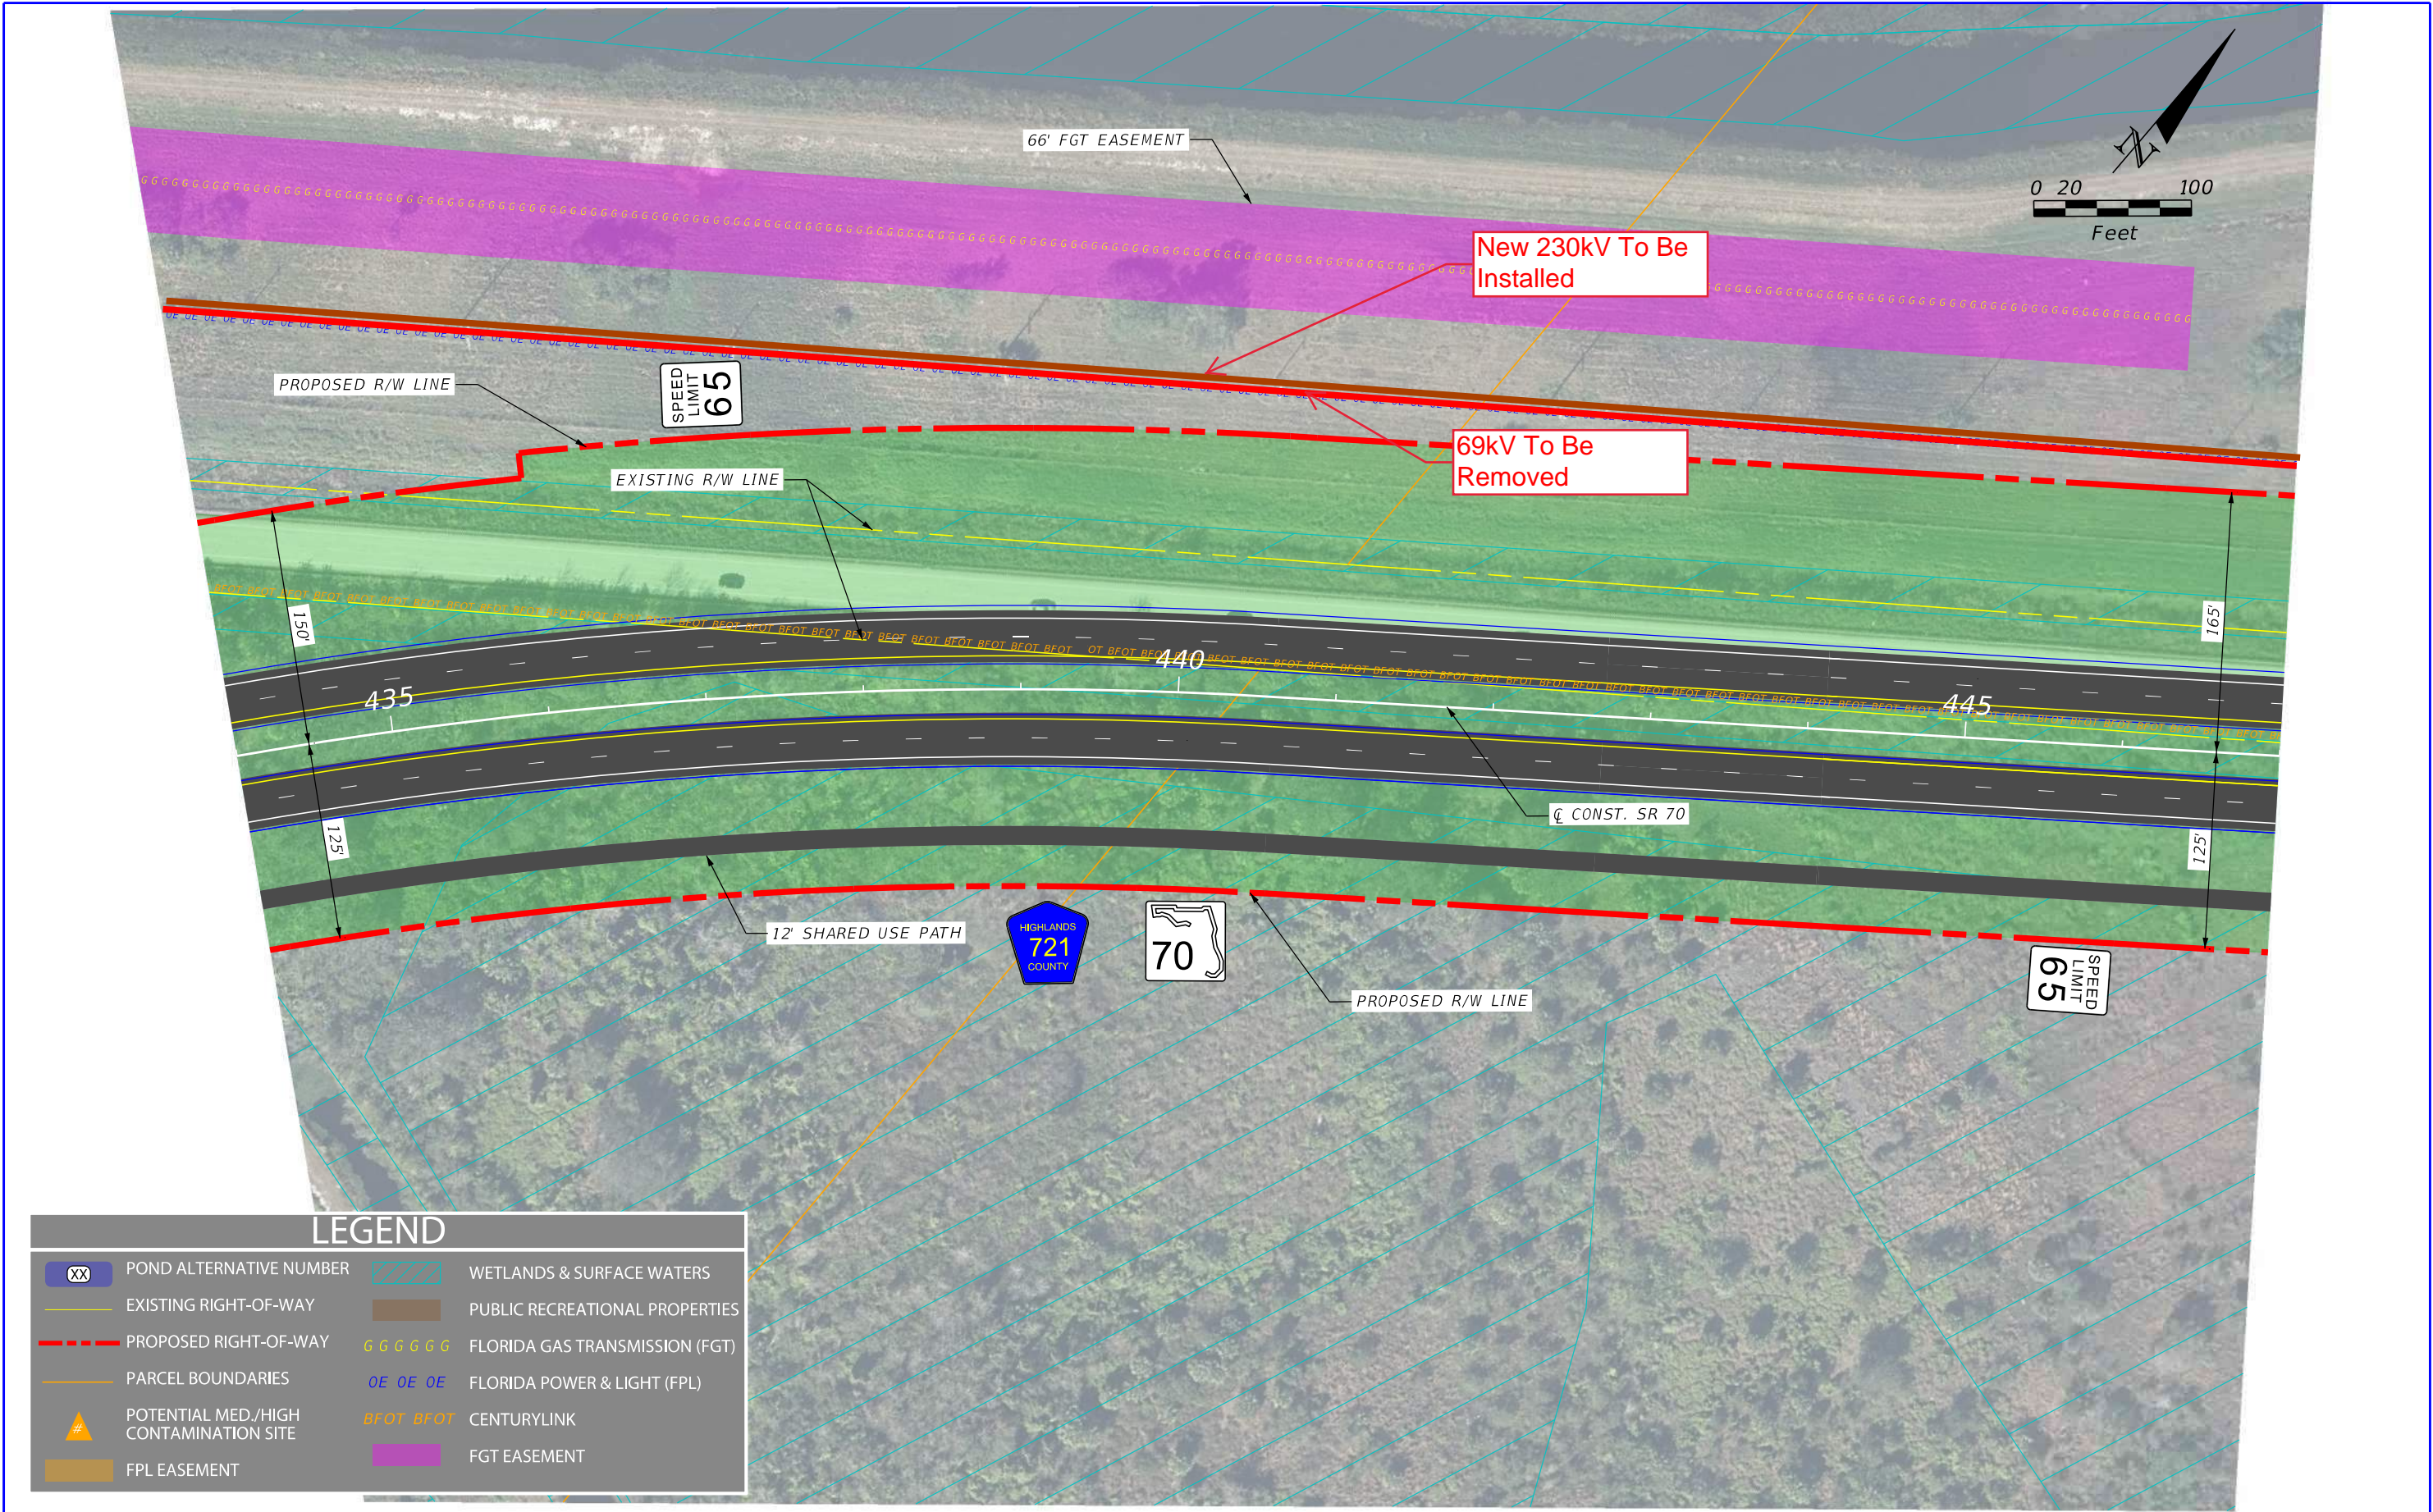

REVISIONS				ENGINEER OF RECORD		STATE OF FLORIDA DEPARTMENT OF TRANSPORTATION		ALTERNATIVE 1 CONCEPT PLAN	SHEET NO. 4
DATE	DESCRIPTION	DATE	DESCRIPTION	NICHOLAS JOHN CLAVELO LICENSE NUMBER: 84366 SCALAR CONSULTING GROUP INC. 5713 CORPORATE WAY, SUITE 200 WEST PALM BEACH, FLORIDA 33407		ROAD NO.	COUNTY		
						SR 70	HIGHLANDS OKEECHOBEE	FINANCIAL PROJECT ID 450334-1-22-01	

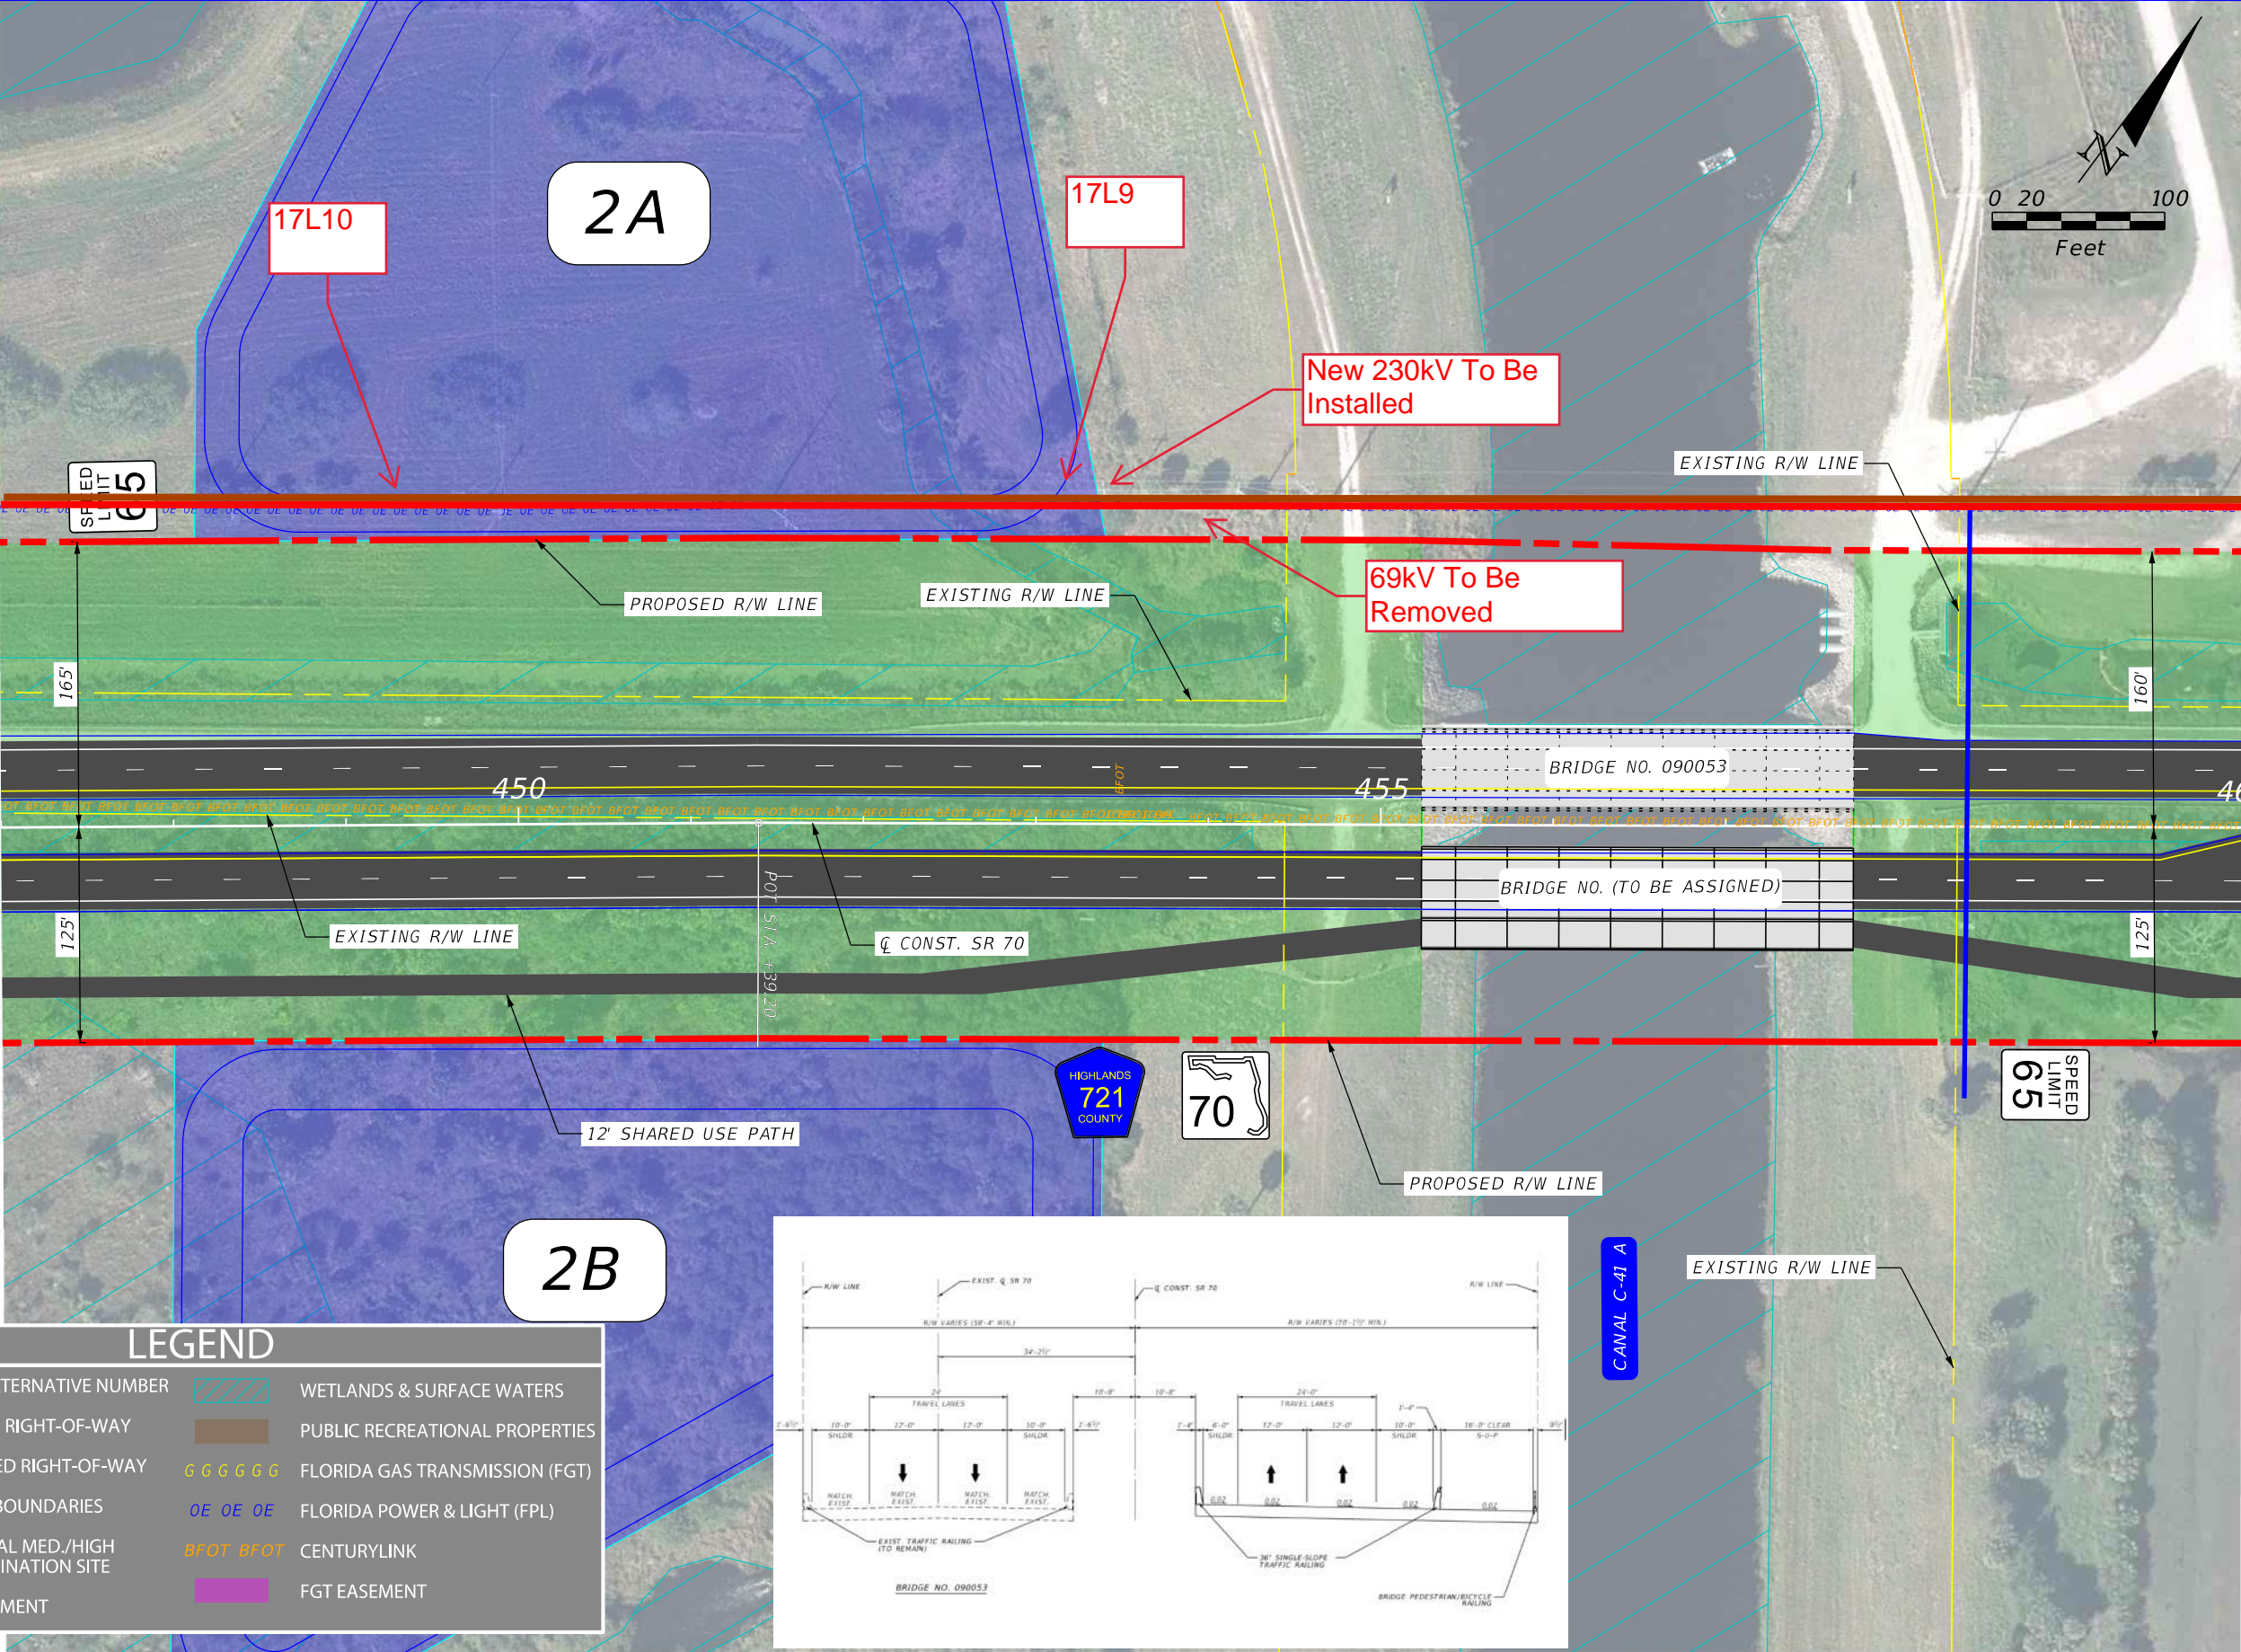

LEGEND

XX

POND ALTERNATIVE NUMBER

EXISTING RIGHT-OF-WAY

PROPOSED RIGHT-OF-WAY

PARCEL BOUNDARIES

#

POTENTIAL MED./HIGH CONTAMINATION SITE

FPL EASEMENT

WETLANDS & SURFACE WATERS

PUBLIC RECREATIONAL PROPERTIES

GGGGGG

FLORIDA GAS TRANSMISSION (FGT)


OE OE OE

FLORIDA POWER & LIGHT (FPL)


BFOT BFOT

CENTURYLINK

FGT EASEMENT

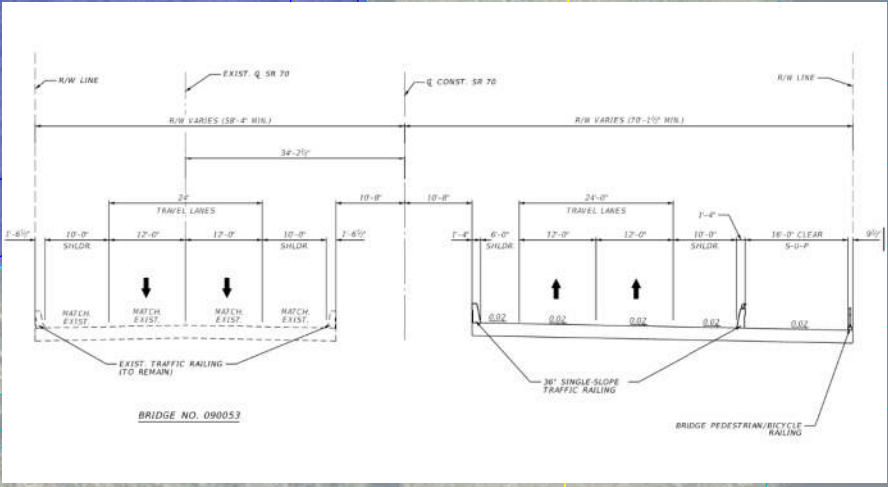

REVISIONS				ENGINEER OF RECORD		STATE OF FLORIDA DEPARTMENT OF TRANSPORTATION		ALTERNATIVE 1 CONCEPT PLAN	SHEET NO. 5
DATE	DESCRIPTION	DATE	DESCRIPTION	NICHOLAS JOHN CLAVELO LICENSE NUMBER: 84366 SCALAR CONSULTING GROUP INC. 5713 CORPORATE WAY, SUITE 200 WEST PALM BEACH, FLORIDA 33407		ROAD NO.	COUNTY		
						SR 70	HIGHLANDS OKEECHOBEE	FINANCIAL PROJECT ID 450334-1-22-01	

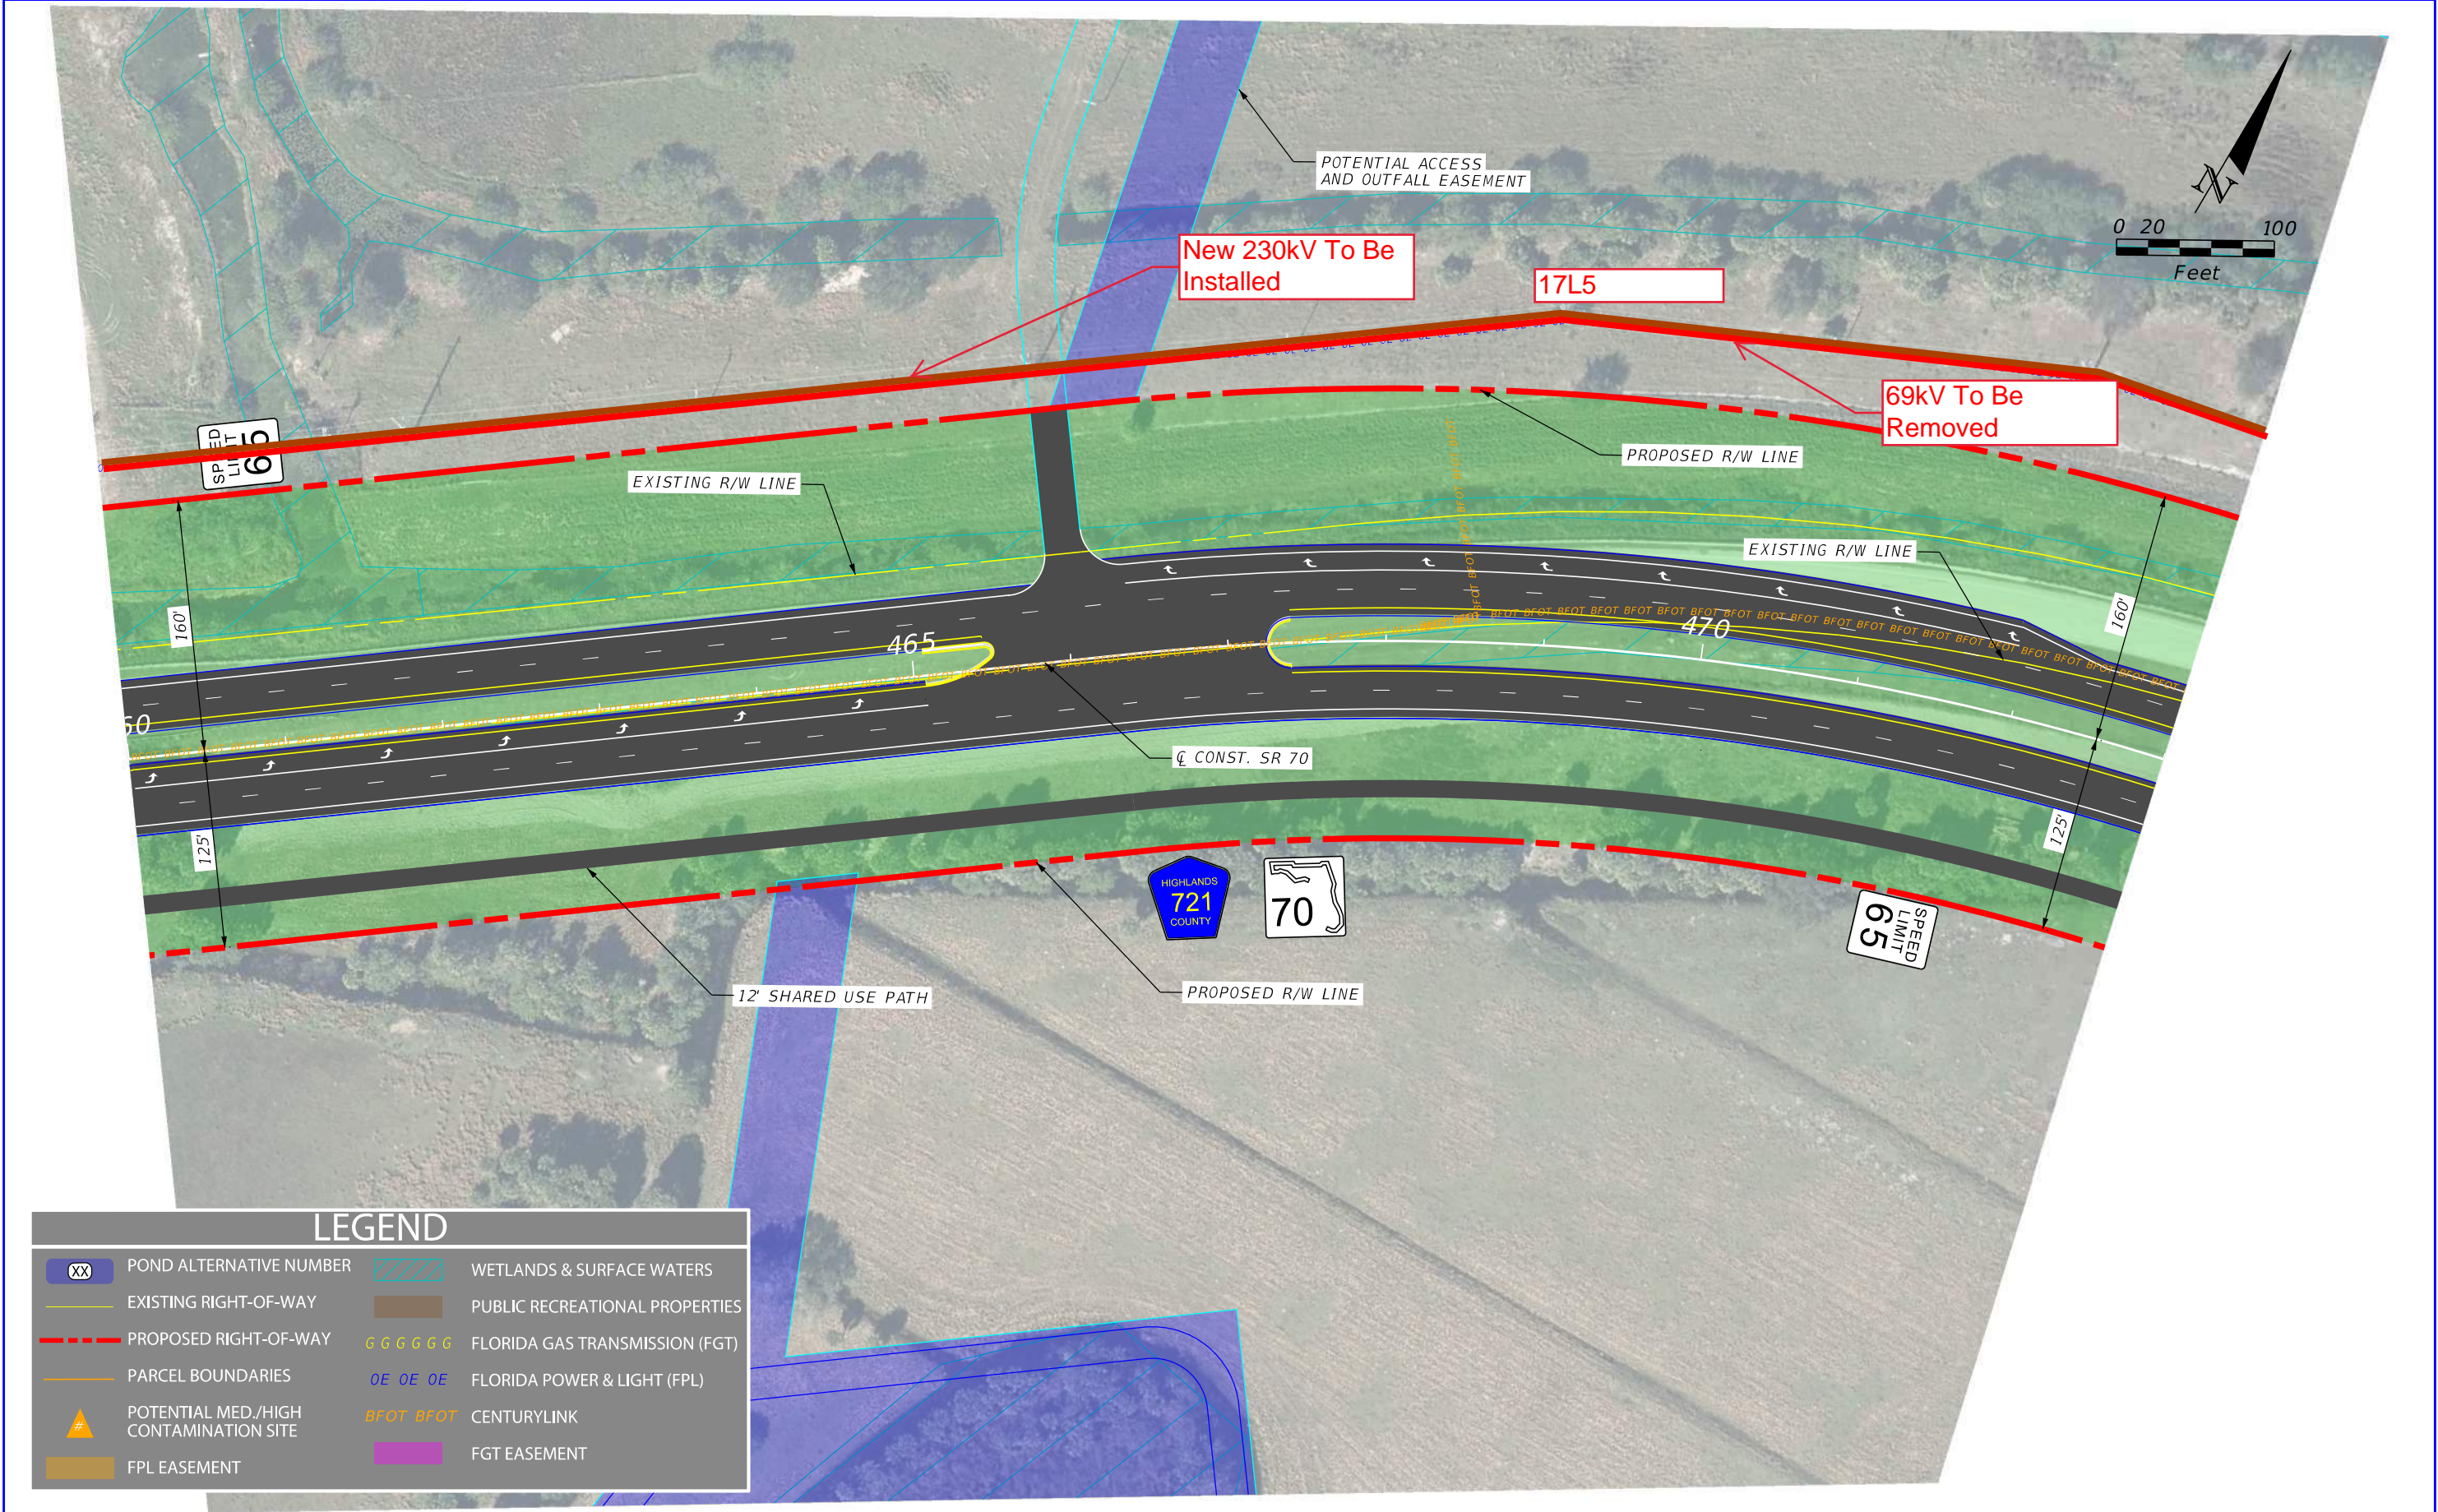

LEGEND

XX

POND ALTERNATIVE NUMBER

EXISTING RIGHT-OF-WAY

PROPOSED RIGHT-OF-WAY

PARCEL BOUNDARIES

#

POTENTIAL MED./HIGH CONTAMINATION SITE

FPL EASEMENT

WETLANDS & SURFACE WATERS

PUBLIC RECREATIONAL PROPERTIES

GGGGGG

FLORIDA GAS TRANSMISSION (FGT)

OE OE OE


FLORIDA POWER & LIGHT (FPL)

BFOT BFOT


CENTURYLINK

FGT EASEMENT

REVISIONS				ENGINEER OF RECORD		STATE OF FLORIDA DEPARTMENT OF TRANSPORTATION		ALTERNATIVE 1 CONCEPT PLAN	SHEET NO. 6
DATE	DESCRIPTION	DATE	DESCRIPTION	NICHOLAS JOHN CLAVELO LICENSE NUMBER: 84366 SCALAR CONSULTING GROUP INC. 5713 CORPORATE WAY, SUITE 200 WEST PALM BEACH, FLORIDA 33407		ROAD NO.	COUNTY		
						SR 70	HIGHLANDS OKEECHOBEE	FINANCIAL PROJECT ID 450334-1-22-01	

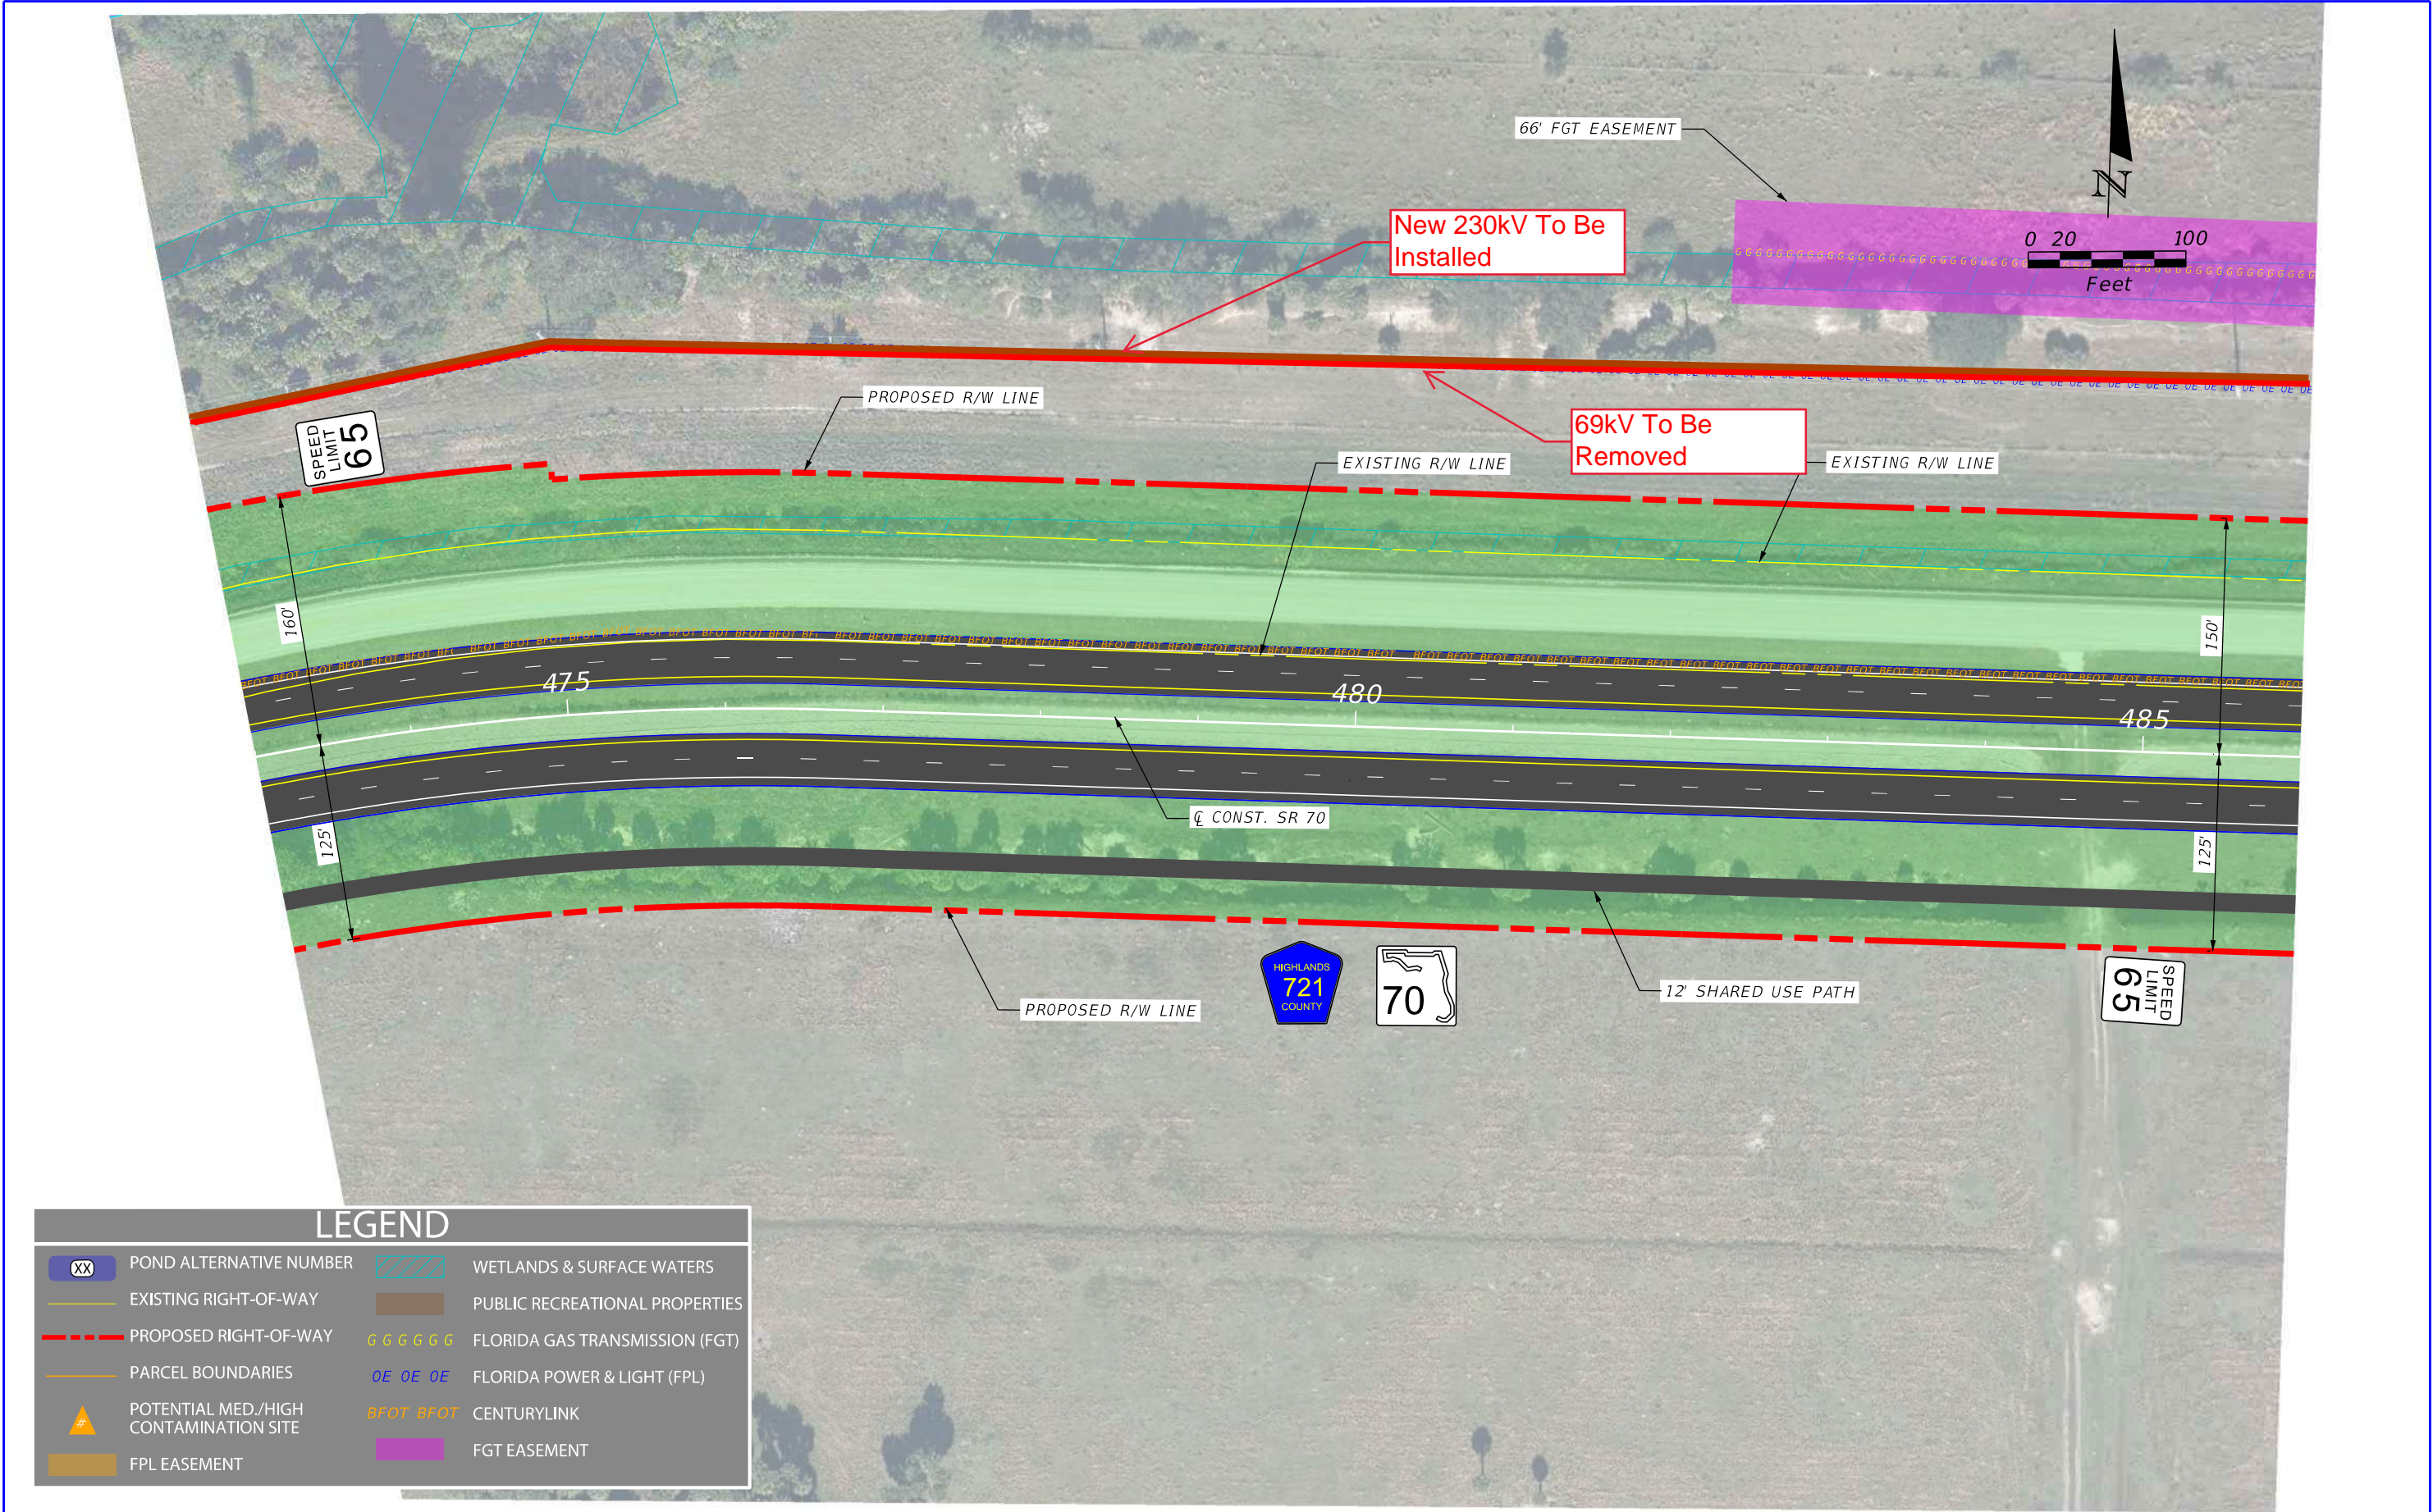

REVISIONS				ENGINEER OF RECORD		STATE OF FLORIDA DEPARTMENT OF TRANSPORTATION		ALTERNATIVE 1 CONCEPT PLAN	SHEET NO. 7
DATE	DESCRIPTION	DATE	DESCRIPTION	NICHOLAS JOHN CLAVELO LICENSE NUMBER: 84366 SCALAR CONSULTING GROUP INC. 5713 CORPORATE WAY, SUITE 200 WEST PALM BEACH, FLORIDA 33407		ROAD NO.	COUNTY		
						SR 70	HIGHLANDS OKEECHOBEE	FINANCIAL PROJECT ID 450334-1-22-01	

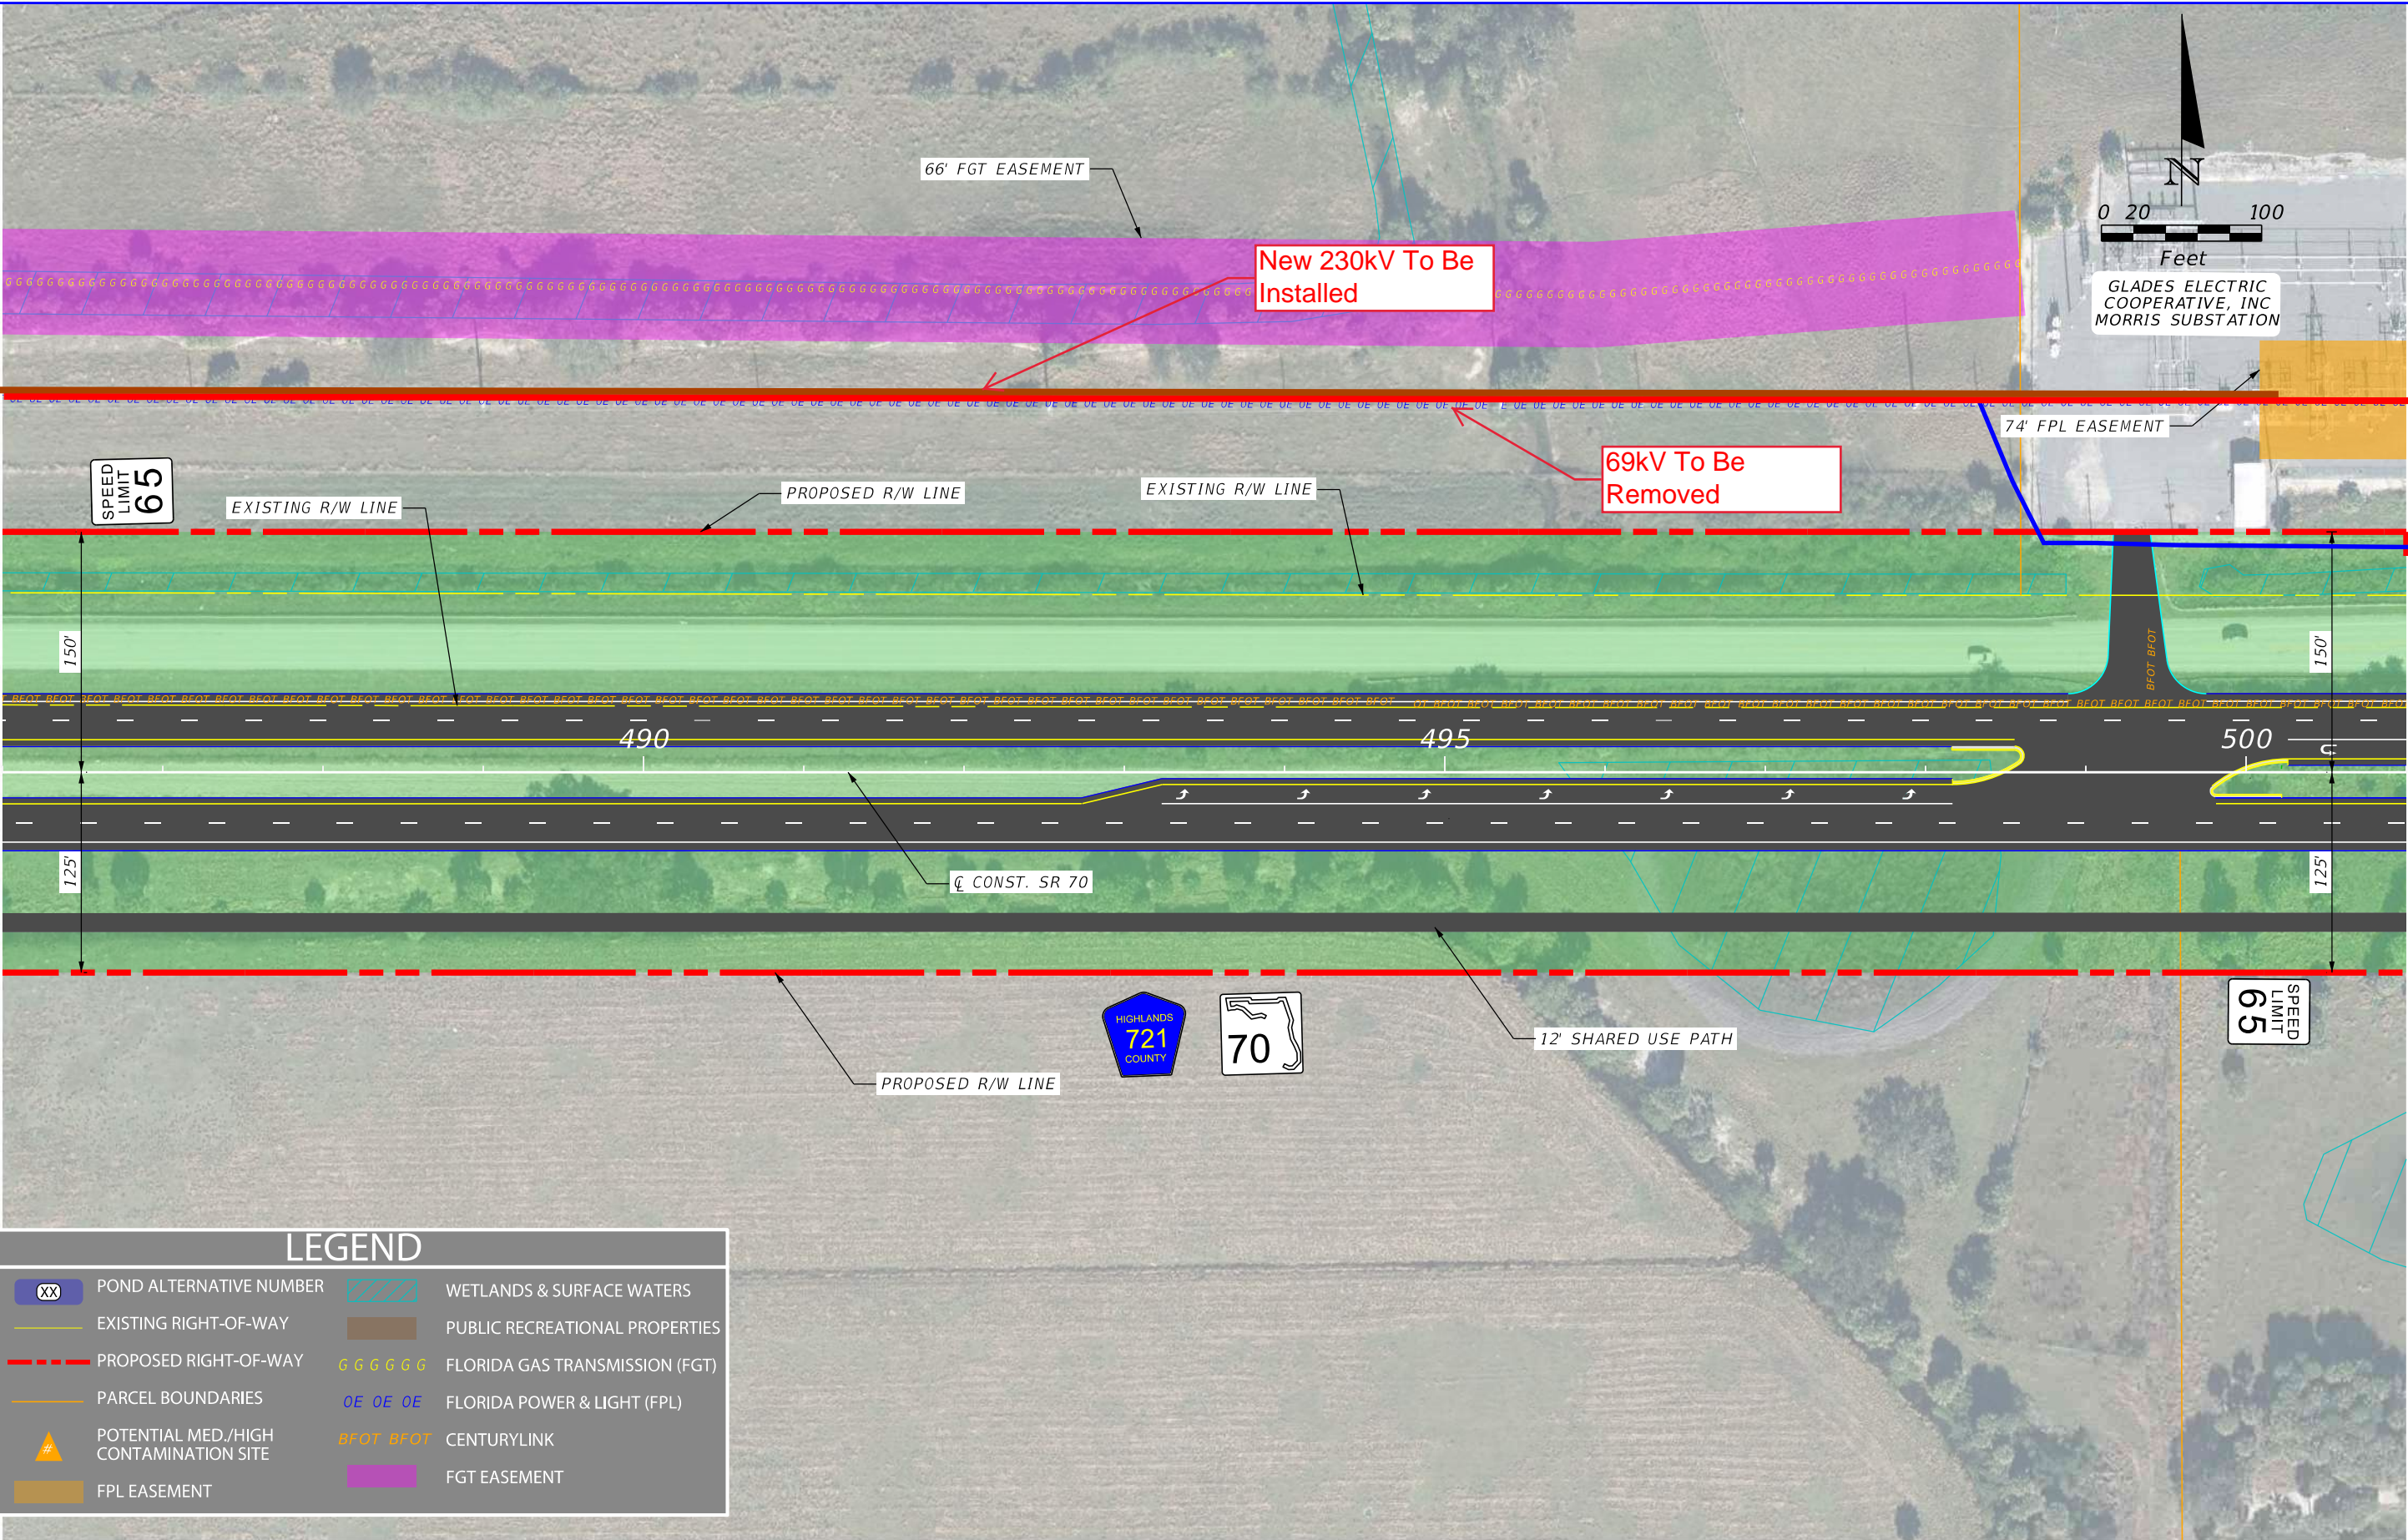

LEGEND

XX

POND ALTERNATIVE NUMBER

EXISTING RIGHT-OF-WAY

PROPOSED RIGHT-OF-WAY

PARCEL BOUNDARIES

#

POTENTIAL MED/HIGH CONTAMINATION SITE

FPL EASEMENT

WETLANDS & SURFACE WATERS

PUBLIC RECREATIONAL PROPERTIES

GGGGGG

FLORIDA GAS TRANSMISSION (FGT)

OE OE OE

FLORIDA POWER & LIGHT (FPL)

BFOT BFOT


CENTURYLINK

FGT EASEMENT


REVISIONS				ENGINEER OF RECORD			STATE OF FLORIDA DEPARTMENT OF TRANSPORTATION			SHEET NO. 8
DATE	DESCRIPTION	DATE	DESCRIPTION	NICHOLAS JOHN CLAVELO LICENSE NUMBER: 84366 SCALAR CONSULTING GROUP INC. 5713 CORPORATE WAY, SUITE 200 WEST PALM BEACH, FLORIDA 33407			ROAD NO.	COUNTY	FINANCIAL PROJECT ID	
							SR 70	HIGHLANDS OKEECHOBEE	450334-1-22-01	

ALTERNATIVE 1
CONCEPT PLAN

P:\FL23010.00 SR 70 PD&E Study\45033412201\roadway\PLANRD01.dgn : CL11 - PLAN 8 [SHEET]
USER: areginato 11/27/2024 4:57:00 PM

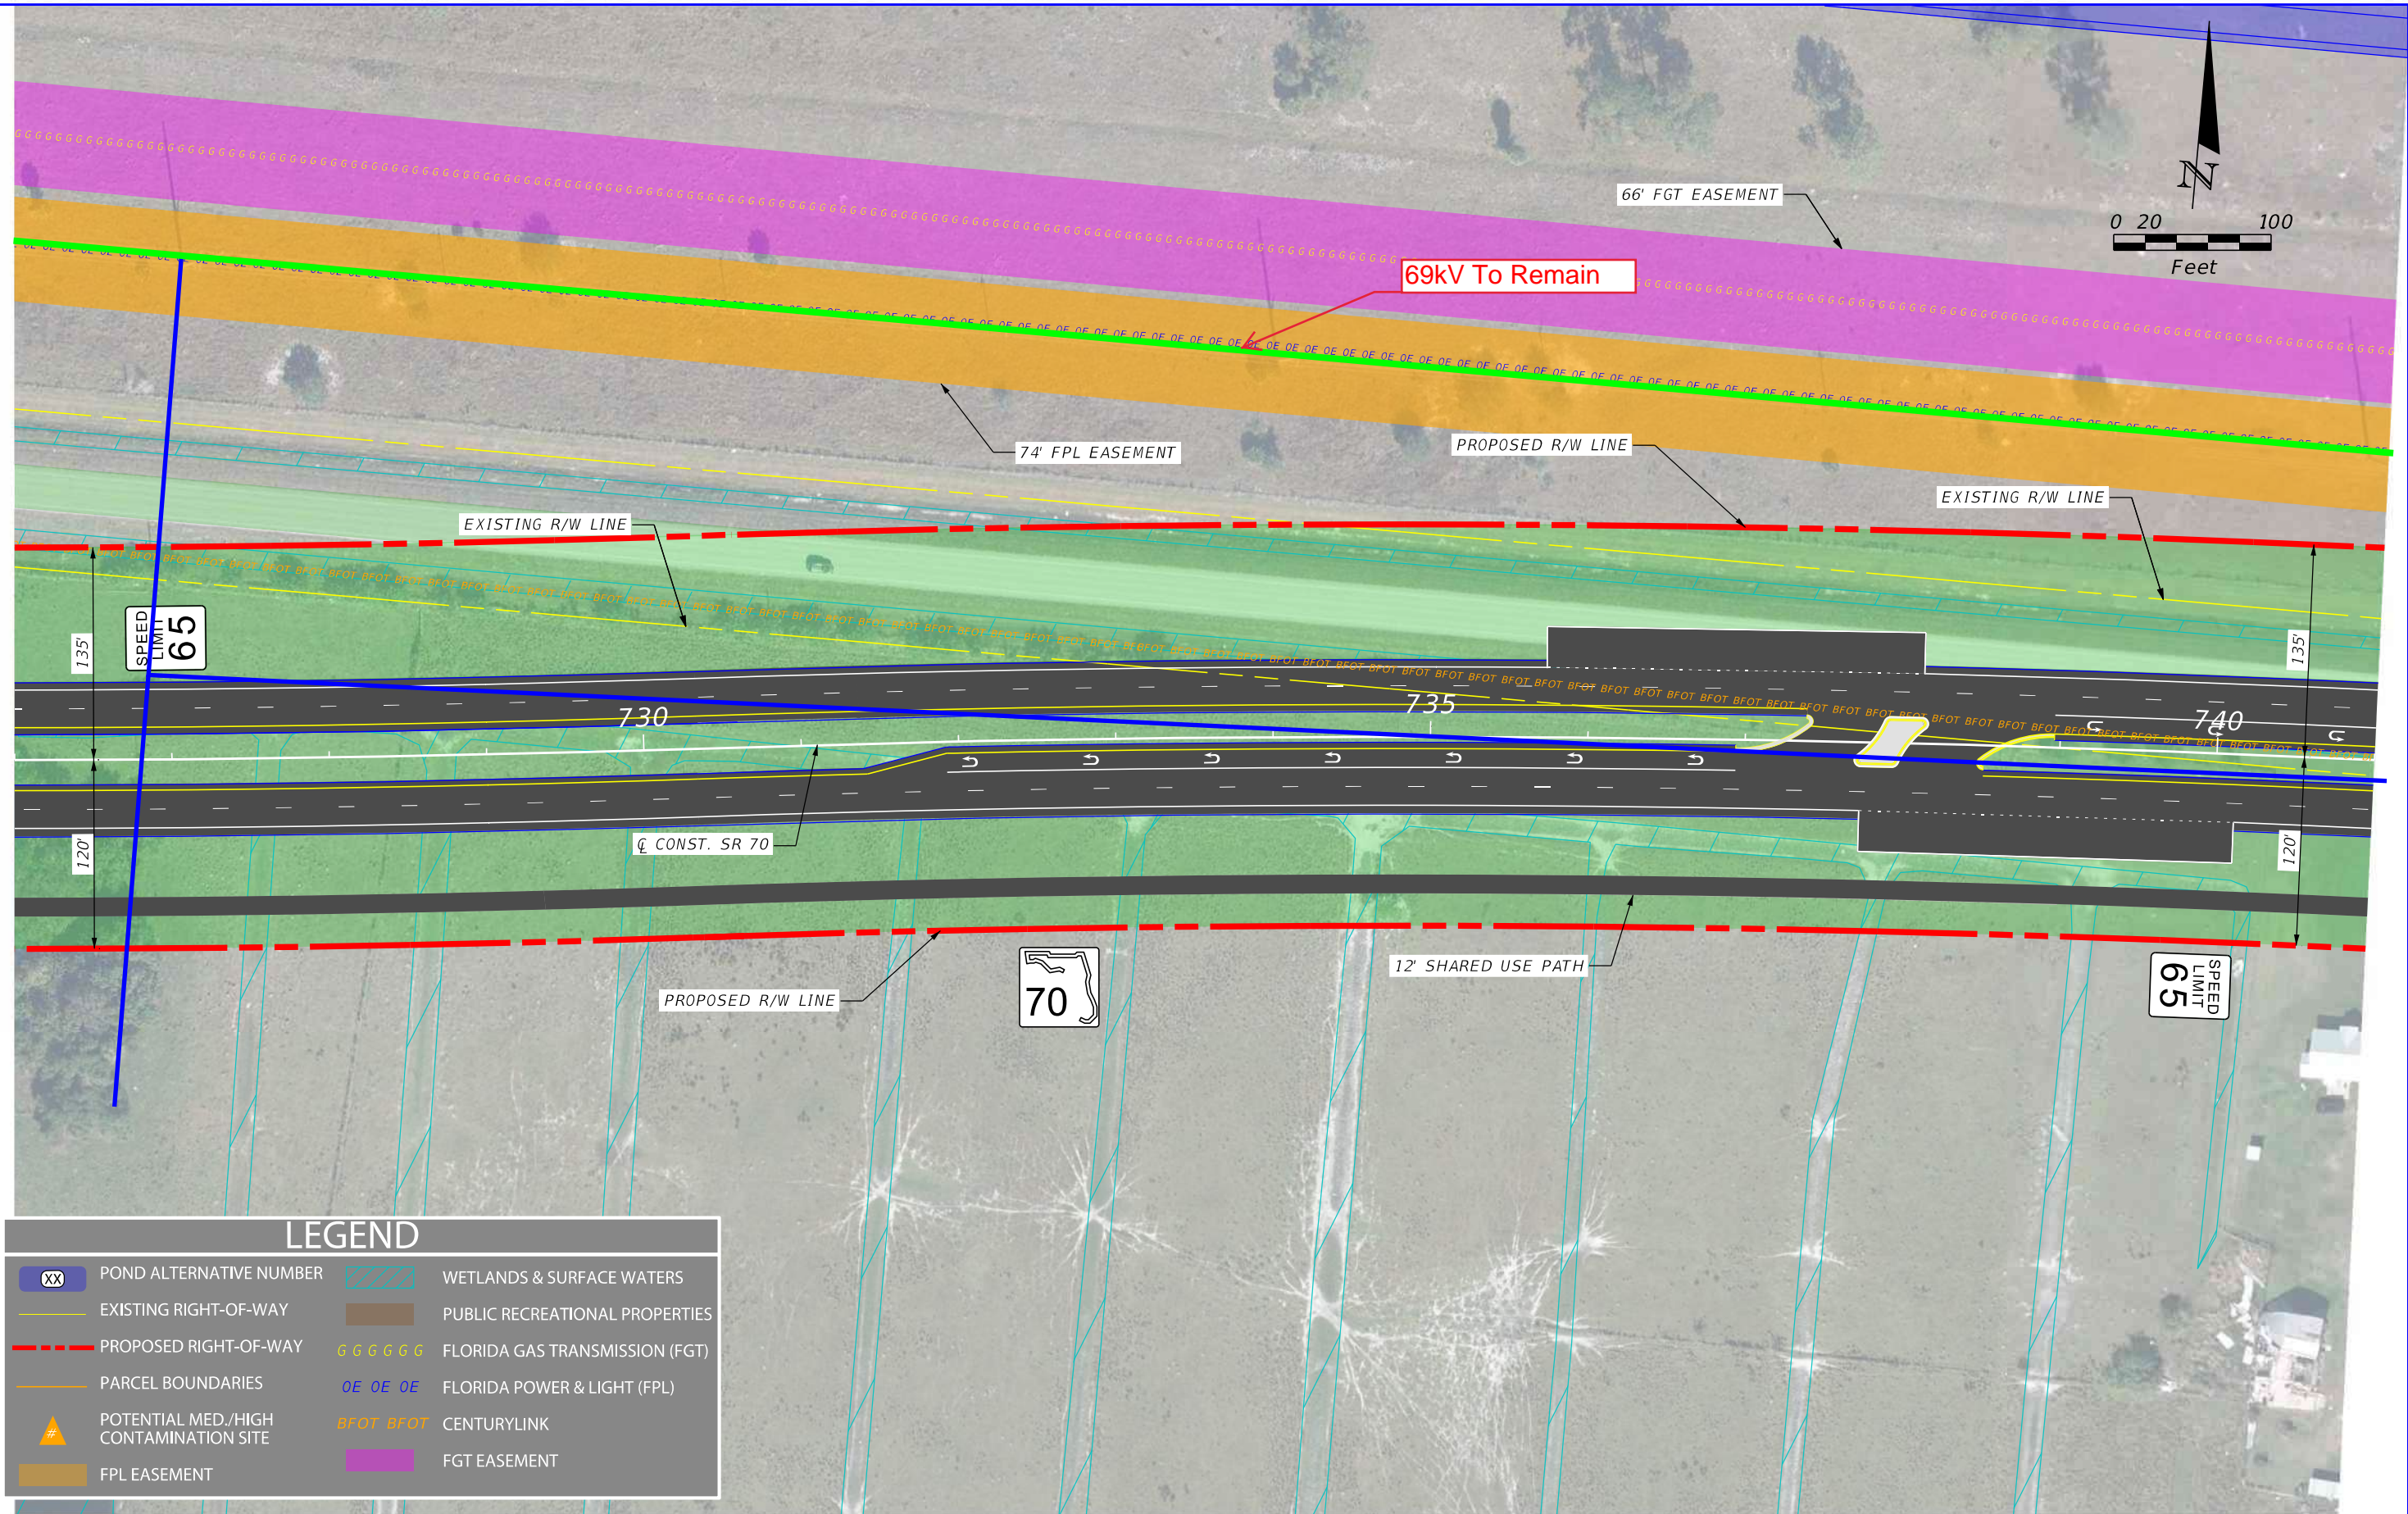


REVISIONS				ENGINEER OF RECORD		STATE OF FLORIDA DEPARTMENT OF TRANSPORTATION		ALTERNATIVE 1 CONCEPT PLAN	SHEET NO. 24
DATE	DESCRIPTION	DATE	DESCRIPTION	NICHOLAS JOHN CLAVELO LICENSE NUMBER: 84366 SCALAR CONSULTING GROUP INC. 5713 CORPORATE WAY, SUITE 200 WEST PALM BEACH, FLORIDA 33407		ROAD NO.	COUNTY		
						SR 70	HIGHLANDS OKEECHOBEE	FINANCIAL PROJECT ID 450334-1-22-01	

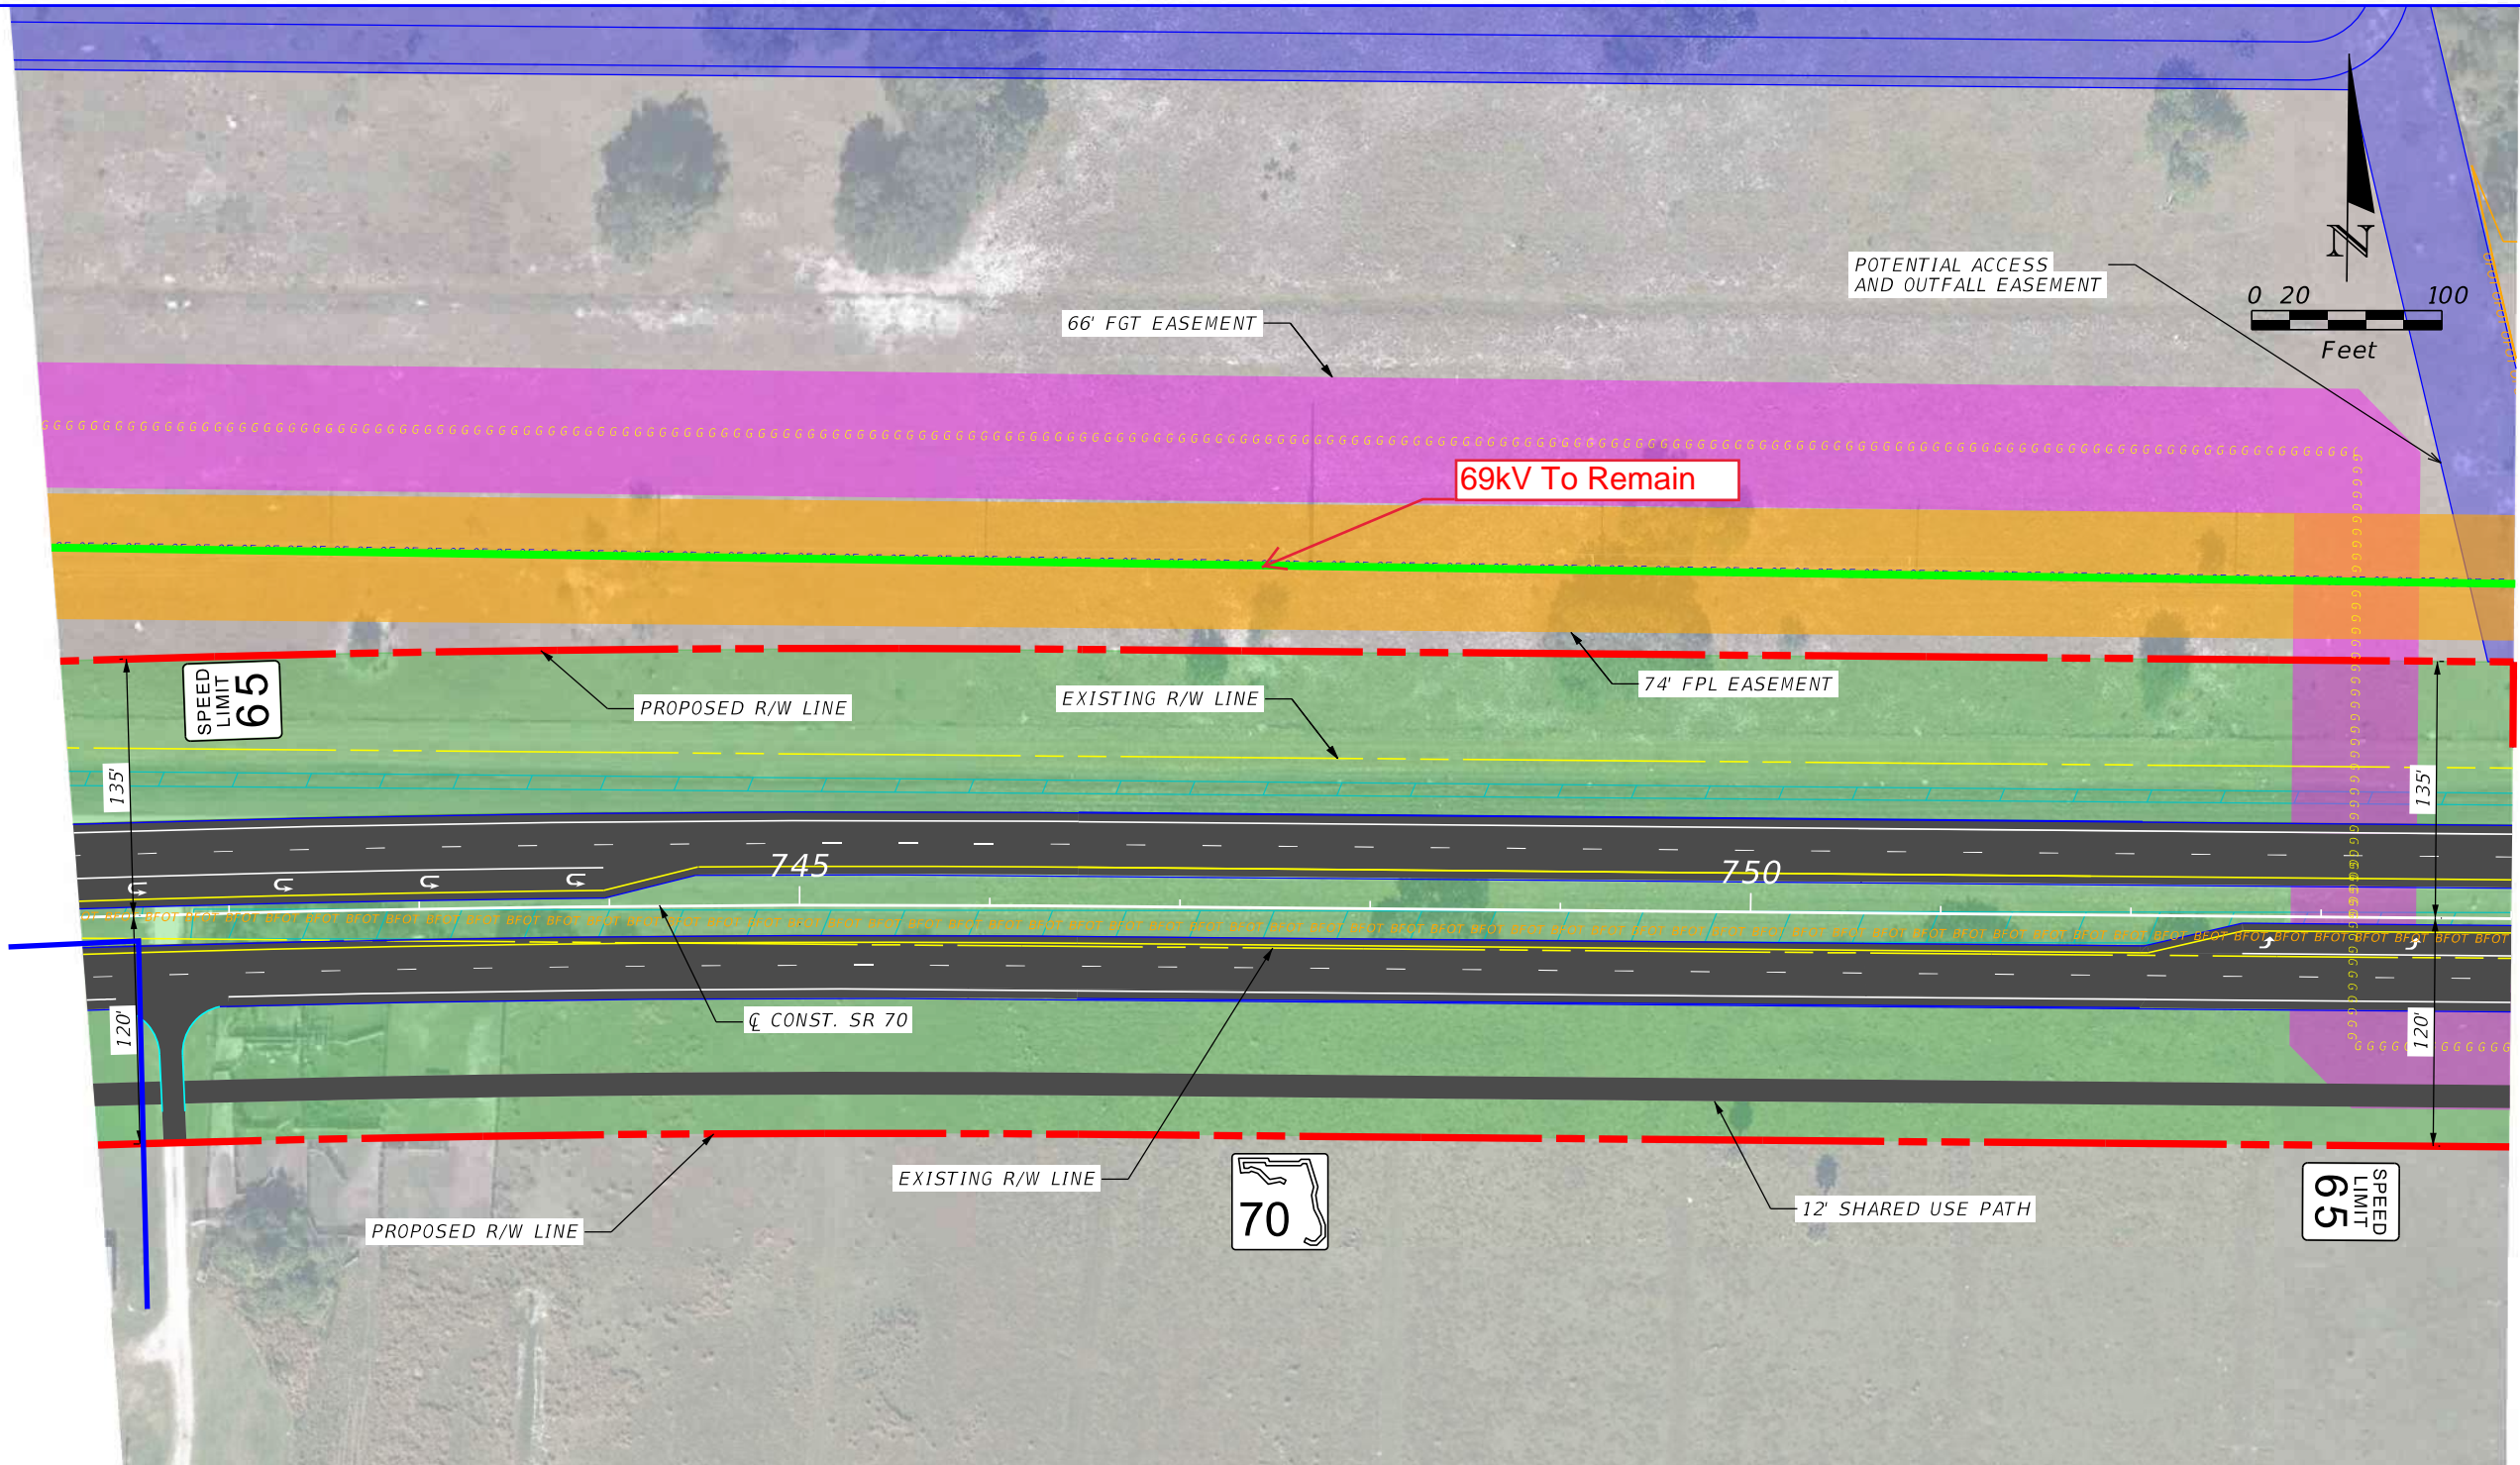


LEGEND			
<div>XX</div>	POND ALTERNATIVE NUMBER	<div></div>	WETLANDS & SURFACE WATERS
<div></div>	EXISTING RIGHT-OF-WAY	<div></div>	PUBLIC RECREATIONAL PROPERTIES
<div></div>	PROPOSED RIGHT-OF-WAY	<div>GGGGGG</div>	FLORIDA GAS TRANSMISSION (FGT)
<div></div>	PARCEL BOUNDARIES	<div>OE OE OE</div>	FLORIDA POWER & LIGHT (FPL)
<div>#</div>	POTENTIAL MED/HIGH CONTAMINATION SITE	<div>BFOT BFOT</div>	CENTURYLINK
<div></div>	FPL EASEMENT	<div></div>	FGT EASEMENT



REVISIONS				ENGINEER OF RECORD	STATE OF FLORIDA DEPARTMENT OF TRANSPORTATION			ALTERNATIVE 1 CONCEPT PLAN	SHEET NO.
DATE	DESCRIPTION	DATE	DESCRIPTION	NICHOLAS JOHN CLAVELO LICENSE NUMBER: 84366 SCALAR CONSULTING GROUP INC. 5713 CORPORATE WAY, SUITE 200 WEST PALM BEACH, FLORIDA 33407	ROAD NO.	COUNTY	FINANCIAL PROJECT ID		25
					SR 70	HIGHLANDS OKEECHOBEE	450334-1-22-01		

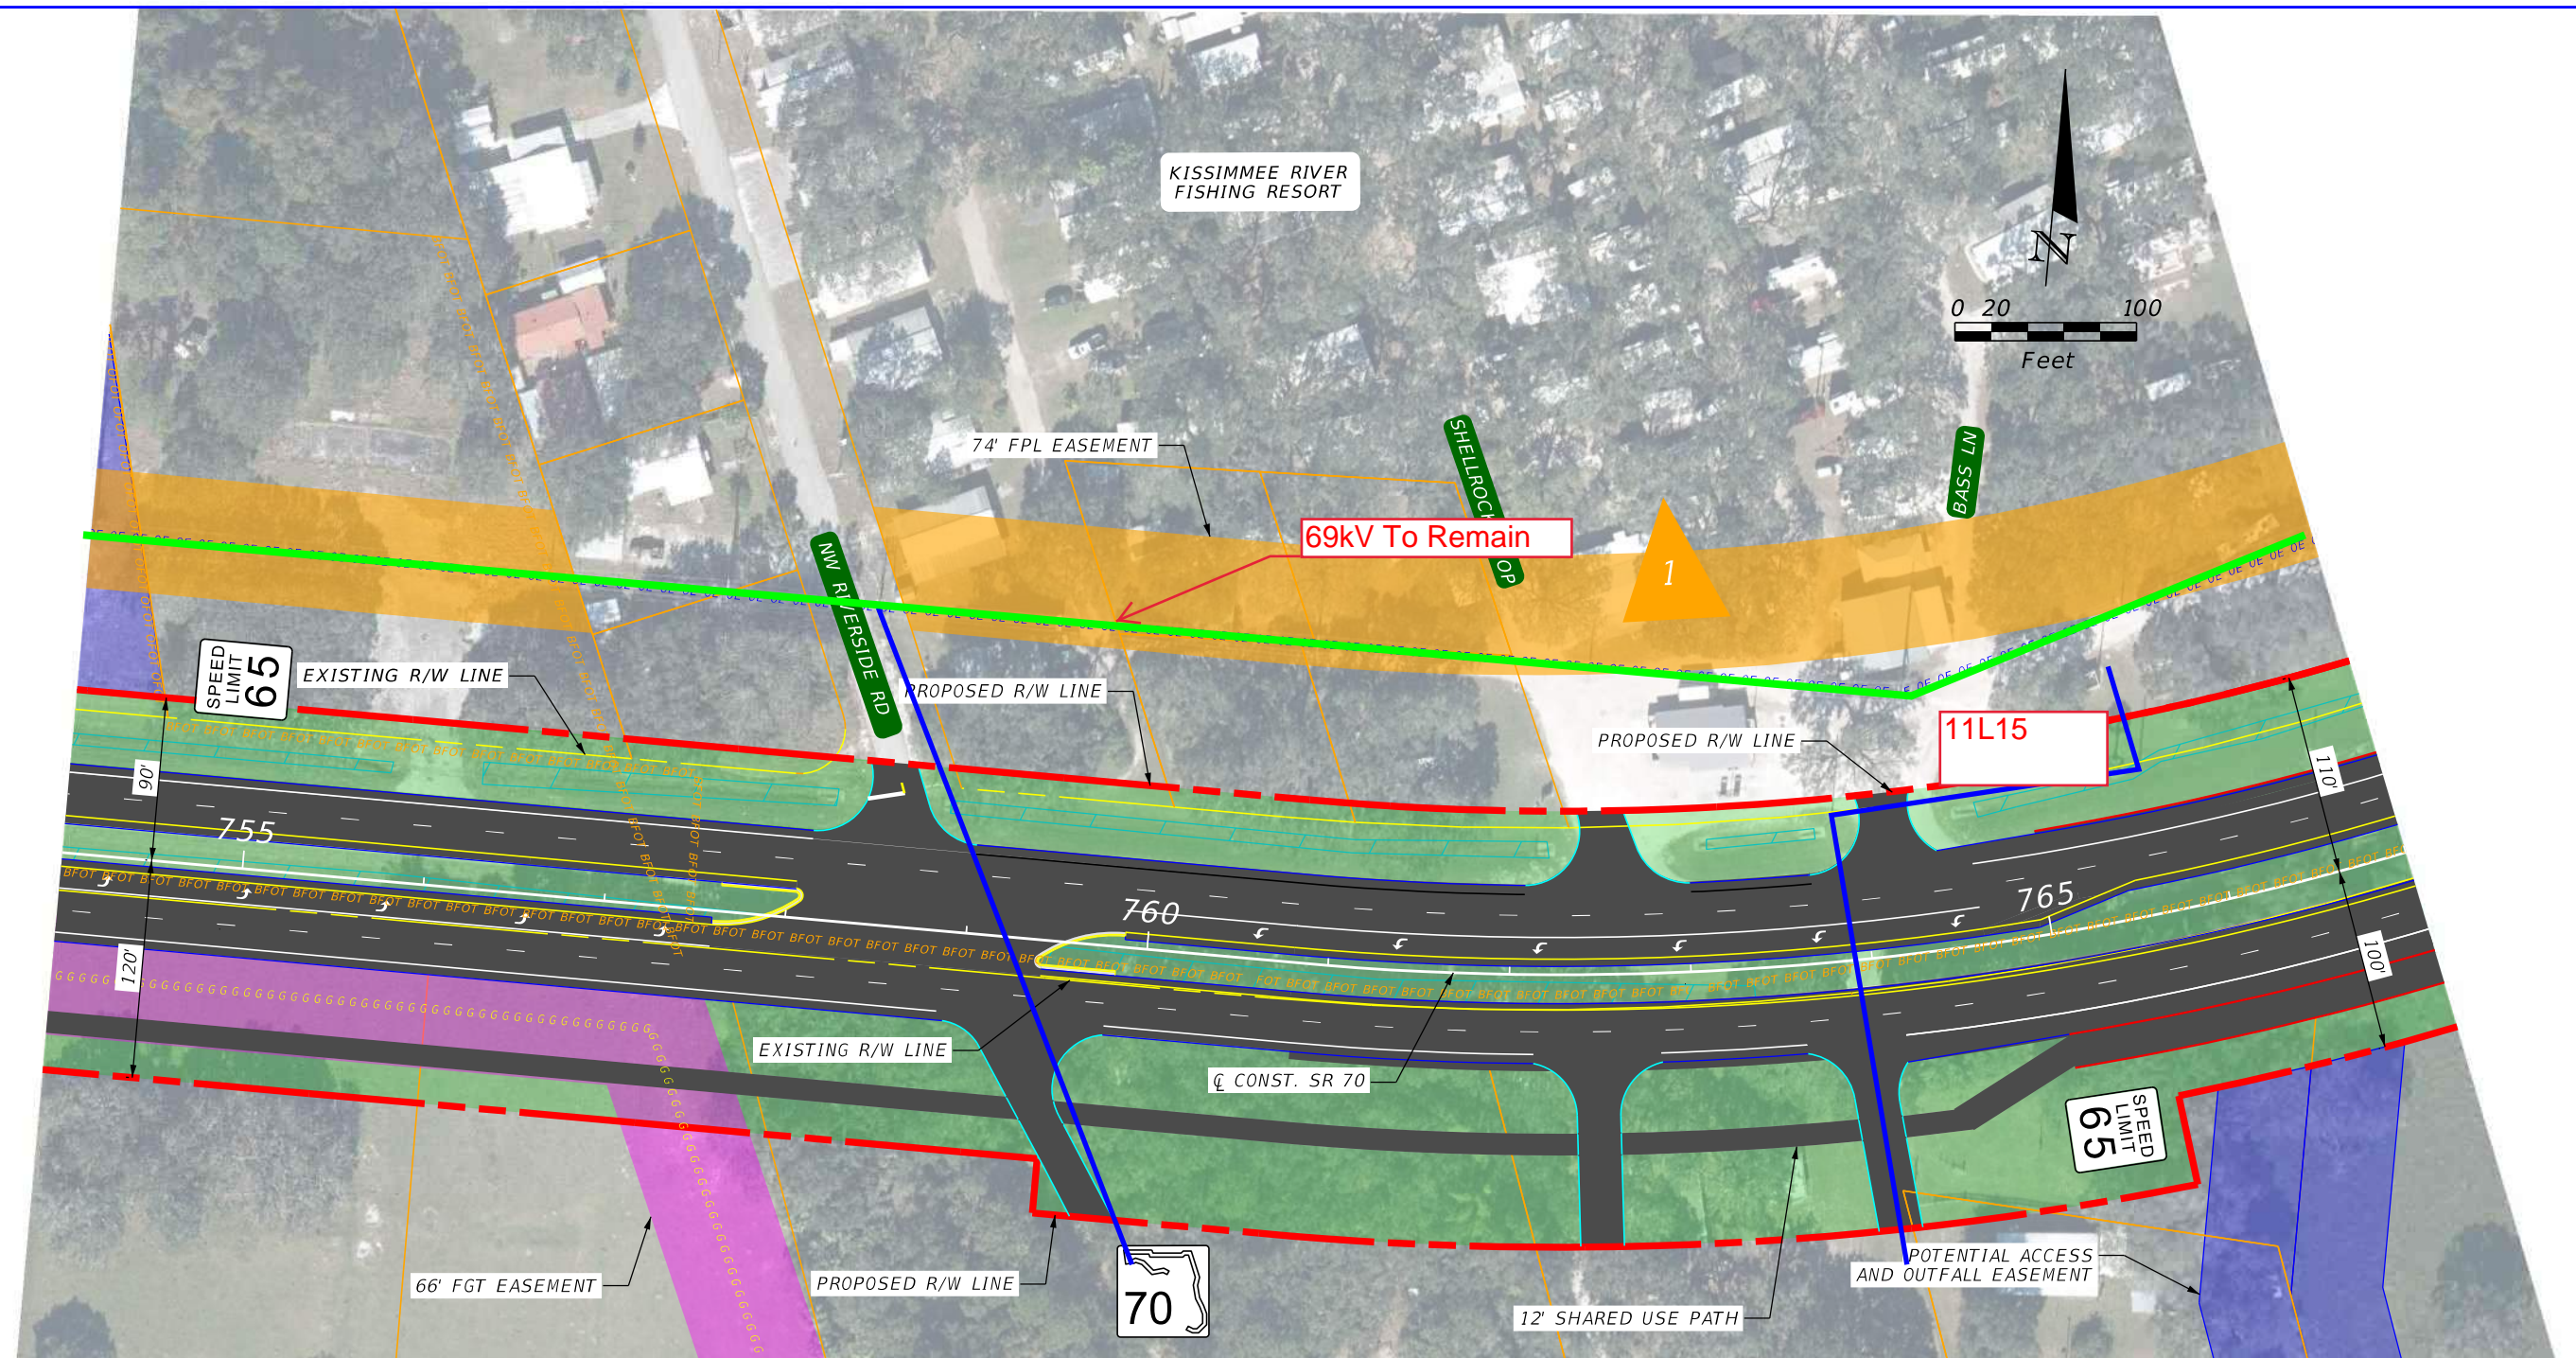


LEGEND			
XX	POND ALTERNATIVE NUMBER		WETLANDS & SURFACE WATERS
---	EXISTING RIGHT-OF-WAY		PUBLIC RECREATIONAL PROPERTIES
---	PROPOSED RIGHT-OF-WAY	GGGGGG	FLORIDA GAS TRANSMISSION (FGT)
---	PARCEL BOUNDARIES	OE OE OE	FLORIDA POWER & LIGHT (FPL)
#	POTENTIAL MED./HIGH CONTAMINATION SITE	BFOT BFOT	CENTURYLINK
	FPL EASEMENT		FGT EASEMENT

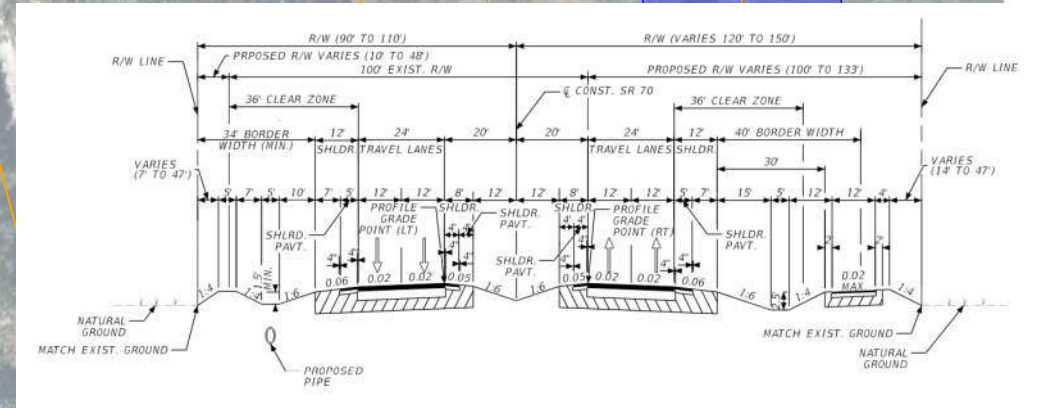

REVISIONS				ENGINEER OF RECORD		STATE OF FLORIDA DEPARTMENT OF TRANSPORTATION		ALTERNATIVE 1 CONCEPT PLAN	SHEET NO. 26
DATE	DESCRIPTION	DATE	DESCRIPTION	NICHOLAS JOHN CLAVELO LICENSE NUMBER: 84366 SCALAR CONSULTING GROUP INC. 5713 CORPORATE WAY, SUITE 200 WEST PALM BEACH, FLORIDA 33407		ROAD NO.	COUNTY		
						SR 70	HIGHLANDS OKEECHOBEE	FINANCIAL PROJECT ID 450334-1-22-01	

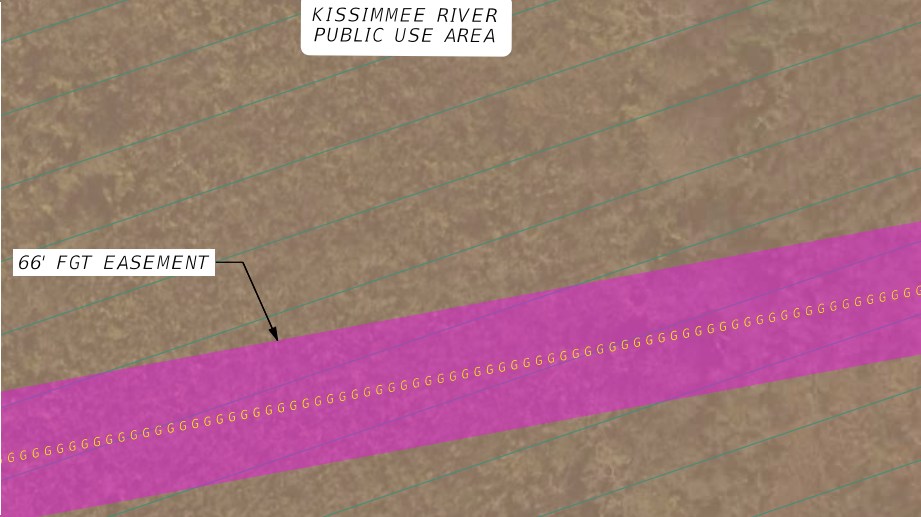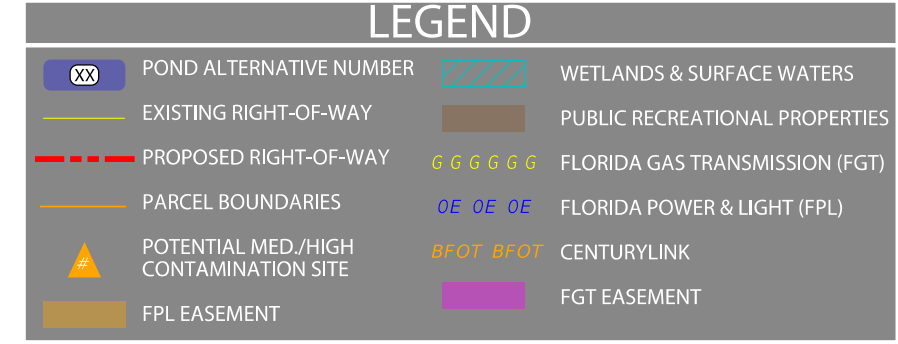

ALTERNATIVE 1 CONCEPT PLAN

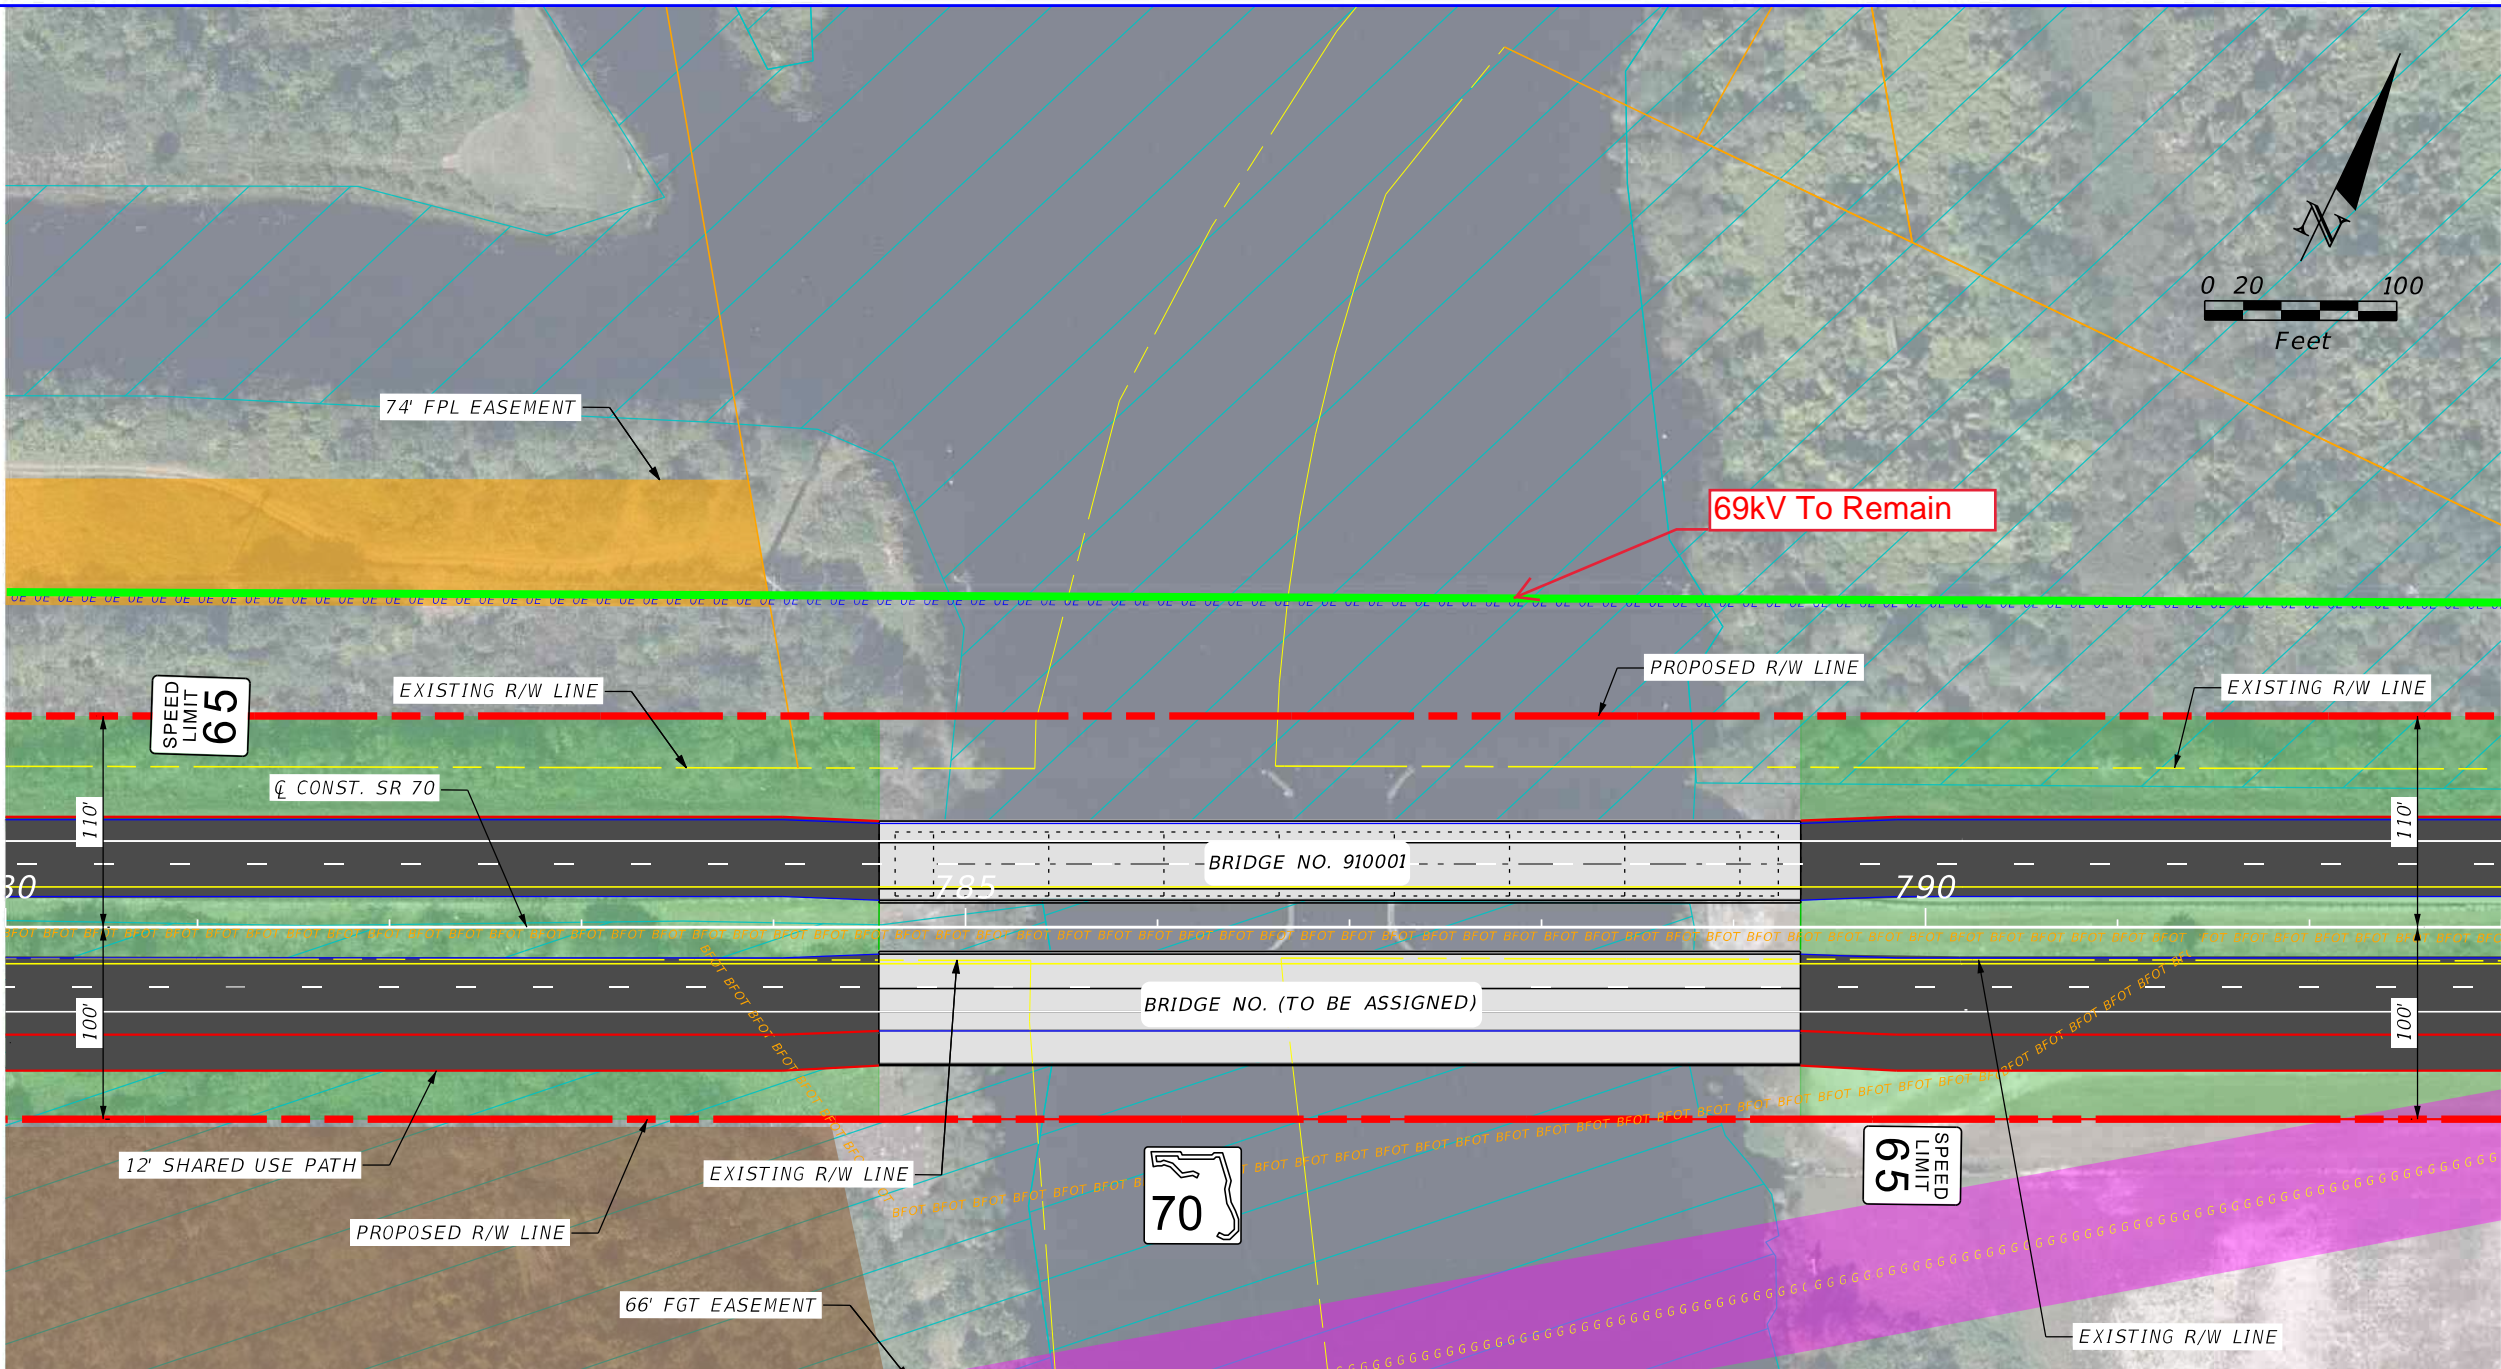

LEGEND

XX

POND ALTERNATIVE NUMBER

EXISTING RIGHT-OF-WAY

PROPOSED RIGHT-OF-WAY

PARCEL BOUNDARIES

#

POTENTIAL MED./HIGH CONTAMINATION SITE

FPL EASEMENT

WETLANDS & SURFACE WATERS

PUBLIC RECREATIONAL PROPERTIES

GGGGGG

FLORIDA GAS TRANSMISSION (FGT)


OE OE OE

FLORIDA POWER & LIGHT (FPL)




BEOT BFOT

CENTURYLINK

FGT EASEMENT

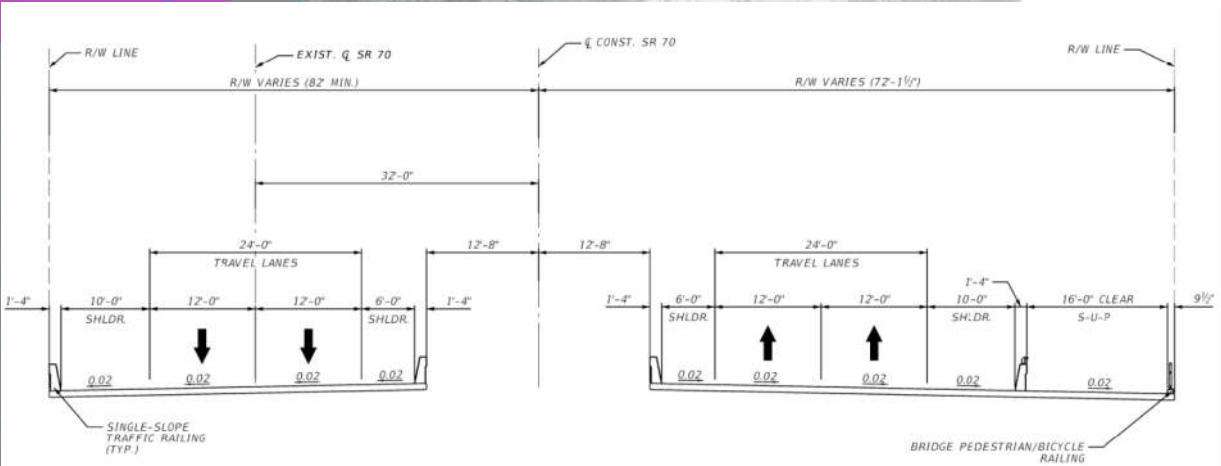


REVISIONS				ENGINEER OF RECORD		STATE OF FLORIDA DEPARTMENT OF TRANSPORTATION		ALTERNATIVE 1 CONCEPT PLAN	SHEET NO. 28
DATE	DESCRIPTION	DATE	DESCRIPTION	NICHOLAS JOHN CLAVELO LICENSE NUMBER: 84366 SCALAR CONSULTING GROUP INC. 5713 CORPORATE WAY, SUITE 200 WEST PALM BEACH, FLORIDA 33407		ROAD NO.	COUNTY		
						SR 70	HIGHLANDS OKEECHOBEE	FINANCIAL PROJECT ID 450334-1-22-01	

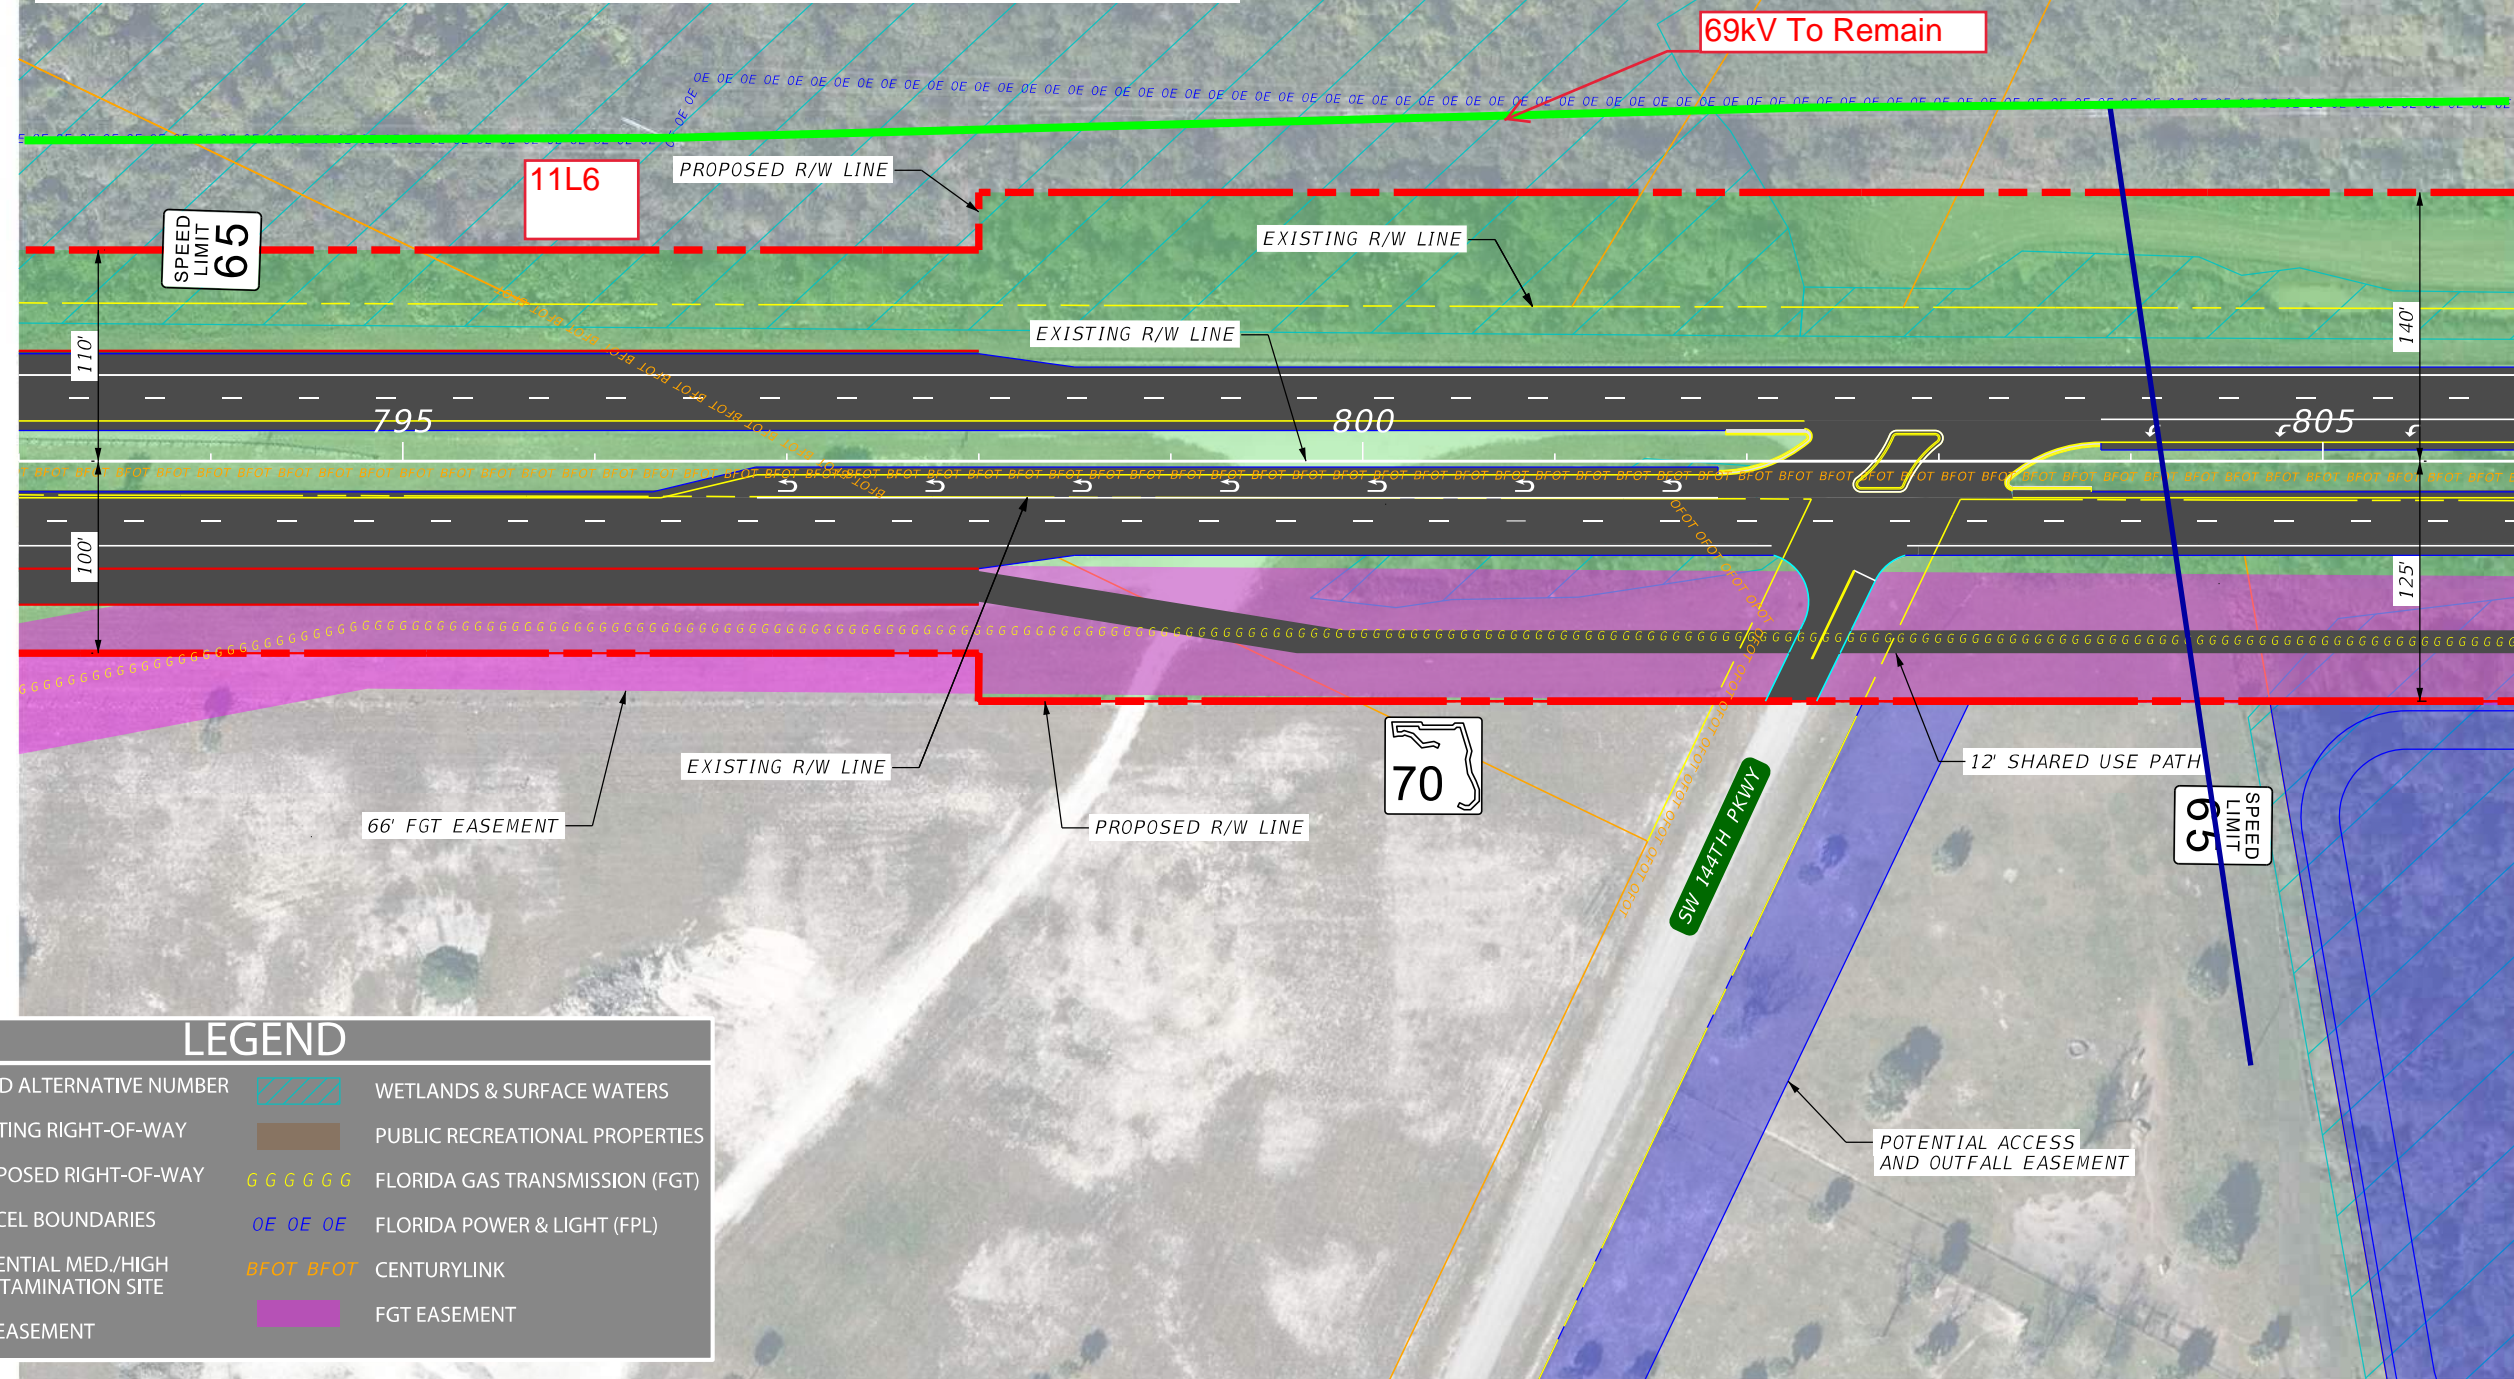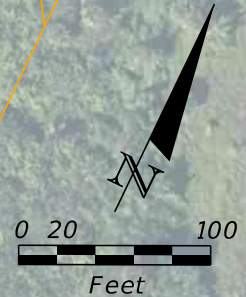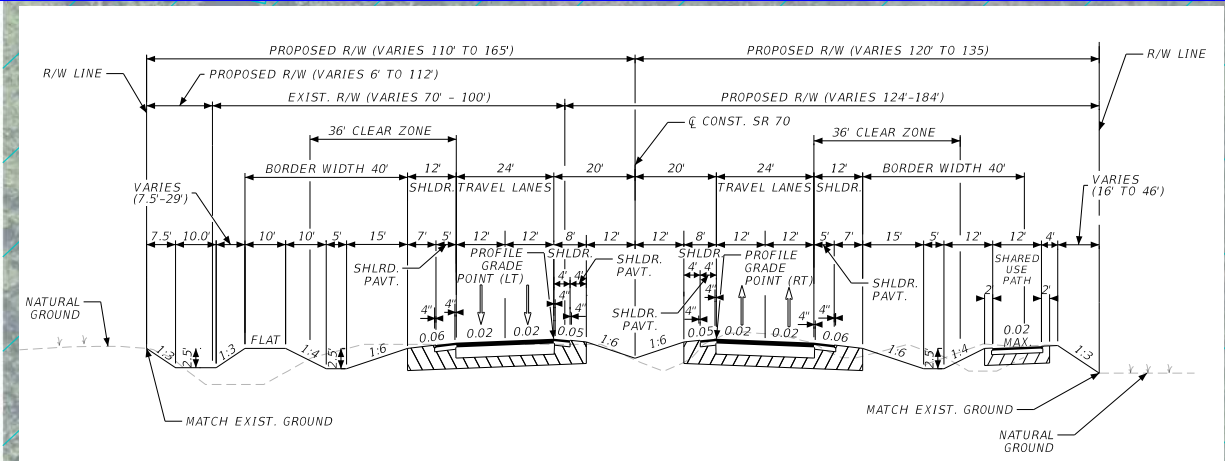

LEGEND			
	POND ALTERNATIVE NUMBER		WETLANDS & SURFACE WATERS
	EXISTING RIGHT-OF-WAY		PUBLIC RECREATIONAL PROPERTIES
	PROPOSED RIGHT-OF-WAY		FLORIDA GAS TRANSMISSION (FGT)
	PARCEL BOUNDARIES		FLORIDA POWER & LIGHT (FPL)
	POTENTIAL MED./HIGH CONTAMINATION SITE		CENTURYLINK
	FPL EASEMENT		FGT EASEMENT

REVISIONS				ENGINEER OF RECORD		STATE OF FLORIDA DEPARTMENT OF TRANSPORTATION		ALTERNATIVE 1 CONCEPT PLAN	SHEET NO. 29
DATE	DESCRIPTION	DATE	DESCRIPTION	NICHOLAS JOHN CLAVELLO LICENSE NUMBER: 84366 SCALAR CONSULTING GROUP INC. 5713 CORPORATE WAY, SUITE 200 WEST PALM BEACH, FLORIDA 33407		ROAD NO.	COUNTY		
						SR 70	HIGHLANDS OKEECHOBEE	FINANCIAL PROJECT ID 450334-1-22-01	

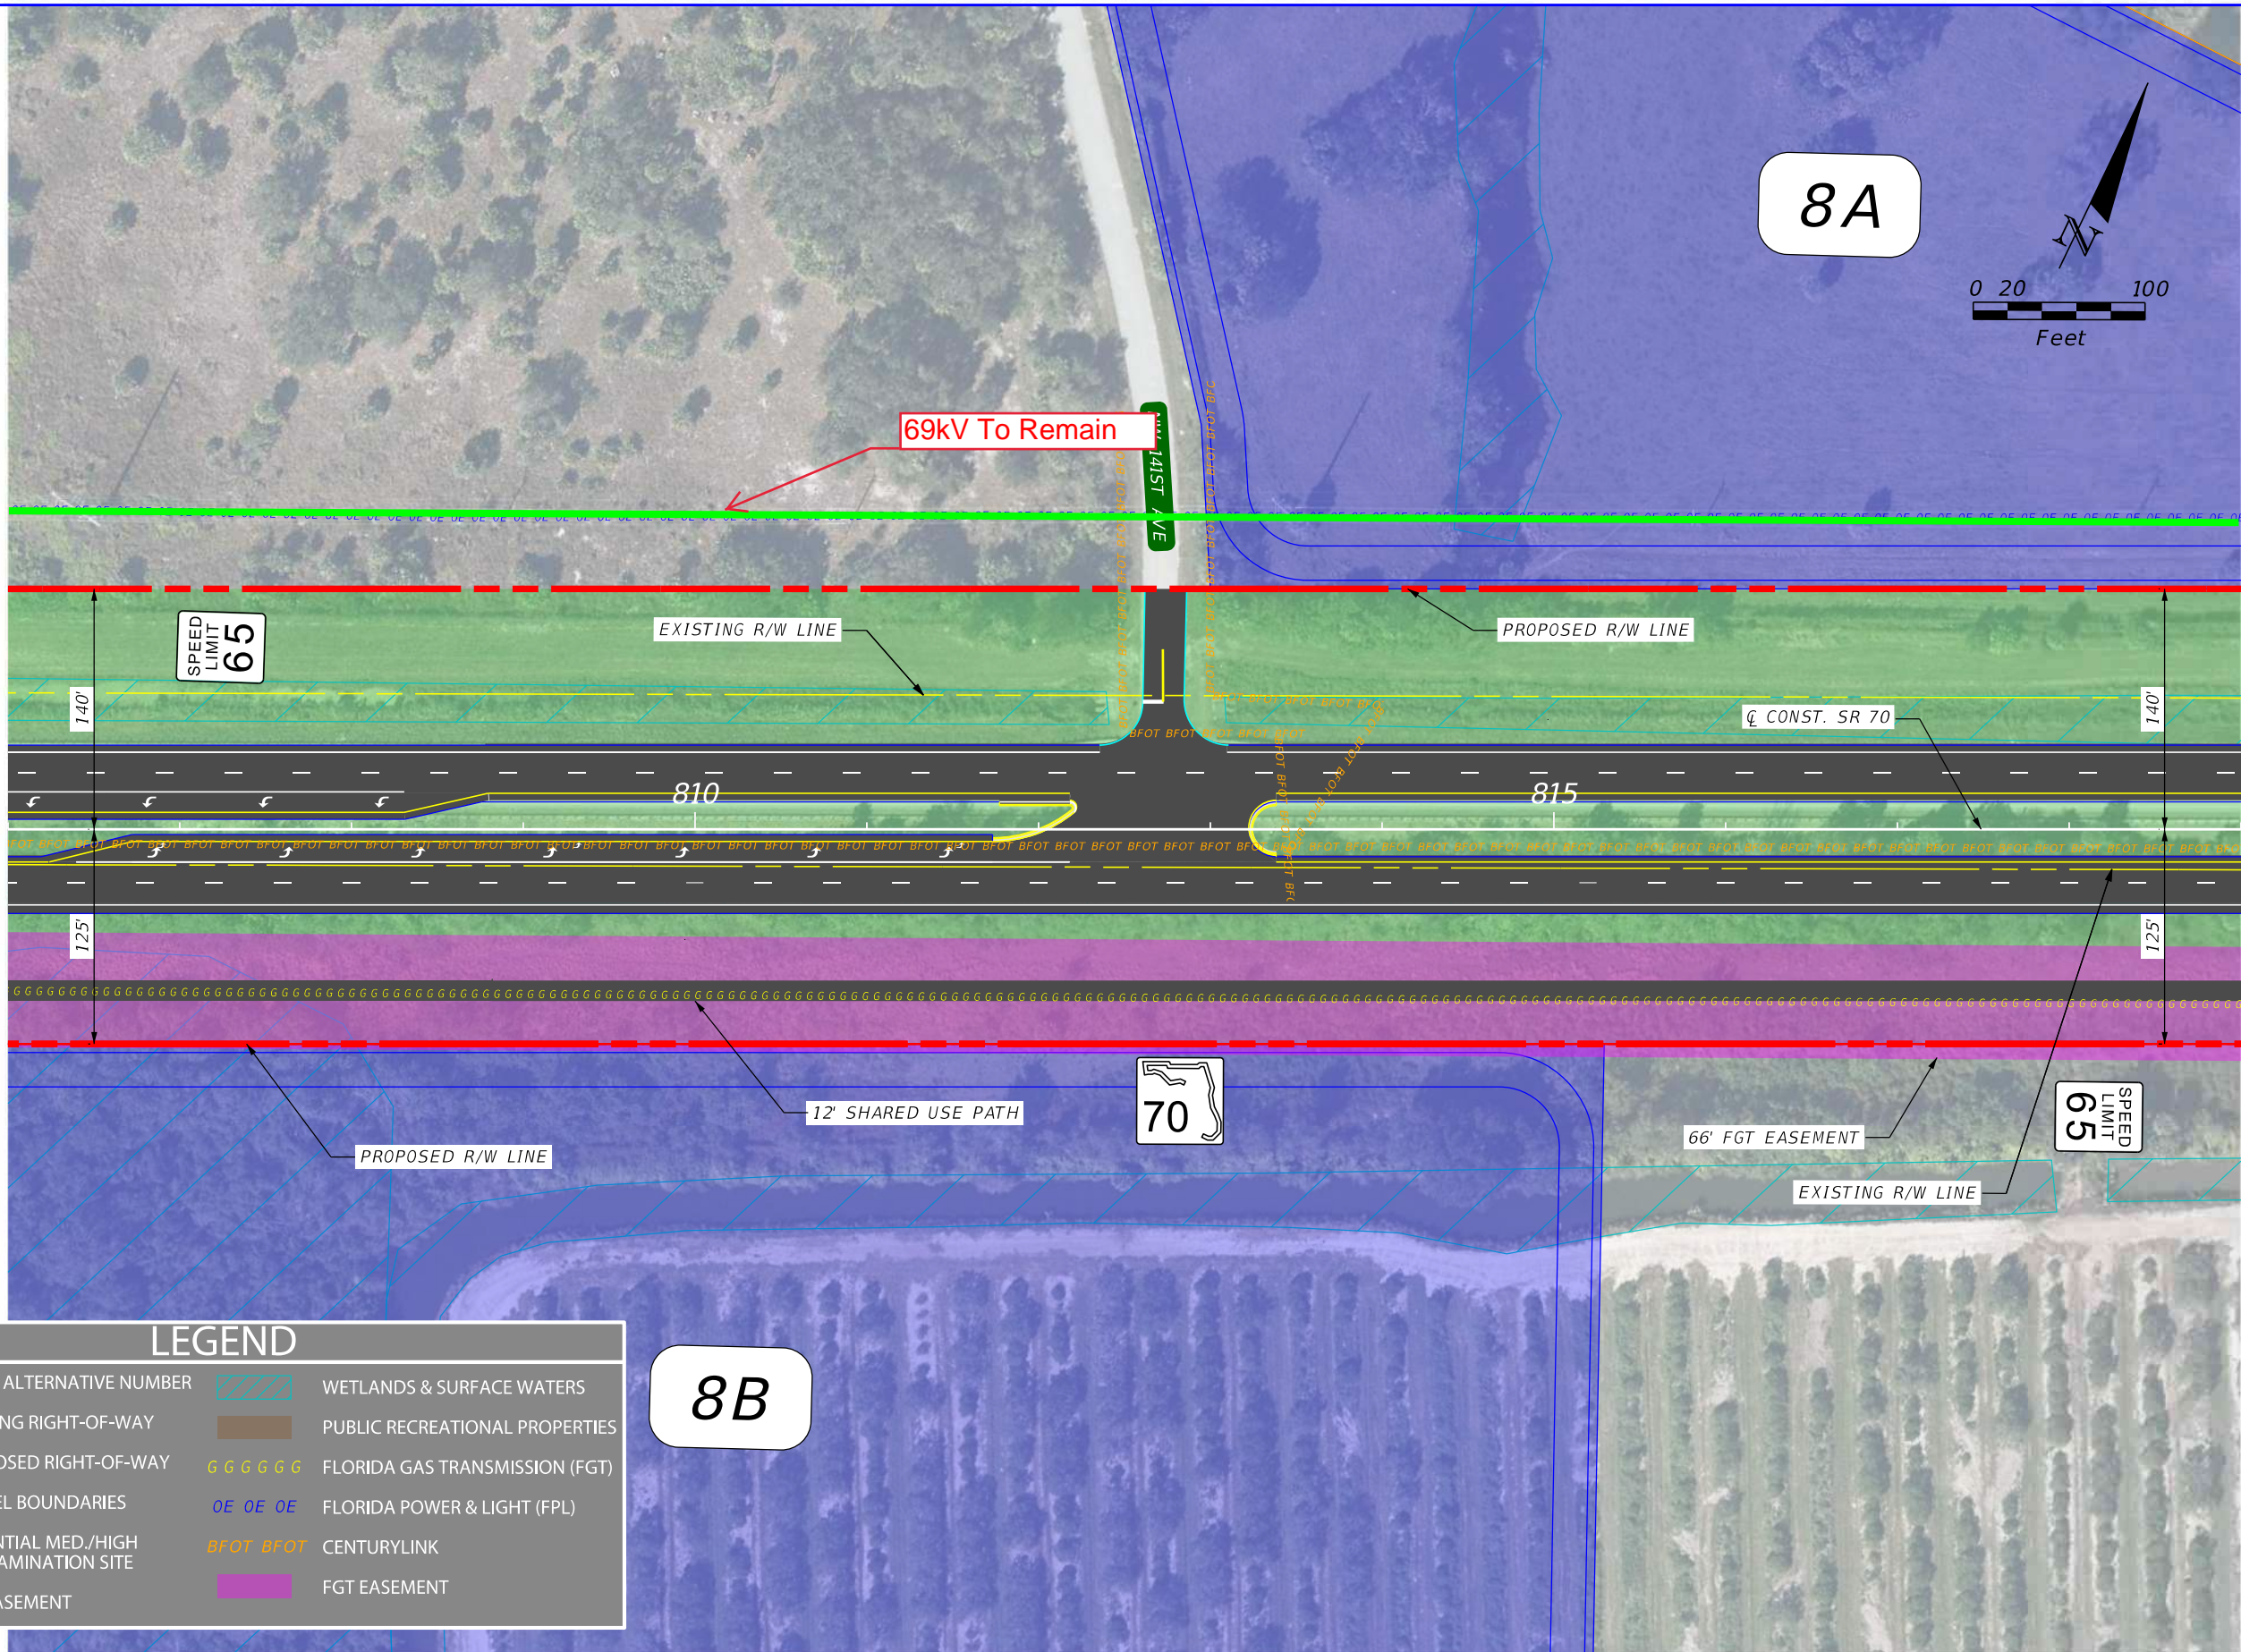

XX

POND ALTERNATIVE NUMBER

EXISTING RIGHT-OF-WAY

PROPOSED RIGHT-OF-WAY

PARCEL BOUNDARIES

▲

POTENTIAL MED./HIGH CONTAMINATION SITE

FPL EASEMENT

WETLANDS & SURFACE WATERS

PUBLIC RECREATIONAL PROPERTIES

GGGGGG

FLORIDA GAS TRANSMISSION (FGT)

OE OE OE


FLORIDA POWER & LIGHT (FPL)

BFOT BFOT

CENTURYLINK


FGT EASEMENT

REVISIONS				ENGINEER OF RECORD		STATE OF FLORIDA DEPARTMENT OF TRANSPORTATION		ALTERNATIVE 1 CONCEPT PLAN	SHEET NO. 30
DATE	DESCRIPTION	DATE	DESCRIPTION	NICHOLAS JOHN CLAVELO LICENSE NUMBER: 84366 SCALAR CONSULTING GROUP INC. 5713 CORPORATE WAY, SUITE 200 WEST PALM BEACH, FLORIDA 33407		ROAD NO.	COUNTY		
						SR 70	HIGHLANDS OKEECHOBEE	FINANCIAL PROJECT ID 450334-1-22-01	

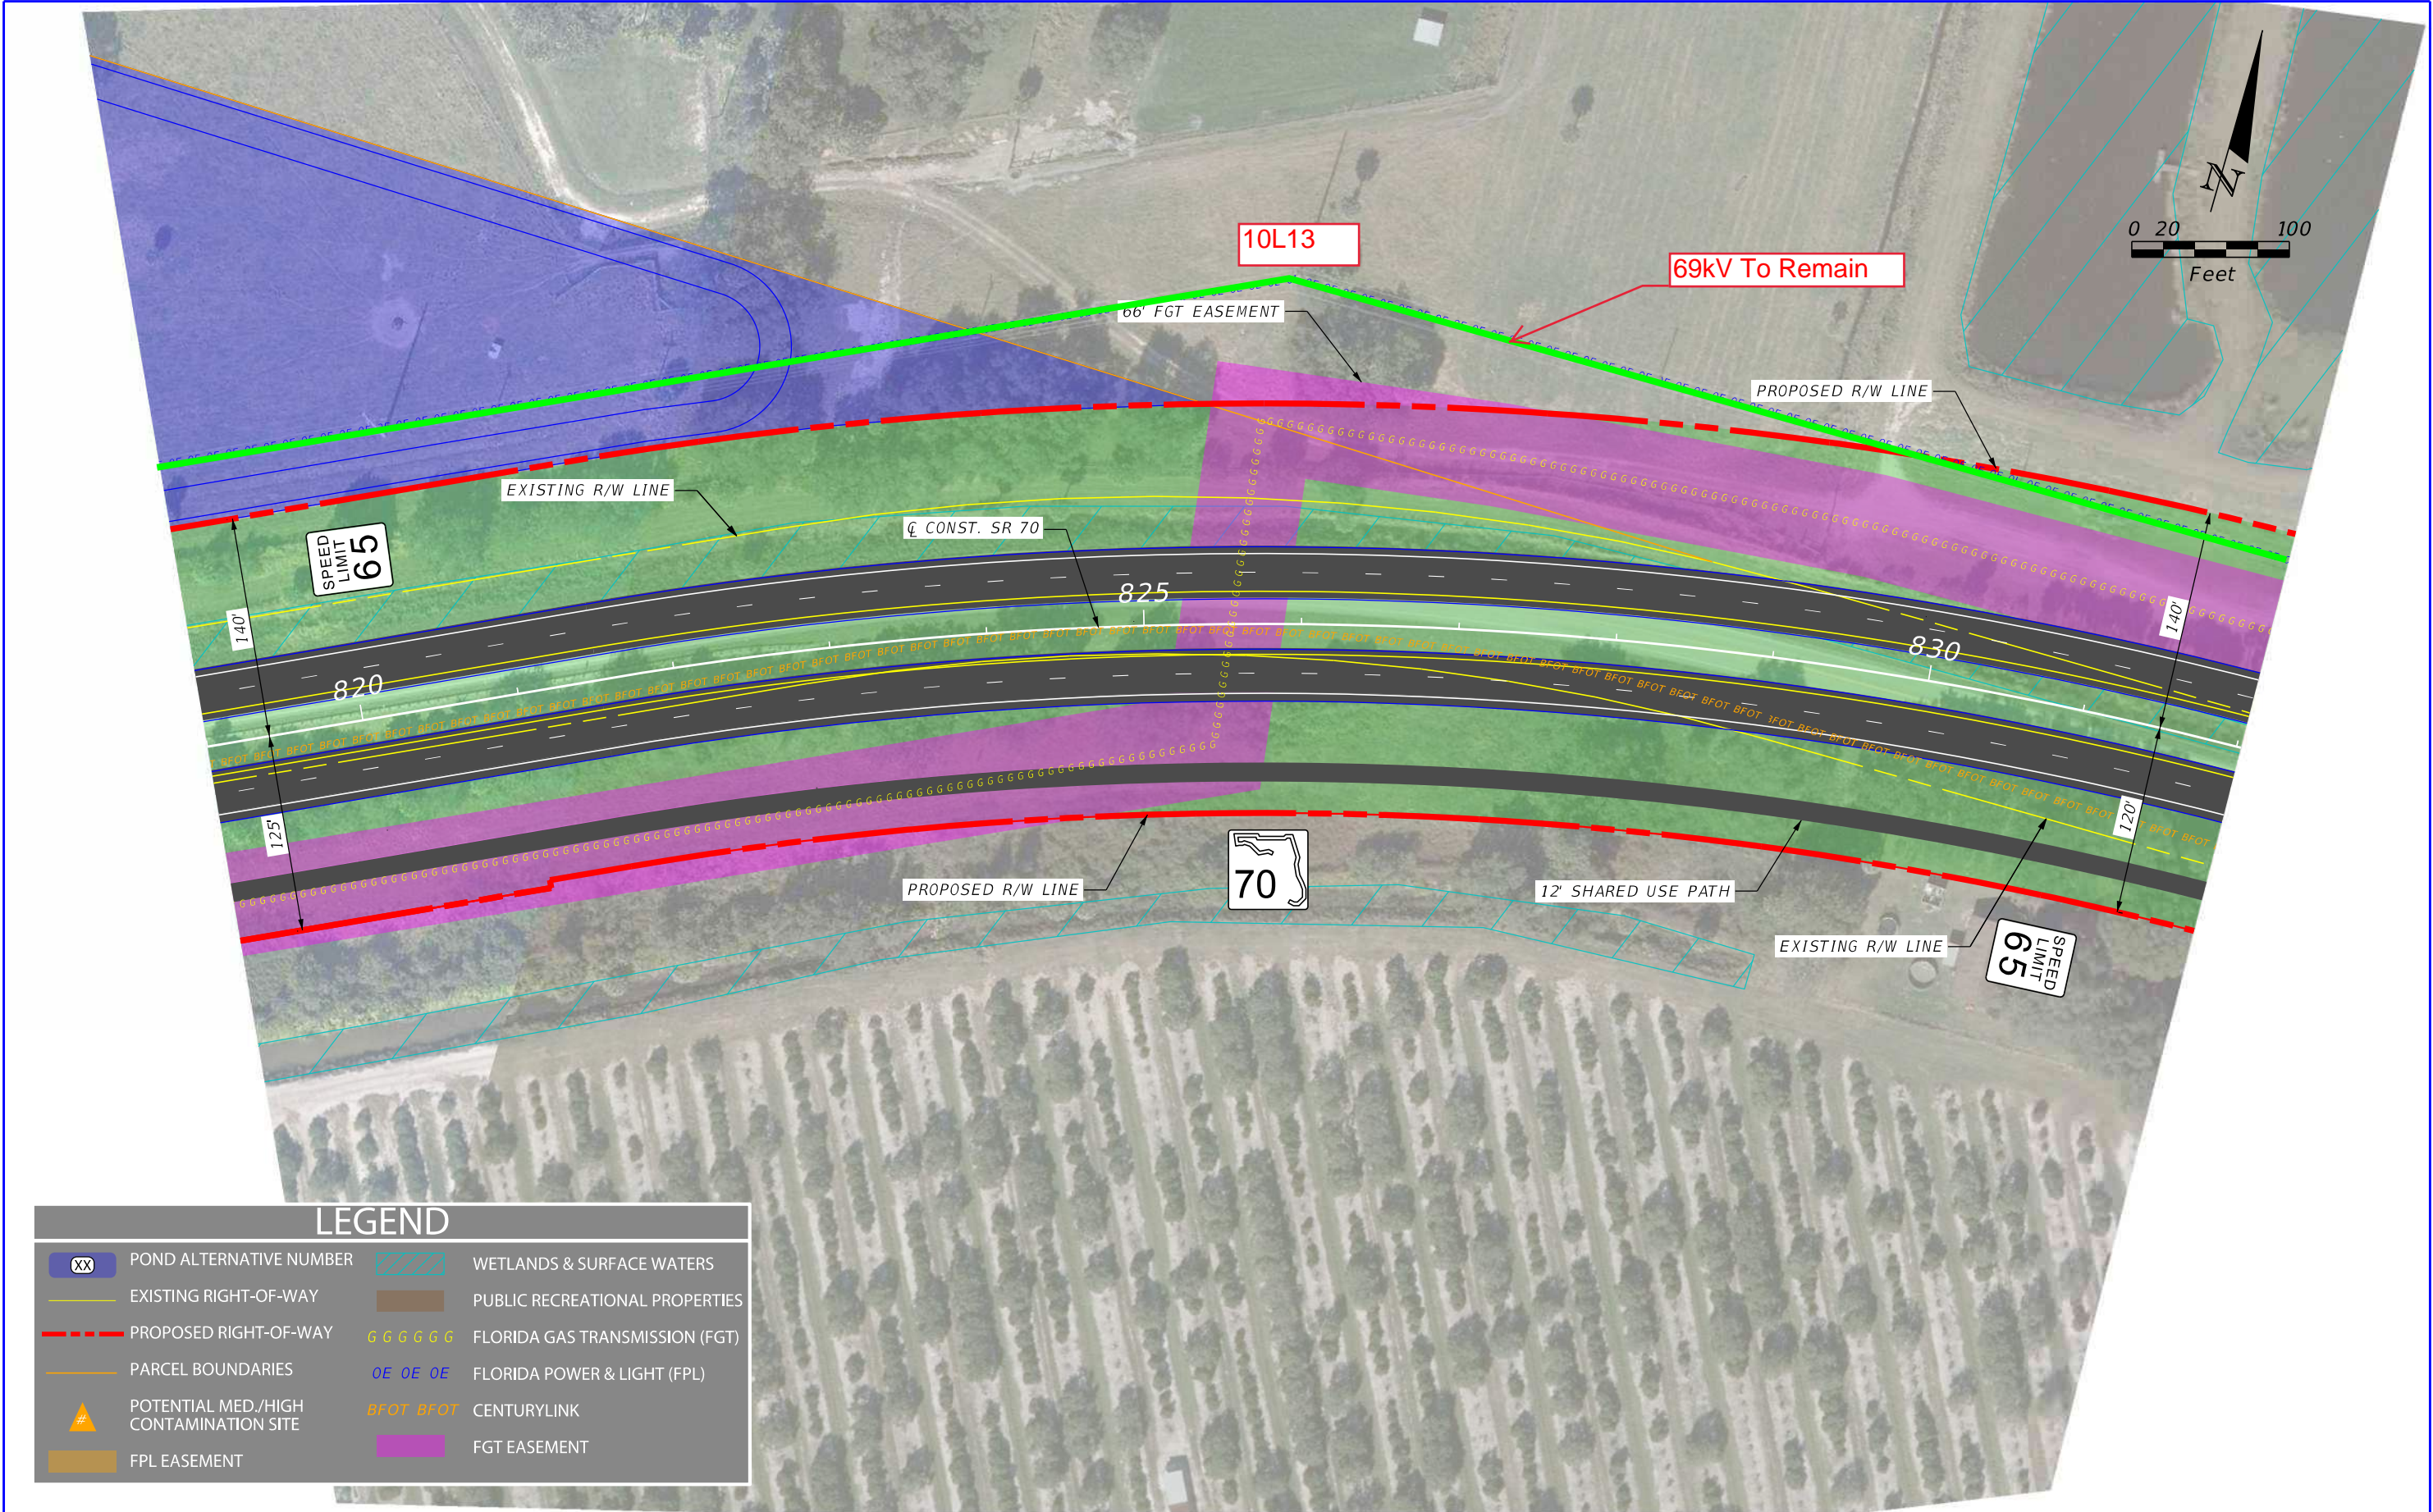


REVISIONS				ENGINEER OF RECORD	STATE OF FLORIDA DEPARTMENT OF TRANSPORTATION			SHEET NO.
DATE	DESCRIPTION	DATE	DESCRIPTION		ROAD NO.	COUNTY	FINANCIAL PROJECT ID	
					SR 70	HIGHLANDS OKEECHOBEE	450334-1-22-01	

ALTERNATIVE 1
CONCEPT PLAN

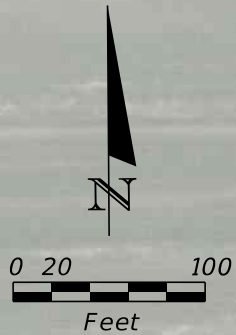

LEGEND			
<div>XX</div>	POND ALTERNATIVE NUMBER	<div></div>	WETLANDS & SURFACE WATERS
<div></div>	EXISTING RIGHT-OF-WAY	<div></div>	PUBLIC RECREATIONAL PROPERTIES
<div></div>	PROPOSED RIGHT-OF-WAY	<div>GGGGGG</div>	FLORIDA GAS TRANSMISSION (FGT)
<div></div>	PARCEL BOUNDARIES	<div>OE OE OE</div>	FLORIDA POWER & LIGHT (FPL)
<div>#</div>	POTENTIAL MED./HIGH CONTAMINATION SITE	<div>BPOT BPOT</div>	CENTURYLINK
<div></div>	FPL EASEMENT	<div></div>	FGT EASEMENT


REVISIONS				ENGINEER OF RECORD	STATE OF FLORIDA DEPARTMENT OF TRANSPORTATION			ALTERNATIVE 1 CONCEPT PLAN	SHEET NO.
DATE	DESCRIPTION	DATE	DESCRIPTION	NICHOLAS JOHN CLAVELO LICENSE NUMBER: 84366 SCALAR CONSULTING GROUP INC. 5713 CORPORATE WAY, SUITE 200 WEST PALM BEACH, FLORIDA 33407	ROAD NO.	COUNTY	FINANCIAL PROJECT ID		32
					SR 70	HIGHLANDS OKEECHOBEE	450334-1-22-01		

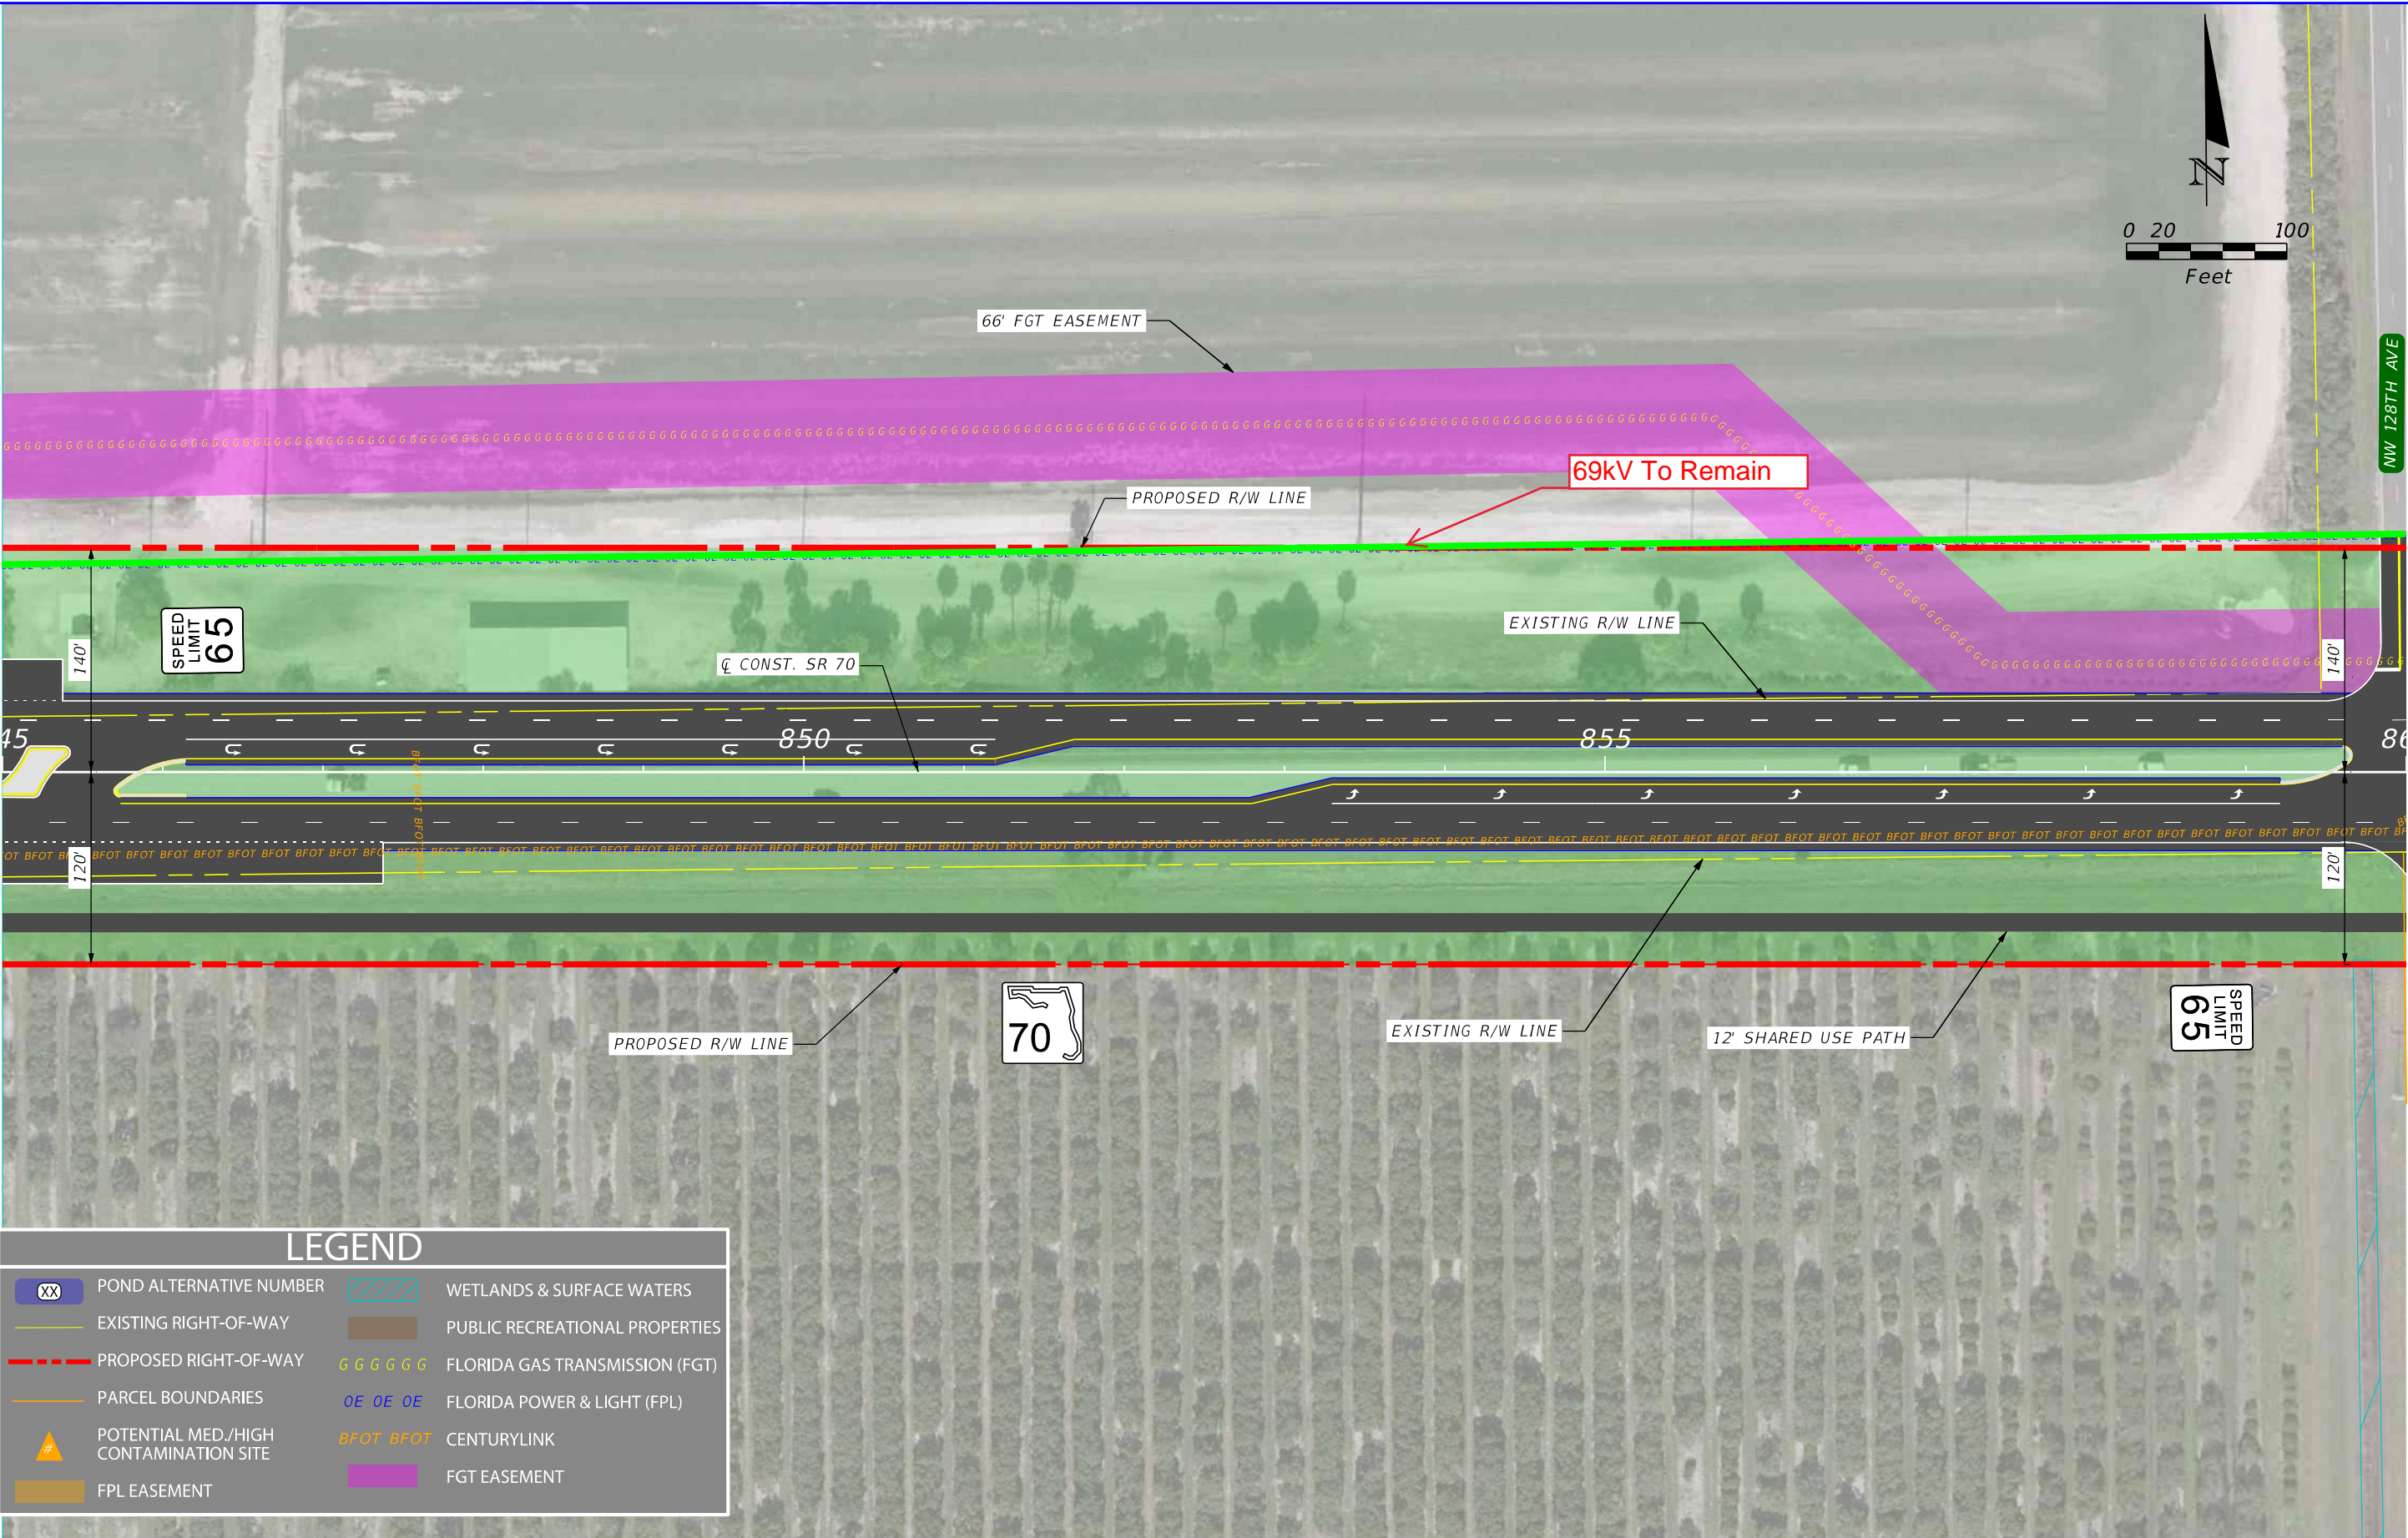


LEGEND

- | | | | |
|------|--|--|--------------------------------|
| (XX) | POND ALTERNATIVE NUMBER | | WETLANDS & SURFACE WATERS |
| | EXISTING RIGHT-OF-WAY | | PUBLIC RECREATIONAL PROPERTIES |
| | PROPOSED RIGHT-OF-WAY | | FLORIDA GAS TRANSMISSION (FGT) |
| | PARCEL BOUNDARIES | | FLORIDA POWER & LIGHT (FPL) |
| | POTENTIAL MED./HIGH CONTAMINATION SITE | | CENTURYLINK |
| | FPL EASEMENT | | FGT EASEMENT |

REVISIONS				ENGINEER OF RECORD	STATE OF FLORIDA DEPARTMENT OF TRANSPORTATION			ALTERNATIVE 1 CONCEPT PLAN	SHEET NO.
DATE	DESCRIPTION	DATE	DESCRIPTION	NICHOLAS JOHN CLAVELO LICENSE NUMBER: 84366 SCALAR CONSULTING GROUP INC. 5713 CORPORATE WAY, SUITE 200 WEST PALM BEACH, FLORIDA 33407	ROAD NO.	COUNTY	FINANCIAL PROJECT ID		33
					SR 70	HIGHLANDS OKEECHOBEE	450334-1-22-01		

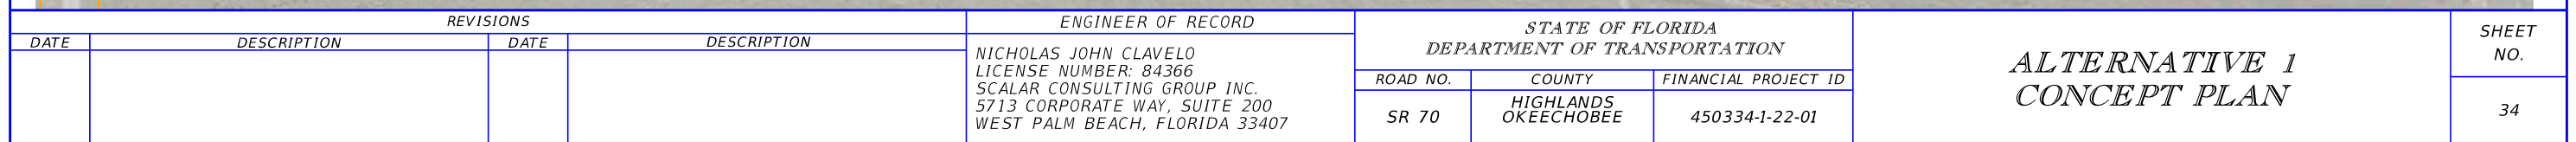

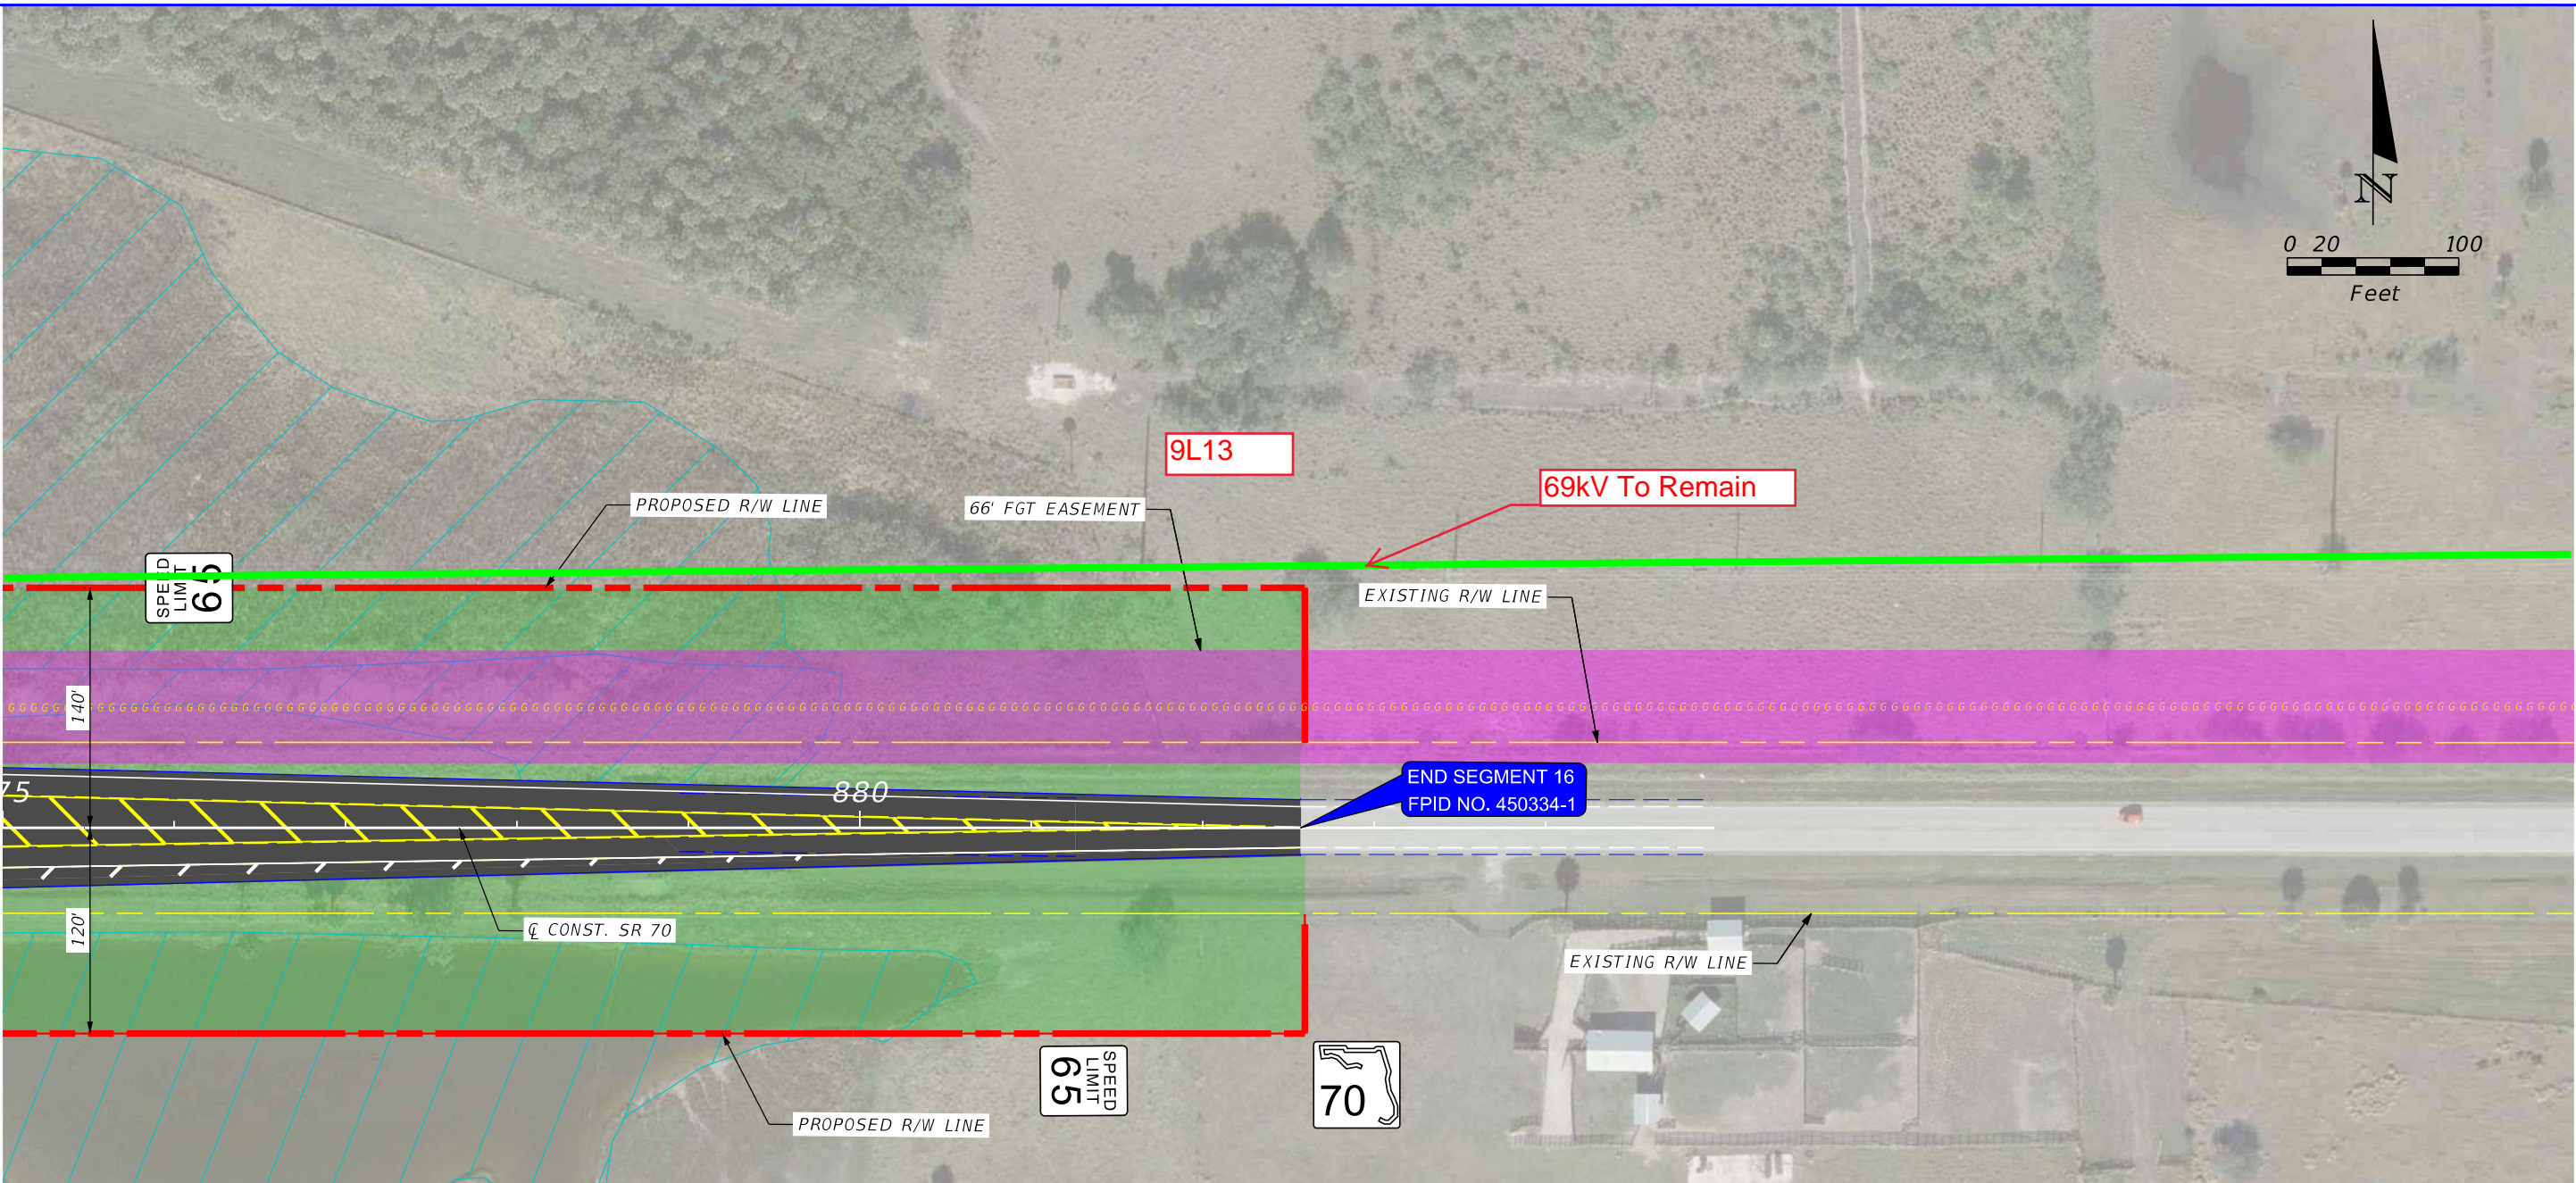

LEGEND

XX

POND ALTERNATIVE NUMBER

EXISTING RIGHT-OF-WAY

PROPOSED RIGHT-OF-WAY

PARCEL BOUNDARIES

POTENTIAL MED./HIGH CONTAMINATION SITE

FPL EASEMENT

WETLANDS & SURFACE WATERS


PUBLIC RECREATIONAL PROPERTIES

FLORIDA GAS TRANSMISSION (FGT)

FLORIDA POWER & LIGHT (FPL)

CENTURYLINK

FGT EASEMENT

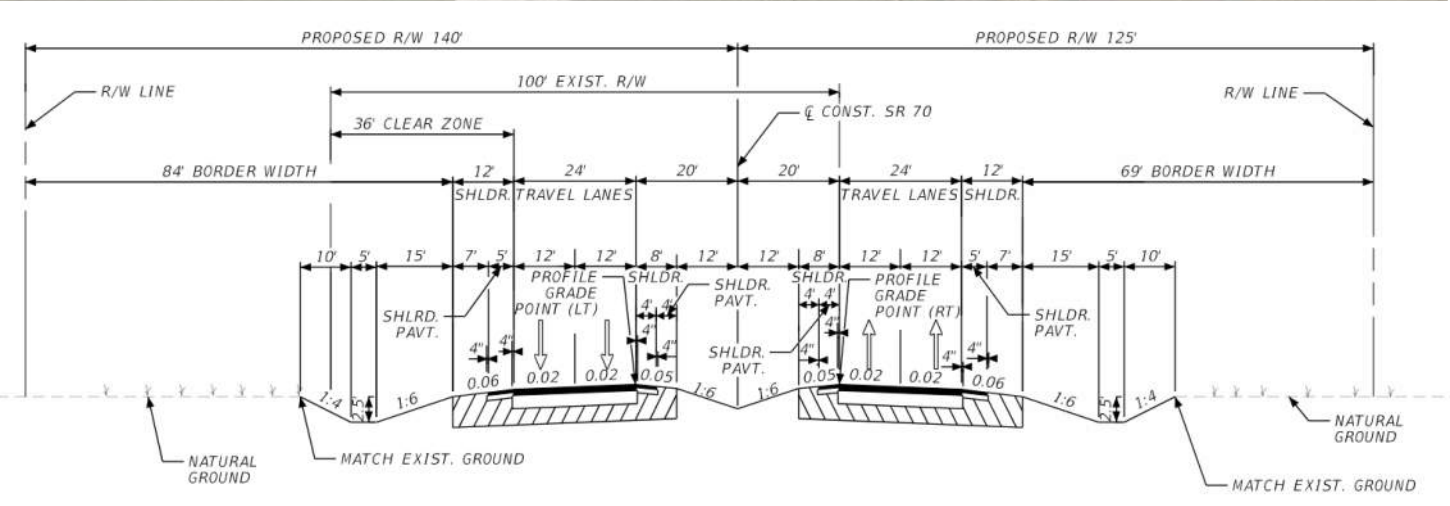

REVISIONS				ENGINEER OF RECORD	STATE OF FLORIDA DEPARTMENT OF TRANSPORTATION			SHEET NO.
DATE	DESCRIPTION	DATE	DESCRIPTION		ROAD NO.	COUNTY	FINANCIAL PROJECT ID	
					SR 70	HIGHLANDS OKEECHOBEE	450334-1-22-01	

ALTERNATIVE 1
CONCEPT PLAN

LUMEN / CENTURYLINK - LOCAL



Terra Technologies RGB Legend		CenturyLink/ Lumen Greenlines	
Red (existing to be removed)	Green (existing to remain)	Dark Green (existing and out of service)	Cyan (existing conduit, CANNOT be removed or adjusted)
Brown (proposed to be place)	Blue (proposed revisions to agency plans)		

1000	Q CONSTRUCTION	PARCEL LINE	FPC SITE
EXIST. R/W LINE	EXIST. EASEMENT	SMF SITE	
PROP. R/W LINE	PROP. TEMP. EASEMENT	PROPOSED ROADWAY	
PROP. PERP. EASEMENT	BRIDGE	MILLING AND RESURF.	

Rummel, Klepper & Kahl, LLP
402 S. Kentucky Avenue
Suite 400
Lakeland, FL 33801
FBPR C.A. NO. 26879

JASON L. LYLE, P.E. 69009

STATE OF FLORIDA DEPARTMENT OF TRANSPORTATION		
ROAD NO.	COUNTY	FINANCIAL PROJECT ID
SR 70	HIGHLANDS	449851-1-22-01 450334-1-22-01

**SR 70 PD&E STUDY
BASEMAP**

SHEET NO.
56


6/29/2023 3:27:26 PM Default \\ad.rkk.com\fs\Cloud\Projects\2020\20020_DICSCemo\Projects\DI 414506-1 SR 70 Jefferson Ave to CR 29\Eng\41450612201\Roadway\UAO\PLANRD56.dgn



<p>1000 Q CONSTRUCTION EXIST. R/W LINE PROP. R/W LINE PROP. PERP. EASEMENT PARCEL LINE EXIST. EASEMENT PROP. TEMP. EASEMENT BRIDGE</p>	<p>FPC SITE SMF SITE PROPOSED ROADWAY MILLING AND RESURF.</p>	<p>Rummel, Klepper & Kahl, LLP 402 S. Kentucky Avenue Suite 400 Lakeland, FL 33801 FBPR C.A. NO. 26879 JASON L. LYLE, P.E. 69009</p>	<table><tr><th colspan="3">STATE OF FLORIDA DEPARTMENT OF TRANSPORTATION</th></tr><tr><th>ROAD NO.</th><th>COUNTY</th><th>FINANCIAL PROJECT ID</th></tr><tr><td>SR 70</td><td>HIGHLANDS</td><td>450334-1-22-01</td></tr></table>	STATE OF FLORIDA DEPARTMENT OF TRANSPORTATION			ROAD NO.	COUNTY	FINANCIAL PROJECT ID	SR 70	HIGHLANDS	450334-1-22-01	<p>SR 70 PD&E STUDY BASEMAP</p>	<table><tr><td>SHEET NO.</td></tr><tr><td>57</td></tr></table>	SHEET NO.	57
STATE OF FLORIDA DEPARTMENT OF TRANSPORTATION																
ROAD NO.	COUNTY	FINANCIAL PROJECT ID														
SR 70	HIGHLANDS	450334-1-22-01														
SHEET NO.																
57																


All CenturyLink facilities (peds, MH, cable and fiber optic) locations are approximate. Call 811 for locates before digging.
Level D Mark ups - records used

MATCH LINE STA. 2598+50.00

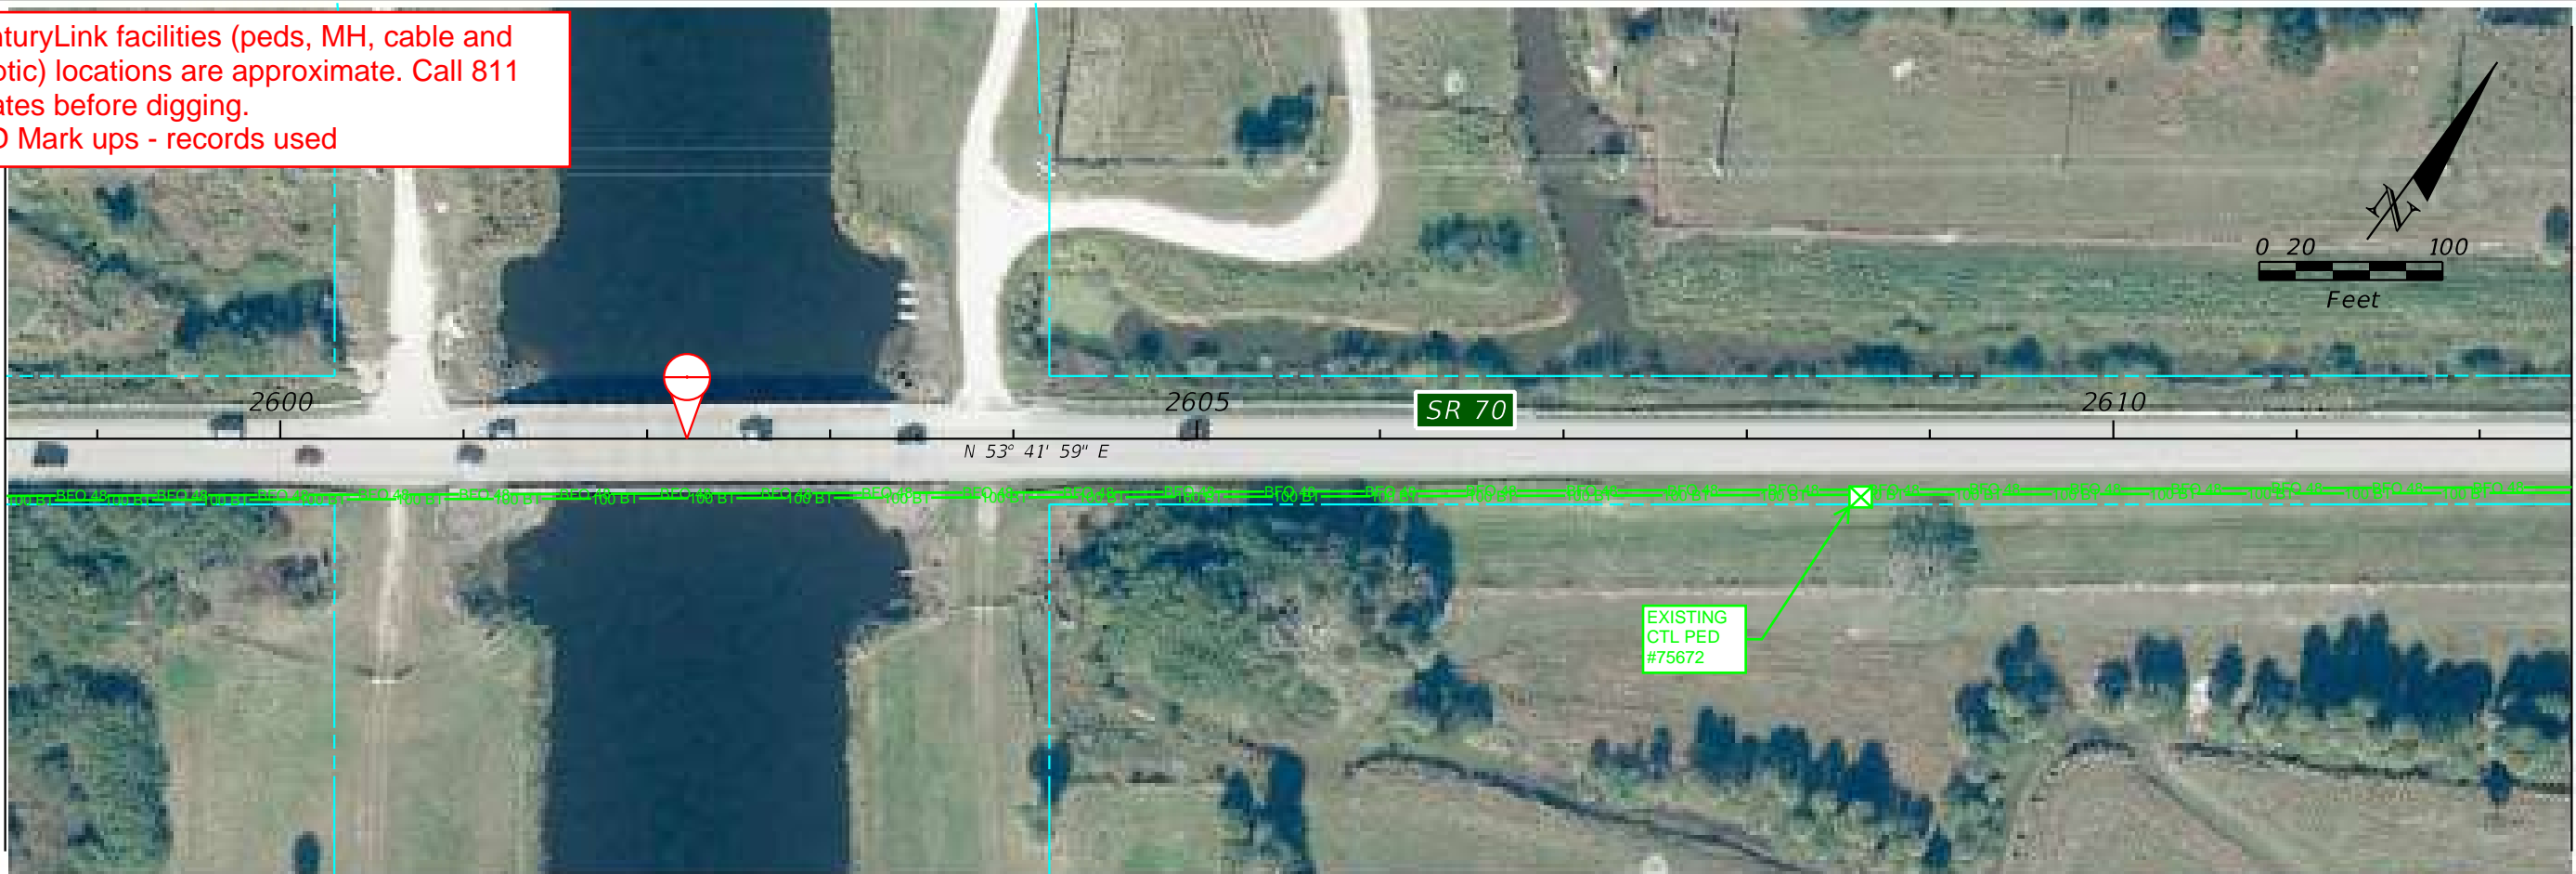

MATCH LINE STA. 2612+50.00

All CenturyLink facilities (peds, MH, cable and fiber optic) locations are approximate. Call 811 for locates before digging.
Level D Mark ups - records used

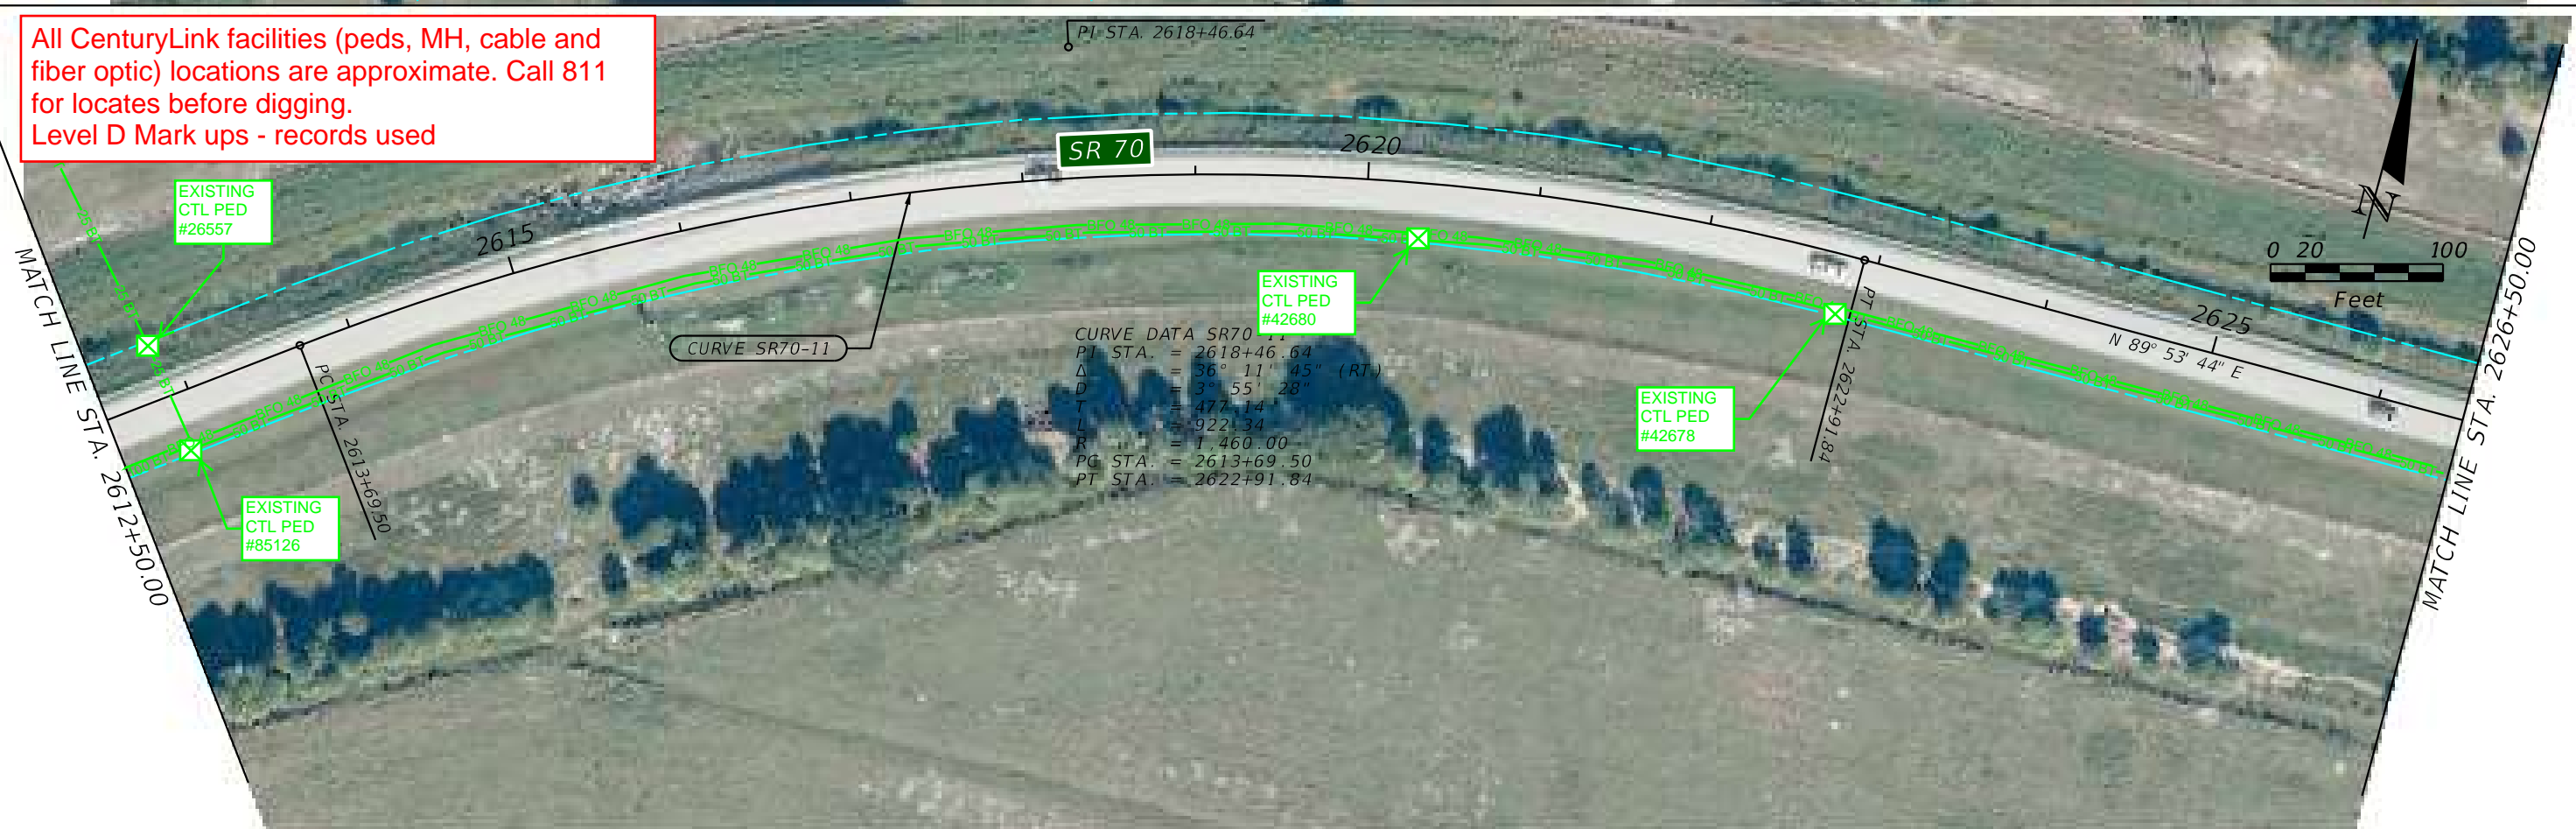


1000	Q CONSTRUCTION	PARCEL LINE	FPC SITE
---	EXIST. R/W LINE	EXIST. EASEMENT	SMF SITE
---	PROP. R/W LINE	PROP. TEMP. EASEMENT	PROPOSED ROADWAY
---	PROP. PERP. EASEMENT	BRIDGE	MILLING AND RESURF.

RK&K
Rummel, Klepper & Kahl, LLP
402 S. Kentucky Avenue
Suite 400
Lakeland, FL 33801
FBPR C.A. NO. 26879
JASON L. LYLE, P.E. 69009

STATE OF FLORIDA DEPARTMENT OF TRANSPORTATION		
ROAD NO.	COUNTY	FINANCIAL PROJECT ID
SR 70	HIGHLANDS	450334-1-22-01

**SR 70 PD&E STUDY
BASEMAP**

SHEET NO.
58

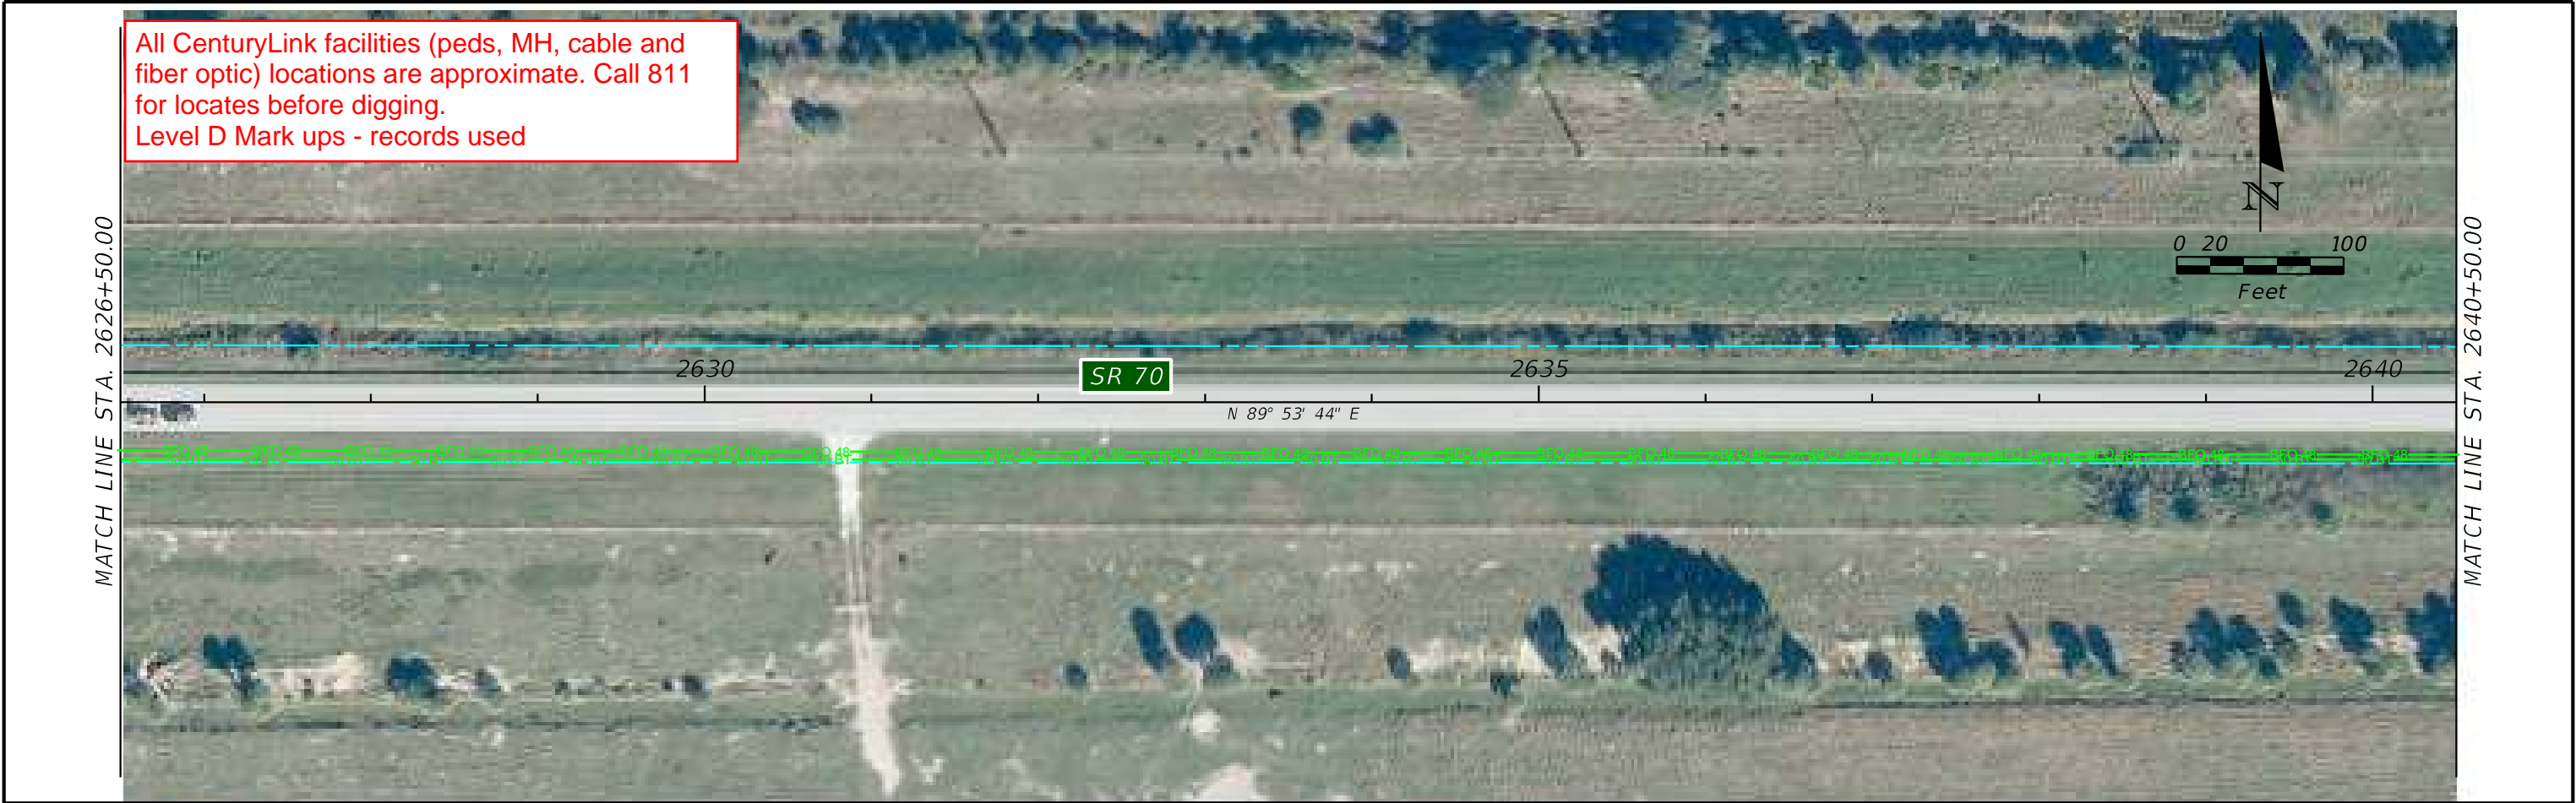

<div><div>1000</div><div>Q CONSTRUCTION</div><div>EXIST. R/W LINE</div><div>PROP. R/W LINE</div><div>PROP. PERP. EASEMENT</div></div> <div><div>PARCEL LINE</div><div>EXIST. EASEMENT</div><div>PROP. TEMP. EASEMENT</div><div>BRIDGE</div></div> <div><div>FPC SITE</div><div>SMF SITE</div><div>PROPOSED ROADWAY</div><div>MILLING AND RESURF.</div></div>	<div><div><div><div><div>RK&K</div><div>Rummel, Klepper & Kahl, LLP</div><div>402 S. Kentucky Avenue</div><div>Suite 400</div><div>Lakeland, FL 33801</div><div>FBPR C.A. NO. 26879</div></div><div>JASON L. LYLE, P.E. 69009</div></div><div><div>STATE OF FLORIDA</div><div>DEPARTMENT OF TRANSPORTATION</div><table><tr><td>ROAD NO.</td><td>COUNTY</td><td>FINANCIAL PROJECT ID</td></tr><tr><td>SR 70</td><td>HIGHLANDS</td><td>450334-1-22-01</td></tr></table></div><div><div>SR 70 PD&E STUDY</div><div>BASEMAP</div></div></div><div><div>SHEET NO.</div><div>59</div></div></div>	ROAD NO.	COUNTY	FINANCIAL PROJECT ID	SR 70	HIGHLANDS	450334-1-22-01
ROAD NO.	COUNTY	FINANCIAL PROJECT ID					
SR 70	HIGHLANDS	450334-1-22-01					



<p>1000 Q CONSTRUCTION EXIST. R/W LINE PROP. R/W LINE PROP. PERP. EASEMENT</p>		<p>PARCEL LINE EXIST. EASEMENT PROP. TEMP. EASEMENT BRIDGE</p>		<p>FPC SITE SMF SITE PROPOSED ROADWAY MILLING AND RESURF.</p>		<p>Rummel, Klepper & Kahl, LLP 402 S. Kentucky Avenue Suite 400 Lakeland, FL 33801 FBPR C.A. NO. 26879 JASON L. LYLE, P.E. 69009</p>		<p>STATE OF FLORIDA DEPARTMENT OF TRANSPORTATION</p> <table border="1"><tr><td>ROAD NO.</td><td>COUNTY</td><td>FINANCIAL PROJECT ID</td></tr><tr><td>SR 70</td><td>HIGHLANDS</td><td>450334-1-22-01</td></tr></table>		ROAD NO.	COUNTY	FINANCIAL PROJECT ID	SR 70	HIGHLANDS	450334-1-22-01	<p>SR 70 PD&E STUDY BASEMAP</p>		<p>SHEET NO. 60</p>	
ROAD NO.	COUNTY	FINANCIAL PROJECT ID																	
SR 70	HIGHLANDS	450334-1-22-01																	

jgalgano 6/29/2023 3:27:47 PM Default \\ad.rkk.com\fs\Cloud\Projects\2020\20020_DICSCemo\Projects\DI 414506-1 SR 70 Jefferson Ave to CR 29\Eng\41450612201\Roadway\UAO\PLANRD60.dgn

THE OFFICIAL RECORD OF THIS SHEET IS THE ELECTRONIC FILE DIGITALLY SIGNED AND SEALED UNDER RULE 61G15-23.004, F.A.C.



<p>1000 Q CONSTRUCTION --- EXIST. R/W LINE --- PROP. R/W LINE --- PROP. PERP. EASEMENT --- PARCEL LINE --- EXIST. EASEMENT --- PROP. TEMP. EASEMENT BRIDGE FPC SITE SMF SITE PROPOSED ROADWAY MILLING AND RESURF.</p>		<p>Rummel, Klepper & Kahl, LLP 402 S. Kentucky Avenue Suite 400 Lakeland, FL 33801 FBPR C.A. NO. 26879 JASON L. LYLE, P.E. 69009</p>	<table><tr><th colspan="3">STATE OF FLORIDA DEPARTMENT OF TRANSPORTATION</th></tr><tr><th>ROAD NO.</th><th>COUNTY</th><th>FINANCIAL PROJECT ID</th></tr><tr><td>SR 70</td><td>HIGHLANDS</td><td>450334-1-22-01</td></tr></table>	STATE OF FLORIDA DEPARTMENT OF TRANSPORTATION			ROAD NO.	COUNTY	FINANCIAL PROJECT ID	SR 70	HIGHLANDS	450334-1-22-01	<p>SR 70 PD&E STUDY BASEMAP</p>	<table><tr><th>SHEET NO.</th></tr><tr><td>61</td></tr></table>	SHEET NO.	61
STATE OF FLORIDA DEPARTMENT OF TRANSPORTATION																
ROAD NO.	COUNTY	FINANCIAL PROJECT ID														
SR 70	HIGHLANDS	450334-1-22-01														
SHEET NO.																
61																

jgalgano 6/29/2023 3:27:52 PM Default \\ad.rkk.com\fs\Cloud\Projects\2020\20020_DICSCMO\Projects\DI 414506-1 SR 70 Jefferson Ave to CR 29\Eng\41450612201\Roadway\UAO\PLANRD61.dgn

THE OFFICIAL RECORD OF THIS SHEET IS THE ELECTRONIC FILE DIGITALLY SIGNED AND SEALED UNDER RULE 61G15-23.004, F.A.C.








<p>1000' Q CONSTRUCTION --- EXIST. R/W LINE --- PROP. R/W LINE --- PROP. PERP. EASEMENT --- PARCEL LINE --- EXIST. EASEMENT --- PROP. TEMP. EASEMENT BRIDGE FPC SITE SMF SITE PROPOSED ROADWAY MILLING AND RESURF.</p>		<p>Rummel, Klepper & Kahl, LLP 402 S. Kentucky Avenue Suite 400 Lakeland, FL 33801 FBPR C.A. NO. 26879 JASON L. LYLE, P.E. 69009</p>	<p>STATE OF FLORIDA DEPARTMENT OF TRANSPORTATION</p> <table border="1"><tr><td>ROAD NO.</td><td>COUNTY</td><td>FINANCIAL PROJECT ID</td></tr><tr><td>SR 70</td><td>HIGHLANDS</td><td>450334-1-22-01</td></tr></table>	ROAD NO.	COUNTY	FINANCIAL PROJECT ID	SR 70	HIGHLANDS	450334-1-22-01	<p>SR 70 PD&E STUDY BASEMAP</p>	<p>SHEET NO. 64</p>
ROAD NO.	COUNTY	FINANCIAL PROJECT ID									
SR 70	HIGHLANDS	450334-1-22-01									

6/29/2023 3:28:05 PM Default \\ad.rkk.com\fs\Cloud\Projects\2020\20020_DICSCemo\Projects\DI 414506-1 SR 70 Jefferson Ave to CR 29\Eng\41450612201\Roadway\UAO\PLANRD64.dgn

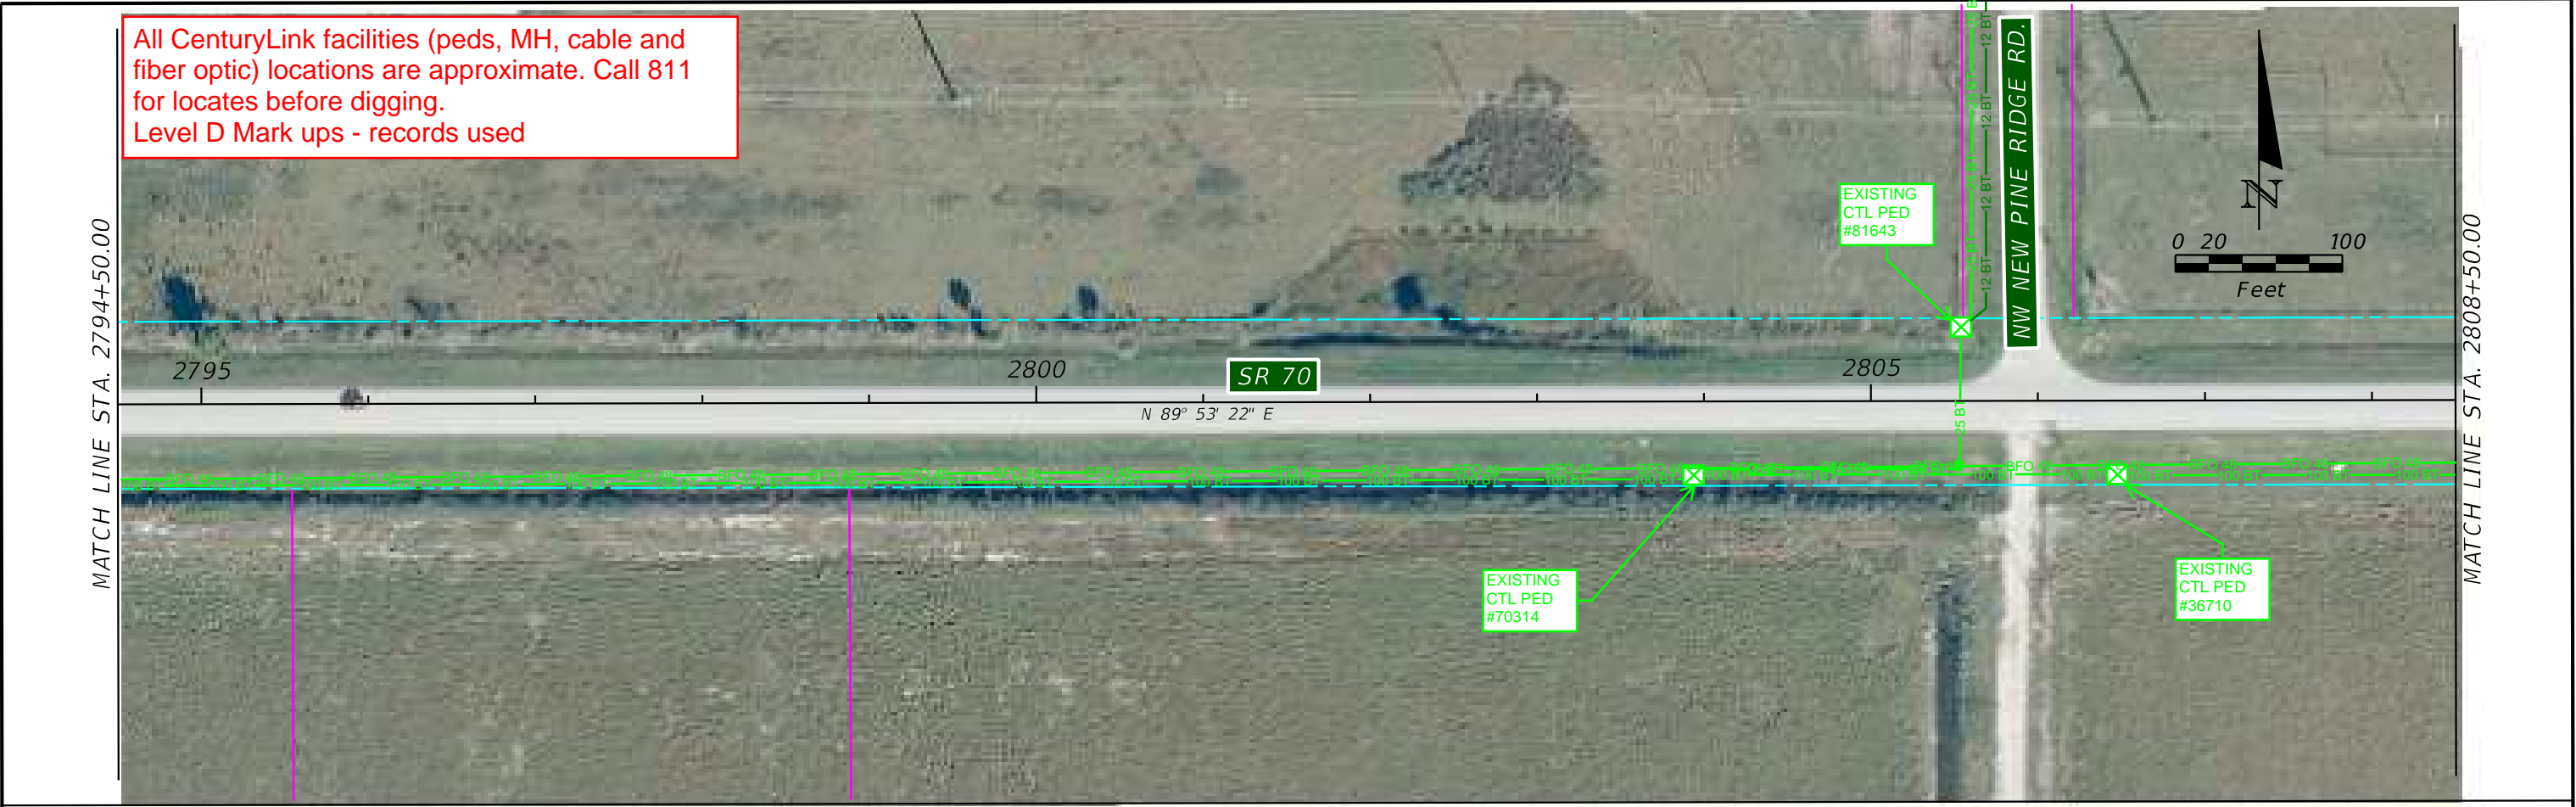

<p>1000' Q CONSTRUCTION --- EXIST. R/W LINE --- PROP. R/W LINE --- PROP. PERP. EASEMENT --- PARCEL LINE --- EXIST. EASEMENT --- PROP. TEMP. EASEMENT --- BRIDGE FPC SITE SMF SITE PROPOSED ROADWAY MILLING AND RESURF.</p>	<p>Rummel, Klepper & Kahl, LLP 402 S. Kentucky Avenue Suite 400 Lakeland, FL 33801 FBPR C.A. NO. 26879 JASON L. LYLE, P.E. 69009</p>	<table border="1"><tr><th colspan="3">STATE OF FLORIDA DEPARTMENT OF TRANSPORTATION</th></tr><tr><td>ROAD NO.</td><td>COUNTY</td><td>FINANCIAL PROJECT ID</td></tr><tr><td>SR 70</td><td>HIGHLANDS</td><td>450334-1-22-01</td></tr></table>	STATE OF FLORIDA DEPARTMENT OF TRANSPORTATION			ROAD NO.	COUNTY	FINANCIAL PROJECT ID	SR 70	HIGHLANDS	450334-1-22-01	<p>SR 70 PD&E STUDY BASEMAP</p>	<p>SHEET NO. 65</p>
STATE OF FLORIDA DEPARTMENT OF TRANSPORTATION													
ROAD NO.	COUNTY	FINANCIAL PROJECT ID											
SR 70	HIGHLANDS	450334-1-22-01											

6/29/2023 3:28:09 PM Default

\\ad.rkk.com\fs\Cloud\Projects\2020\20020_DICSCEMO\Projects\DI 414506-1 SR 70 Jefferson Ave to CR 29\Eng\41450612201\Roadway\UAO\PLANRD65.dgn

THE OFFICIAL RECORD OF THIS SHEET IS THE ELECTRONIC FILE DIGITALLY SIGNED AND SEALED UNDER RULE 61G15-23.004, F.A.C.


All CenturyLink facilities (peds, MH, cable and fiber optic) locations are approximate. Call 811 for locates before digging.
Level D Mark ups - records used

MATCH LINE STA. 2822+50.00



MATCH LINE STA. 2836+50.00

MATCH LINE STA. 2836+50.00

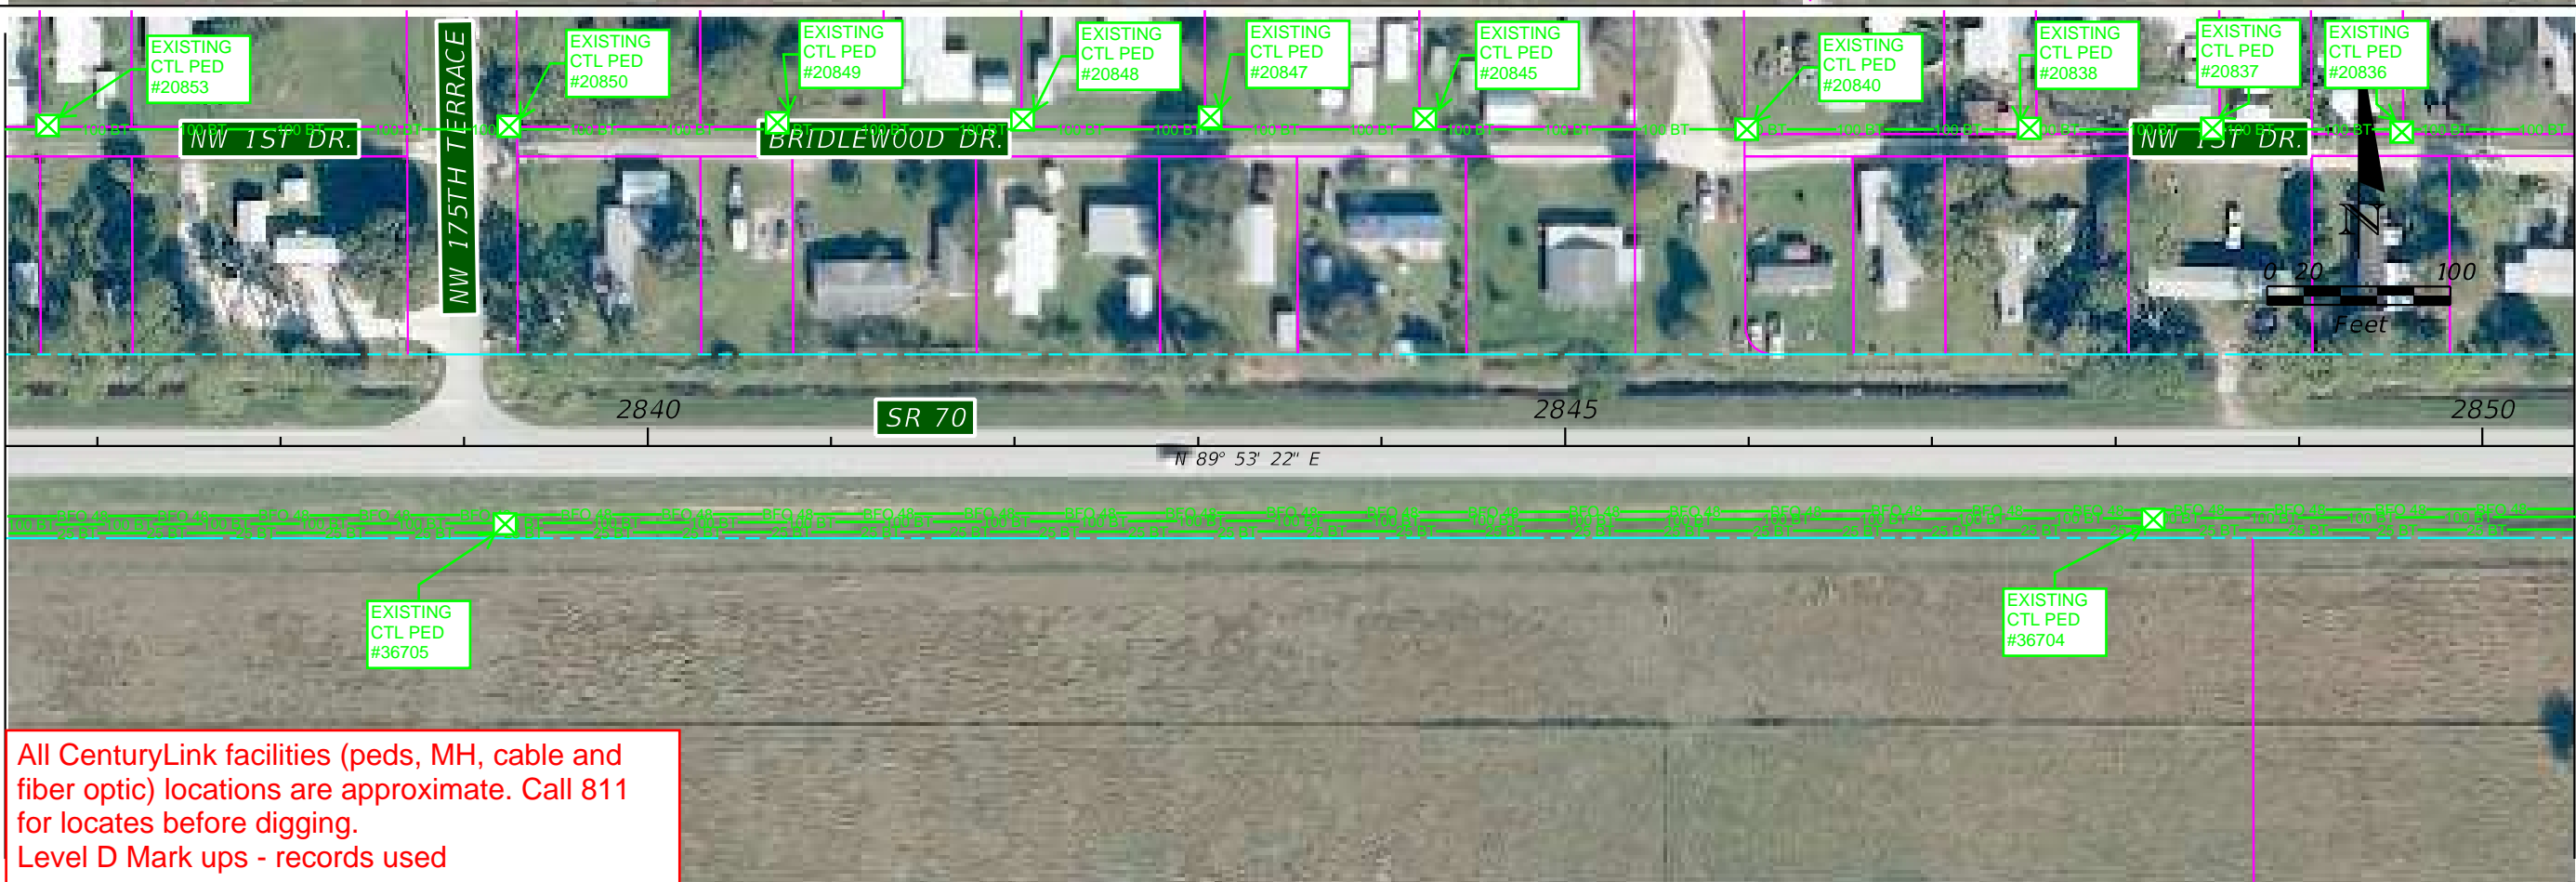

MATCH LINE STA. 2850+50.00

All CenturyLink facilities (peds, MH, cable and fiber optic) locations are approximate. Call 811 for locates before digging.
Level D Mark ups - records used


1000	Q CONSTRUCTION	PARCEL LINE	FPC SITE
---	EXIST. R/W LINE	EXIST. EASEMENT	SMF SITE
---	PROP. R/W LINE	PROP. TEMP. EASEMENT	PROPOSED ROADWAY
---	PROP. PERP. EASEMENT	BRIDGE	MILLING AND RESURF.

RK&K
Rummel, Klepper & Kahl, LLP
402 S. Kentucky Avenue
Suite 400
Lakeland, FL 33801
FBPR C.A. NO. 26879
JASON L. LYLE, P.E. 69009

STATE OF FLORIDA DEPARTMENT OF TRANSPORTATION		
ROAD NO.	COUNTY	FINANCIAL PROJECT ID
SR 70	HIGHLANDS	450334-1-22-01

**SR 70 PD&E STUDY
BASEMAP**

SHEET NO.
66

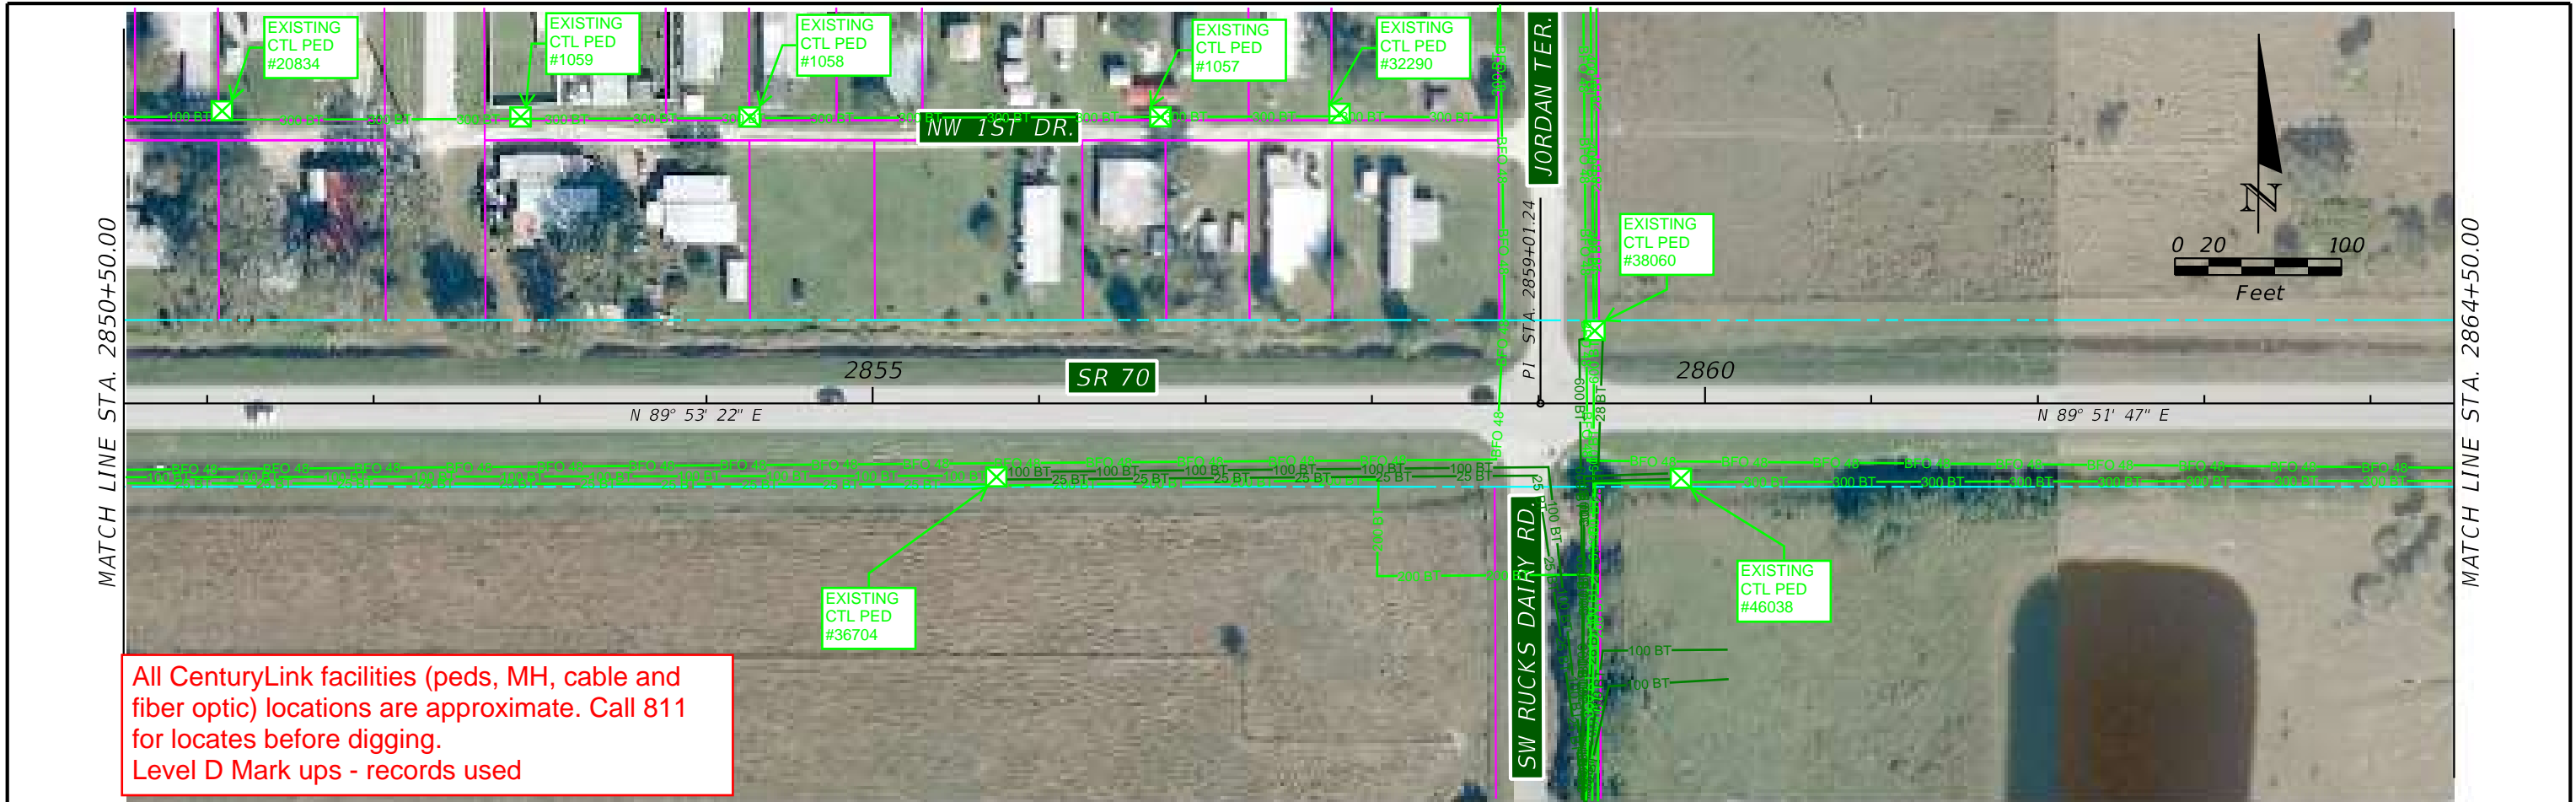


<p>1000 Q CONSTRUCTION --- EXIST. R/W LINE --- PROP. R/W LINE --- PROP. PERP. EASEMENT --- PARCEL LINE --- EXIST. EASEMENT --- PROP. TEMP. EASEMENT BRIDGE FPC SITE SMF SITE PROPOSED ROADWAY MILLING AND RESURF.</p>		<p>Rummel, Klepper & Kahl, LLP 402 S. Kentucky Avenue Suite 400 Lakeland, FL 33801 FBPR C.A. NO. 26879 JASON L. LYLE, P.E. 69009</p>	<table border="1"><tr><th colspan="3">STATE OF FLORIDA DEPARTMENT OF TRANSPORTATION</th></tr><tr><th>ROAD NO.</th><th>COUNTY</th><th>FINANCIAL PROJECT ID</th></tr><tr><td>SR 70</td><td>HIGHLANDS</td><td>450334-1-22-01</td></tr></table>	STATE OF FLORIDA DEPARTMENT OF TRANSPORTATION			ROAD NO.	COUNTY	FINANCIAL PROJECT ID	SR 70	HIGHLANDS	450334-1-22-01	<p>SR 70 PD&E STUDY BASEMAP</p>	<table border="1"><tr><td>SHEET NO.</td></tr><tr><td>67</td></tr></table>	SHEET NO.	67
STATE OF FLORIDA DEPARTMENT OF TRANSPORTATION																
ROAD NO.	COUNTY	FINANCIAL PROJECT ID														
SR 70	HIGHLANDS	450334-1-22-01														
SHEET NO.																
67																

THE OFFICIAL RECORD OF THIS SHEET IS THE ELECTRONIC FILE DIGITALLY SIGNED AND SEALED UNDER RULE 61G15-23.004, F.A.C.

All CenturyLink facilities (peds, MH, cable and fiber optic) locations are approximate. Call 811 for locates before digging.
Level D Mark ups - records used


MATCH LINE STA. 2878+50.00

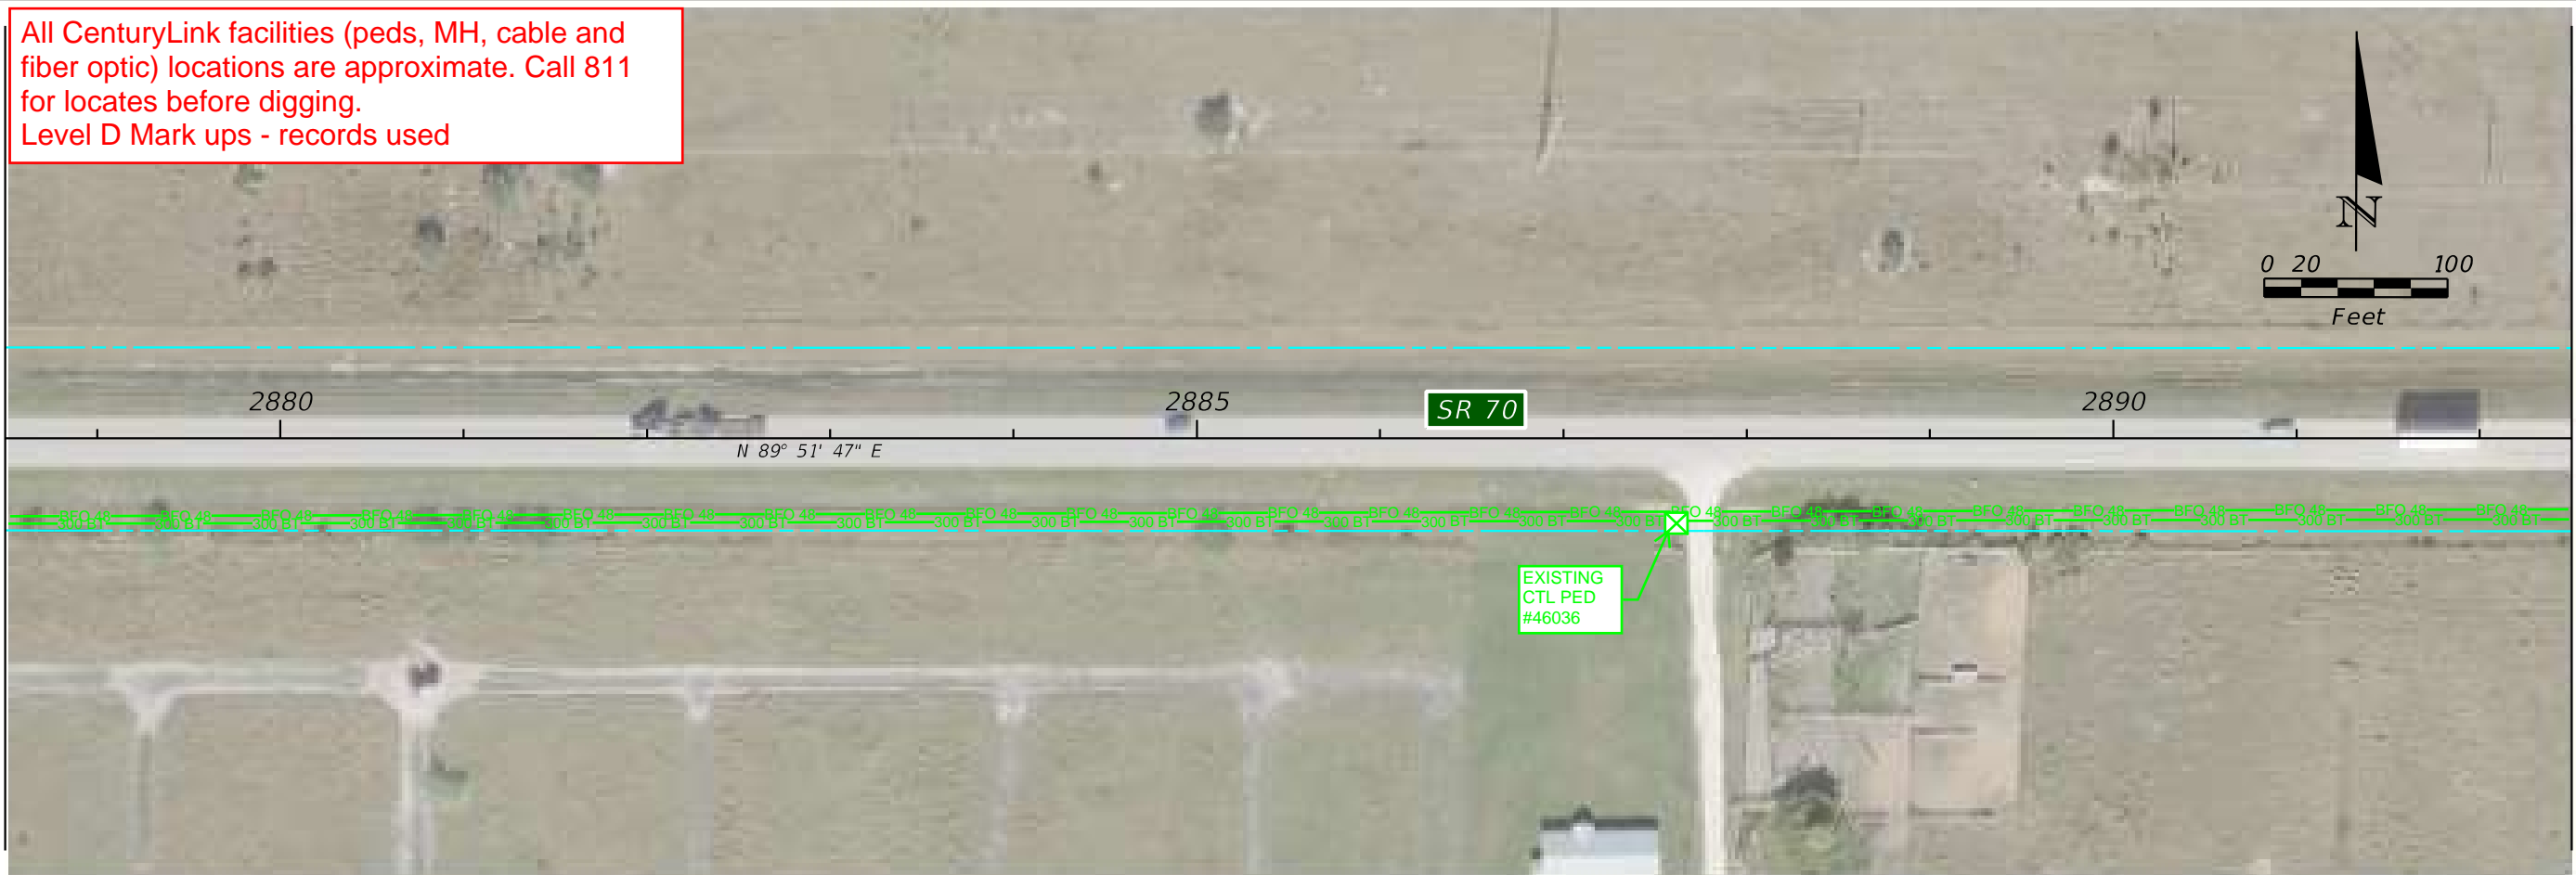

MATCH LINE STA. 2892+50.00

All CenturyLink facilities (peds, MH, cable and fiber optic) locations are approximate. Call 811 for locates before digging.
Level D Mark ups - records used

MATCH LINE STA. 2892+50.00

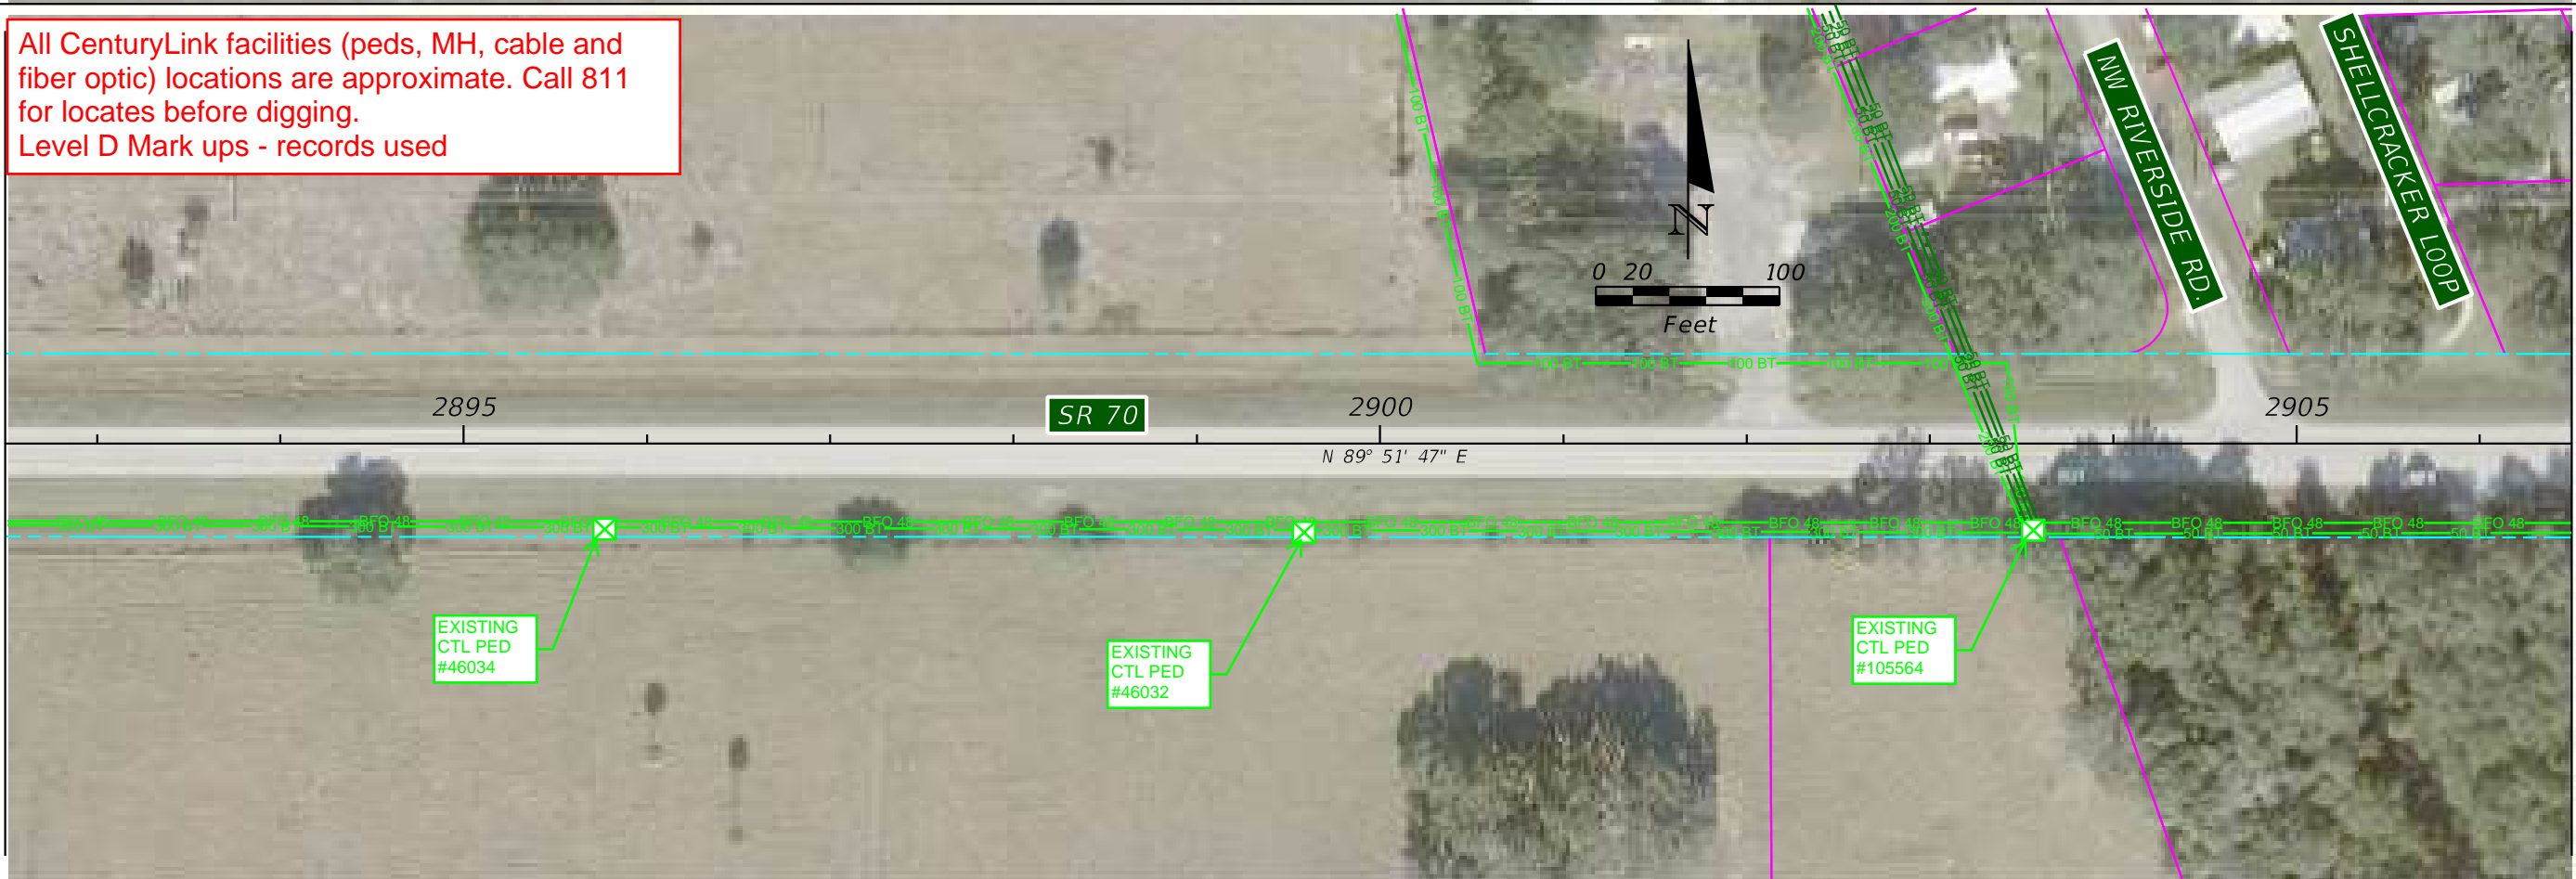

MATCH LINE STA. 2906+50.00


1000	Q CONSTRUCTION	PARCEL LINE	FPC SITE
---	EXIST. R/W LINE	EXIST. EASEMENT	SMF SITE
---	PROP. R/W LINE	PROP. TEMP. EASEMENT	PROPOSED ROADWAY
---	PROP. PERP. EASEMENT	BRIDGE	MILLING AND RESURF.

RK&K
Rummel, Klepper & Kahl, LLP
402 S. Kentucky Avenue
Suite 400
Lakeland, FL 33801
FBPR C.A. NO. 26879
JASON L. LYLE, P.E. 69009

STATE OF FLORIDA DEPARTMENT OF TRANSPORTATION		
ROAD NO.	COUNTY	FINANCIAL PROJECT ID
SR 70	HIGHLANDS	450334-1-22-01

SR 70 PD&E STUDY BASEMAP	
SHEET NO. 68	

All CenturyLink facilities (peds, MH, cable and fiber optic) locations are approximate. Call 811 for locates before digging.
Level D Mark ups - records used

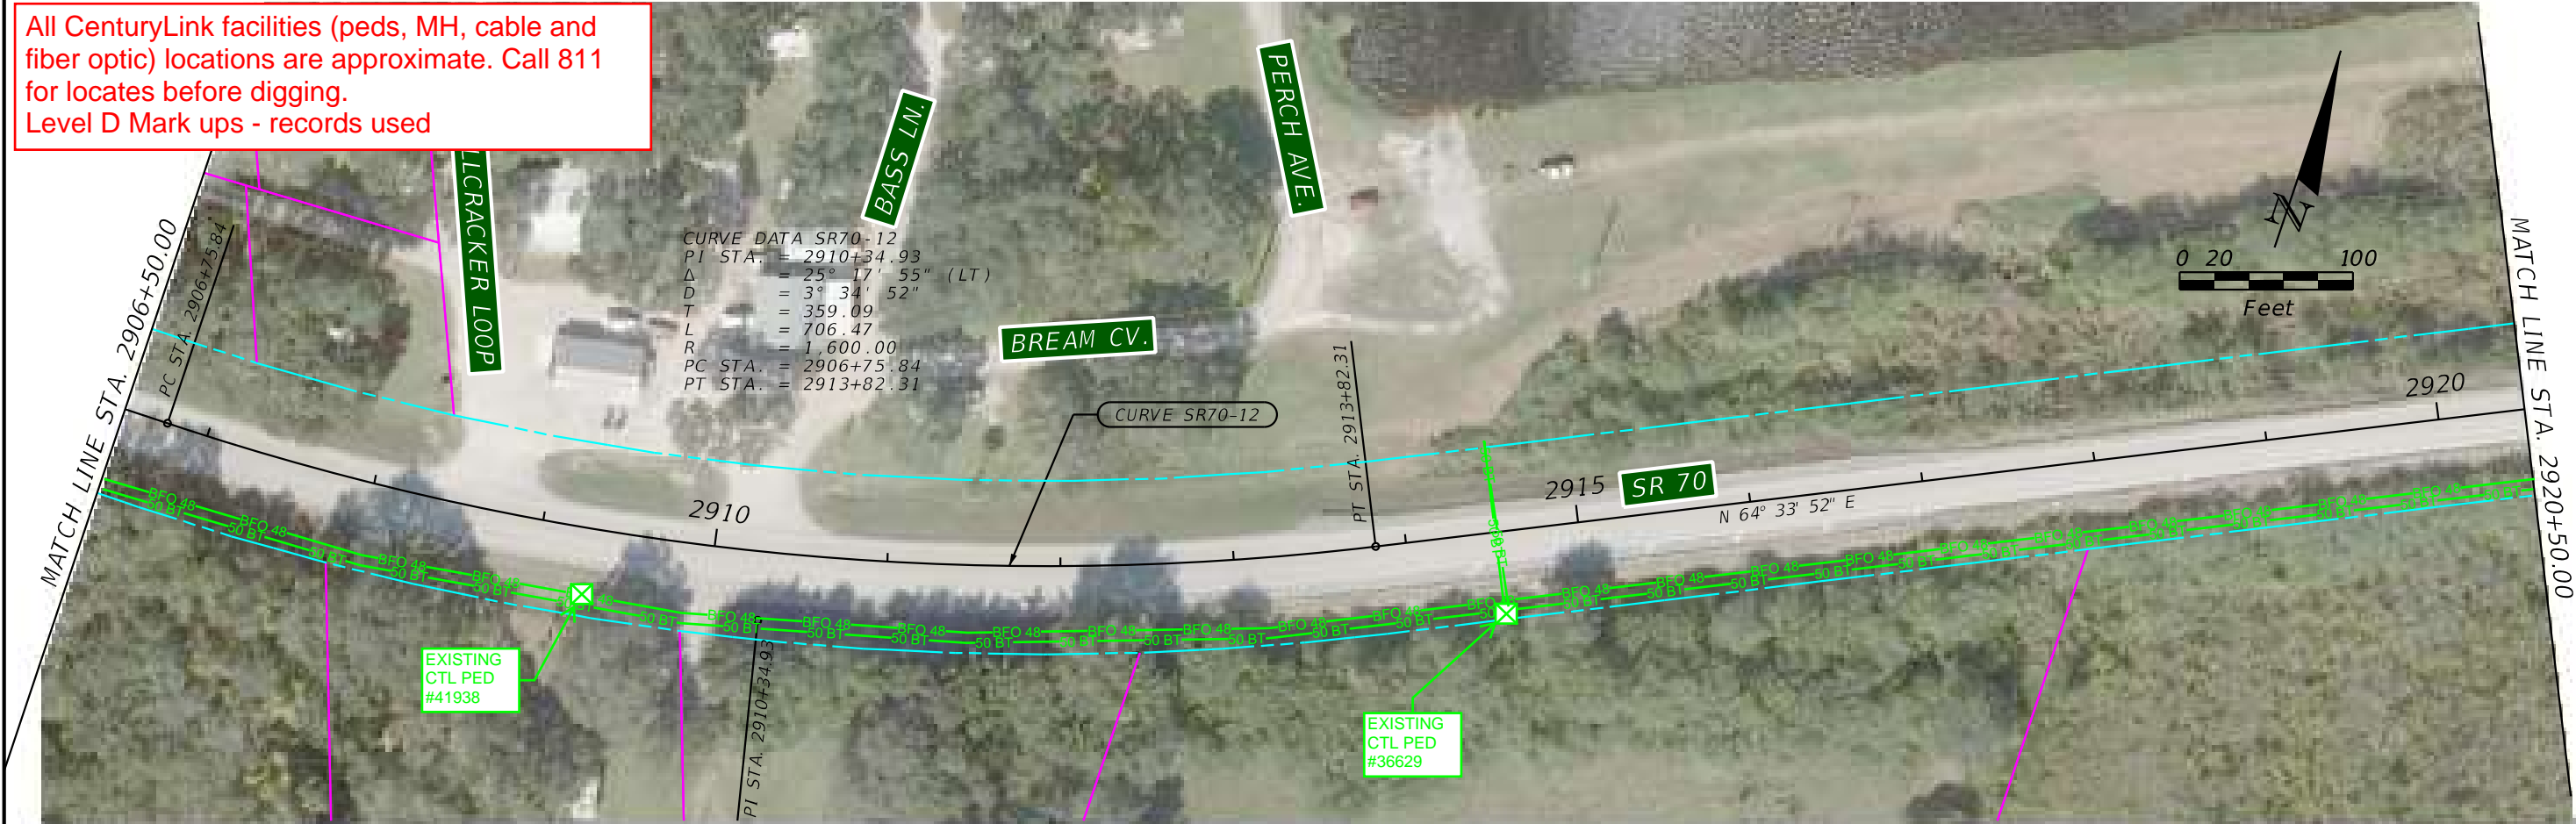

All CenturyLink facilities (peds, MH, cable and fiber optic) locations are approximate. Call 811 for locates before digging.
Level D Mark ups - records used



1000	Q CONSTRUCTION	PARCEL LINE	FPC SITE
---	EXIST. R/W LINE	EXIST. EASEMENT	SMF SITE
---	PROP. R/W LINE	PROP. TEMP. EASEMENT	PROPOSED ROADWAY
---	PROP. PERP. EASEMENT	BRIDGE	MILLING AND RESURF.

RK&K
Rummel, Klepper & Kahl, LLP
402 S. Kentucky Avenue
Suite 400
Lakeland, FL 33801
FBPR C.A. NO. 26879
JASON L. LYLE, P.E. 69009

STATE OF FLORIDA DEPARTMENT OF TRANSPORTATION		
ROAD NO.	COUNTY	FINANCIAL PROJECT ID
SR 70	HIGHLANDS OKEECHOBEE	450334-1-22-01


**SR 70 PD&E STUDY
BASEMAP**

SHEET NO.
69

THE OFFICIAL RECORD OF THIS SHEET IS THE ELECTRONIC FILE DIGITALLY SIGNED AND SEALED UNDER RULE 61G15-23.004, F.A.C.

All CenturyLink facilities (peds, MH, cable and fiber optic) locations are approximate. Call 811 for locates before digging.
Level D Mark ups - records used

MATCH LINE STA. 2934+50.00

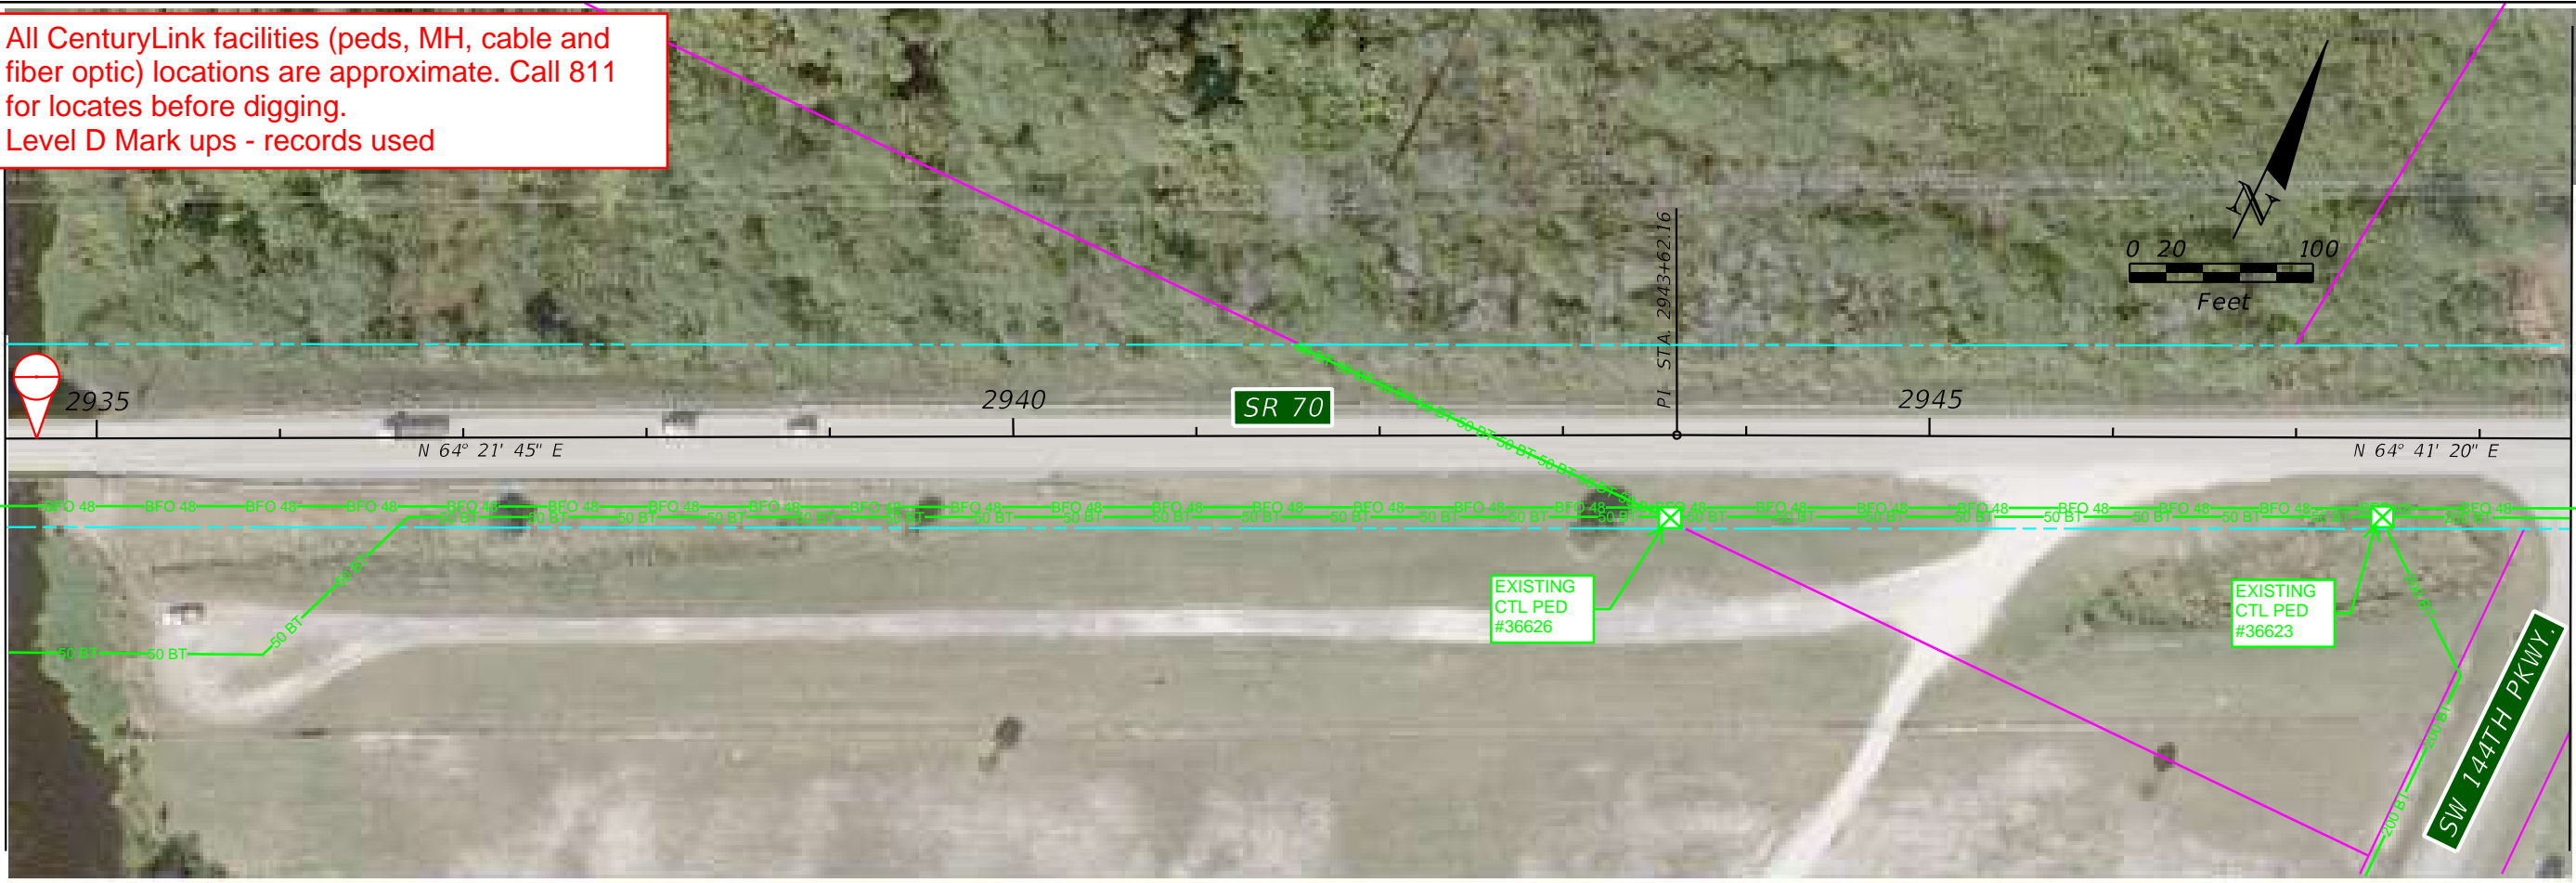

MATCH LINE STA. 2948+50.00



All CenturyLink facilities (peds, MH, cable and fiber optic) locations are approximate. Call 811 for locates before digging.
Level D Mark ups - records used

MATCH LINE STA. 2948+50.00



MATCH LINE STA. 2962+50.00

<p>CONSTRUCTION EXIST. R/W LINE PROP. R/W LINE PROP. PERP. EASEMENT PARCEL LINE EXIST. EASEMENT PROP. TEMP. EASEMENT BRIDGE FPC SITE SMF SITE PROPOSED ROADWAY MILLING AND RESURF.</p>			<p>Rummel, Klepper & Kahl, LLP 402 S. Kentucky Avenue Suite 400 Lakeland, FL 33801 FBPR C.A. NO. 26879 JASON L. LYLE, P.E. 69009</p>	<p>STATE OF FLORIDA DEPARTMENT OF TRANSPORTATION</p> <table border="1"><tr><td>ROAD NO.</td><td>COUNTY</td><td>FINANCIAL PROJECT ID</td></tr><tr><td>SR 70</td><td>OKEECHOBEE</td><td>450334-1-22-01</td></tr></table>			ROAD NO.	COUNTY	FINANCIAL PROJECT ID	SR 70	OKEECHOBEE	450334-1-22-01	<p>SR 70 PD&E STUDY BASEMAP</p>		<p>SHEET NO. 70</p>
ROAD NO.	COUNTY	FINANCIAL PROJECT ID													
SR 70	OKEECHOBEE	450334-1-22-01													

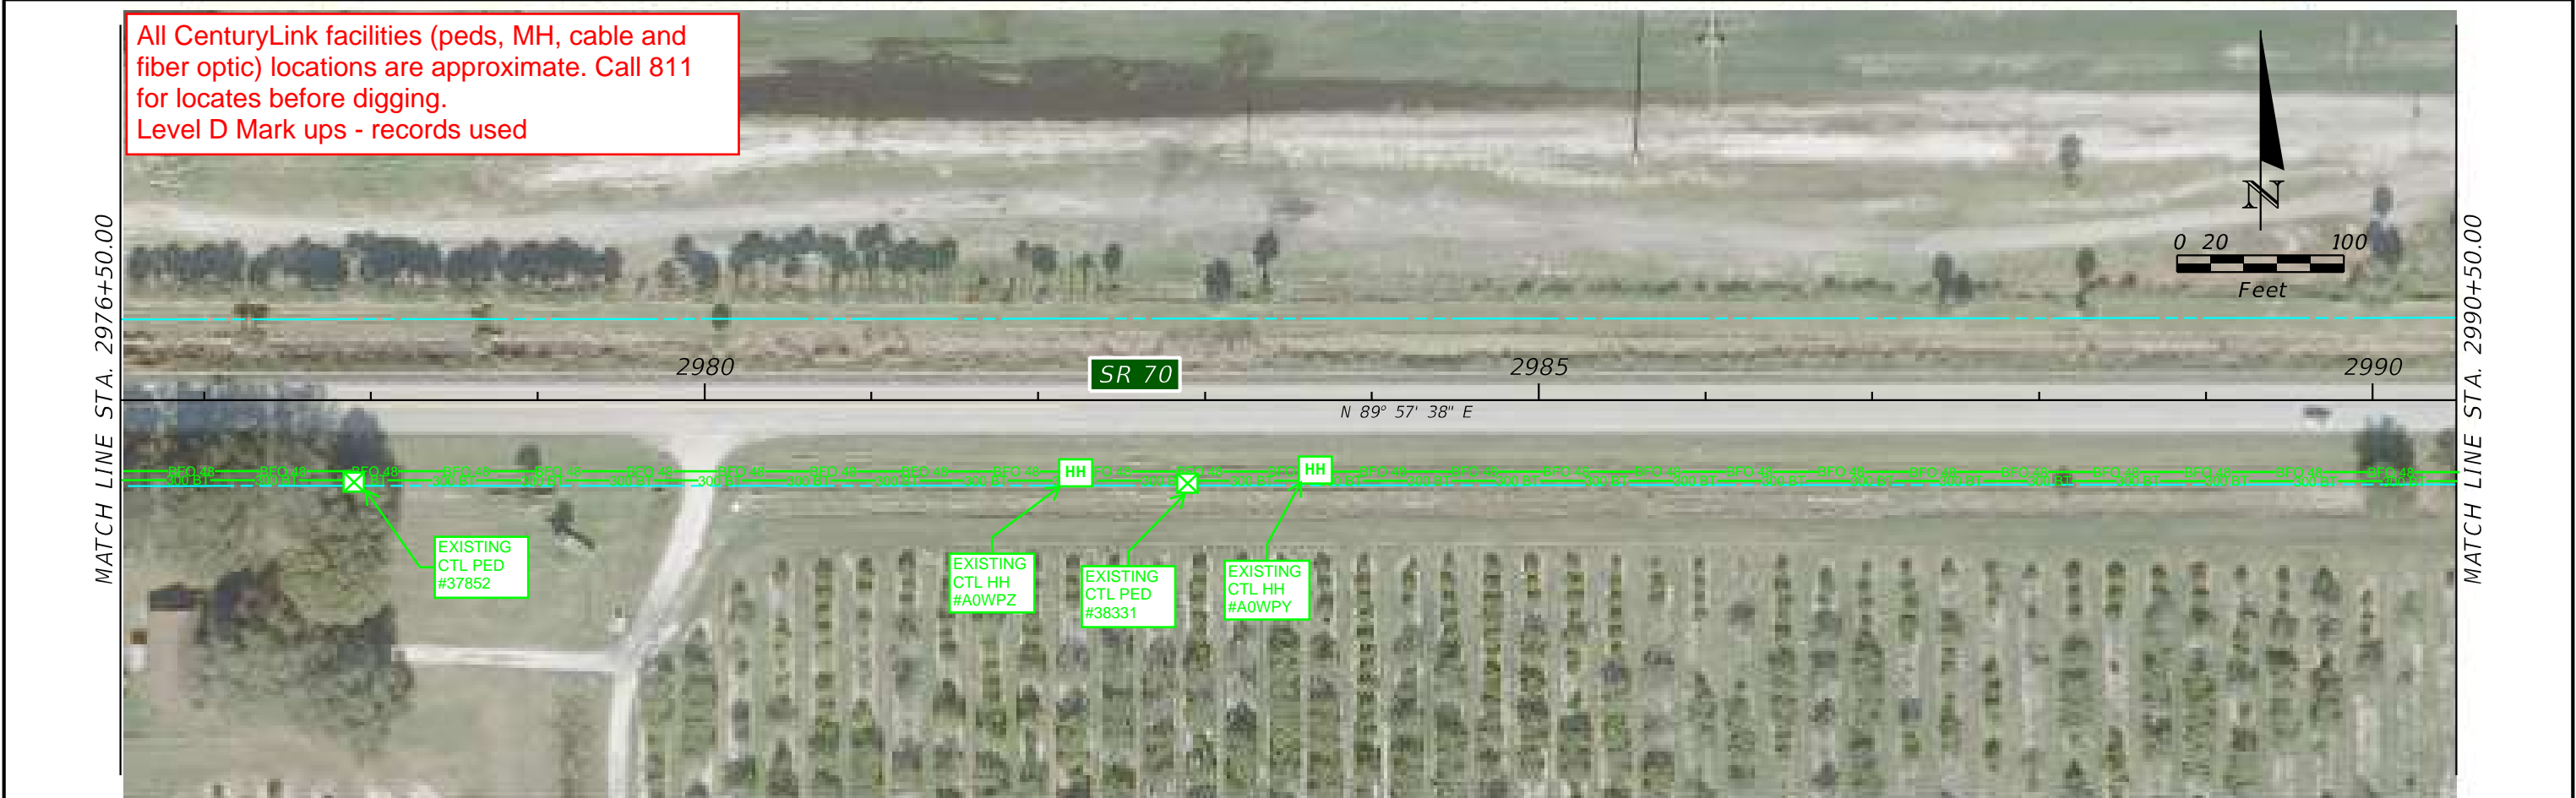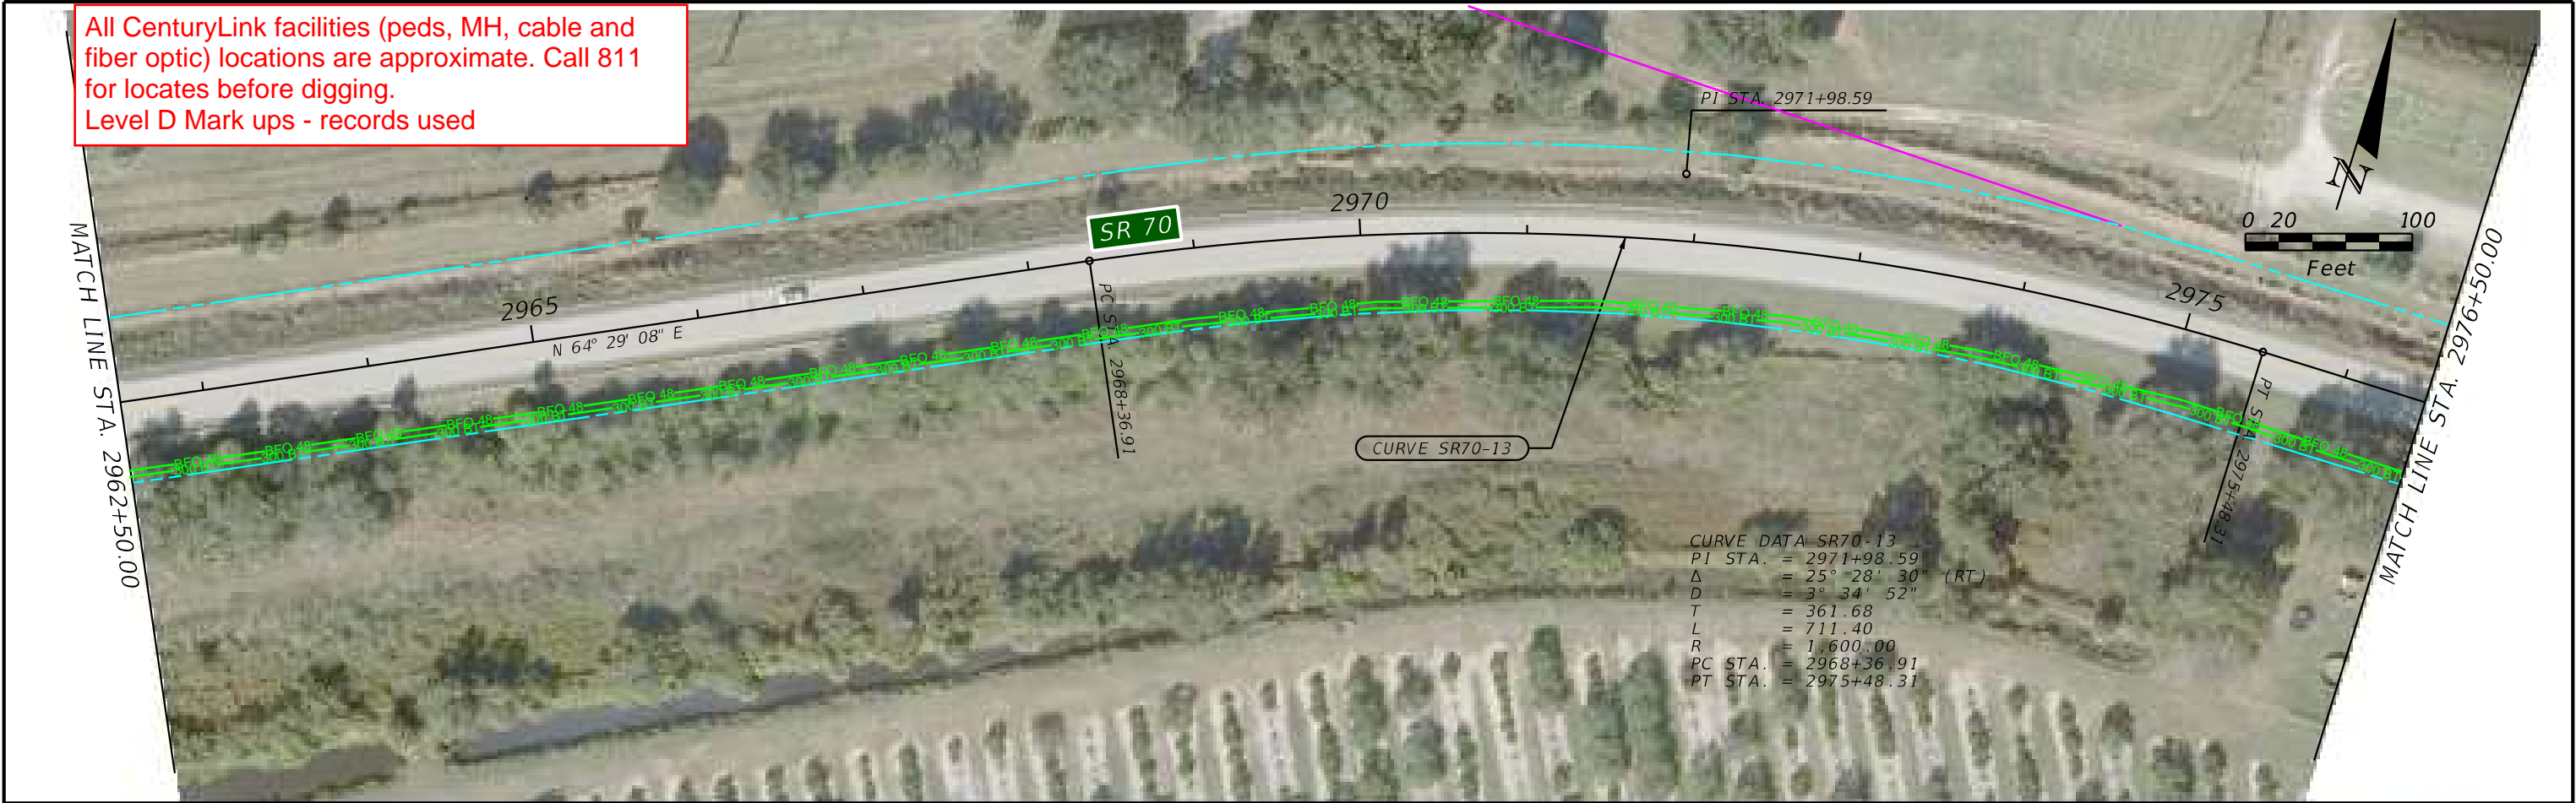

All CenturyLink facilities (peds, MH, cable and fiber optic) locations are approximate. Call 811 for locates before digging.
Level D Mark ups - records used

MATCH LINE STA. 2990+50.00



MATCH LINE STA. 3004+50.00

MATCH LINE STA. 3004+50.00



MATCH LINE STA. 3018+50.00

All CenturyLink facilities (peds, MH, cable and fiber optic) locations are approximate. Call 811 for locates before digging.
Level D Mark ups - records used

	Q CONSTRUCTION		PARCEL LINE		FPC SITE
	EXIST. R/W LINE		EXIST. EASEMENT		SMF SITE
	PROP. R/W LINE		PROP. TEMP. EASEMENT		PROPOSED ROADWAY
	PROP. PERP. EASEMENT		BRIDGE		MILLING AND RESURF.

Rummel, Klepper & Kahl, LLP
402 S. Kentucky Avenue
Suite 400
Lakeland, FL 33801
FBPR C.A. NO. 26879

JASON L. LYLE, P.E. 69009

STATE OF FLORIDA DEPARTMENT OF TRANSPORTATION		
ROAD NO.	COUNTY	FINANCIAL PROJECT ID
SR 70	OKEECHOBEE	450334-1-22-01

SR 70 PD&E STUDY
BASEMAP

SHEET NO.
72

APPENDIX C
COST ESTIMATE BACKUP DOCUMENTATION

Project Information And Update

WGI#

FPN: 450334-1

County: Highlands/ Okeechobee

Report Date:

Description: SR 70 CR 721 to 128th Ave.

Type Work:

Project Manager

Engineer of Record:

Utility Coordinator

Length of Project

Scalar

8.6 miles

Actual dates for each Phase as applicable, not scheduled dates.

Project Plans to UAO's		Utility Meeting Date		UWHCA With UAO and 56-**		Amount
Greenline						
Phase II						
Phase III						


Issues This Month

UAO Name																											
							Non Reimbursable									Reimbursable											
Comcast							\$ 48,100.00																				
Florida Gas Transmission																\$27,588,070.00											
Florida Power & Light Distribution (13kv)							\$ 339,337.00									\$1,863,636.00											
Florida Power & Light Transmission (69kv)																\$14,958,333.00											
Lumen/ Centurylink							\$ 1,819,165.00									\$3,900,000.00											
						HB 703	\$ 909,582.50									\$1,950,000.00											


Originally Estimated in Fall 2024	\$	3,068,084.50	\$50,260,039.00
2025 cost increase 4.6%		\$141,131.89	\$2,311,961.79
Subtotal		\$3,209,216.39	\$52,572,000.79
Engineering Estimate (12%) (Ph 36)	\$	385,105.97	\$6,308,640.10
Land & R/W Cost (30%) (Ph 46)			\$15,771,600.24
Construction (Ph 56)	\$	3,209,216.39	\$52,572,000.79
CE&I (5%)	\$	160,460.82	\$2,628,600.04
Total Utility Relocation Cost		\$3,754,783.17	\$77,280,841.17

HB 703 refers to Telecom reimburesment under FS 337.403


APPENDIX D
FP&L TRANSMISSION PROPOSED 230kV

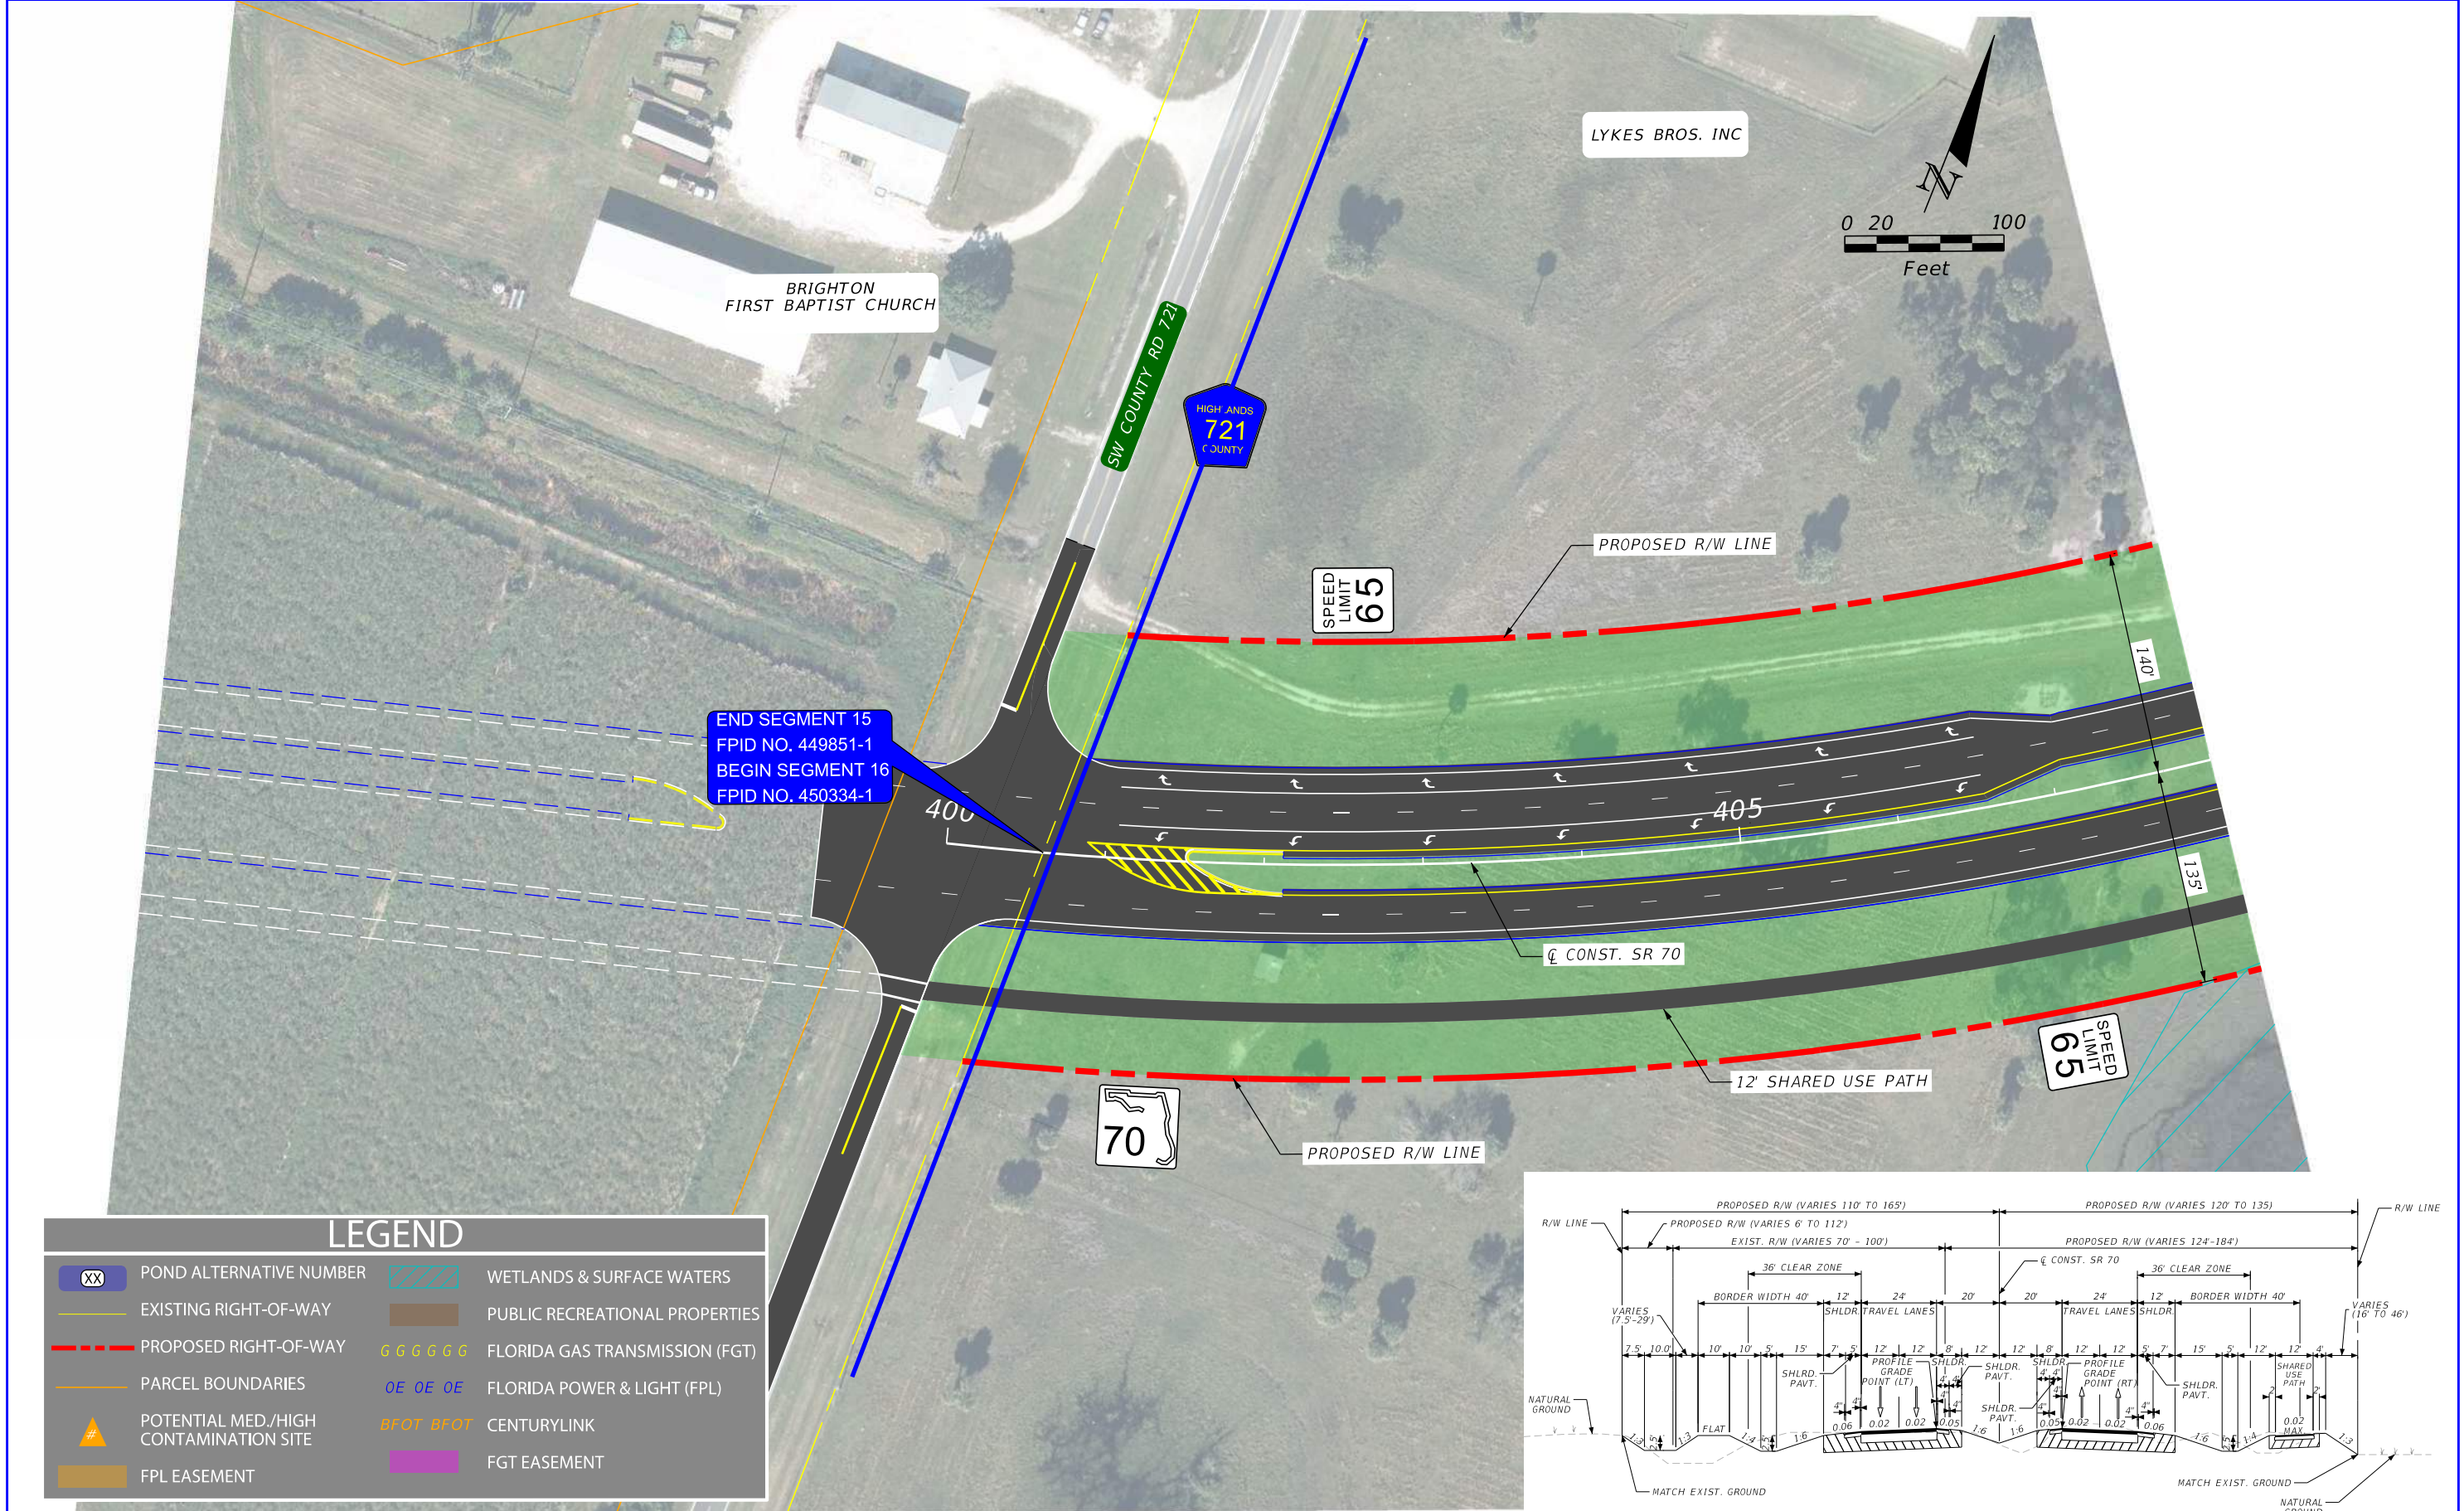

REVISIONS				ENGINEER OF RECORD		STATE OF FLORIDA DEPARTMENT OF TRANSPORTATION		ALTERNATIVE 1 CONCEPT PLAN	SHEET NO. 1
DATE	DESCRIPTION	DATE	DESCRIPTION	NICHOLAS JOHN CLAVELO LICENSE NUMBER: 84366 SCALAR CONSULTING GROUP INC. 5713 CORPORATE WAY, SUITE 200 WEST PALM BEACH, FLORIDA 33407		ROAD NO.	COUNTY		
						SR 70	HIGHLANDS OKEECHOBEE	FINANCIAL PROJECT ID 450334-1-22-01	

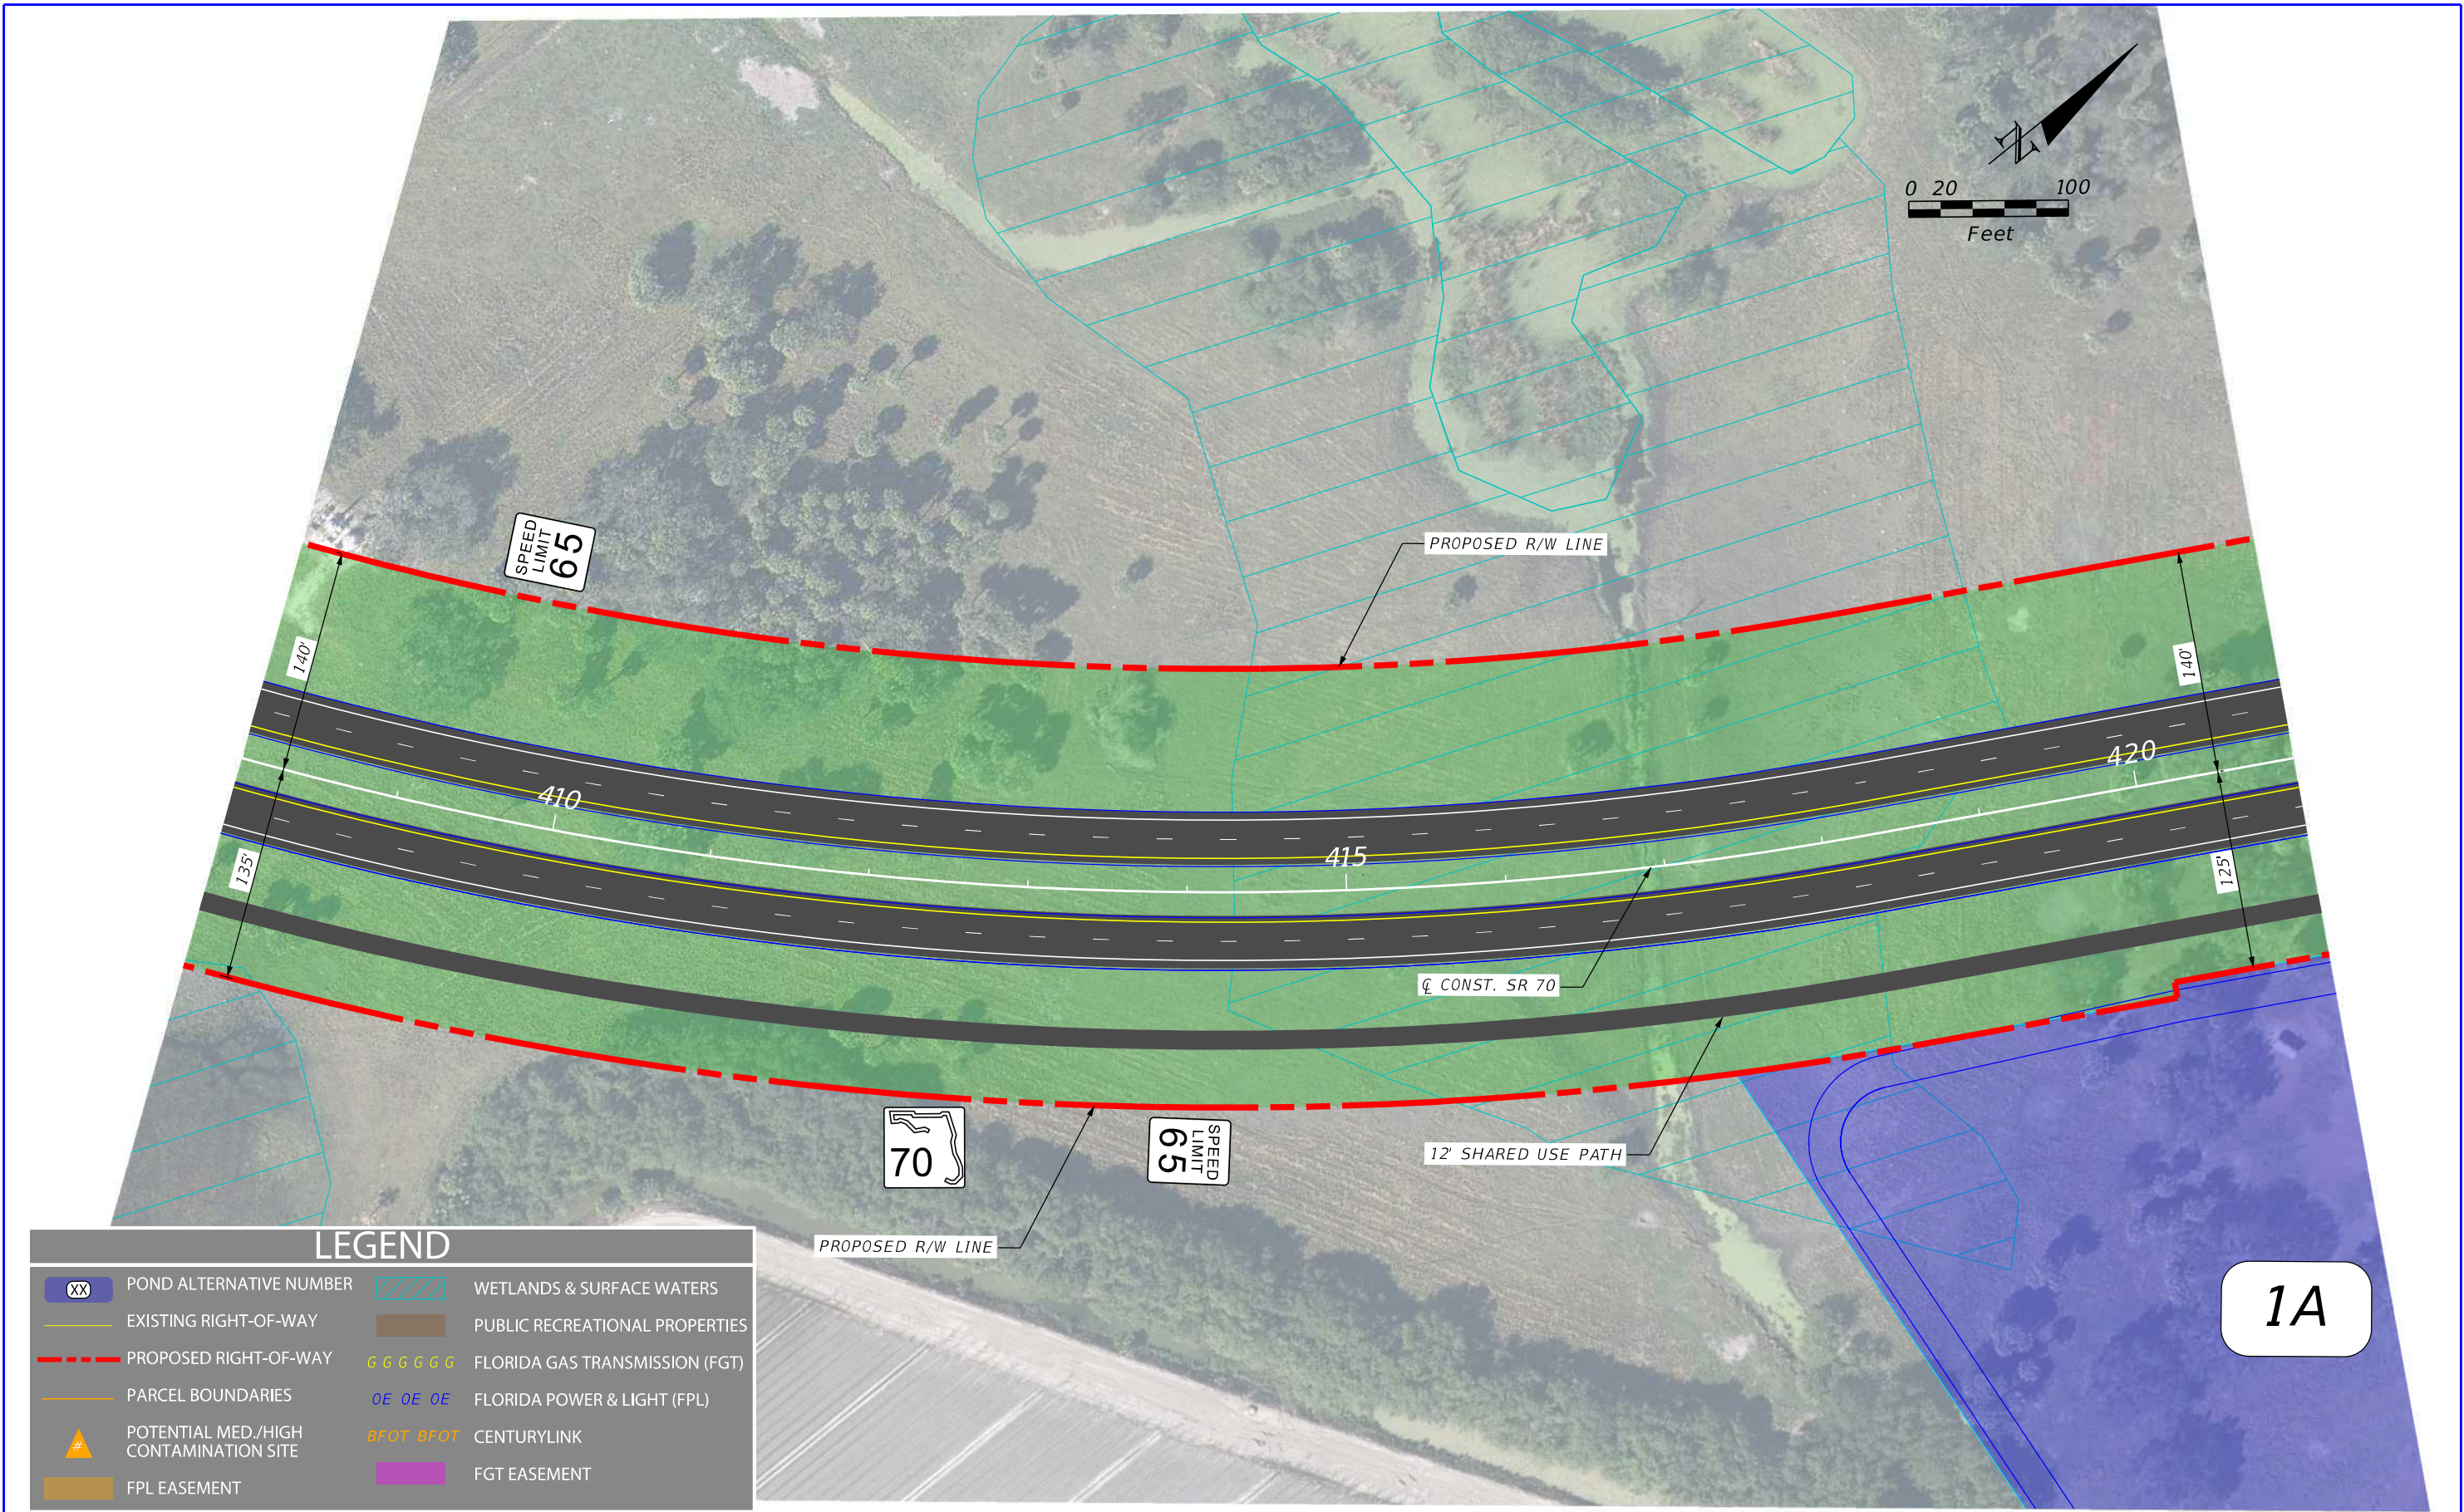

REVISIONS				ENGINEER OF RECORD		STATE OF FLORIDA DEPARTMENT OF TRANSPORTATION		SHEET NO.
DATE	DESCRIPTION	DATE	DESCRIPTION	NICHOLAS JOHN CLAVELO LICENSE NUMBER: 84366 SCALAR CONSULTING GROUP INC. 5713 CORPORATE WAY, SUITE 200 WEST PALM BEACH, FLORIDA 33407		ROAD NO.	COUNTY	
						SR 70	HIGHLANDS OKEECHOBEE	
						FINANCIAL PROJECT ID 450334-1-22-01		2

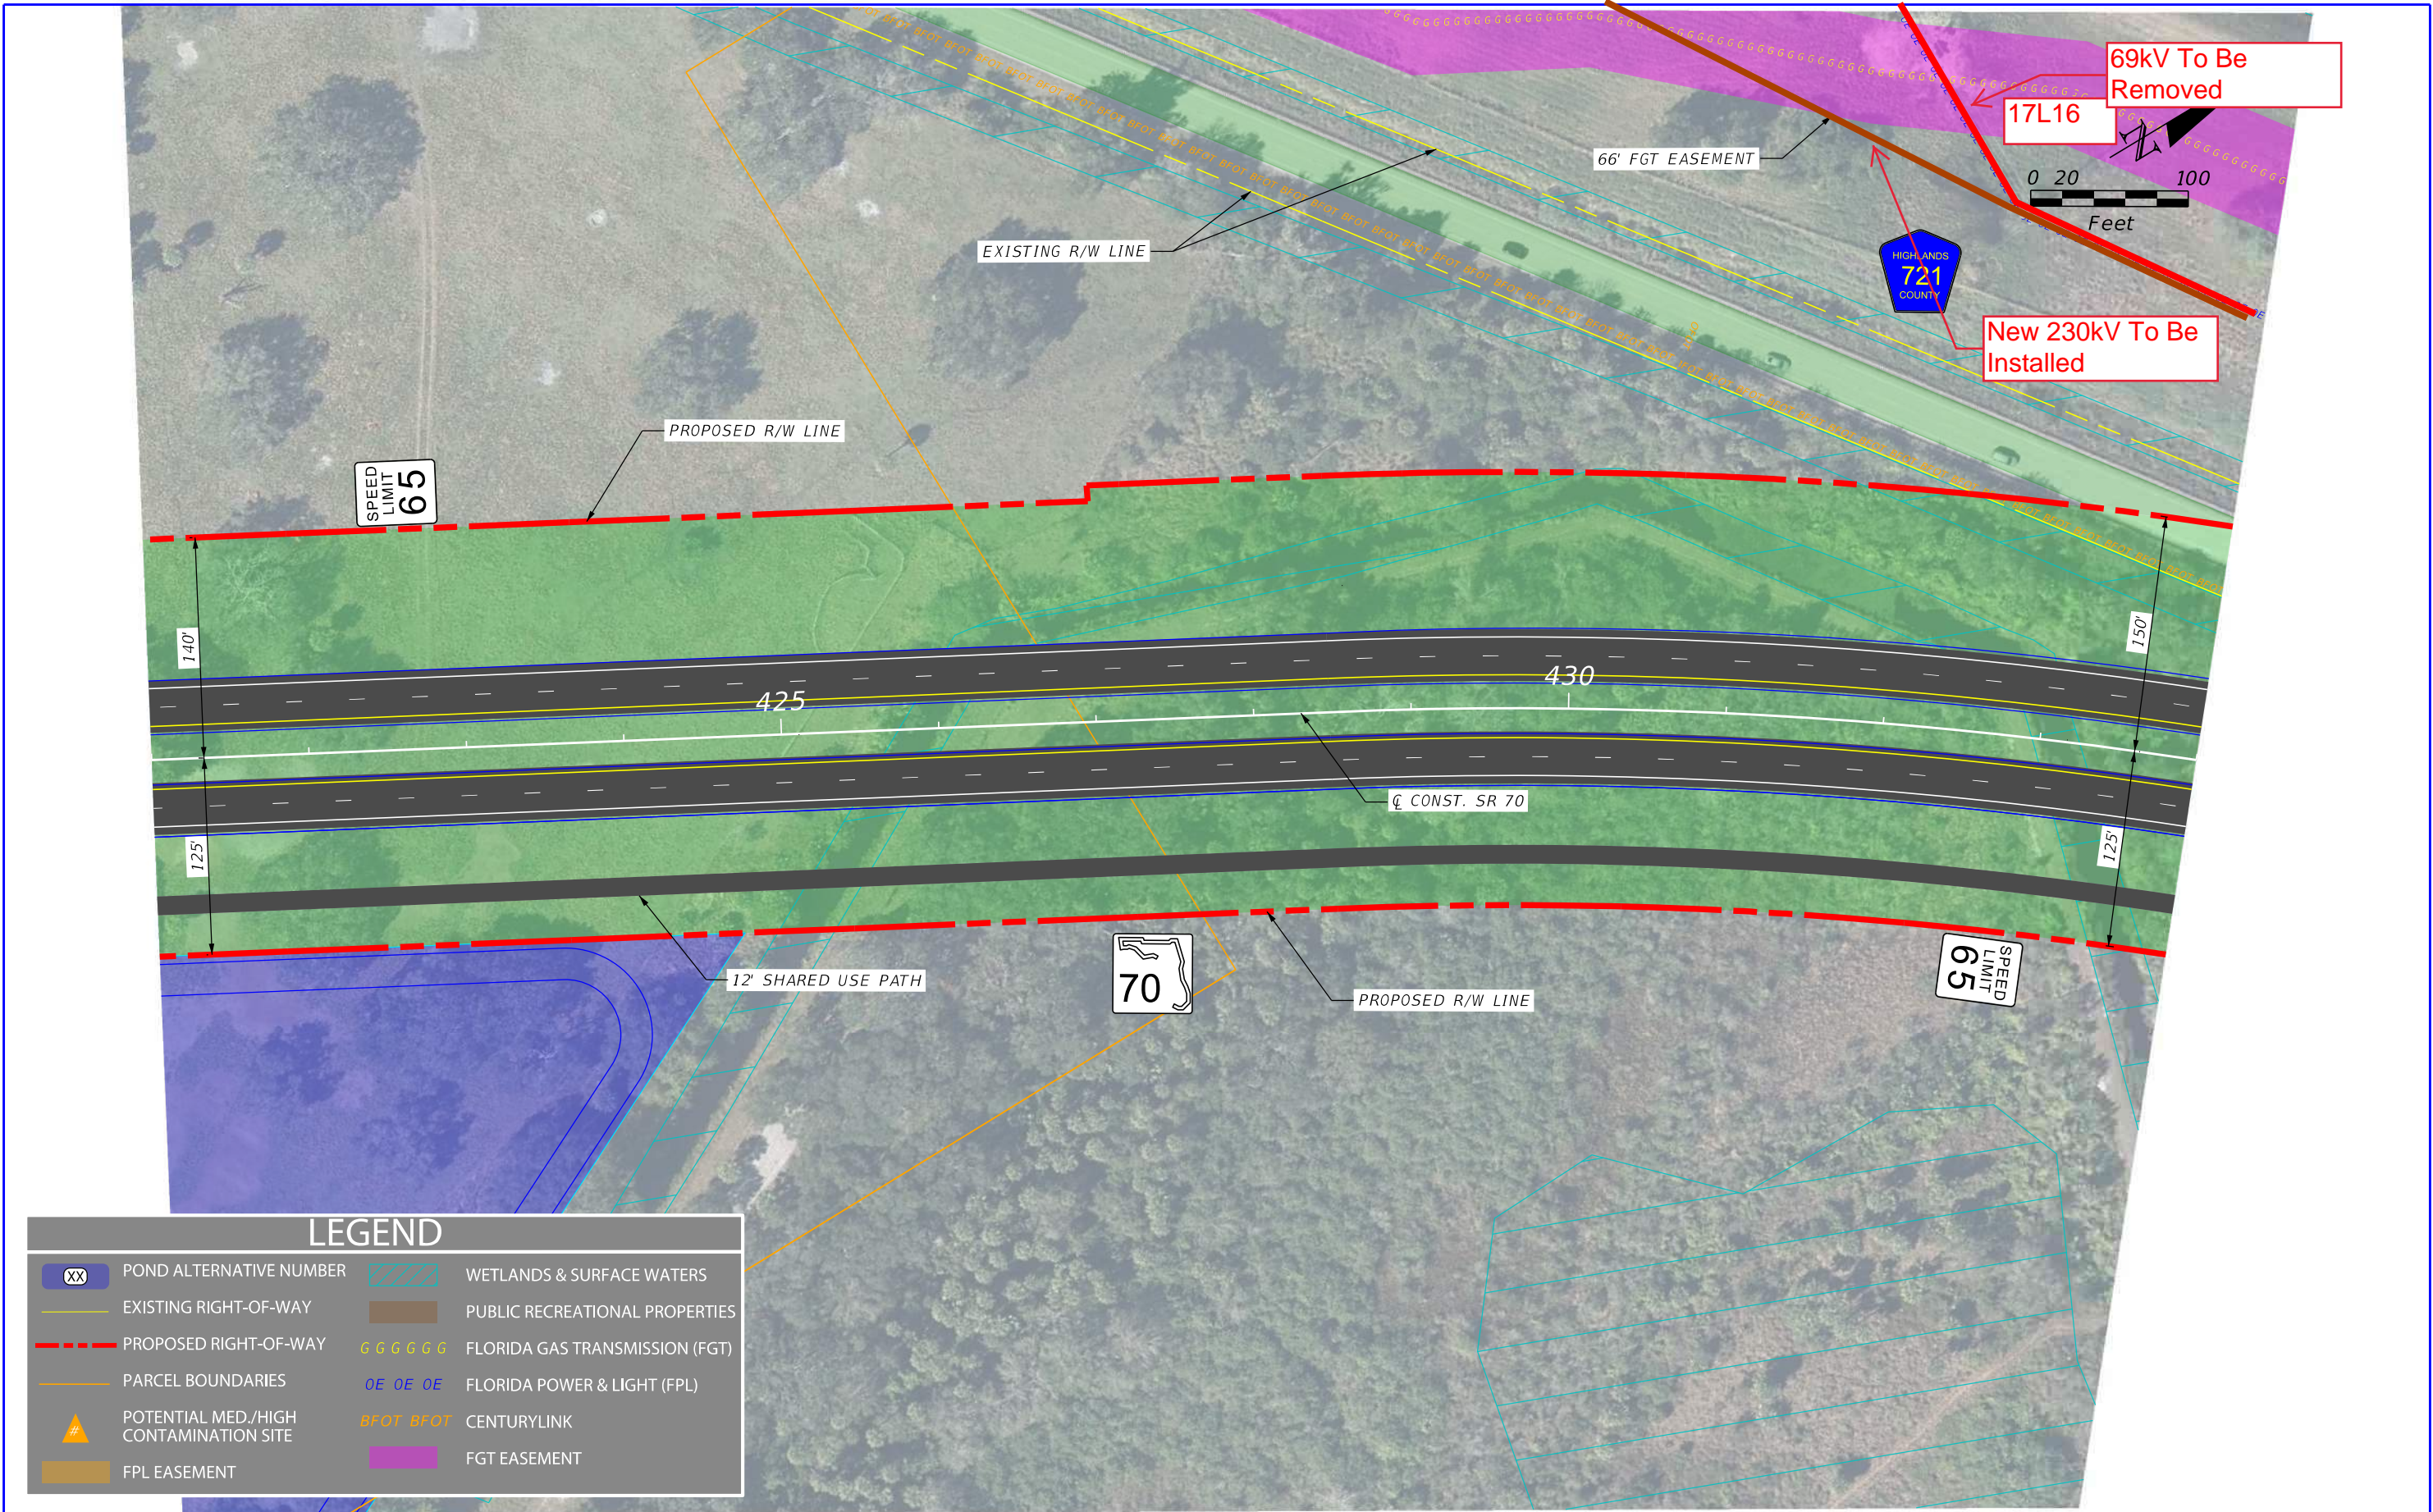

LEGEND

XX

POND ALTERNATIVE NUMBER

EXISTING RIGHT-OF-WAY

PROPOSED RIGHT-OF-WAY

PARCEL BOUNDARIES

#

POTENTIAL MED./HIGH CONTAMINATION SITE

FPL EASEMENT

WETLANDS & SURFACE WATERS

PUBLIC RECREATIONAL PROPERTIES

G G G G G G

FLORIDA GAS TRANSMISSION (FGT)

OE OE OE

FLORIDA POWER & LIGHT (FPL)


BFOT BFOT

CENTURYLINK

FGT EASEMENT

REVISIONS				ENGINEER OF RECORD	STATE OF FLORIDA DEPARTMENT OF TRANSPORTATION			SHEET NO. 3
DATE	DESCRIPTION	DATE	DESCRIPTION		ROAD NO.	COUNTY	FINANCIAL PROJECT ID	
					SR 70	HIGHLANDS OKEECHOBEE	450334-1-22-01	

ALTERNATIVE 1
CONCEPT PLAN

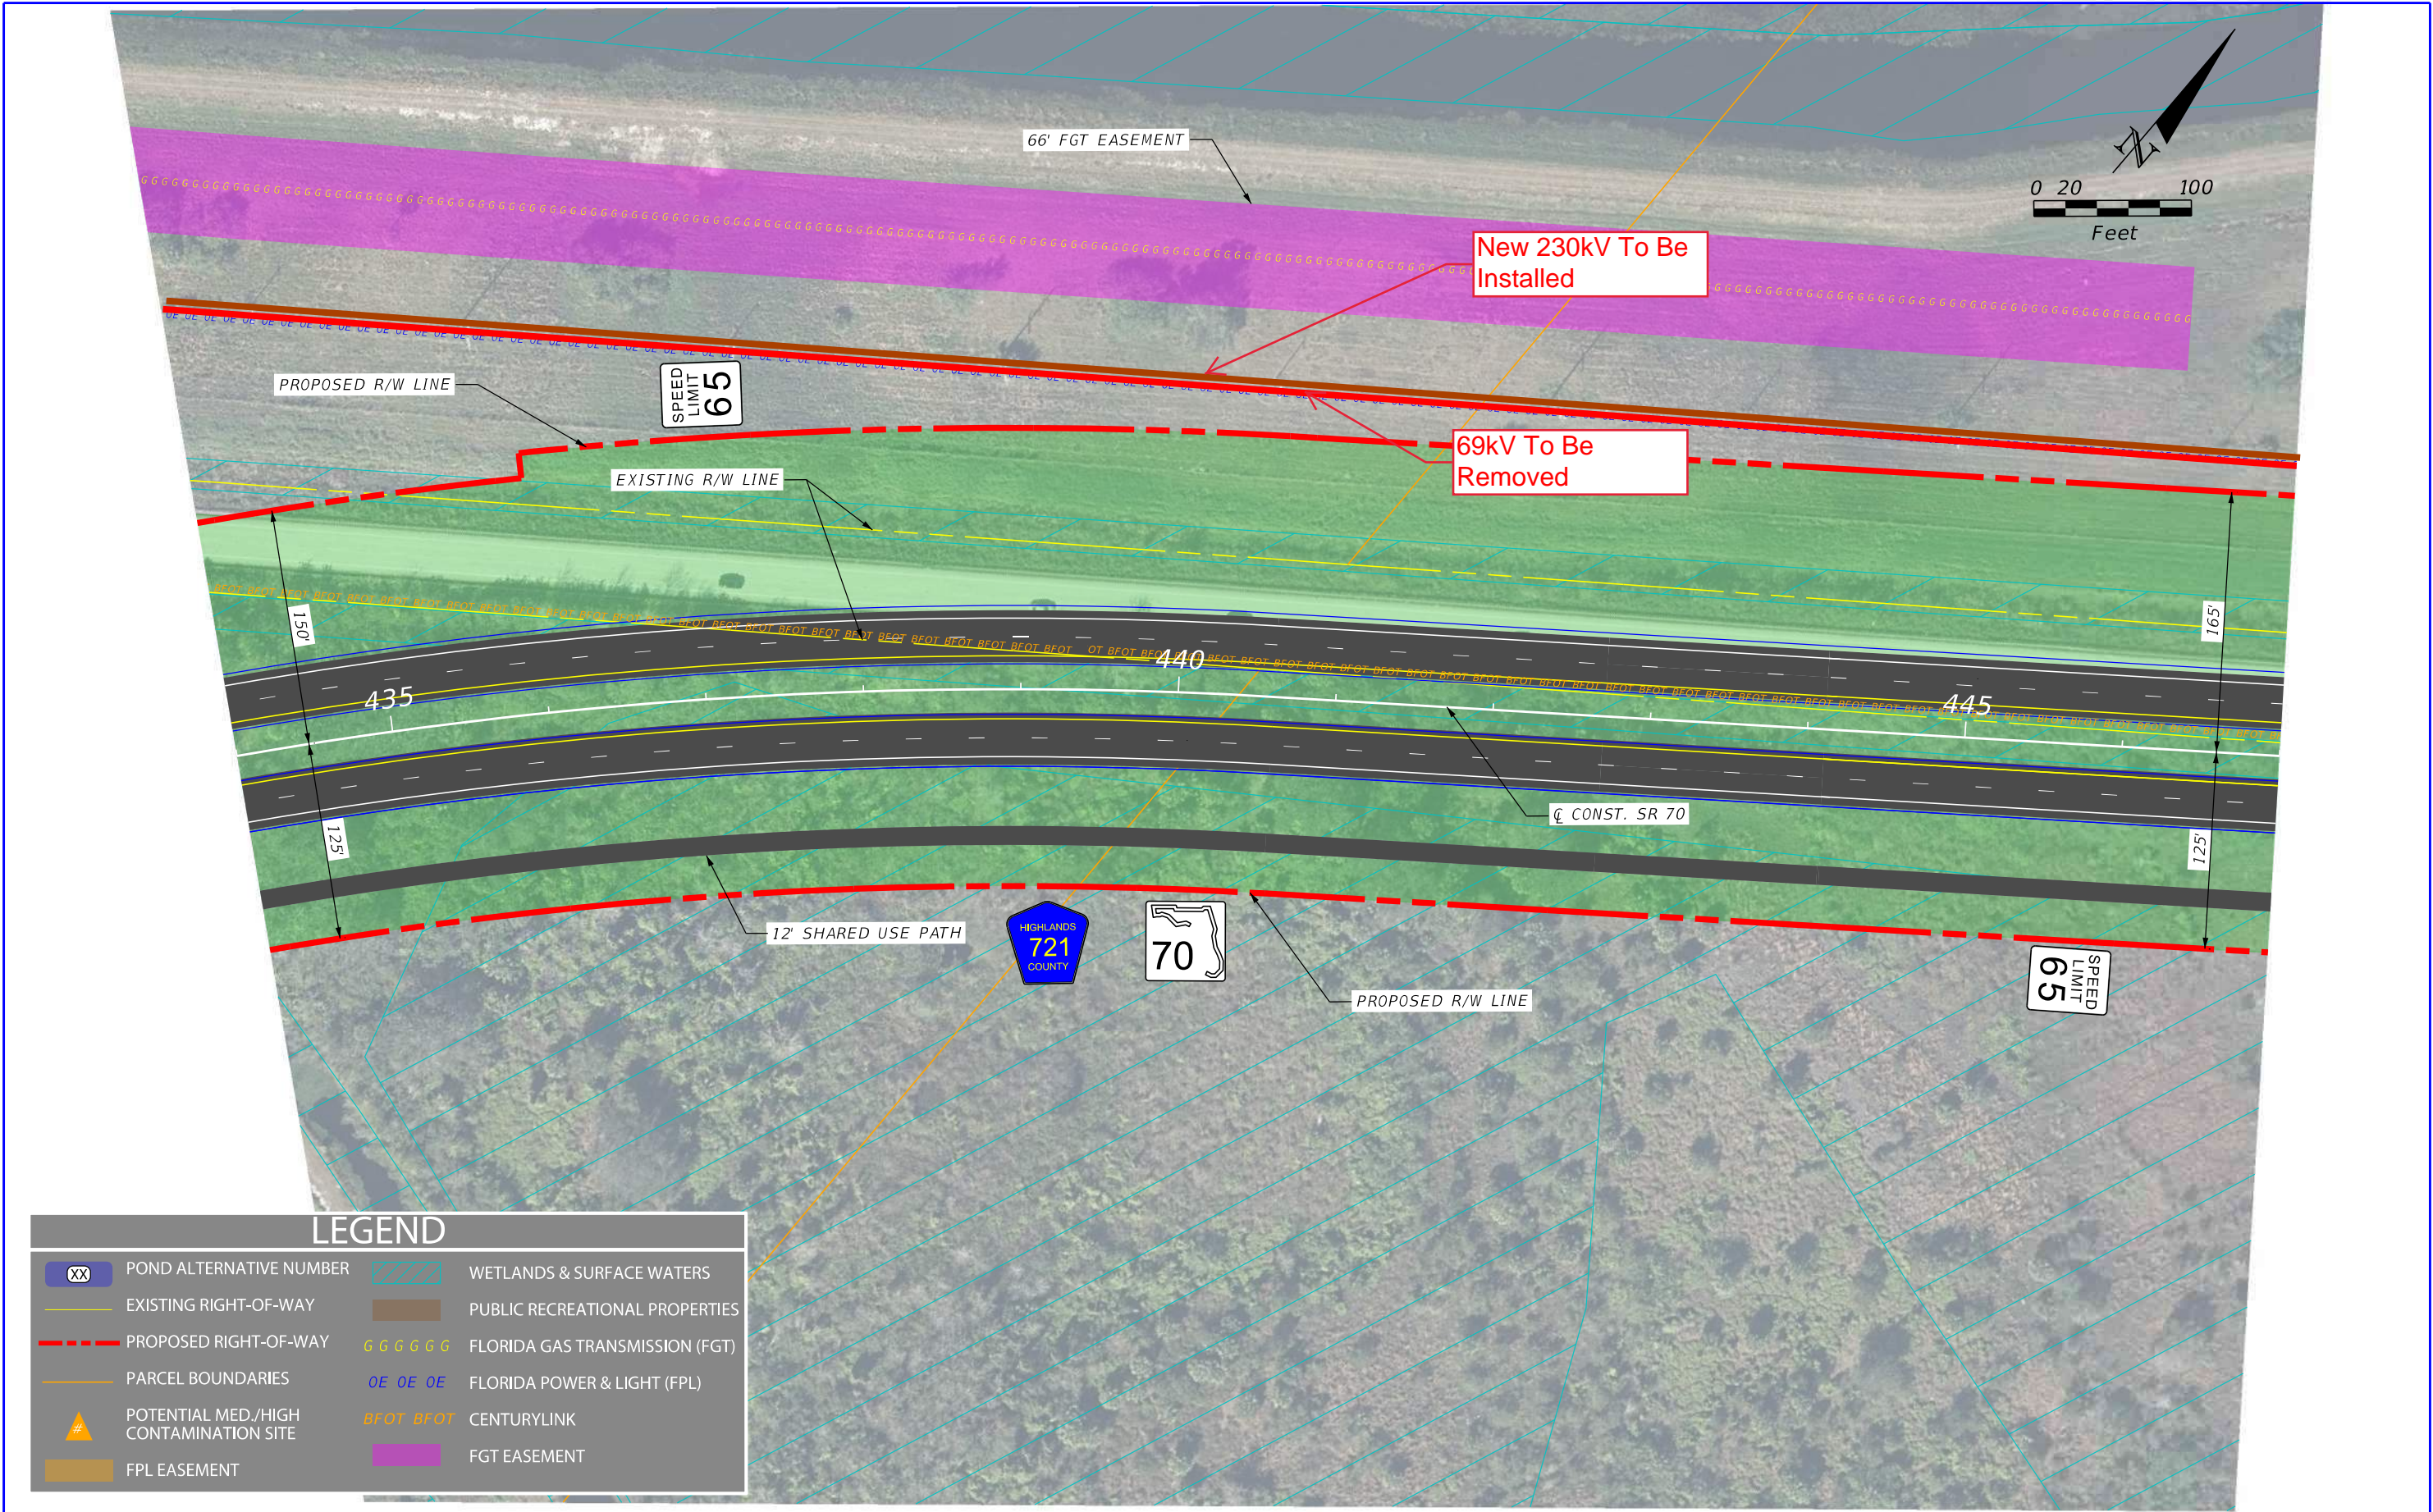

LEGEND

XX

POND ALTERNATIVE NUMBER

EXISTING RIGHT-OF-WAY

PROPOSED RIGHT-OF-WAY

PARCEL BOUNDARIES

#

POTENTIAL MED./HIGH CONTAMINATION SITE

FPL EASEMENT

WETLANDS & SURFACE WATERS

PUBLIC RECREATIONAL PROPERTIES

GGGGGG

FLORIDA GAS TRANSMISSION (FGT)

OE OE OE

FLORIDA POWER & LIGHT (FPL)


BFOT BFOT

CENTURYLINK

FGT EASEMENT

REVISIONS				ENGINEER OF RECORD	STATE OF FLORIDA DEPARTMENT OF TRANSPORTATION			SHEET NO. 4
DATE	DESCRIPTION	DATE	DESCRIPTION		ROAD NO.	COUNTY	FINANCIAL PROJECT ID	
					SR 70	HIGHLANDS OKEECHOBEE	450334-1-22-01	

ALTERNATIVE 1
CONCEPT PLAN

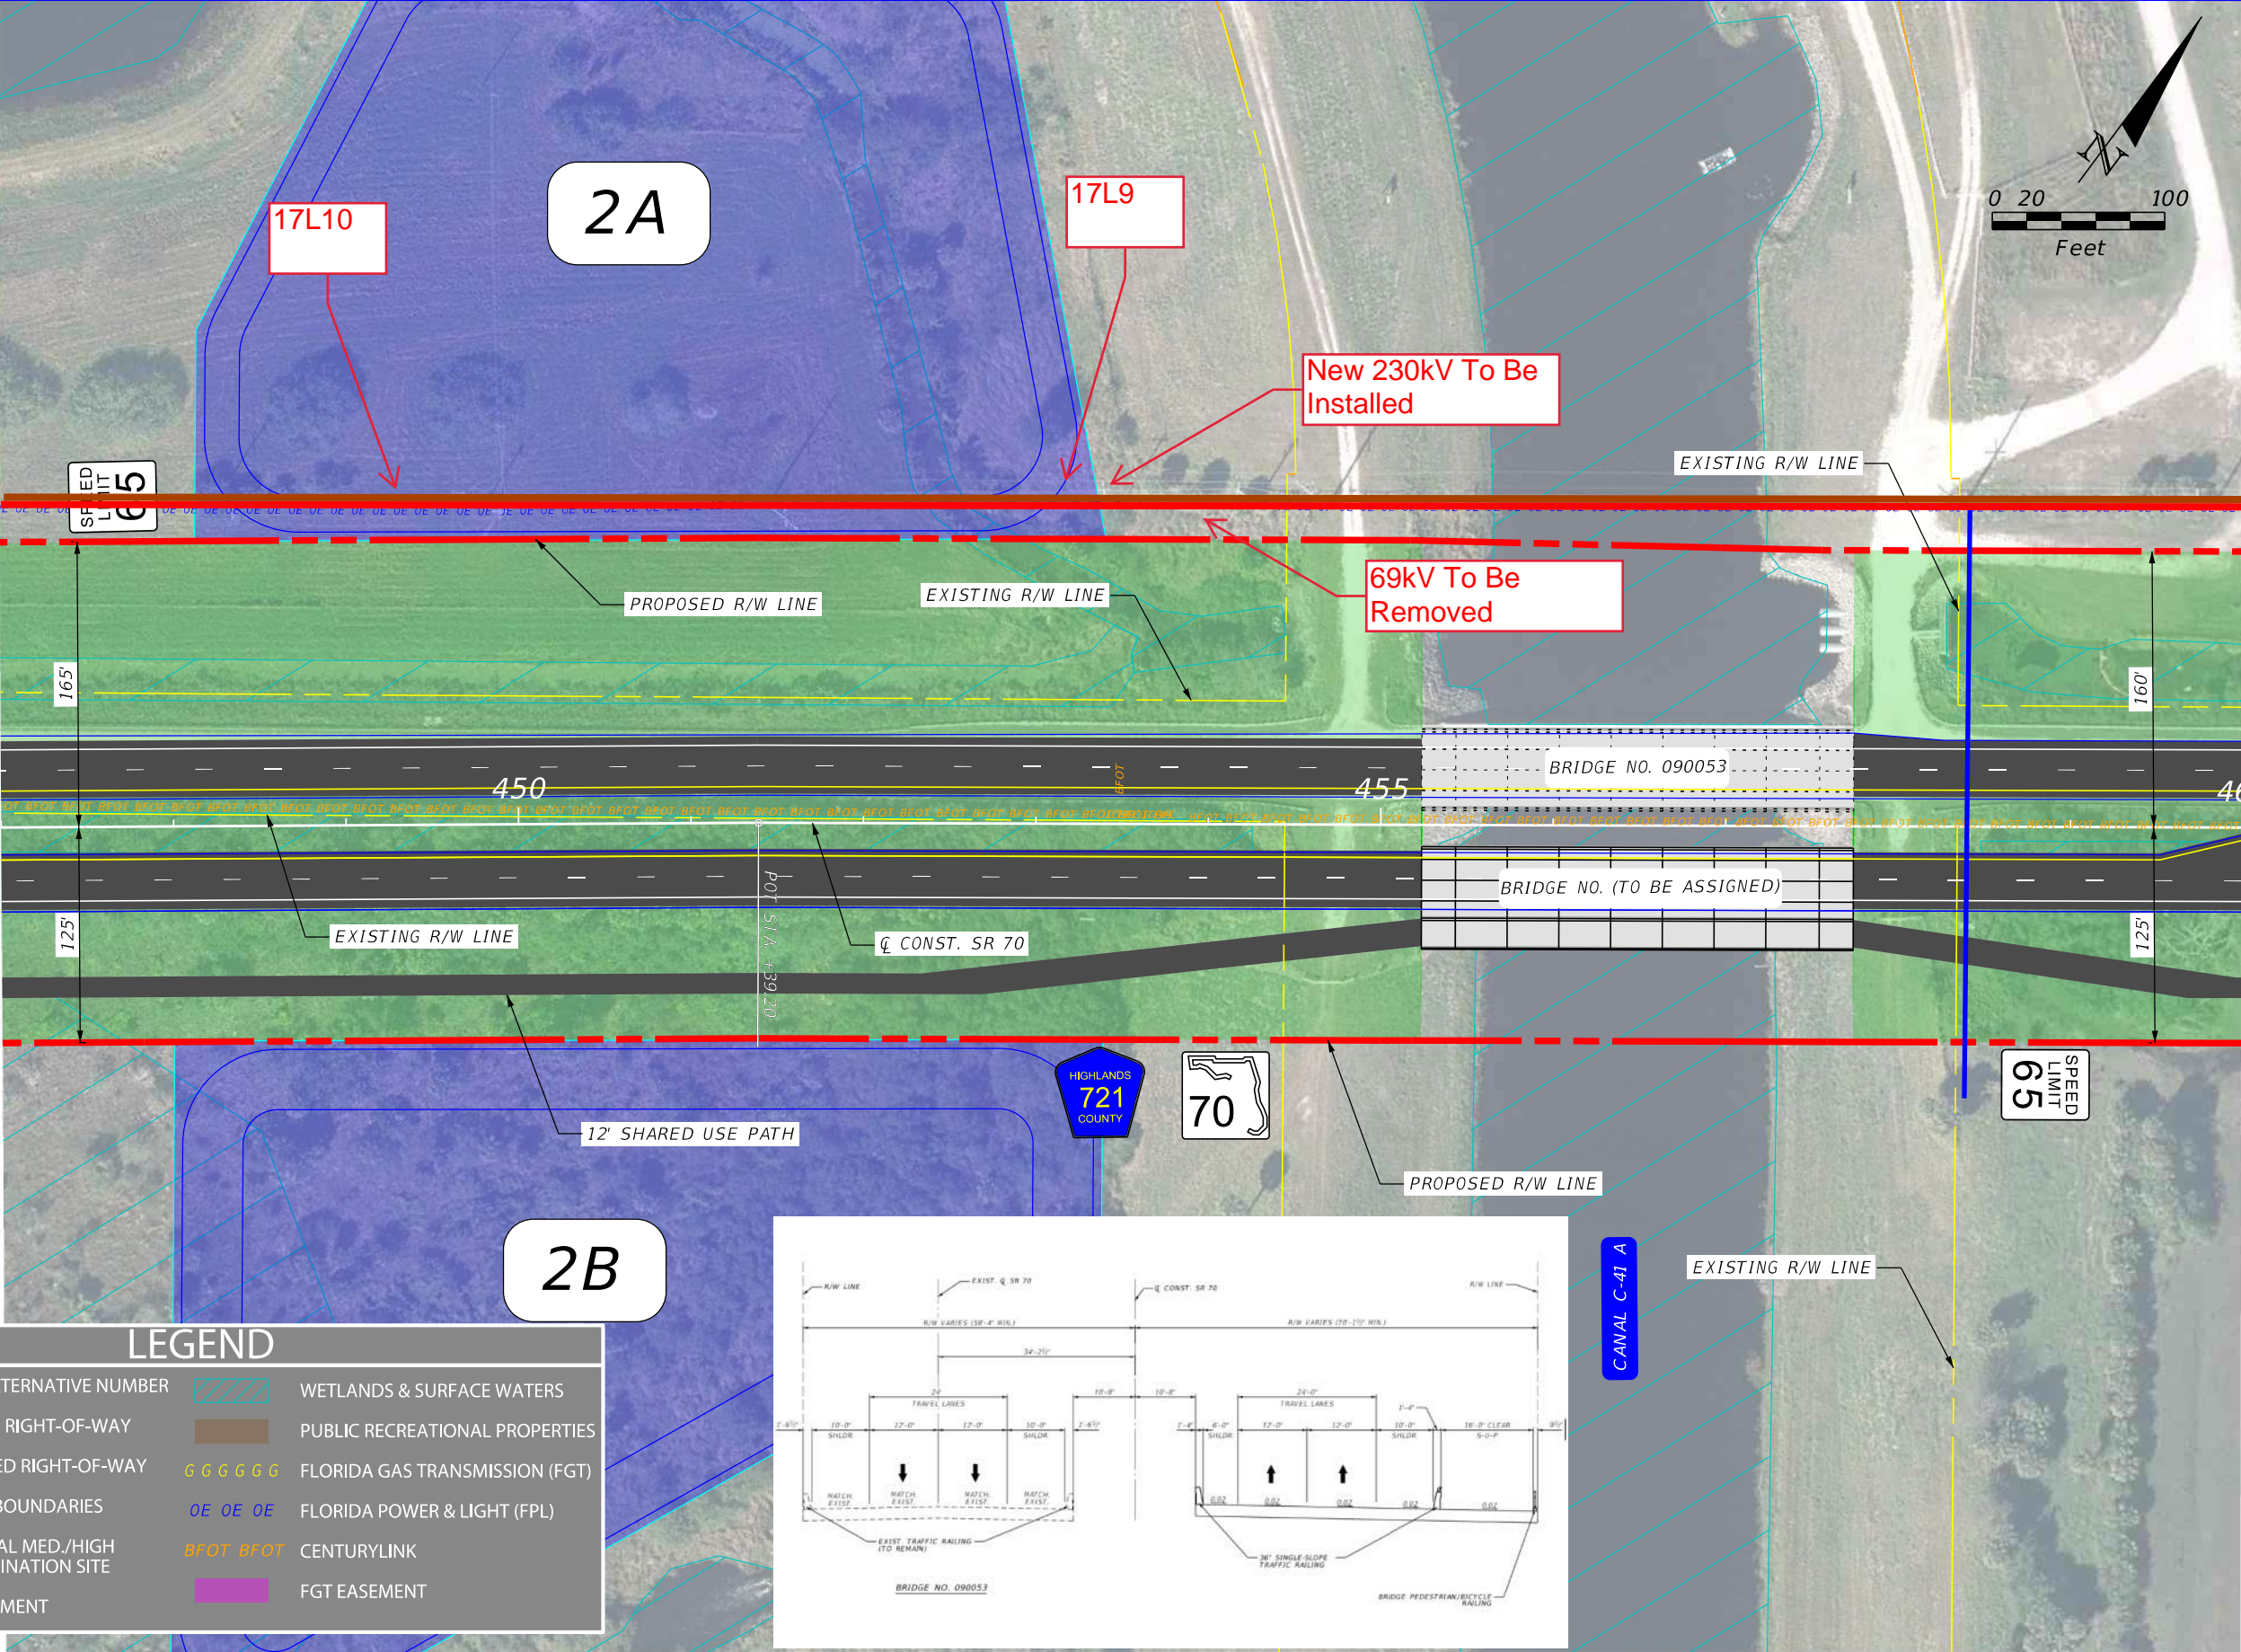

LEGEND

XX

POND ALTERNATIVE NUMBER

EXISTING RIGHT-OF-WAY

PROPOSED RIGHT-OF-WAY

PARCEL BOUNDARIES

#

POTENTIAL MED./HIGH CONTAMINATION SITE

FPL EASEMENT

WETLANDS & SURFACE WATERS

PUBLIC RECREATIONAL PROPERTIES

GGGGGG

FLORIDA GAS TRANSMISSION (FGT)


OE OE OE

FLORIDA POWER & LIGHT (FPL)


BFOT BFOT

CENTURYLINK

FGT EASEMENT

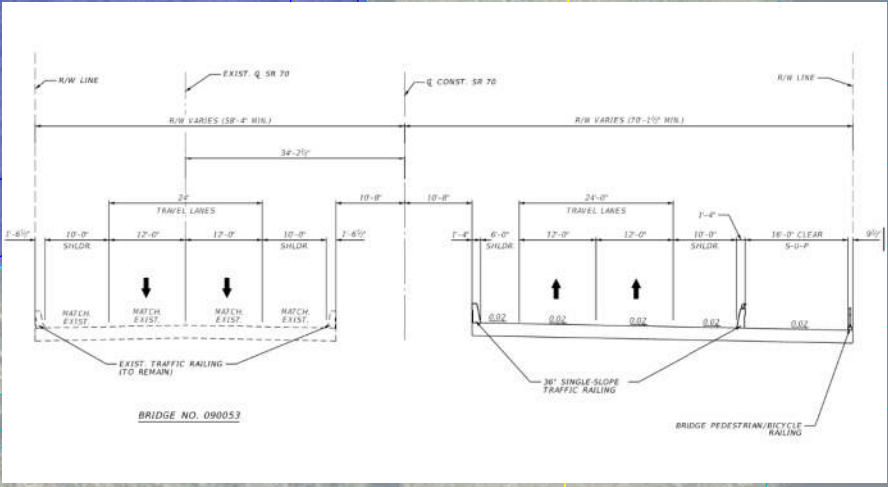

REVISIONS				ENGINEER OF RECORD	STATE OF FLORIDA DEPARTMENT OF TRANSPORTATION			ALTERNATIVE 1 CONCEPT PLAN	SHEET NO.
DATE	DESCRIPTION	DATE	DESCRIPTION	NICHOLAS JOHN CLAVELO LICENSE NUMBER: 84366 SCALAR CONSULTING GROUP INC. 5713 CORPORATE WAY, SUITE 200 WEST PALM BEACH, FLORIDA 33407	ROAD NO.	COUNTY	FINANCIAL PROJECT ID		5
					SR 70	HIGHLANDS OKEECHOBEE	450334-1-22-01		

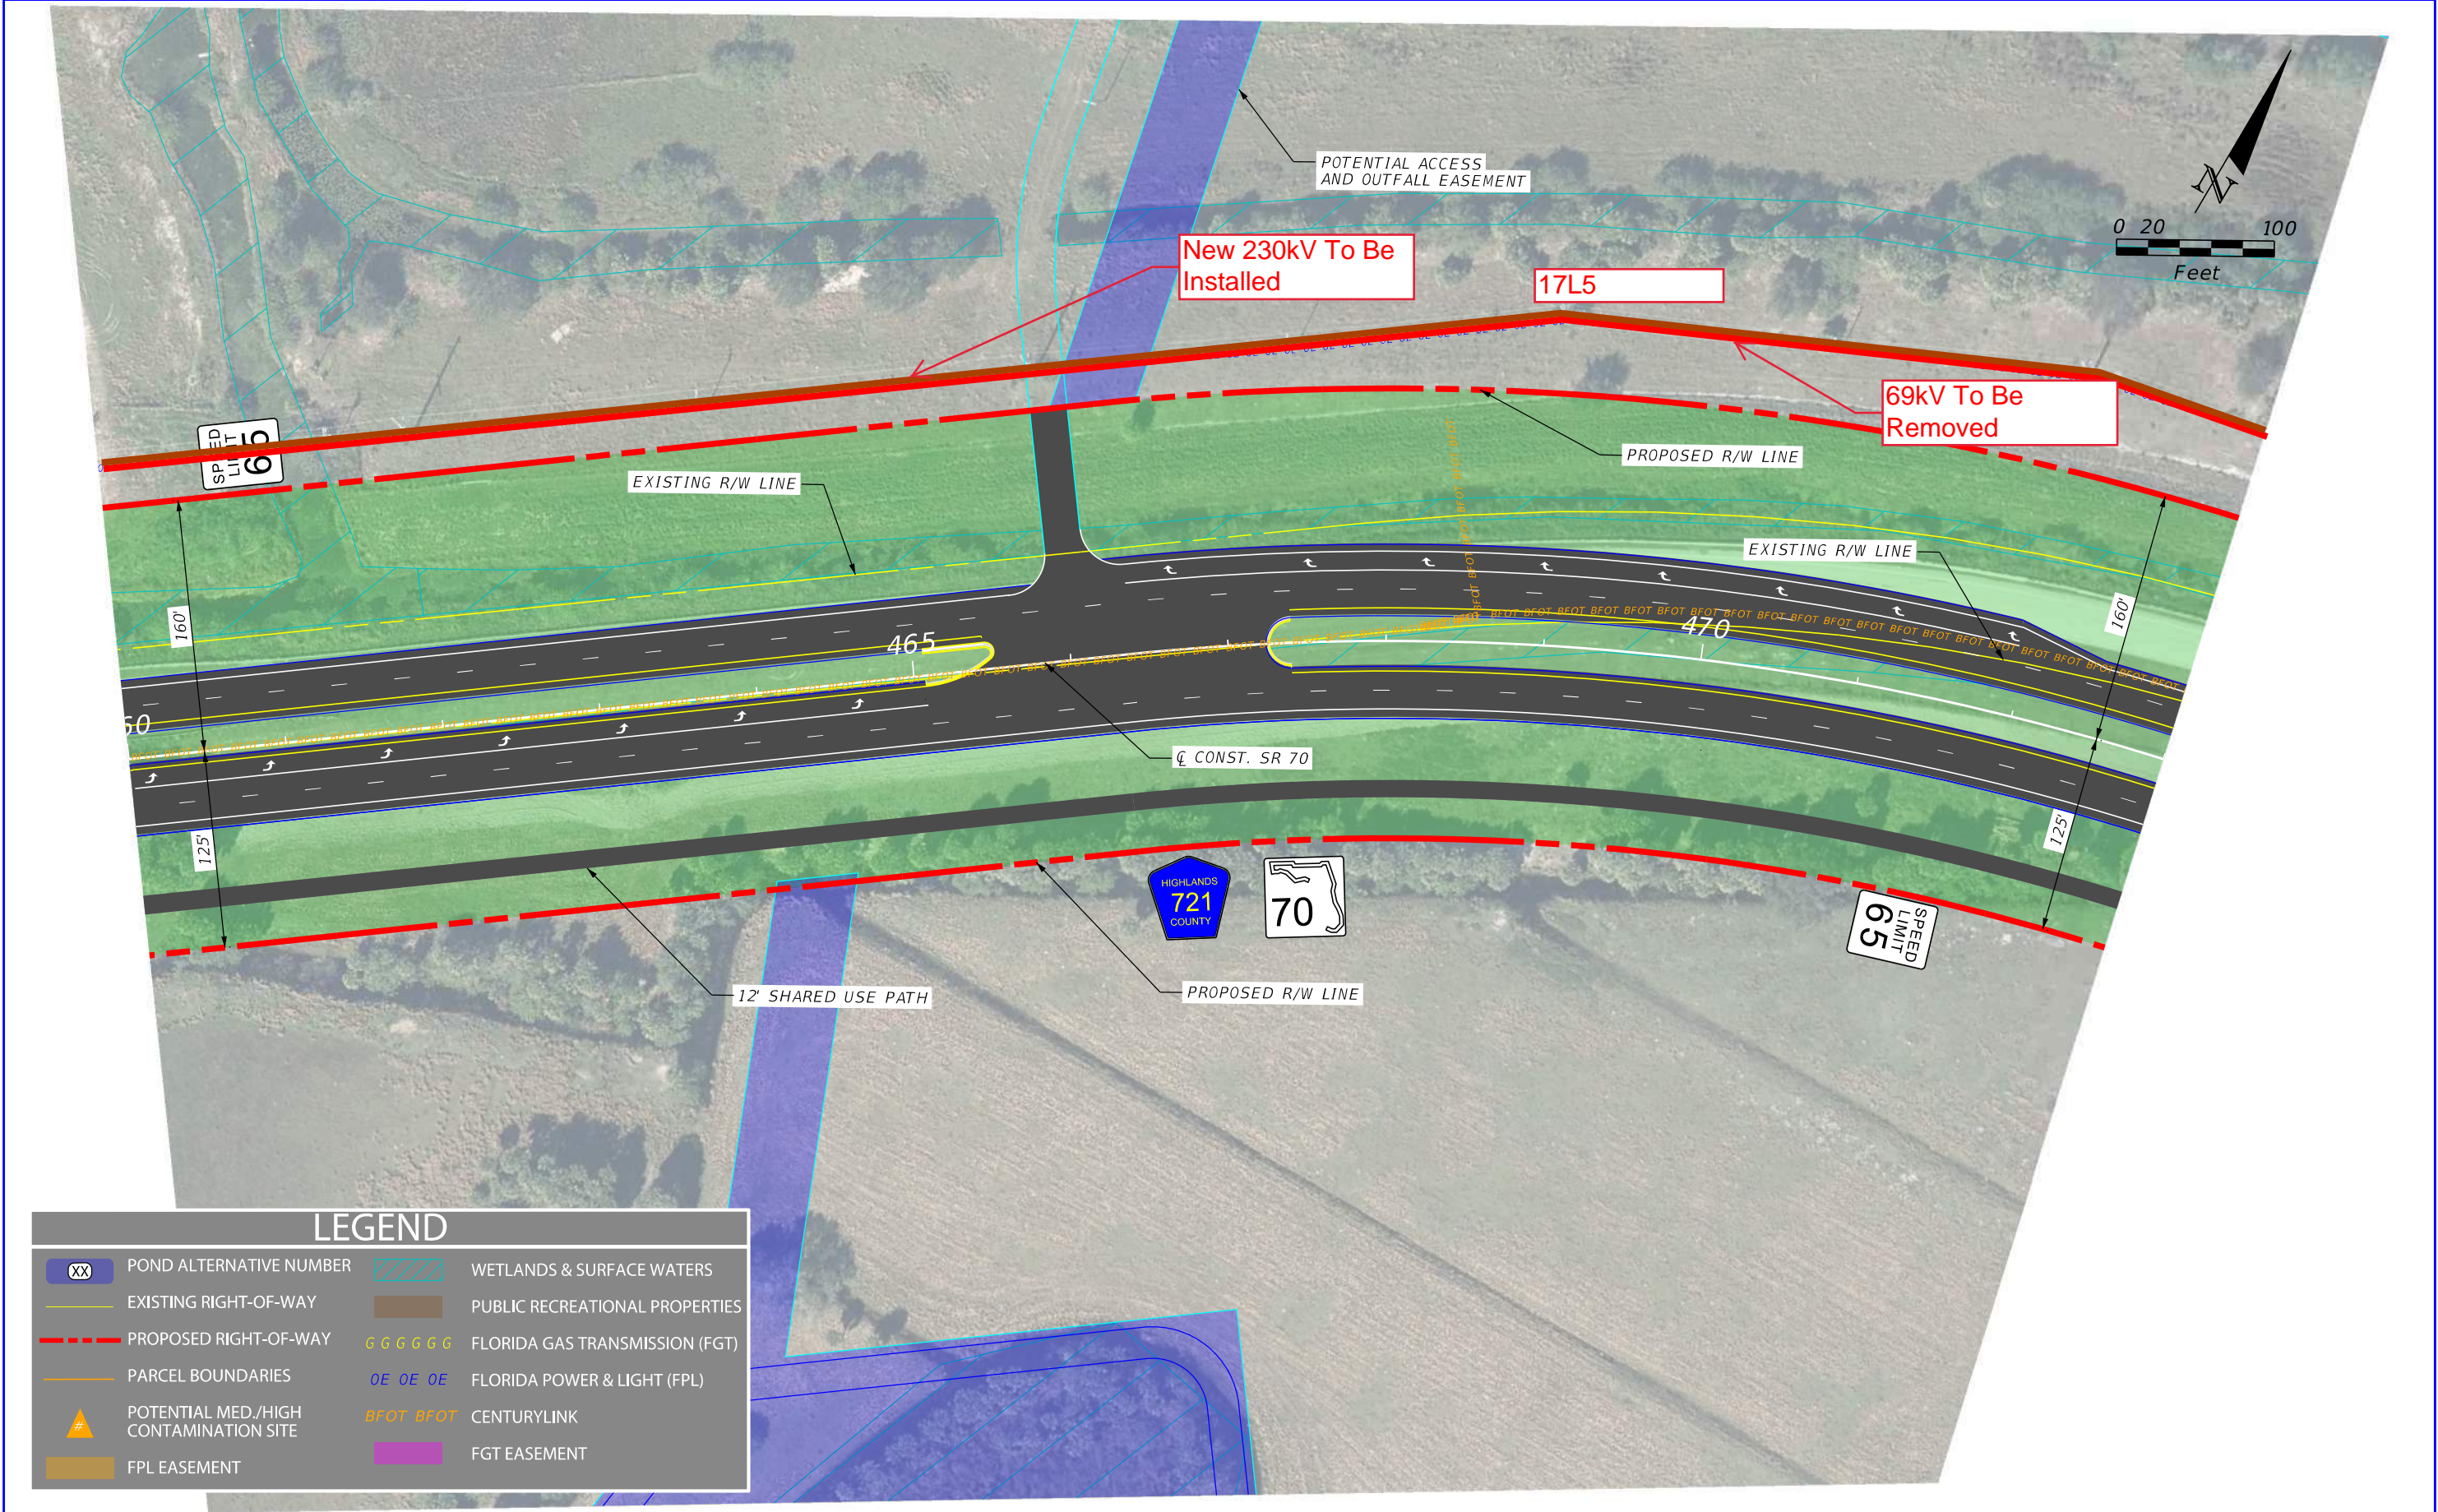

LEGEND

XX

POND ALTERNATIVE NUMBER

EXISTING RIGHT-OF-WAY

PROPOSED RIGHT-OF-WAY

PARCEL BOUNDARIES

#

POTENTIAL MED./HIGH CONTAMINATION SITE

FPL EASEMENT

WETLANDS & SURFACE WATERS

PUBLIC RECREATIONAL PROPERTIES

GGGGGG

FLORIDA GAS TRANSMISSION (FGT)

OE OE OE

FLORIDA POWER & LIGHT (FPL)


BFOT BFOT

CENTURYLINK


FGT EASEMENT

REVISIONS				ENGINEER OF RECORD		STATE OF FLORIDA DEPARTMENT OF TRANSPORTATION		ALTERNATIVE 1 CONCEPT PLAN	SHEET NO. 6
DATE	DESCRIPTION	DATE	DESCRIPTION	NICHOLAS JOHN CLAVELO LICENSE NUMBER: 84366 SCALAR CONSULTING GROUP INC. 5713 CORPORATE WAY, SUITE 200 WEST PALM BEACH, FLORIDA 33407		ROAD NO.	COUNTY		
						SR 70	HIGHLANDS OKEECHOBEE	FINANCIAL PROJECT ID 450334-1-22-01	

P:\FL23010.00 SR 70 PD&E Study\45033412201\roadway\PLANRD01.dgn ; CL10 - PLAN 6 [SHEET]
USER: areginato 11/27/2024 4:56:50 PM

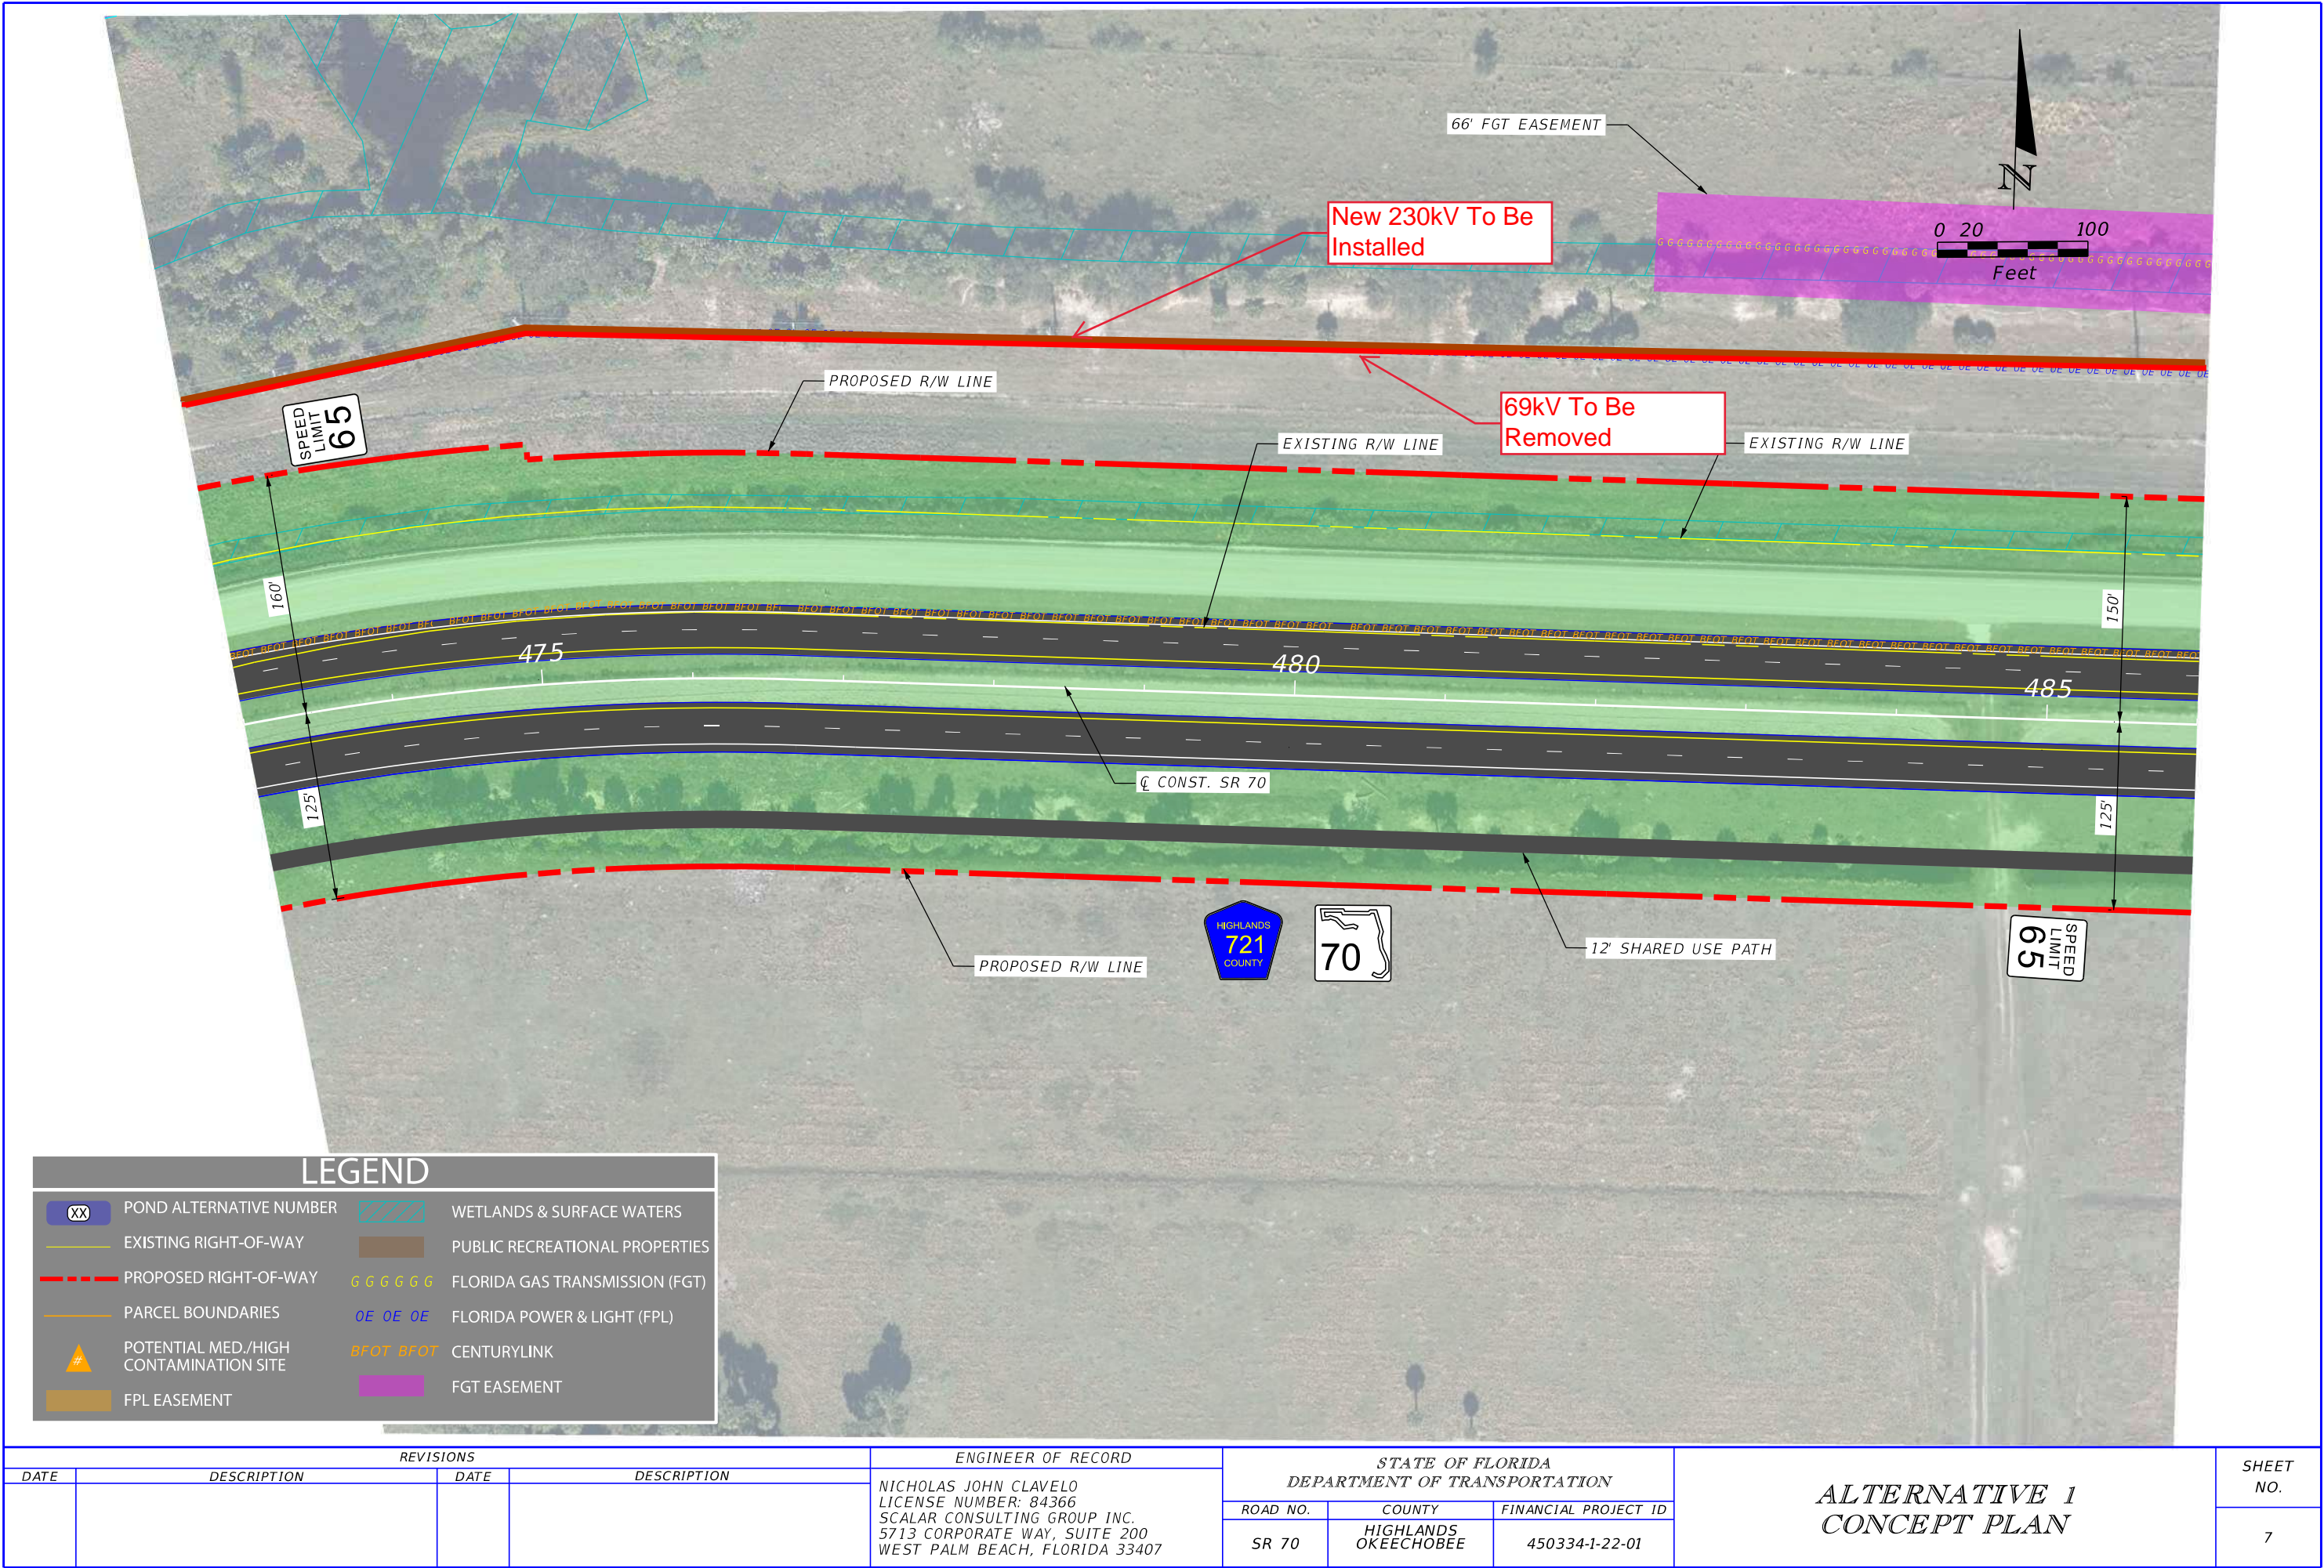

REVISIONS				ENGINEER OF RECORD		STATE OF FLORIDA DEPARTMENT OF TRANSPORTATION		ALTERNATIVE 1 CONCEPT PLAN	SHEET NO. 7
DATE	DESCRIPTION	DATE	DESCRIPTION	NICHOLAS JOHN CLAVELO LICENSE NUMBER: 84366 SCALAR CONSULTING GROUP INC. 5713 CORPORATE WAY, SUITE 200 WEST PALM BEACH, FLORIDA 33407		ROAD NO.	COUNTY		
						SR 70	HIGHLANDS OKEECHOBEE	FINANCIAL PROJECT ID 450334-1-22-01	

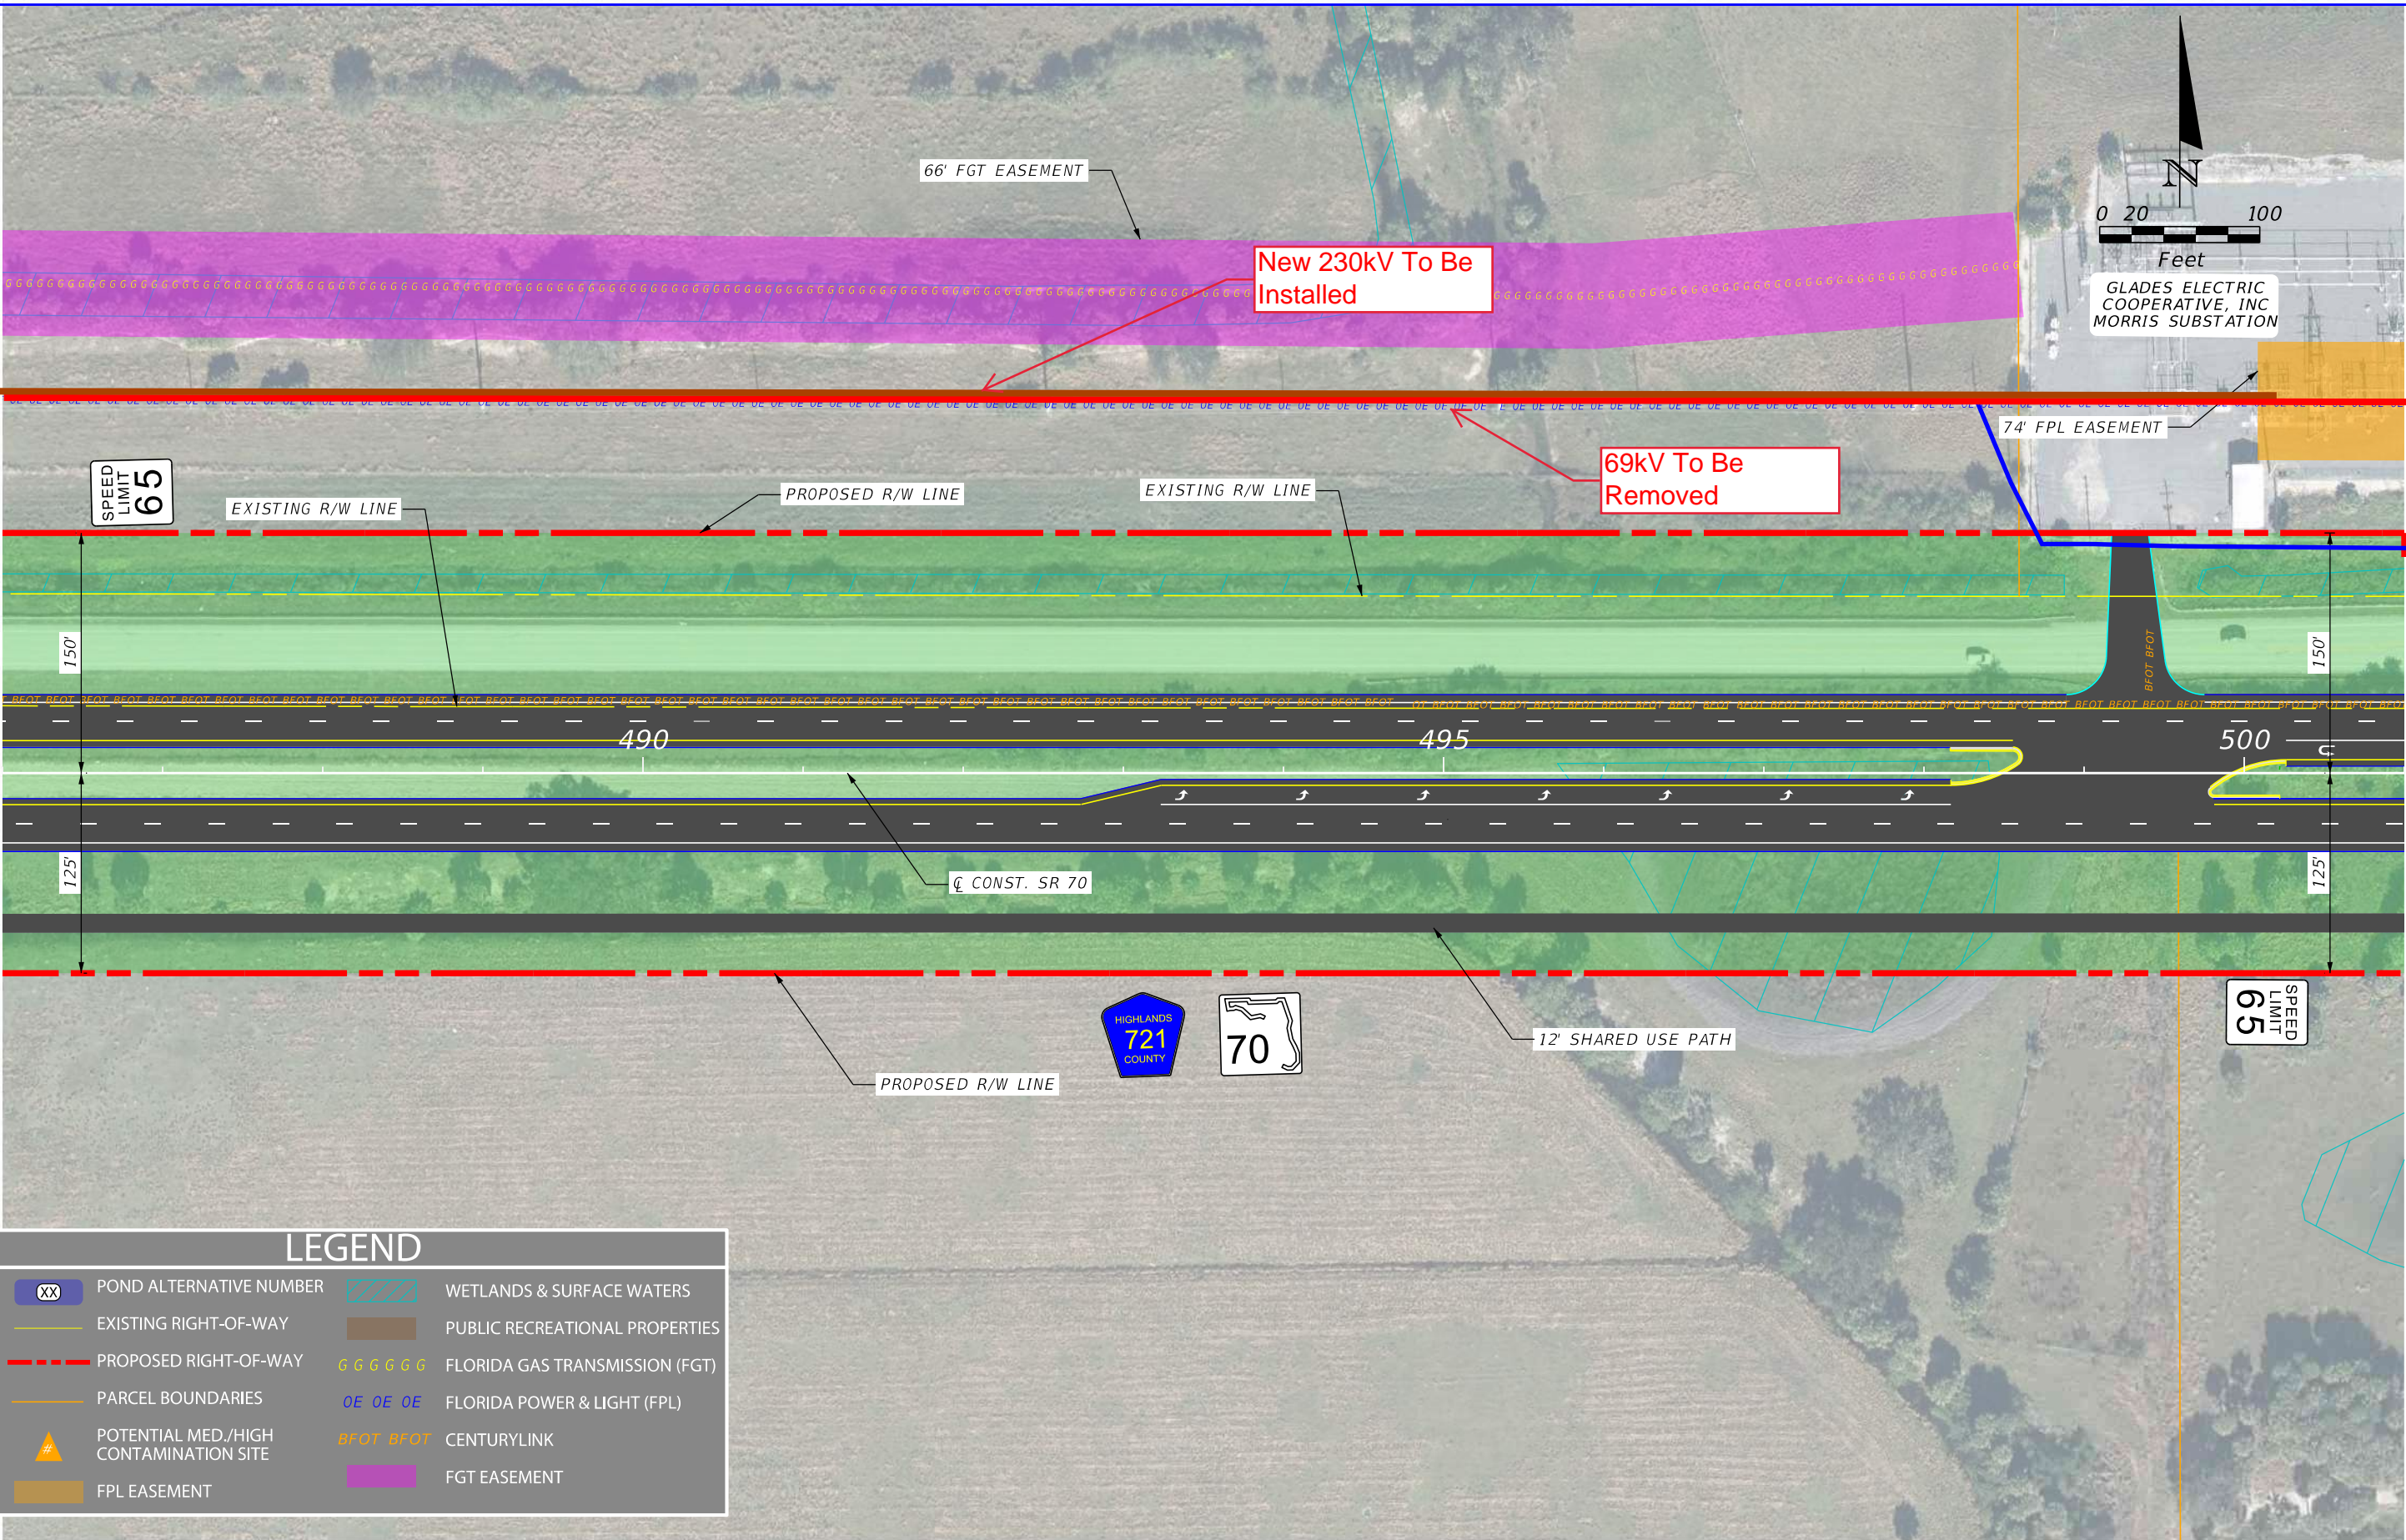

LEGEND

XX

POND ALTERNATIVE NUMBER

EXISTING RIGHT-OF-WAY

PROPOSED RIGHT-OF-WAY

PARCEL BOUNDARIES

#

POTENTIAL MED/HIGH CONTAMINATION SITE

FPL EASEMENT

WETLANDS & SURFACE WATERS

PUBLIC RECREATIONAL PROPERTIES

GGGGGG

FLORIDA GAS TRANSMISSION (FGT)

OE OE OE

FLORIDA POWER & LIGHT (FPL)

BFOT BFOT


CENTURYLINK

FGT EASEMENT

REVISIONS				ENGINEER OF RECORD			STATE OF FLORIDA DEPARTMENT OF TRANSPORTATION			SHEET NO. 8
DATE	DESCRIPTION	DATE	DESCRIPTION	NICHOLAS JOHN CLAVELO LICENSE NUMBER: 84366 SCALAR CONSULTING GROUP INC. 5713 CORPORATE WAY, SUITE 200 WEST PALM BEACH, FLORIDA 33407			ROAD NO.	COUNTY	FINANCIAL PROJECT ID	
							SR 70	HIGHLANDS OKEECHOBEE	450334-1-22-01	

ALTERNATIVE 1
CONCEPT PLAN

P:\FL23010.00 SR 70 PD&E Study\45033412201\roadway\PLANRD01.dgn : CL11 - PLAN 8 [SHEET]
USER: areginato 11/27/2024 4:57:00 PM

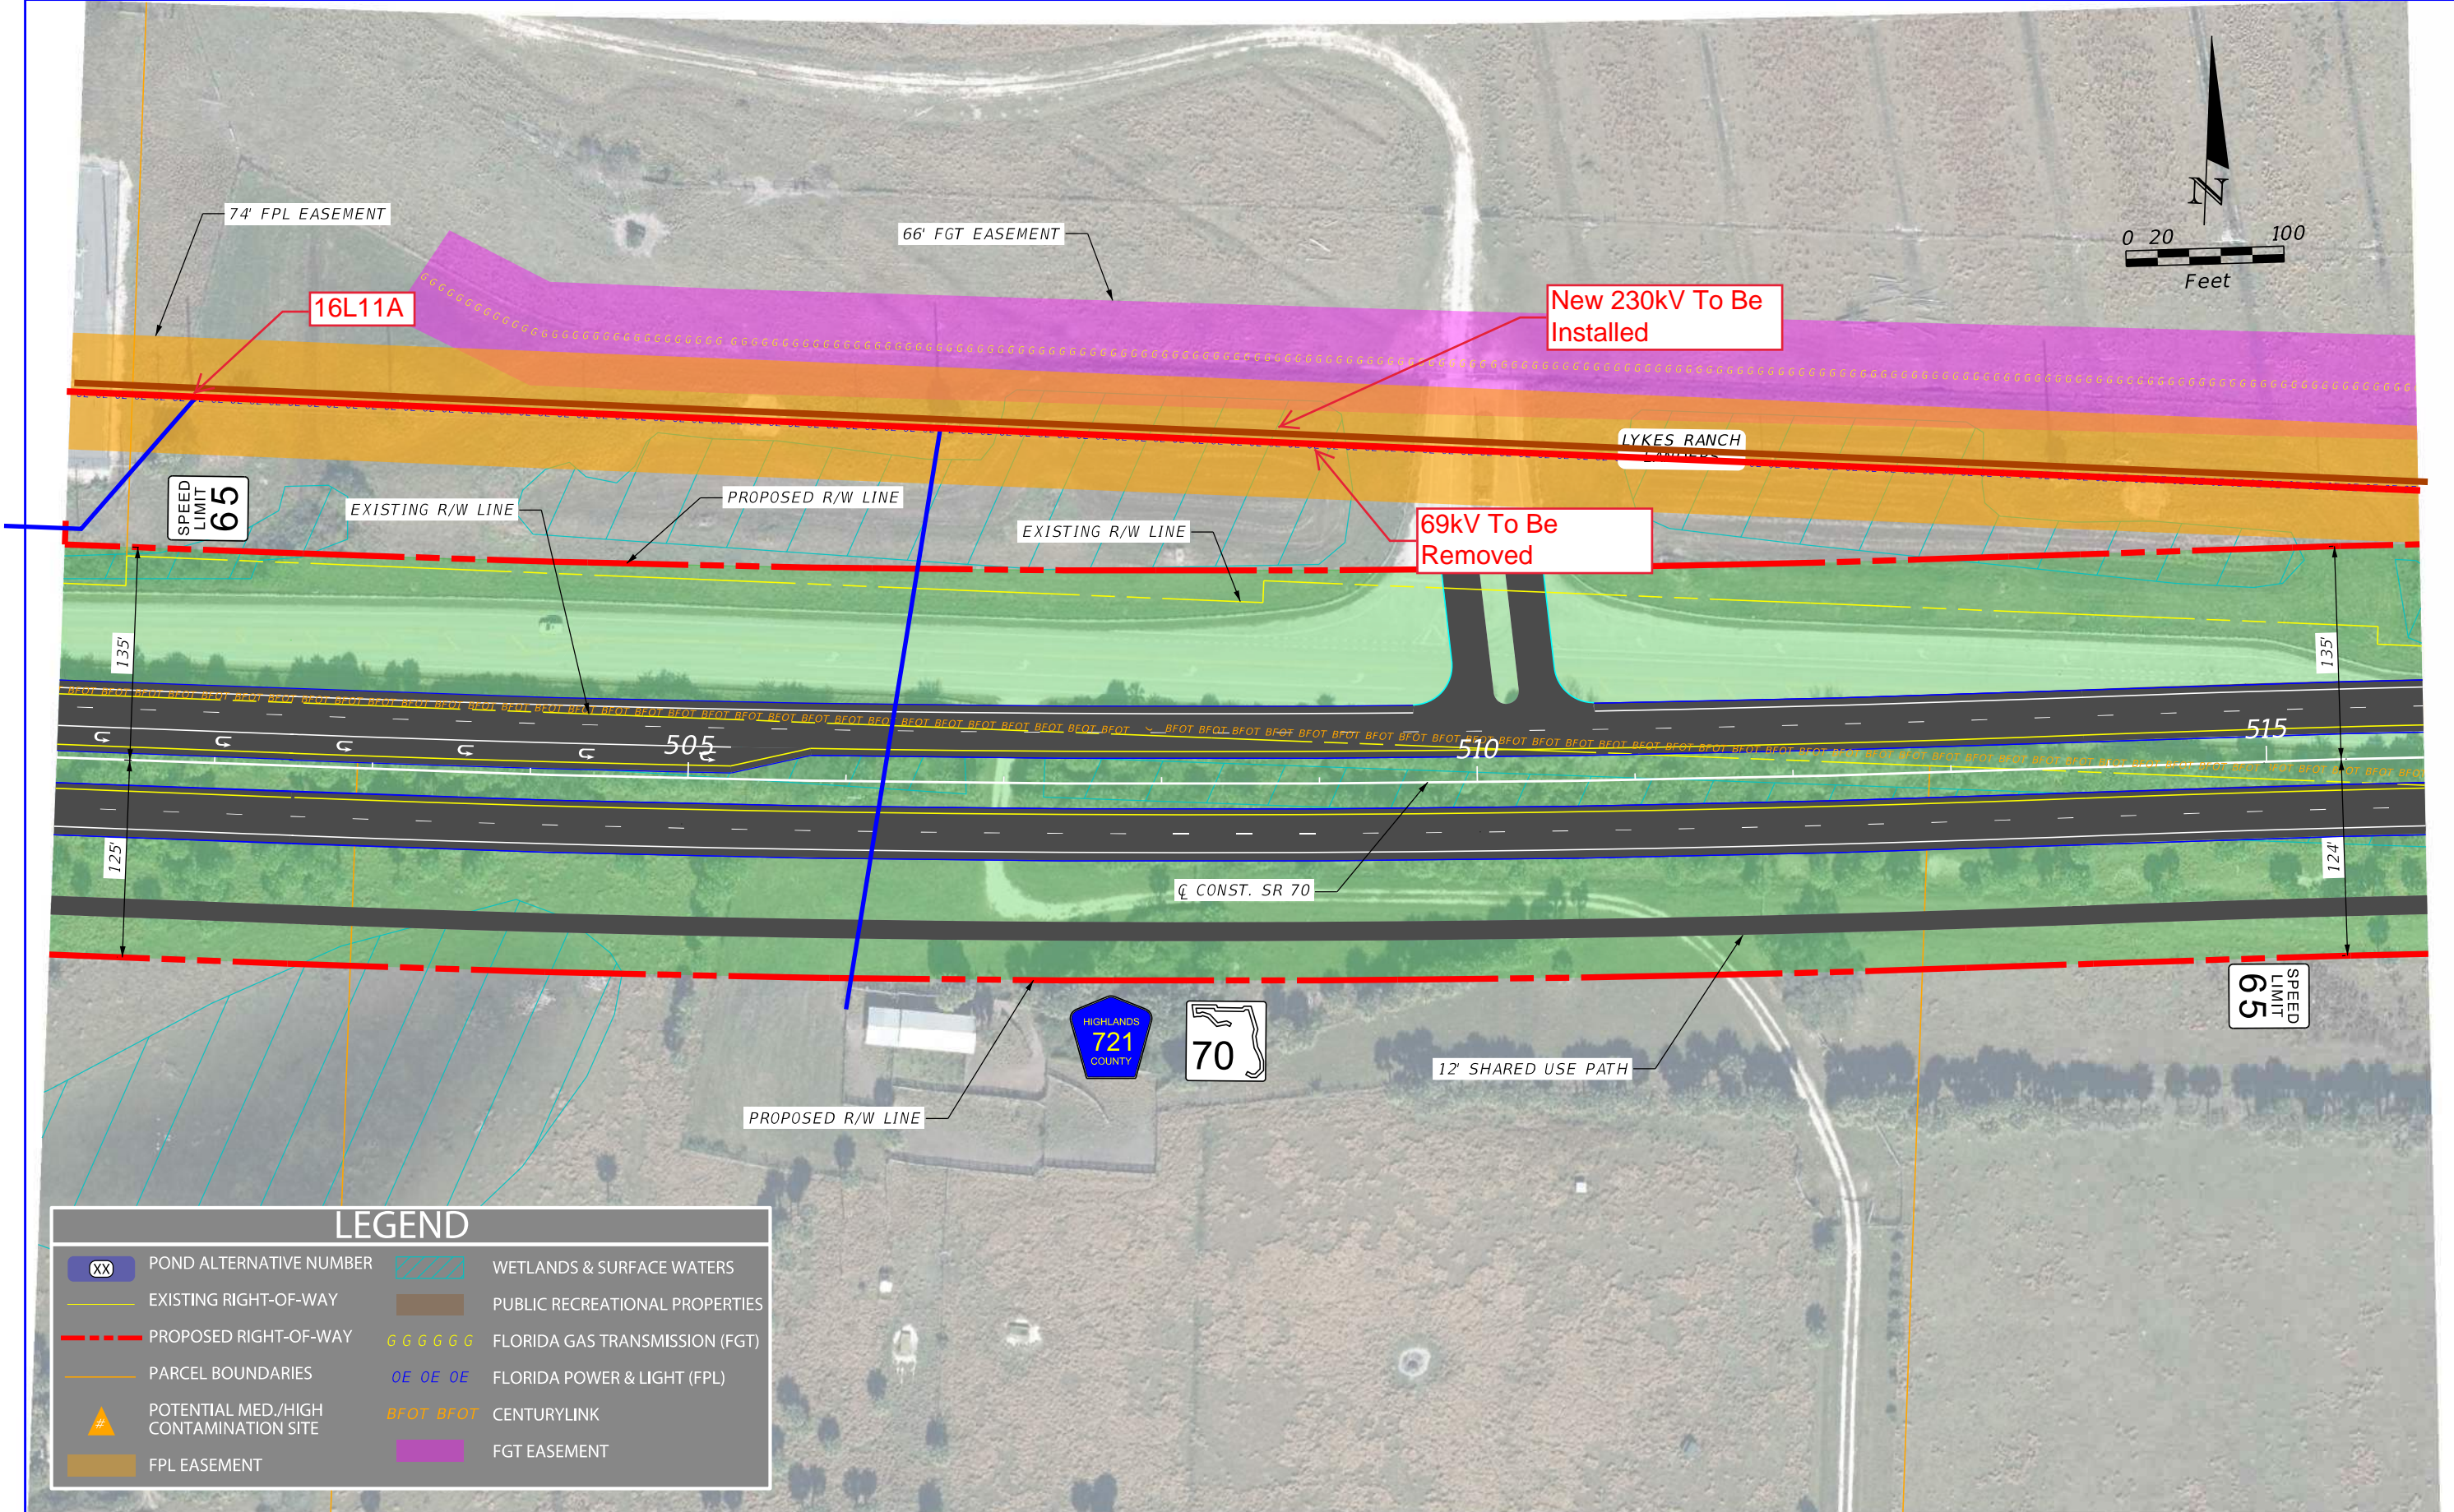

LEGEND

XX

POND ALTERNATIVE NUMBER

EXISTING RIGHT-OF-WAY

PROPOSED RIGHT-OF-WAY

PARCEL BOUNDARIES

#

POTENTIAL MED/HIGH CONTAMINATION SITE

FPL EASEMENT

WETLANDS & SURFACE WATERS

PUBLIC RECREATIONAL PROPERTIES

GGGGGG

FLORIDA GAS TRANSMISSION (FGT)

OE OE OE


FLORIDA POWER & LIGHT (FPL)

BFOT BFOT

CENTURYLINK

FGT EASEMENT

REVISIONS				ENGINEER OF RECORD		STATE OF FLORIDA DEPARTMENT OF TRANSPORTATION		ALTERNATIVE 1 CONCEPT PLAN	SHEET NO. 9
DATE	DESCRIPTION	DATE	DESCRIPTION	NICHOLAS JOHN CLAVELO LICENSE NUMBER: 84366 SCALAR CONSULTING GROUP INC. 5713 CORPORATE WAY, SUITE 200 WEST PALM BEACH, FLORIDA 33407		ROAD NO.	COUNTY		
						SR 70	HIGHLANDS OKEECHOBEE	FINANCIAL PROJECT ID 450334-1-22-01	

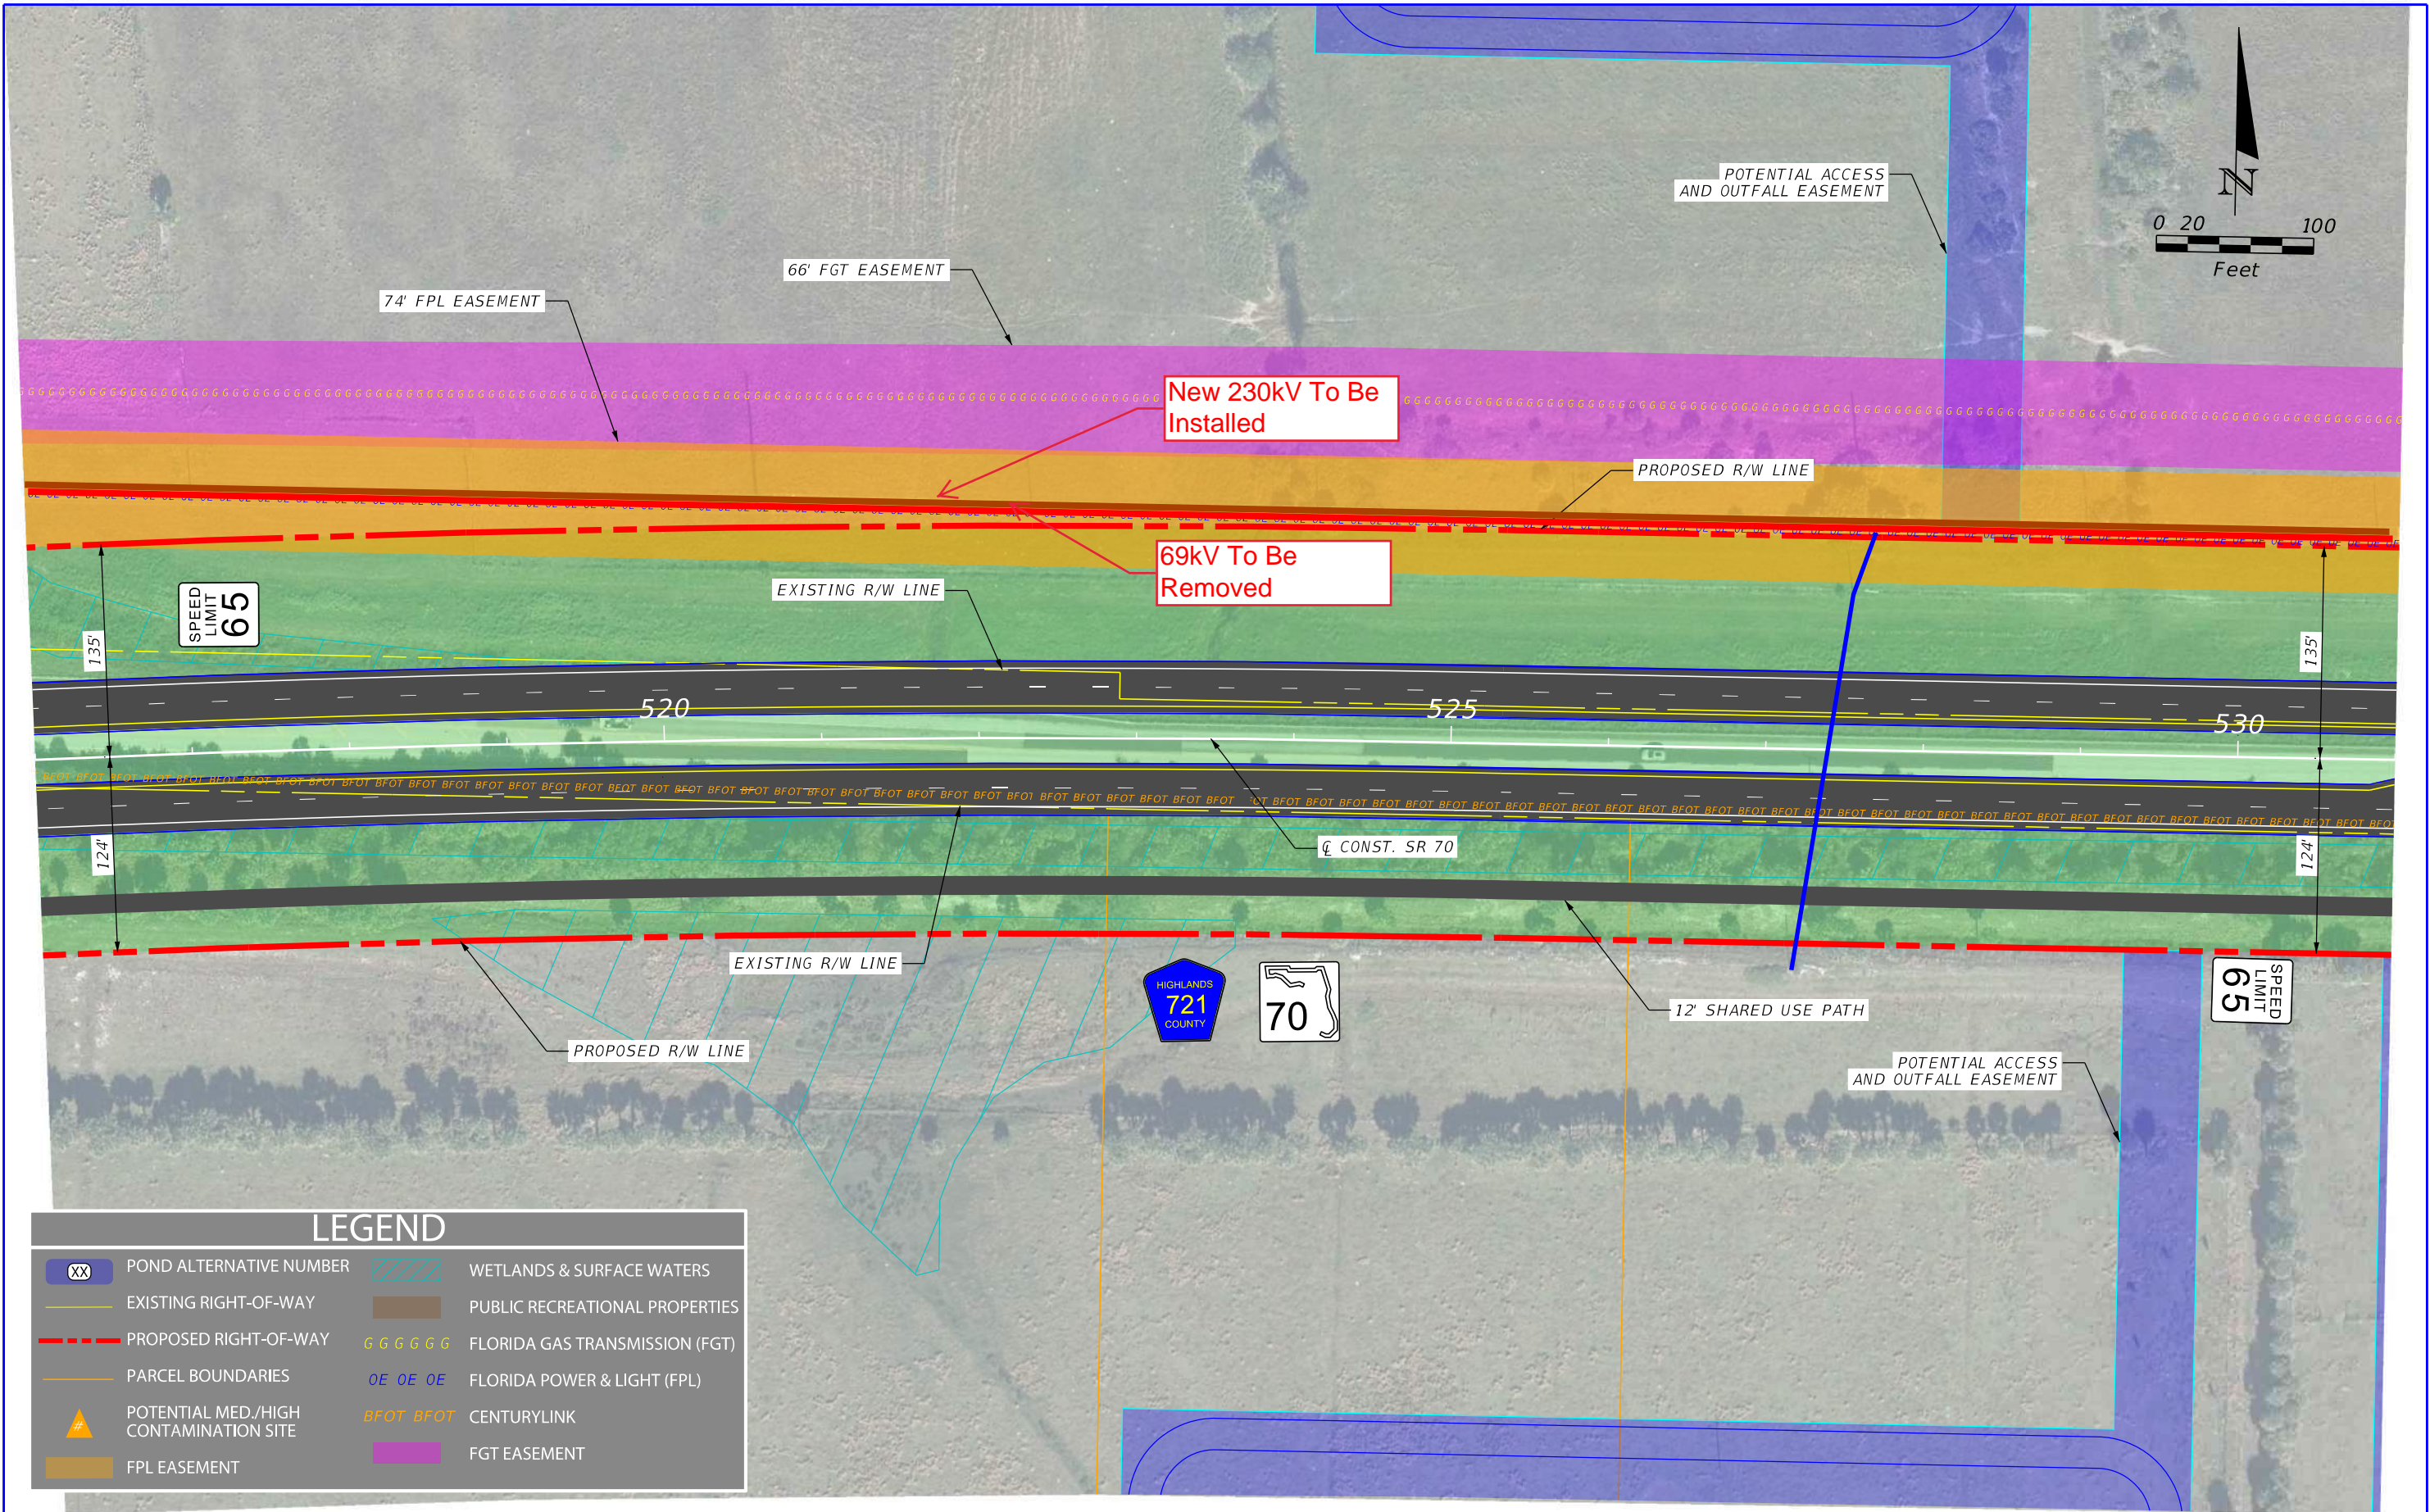

LEGEND

XX

POND ALTERNATIVE NUMBER

EXISTING RIGHT-OF-WAY

PROPOSED RIGHT-OF-WAY

PARCEL BOUNDARIES

#

POTENTIAL MED./HIGH CONTAMINATION SITE

FPL EASEMENT

WETLANDS & SURFACE WATERS

PUBLIC RECREATIONAL PROPERTIES

GGGGGG

FLORIDA GAS TRANSMISSION (FGT)

OE OE OE


FLORIDA POWER & LIGHT (FPL)

BFOT BFOT


CENTURYLINK

FGT EASEMENT

REVISIONS				ENGINEER OF RECORD		STATE OF FLORIDA DEPARTMENT OF TRANSPORTATION		ALTERNATIVE 1 CONCEPT PLAN	SHEET NO. 10
DATE	DESCRIPTION	DATE	DESCRIPTION	NICHOLAS JOHN CLAVELO LICENSE NUMBER: 84366 SCALAR CONSULTING GROUP INC. 5713 CORPORATE WAY, SUITE 200 WEST PALM BEACH, FLORIDA 33407		ROAD NO.	COUNTY		
						SR 70	HIGHLANDS OKEECHOBEE	FINANCIAL PROJECT ID 450334-1-22-01	

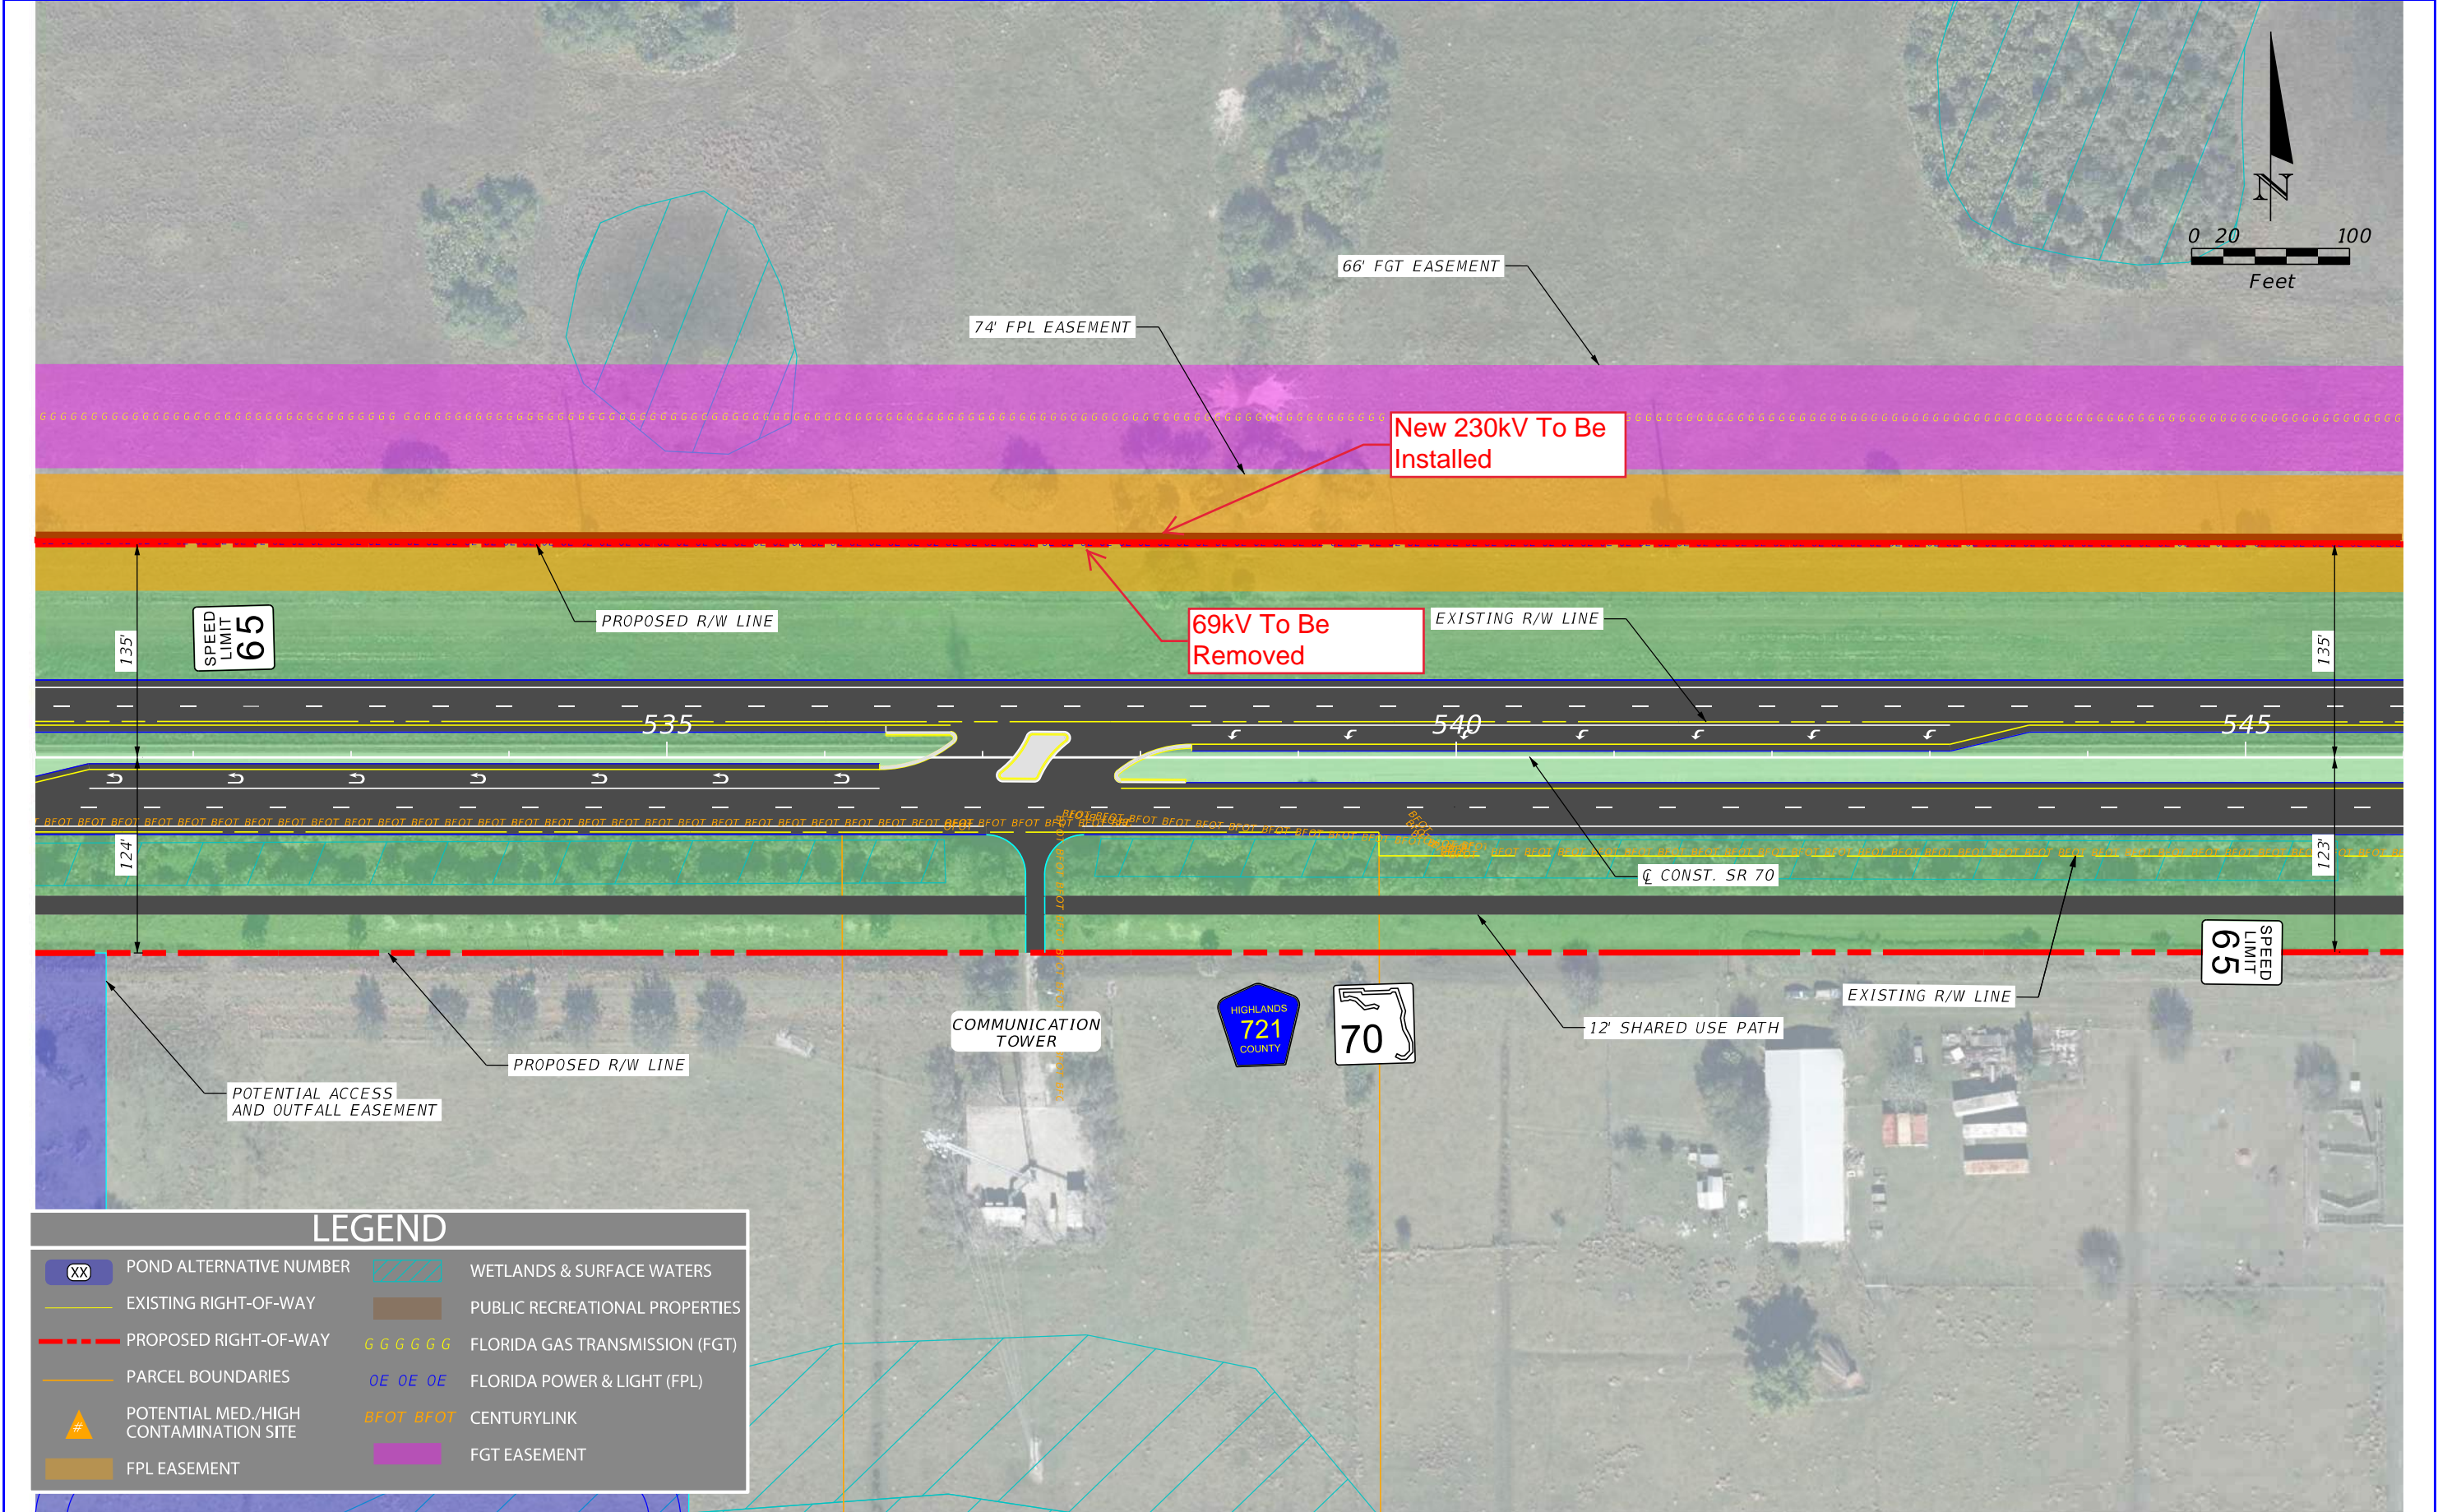


REVISIONS				ENGINEER OF RECORD		STATE OF FLORIDA DEPARTMENT OF TRANSPORTATION		ALTERNATIVE 1 CONCEPT PLAN	SHEET NO. 11
DATE	DESCRIPTION	DATE	DESCRIPTION	NICHOLAS JOHN CLAVELO LICENSE NUMBER: 84366 SCALAR CONSULTING GROUP INC. 5713 CORPORATE WAY, SUITE 200 WEST PALM BEACH, FLORIDA 33407		ROAD NO.	COUNTY		
						SR 70	HIGHLANDS OKEECHOBEE	FINANCIAL PROJECT ID 450334-1-22-01	

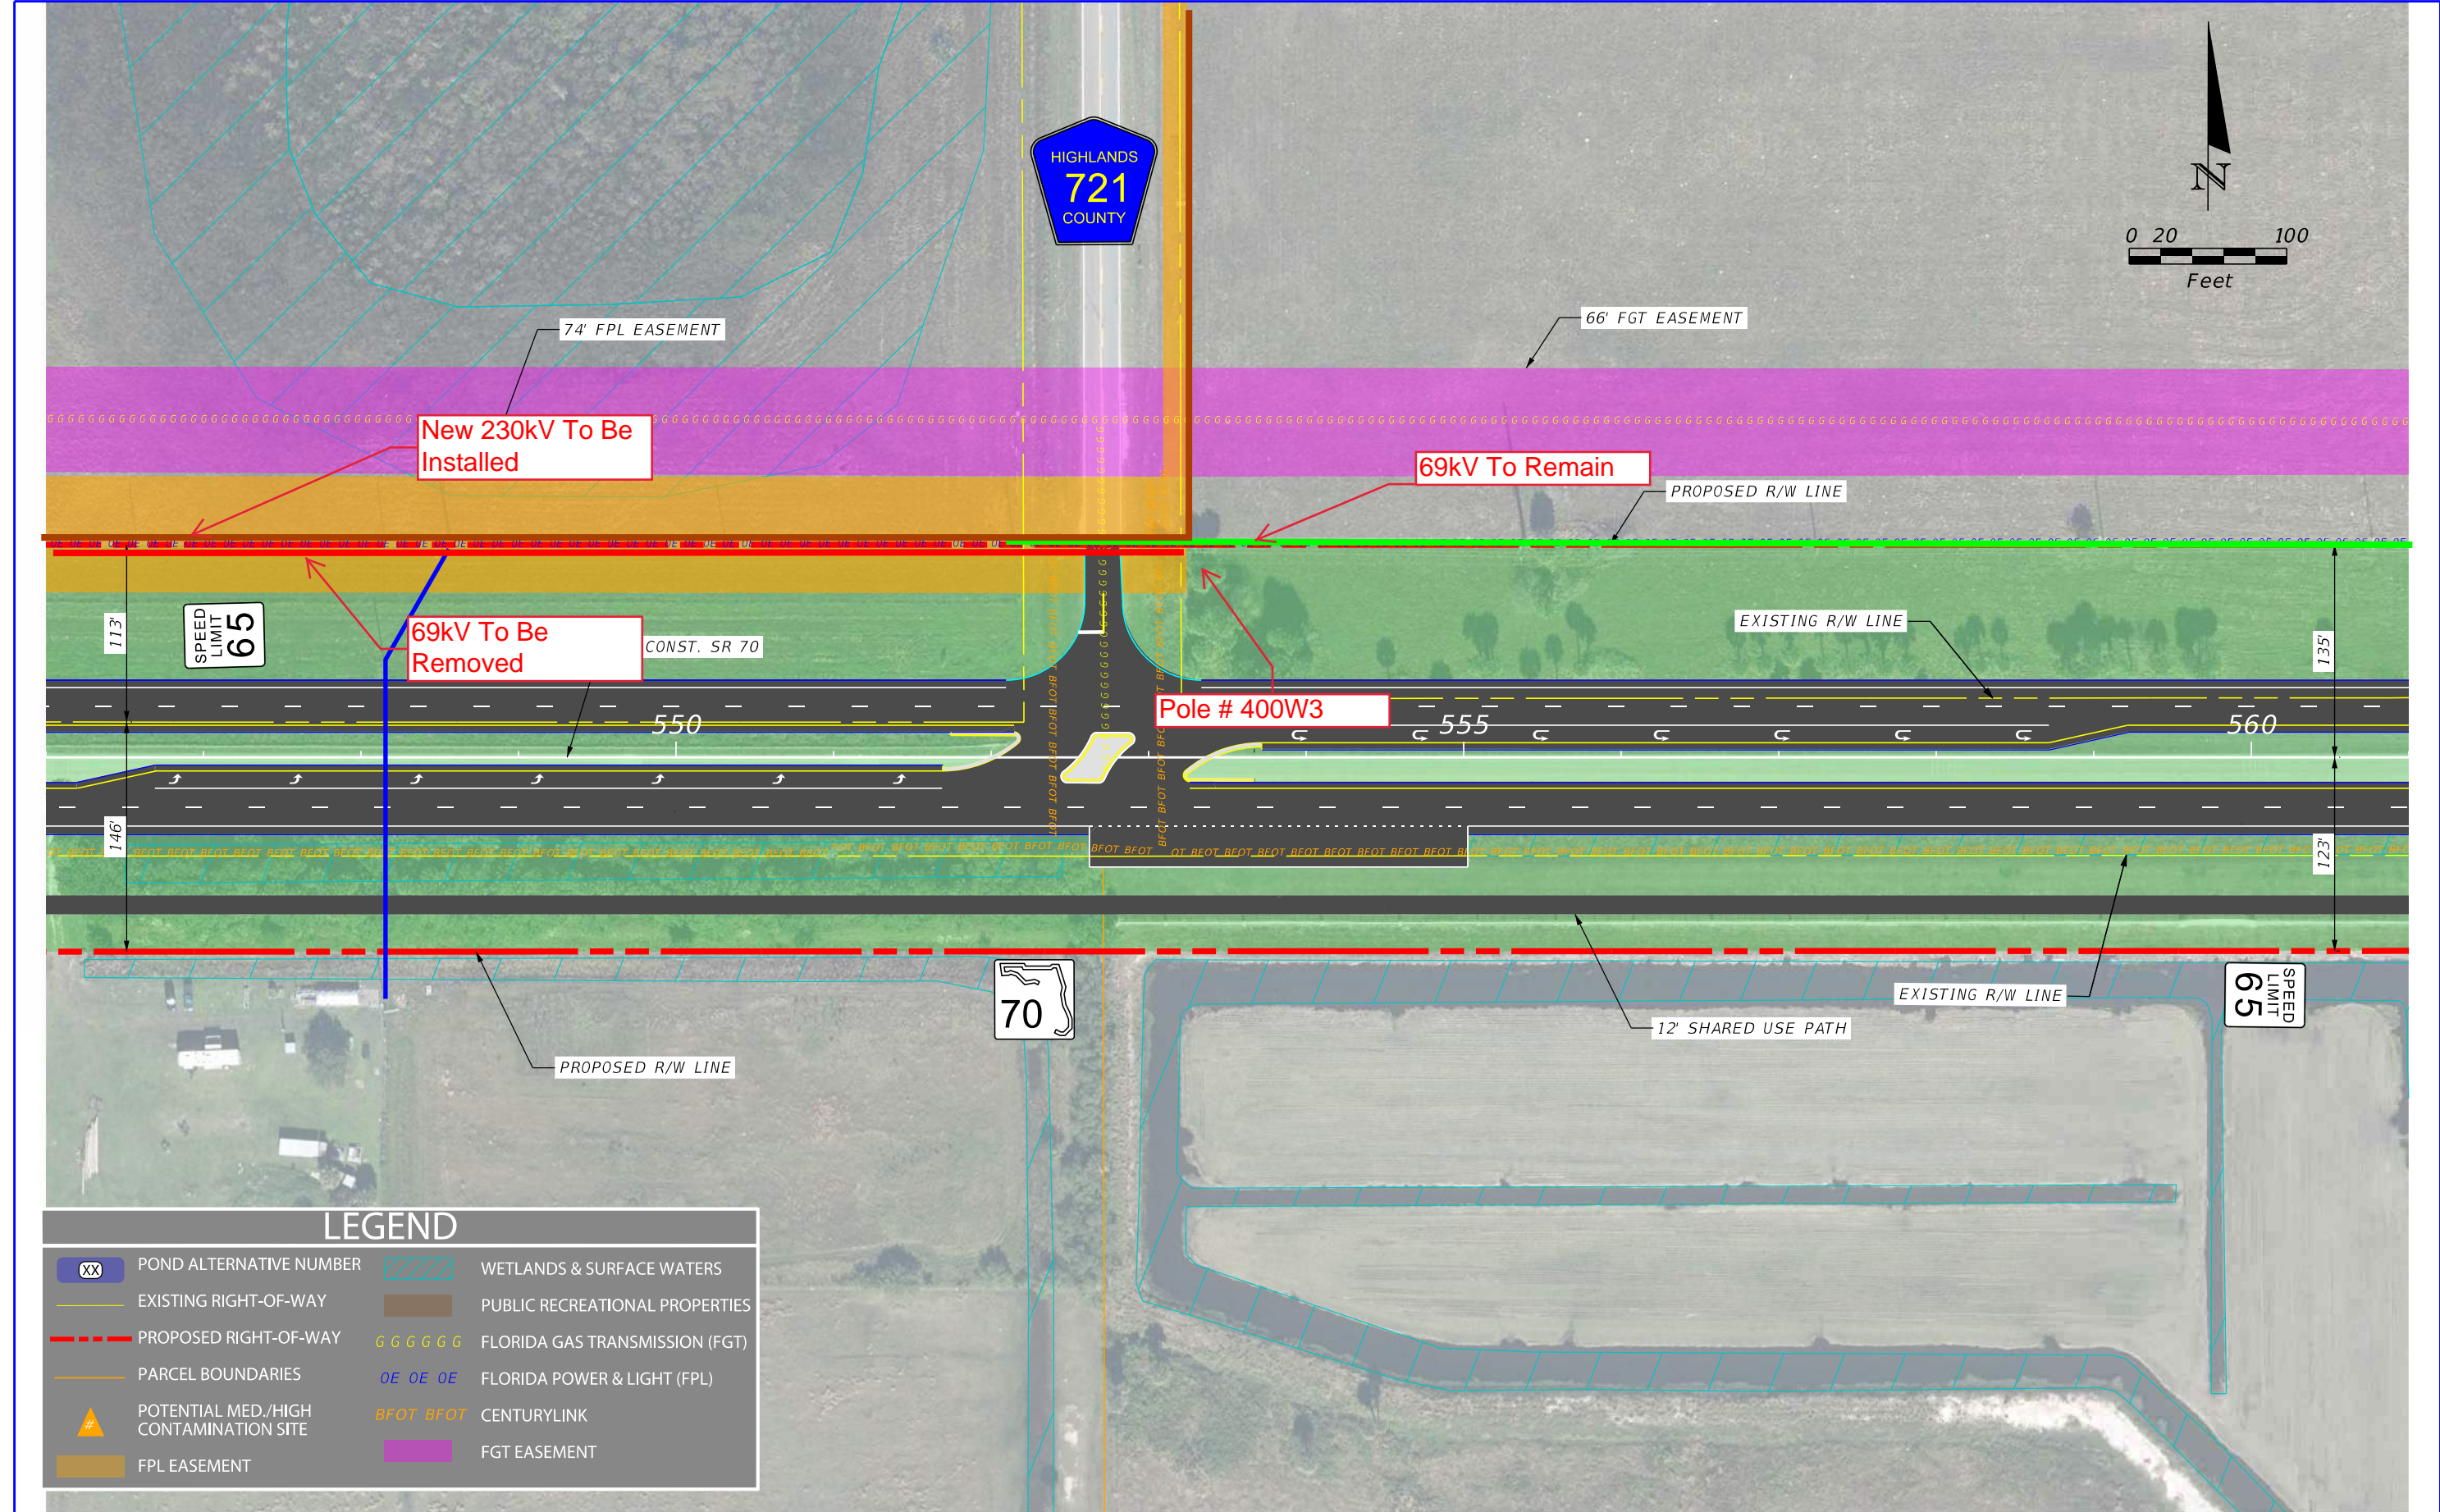

REVISIONS				ENGINEER OF RECORD		STATE OF FLORIDA DEPARTMENT OF TRANSPORTATION		ALTERNATIVE 1 CONCEPT PLAN	SHEET NO. 12
DATE	DESCRIPTION	DATE	DESCRIPTION	NICHOLAS JOHN CLAVELO LICENSE NUMBER: 84366 SCALAR CONSULTING GROUP INC. 5713 CORPORATE WAY, SUITE 200 WEST PALM BEACH, FLORIDA 33407		ROAD NO.	COUNTY		
						SR 70	HIGHLANDS OKEECHOBEE	FINANCIAL PROJECT ID 450334-1-22-01	

APPENDIX E
PREFERRED ALTERNATIVE CONCEPT PLANS

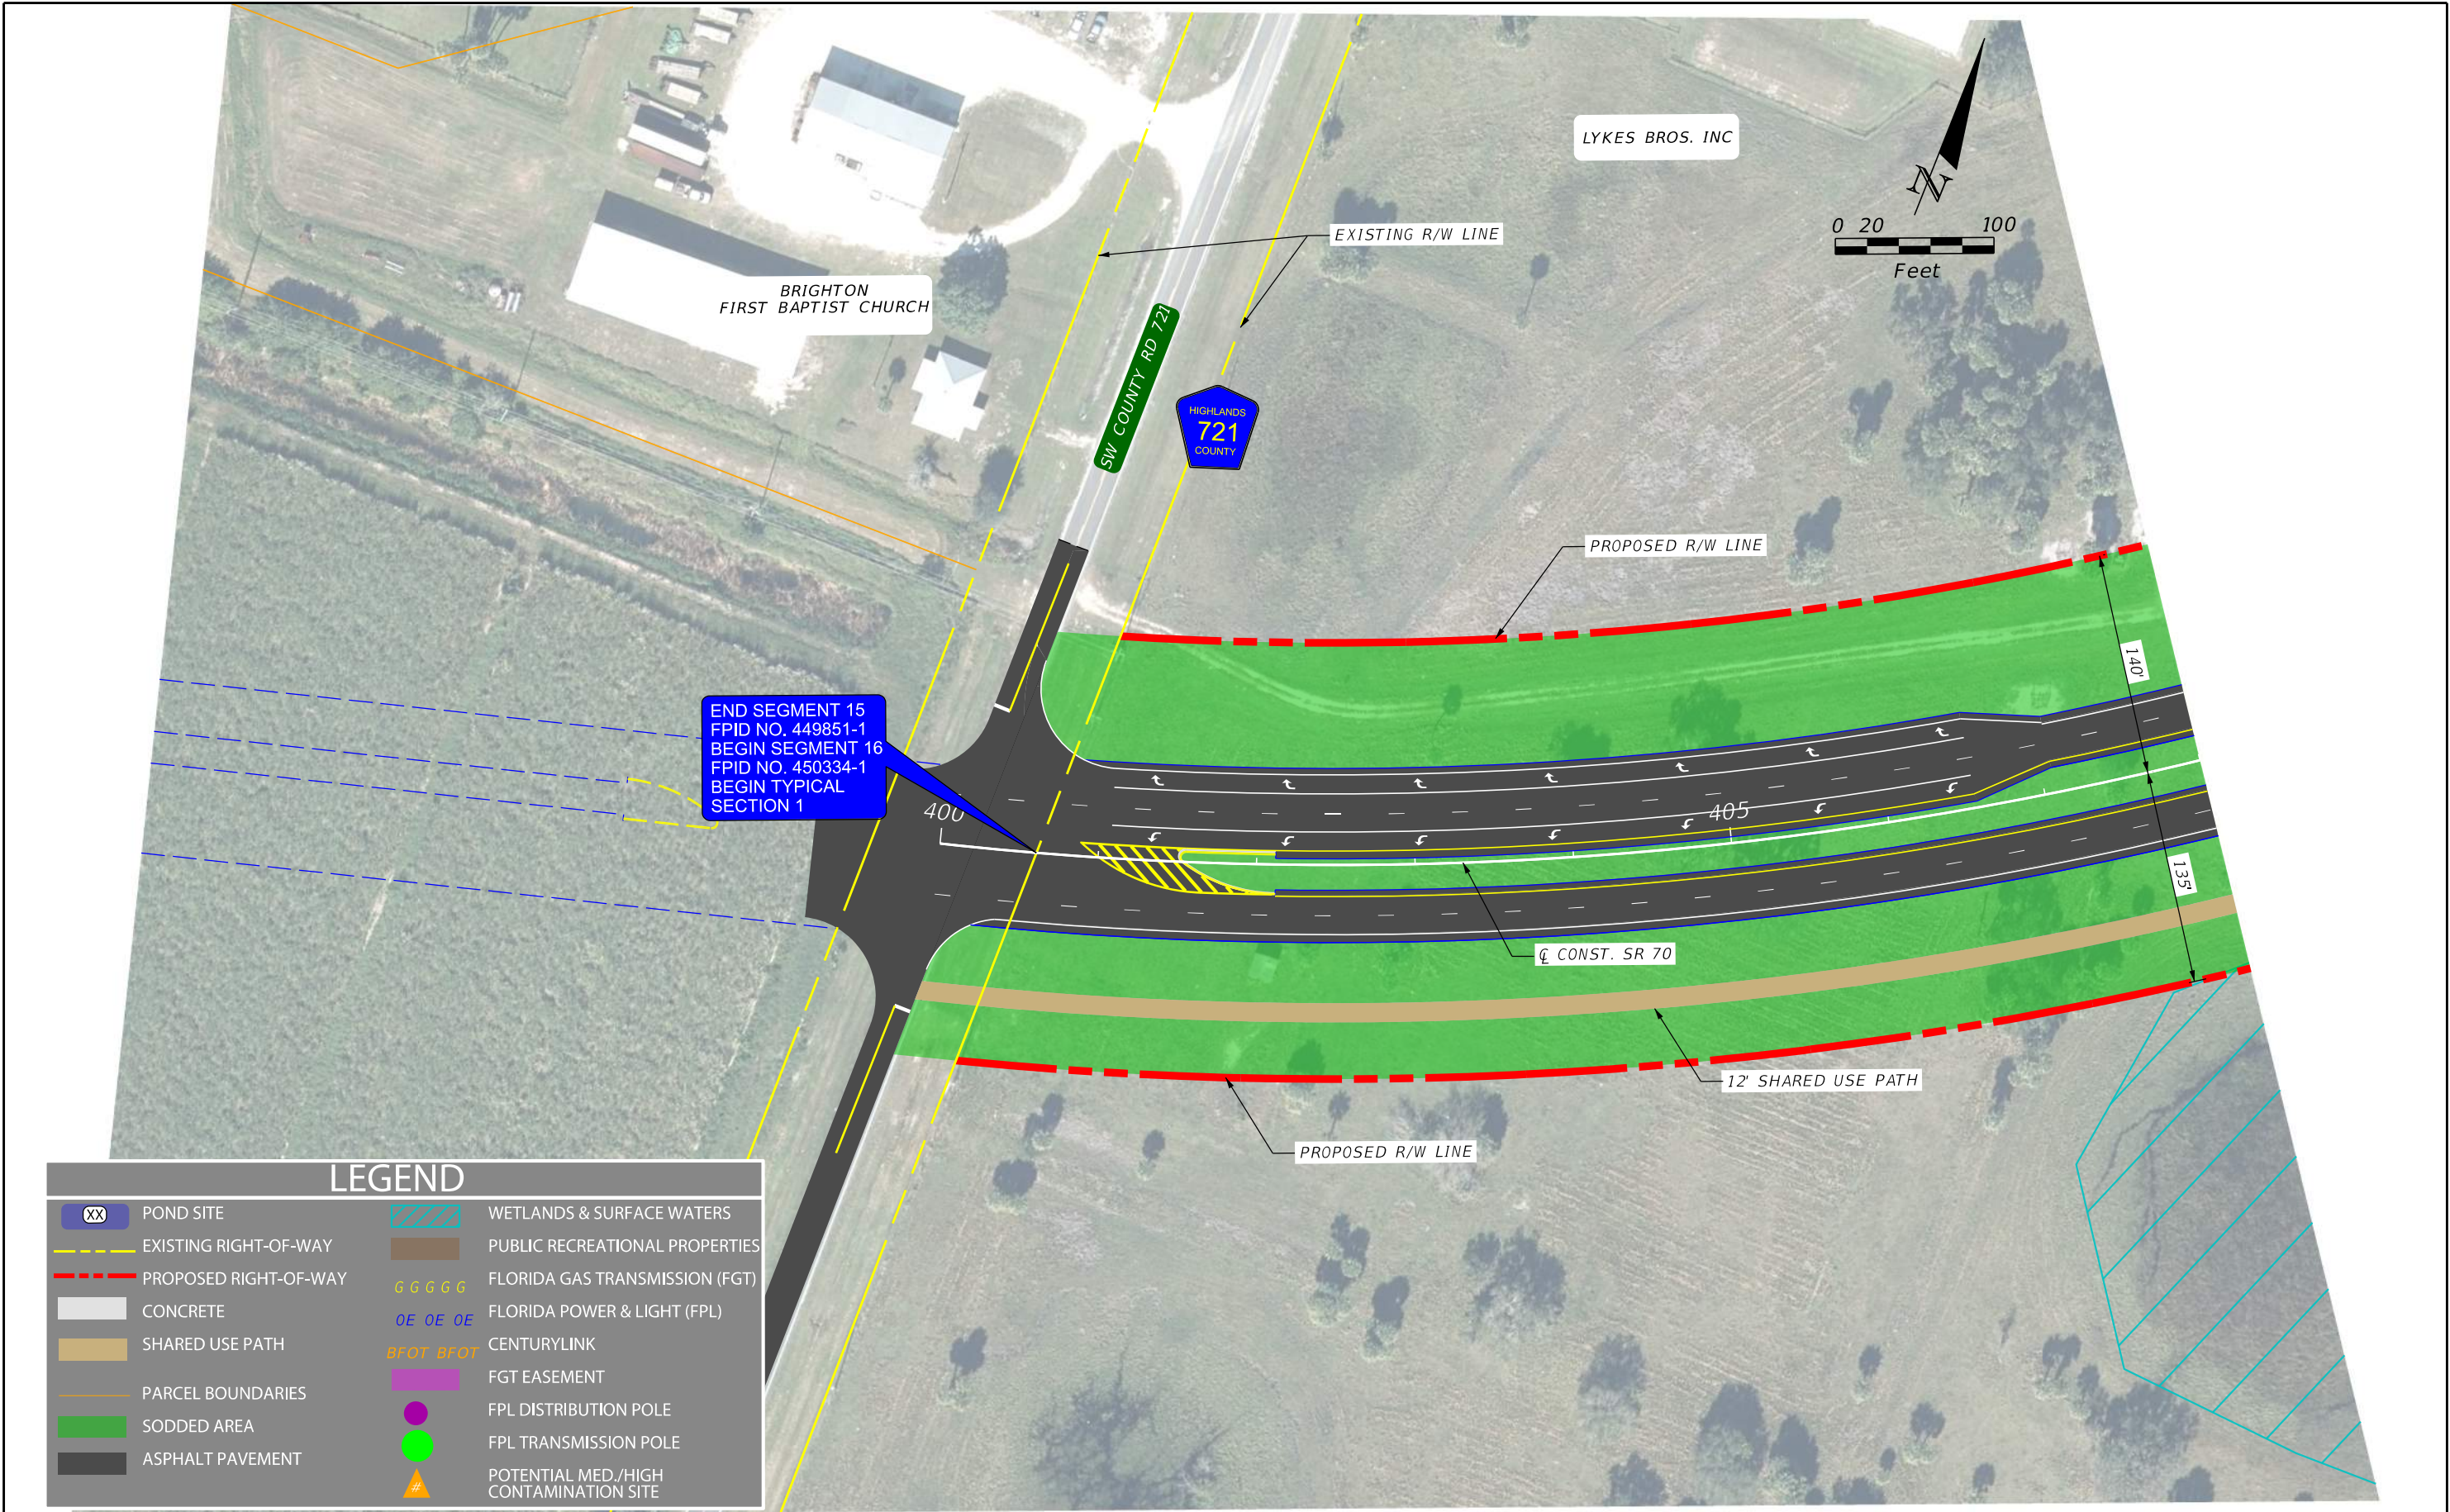


REVISIONS				ENGINEER OF RECORD	STATE OF FLORIDA DEPARTMENT OF TRANSPORTATION			SHEET NO. 1
DATE	DESCRIPTION	DATE	DESCRIPTION		ROAD NO.	COUNTY	FINANCIAL PROJECT ID	
					SR 70	HIGHLANDS OKEECHOBEE	450334-1-22-01	

NICHOLAS JOHN CLAVELO P.E.
LICENSE NUMBER: 84366
SCALAR CONSULTING GROUP, LLC.
5713 CORPORATE WAY, SUITE 200
WEST PALM BEACH, FLORIDA 33407

ALTERNATIVE 1
CONCEPT PLAN

THE OFFICIAL RECORD OF THIS SHEET IS THE ELECTRONIC FILE DIGITALLY SIGNED AND SEALED UNDER RULE 61G15-23.004, F.A.C.

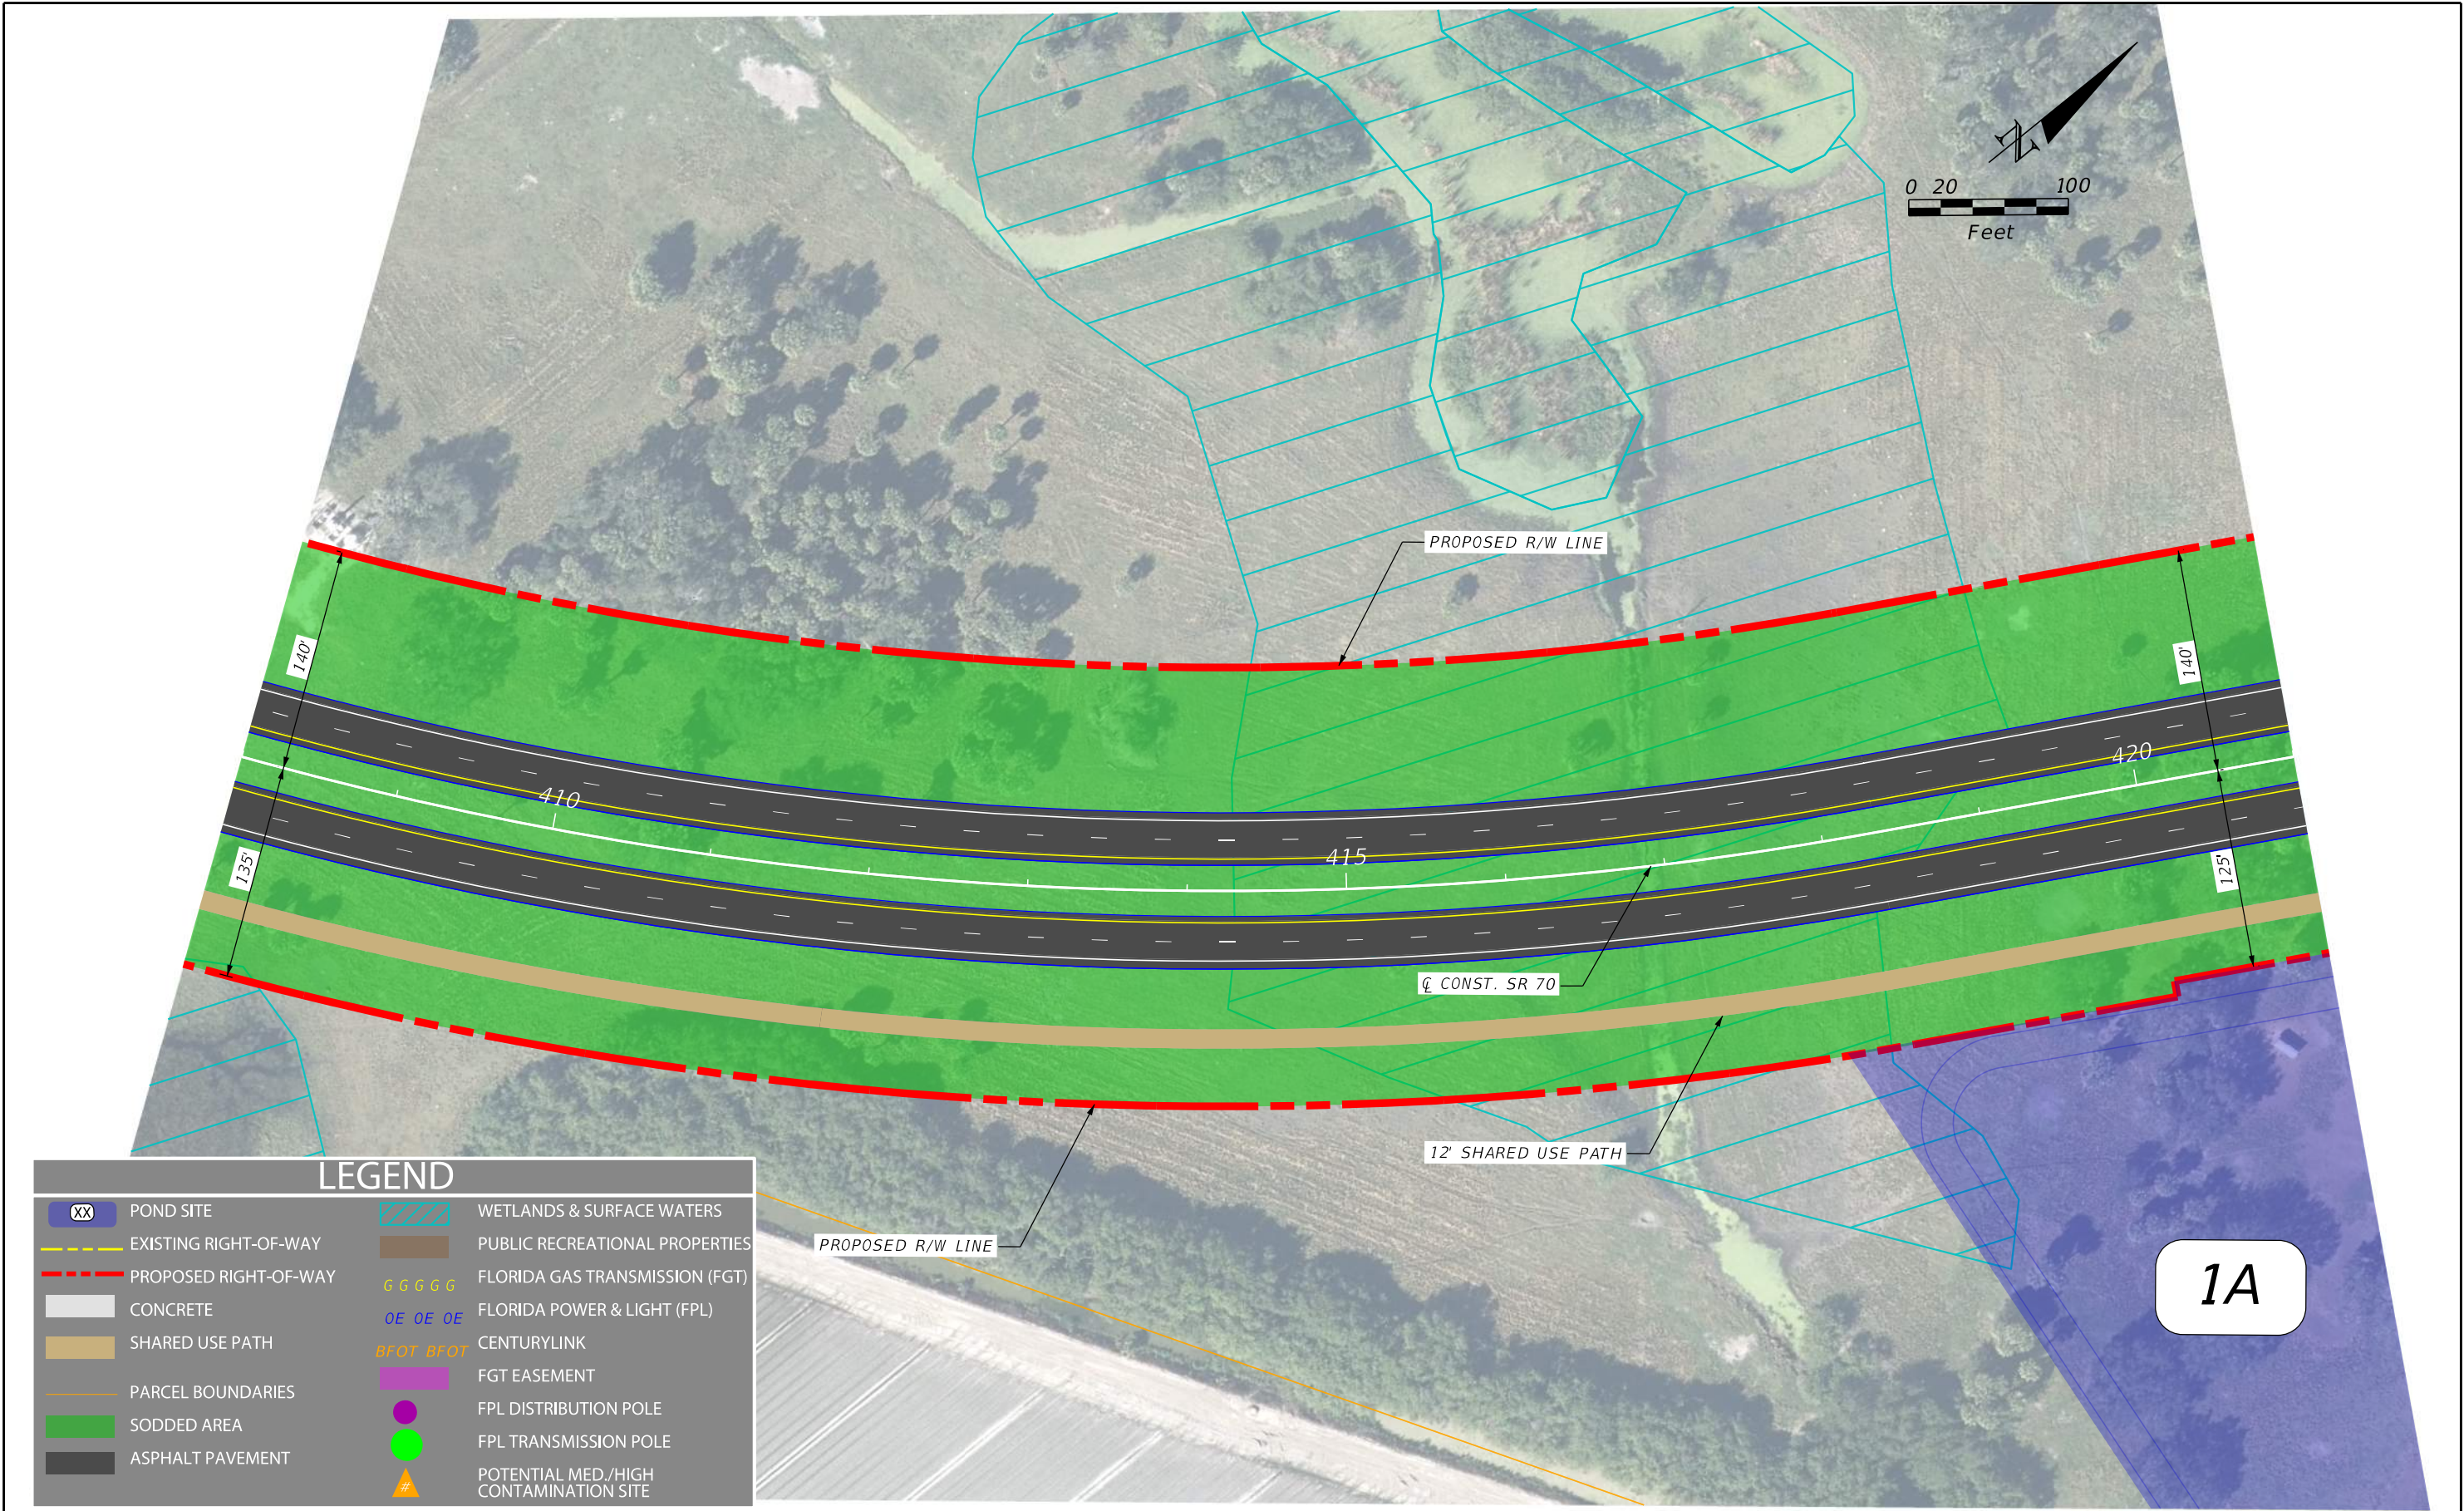


REVISIONS				ENGINEER OF RECORD	STATE OF FLORIDA DEPARTMENT OF TRANSPORTATION			SHEET NO.
DATE	DESCRIPTION	DATE	DESCRIPTION		ROAD NO.	COUNTY	FINANCIAL PROJECT ID	
					SR 70	HIGHLANDS OKEECHOBEE	450334-1-22-01	

NICHOLAS JOHN CLAVELO P.E.
LICENSE NUMBER: 84366
SCALAR CONSULTING GROUP, LLC.
5713 CORPORATE WAY, SUITE 200
WEST PALM BEACH, FLORIDA 33407

ALTERNATIVE 1
CONCEPT PLAN

2

THE OFFICIAL RECORD OF THIS SHEET IS THE ELECTRONIC FILE DIGITALLY SIGNED AND SEALED UNDER RULE 61G15-23.004, F.A.C.

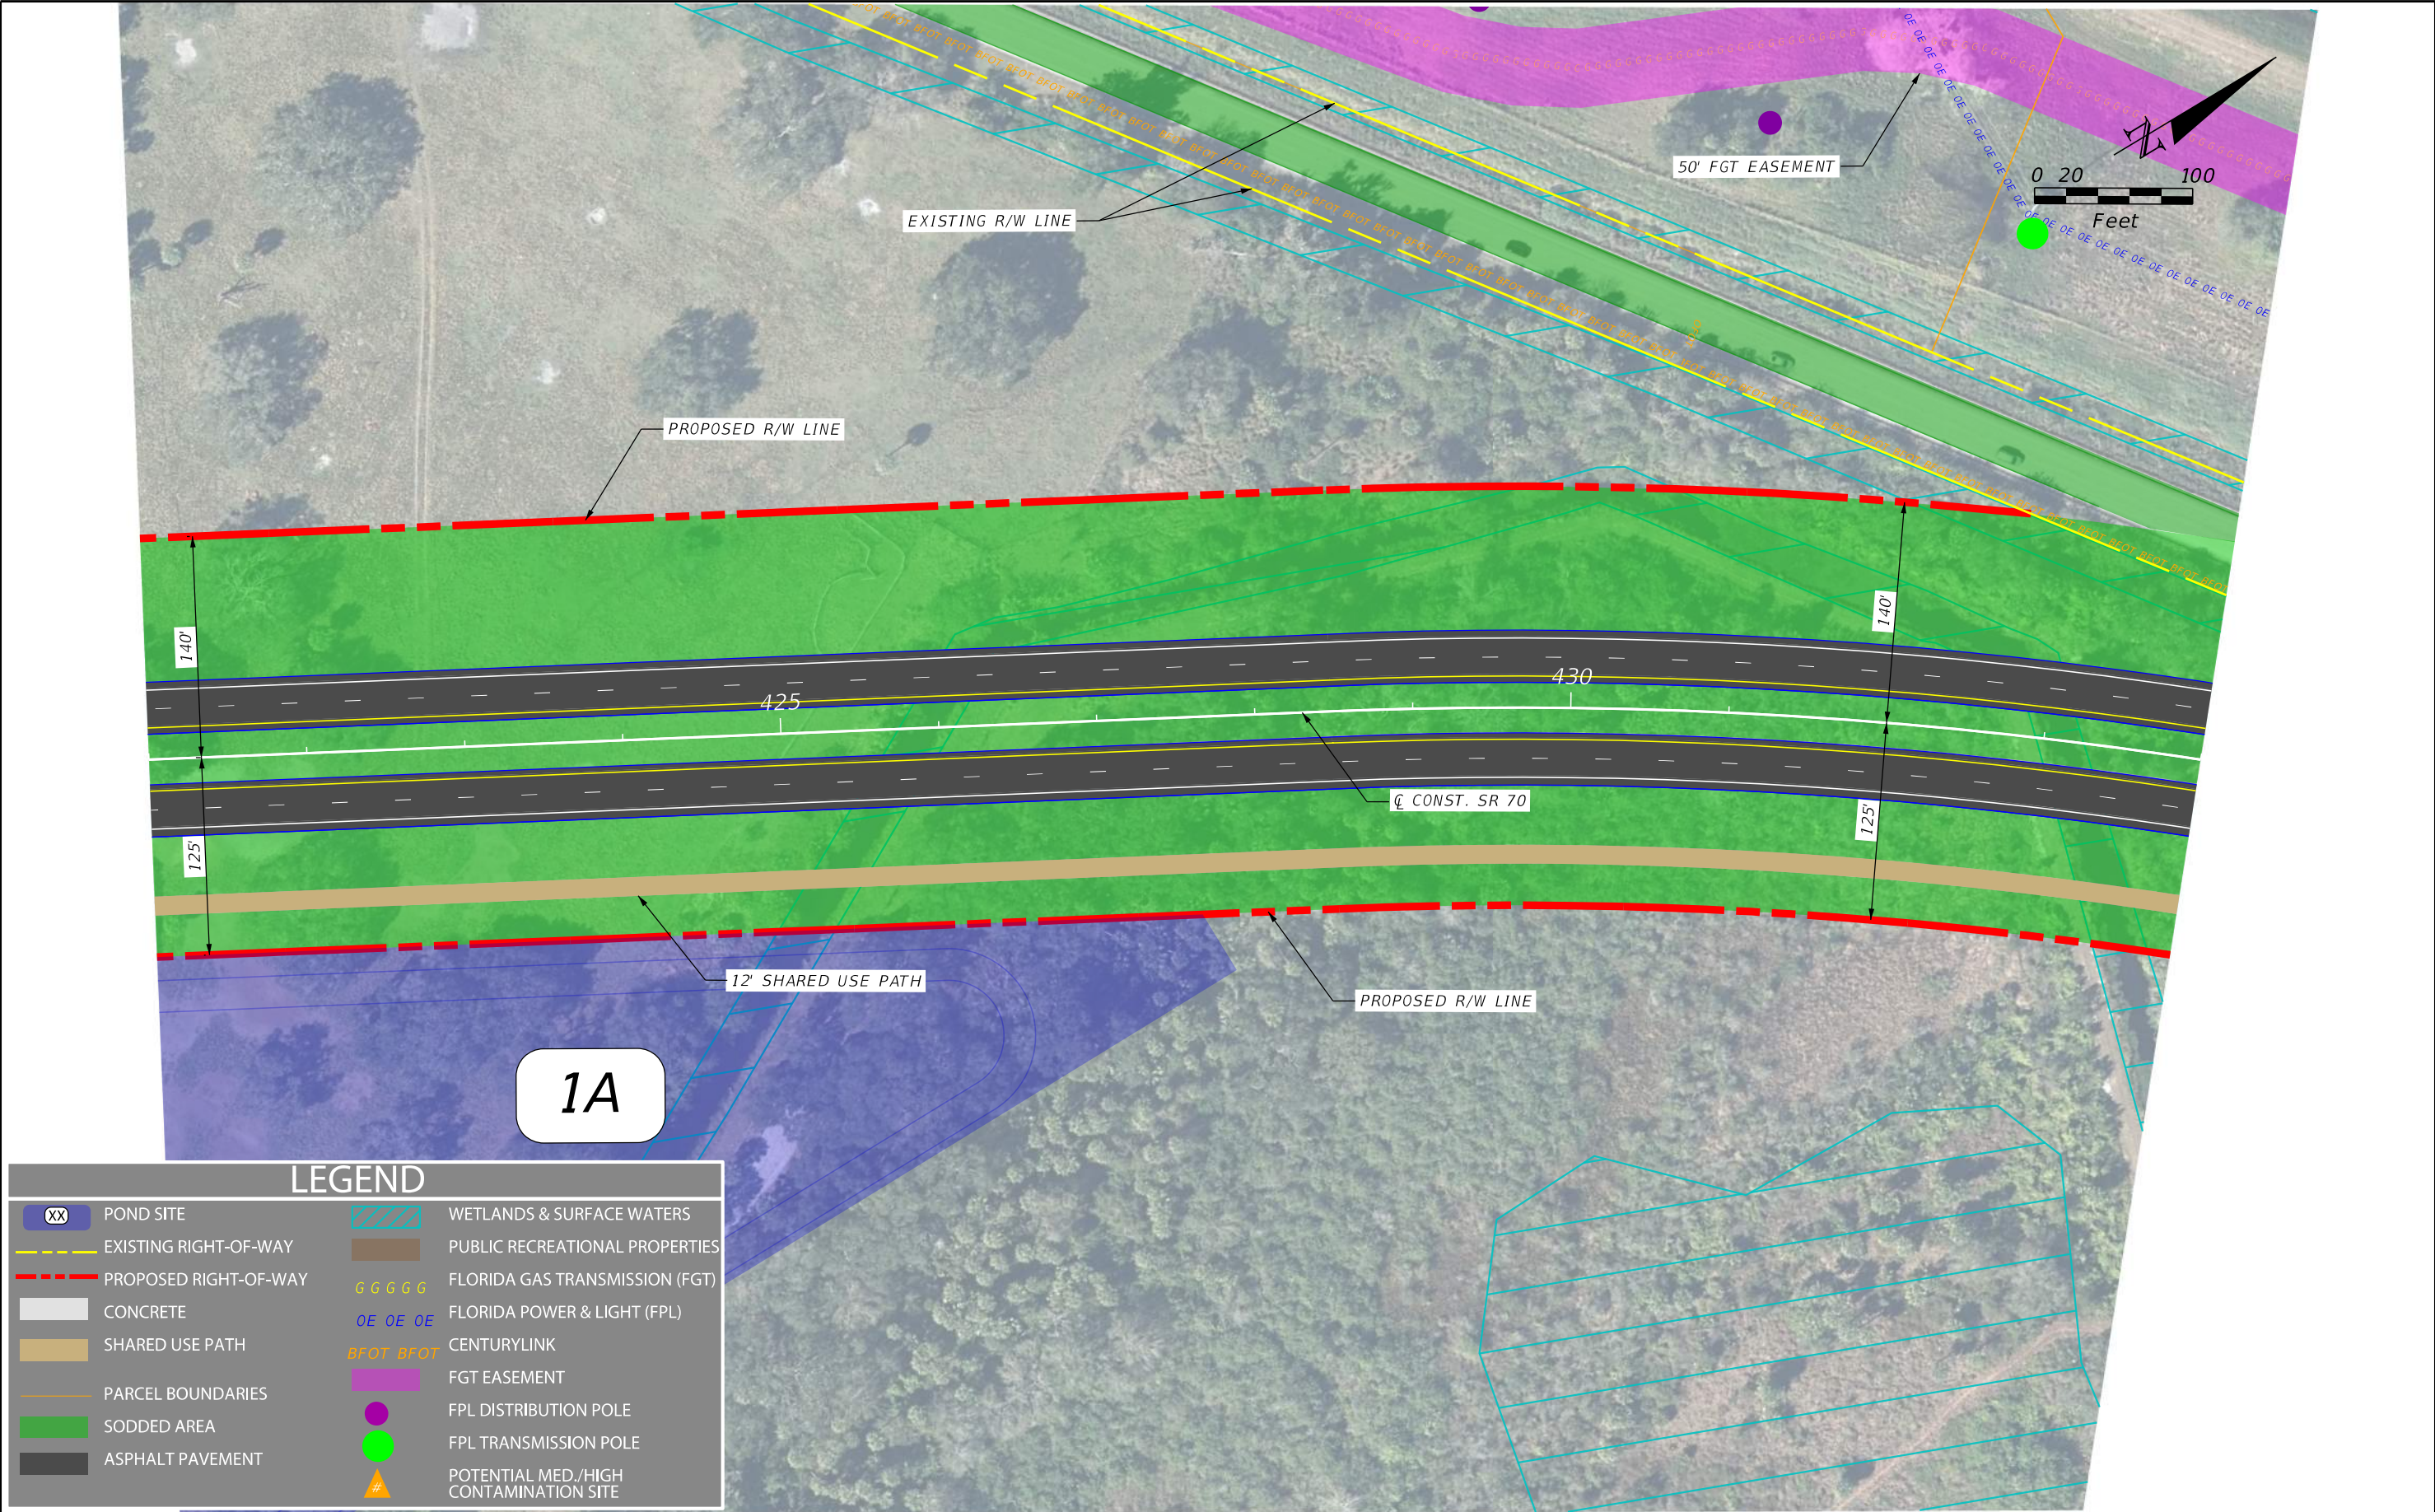

XX

POND SITE

EXISTING RIGHT-OF-WAY

PROPOSED RIGHT-OF-WAY

CONCRETE

SHARED USE PATH

PARCEL BOUNDARIES

SODDED AREA

ASPHALT PAVEMENT

WETLANDS & SURFACE WATERS

PUBLIC RECREATIONAL PROPERTIES

FLORIDA GAS TRANSMISSION (FGT)

FLORIDA POWER & LIGHT (FPL)

CENTURYLINK

FGT EASEMENT

FPL DISTRIBUTION POLE

FPL TRANSMISSION POLE

POTENTIAL MED./HIGH CONTAMINATION SITE

REVISIONS				ENGINEER OF RECORD	STATE OF FLORIDA DEPARTMENT OF TRANSPORTATION			SHEET NO. 3
DATE	DESCRIPTION	DATE	DESCRIPTION		ROAD NO.	COUNTY	FINANCIAL PROJECT ID	
					SR 70	HIGHLANDS OKEECHOBEE	450334-1-22-01	

ALTERNATIVE 1
CONCEPT PLAN

THE OFFICIAL RECORD OF THIS SHEET IS THE ELECTRONIC FILE DIGITALLY SIGNED AND SEALED UNDER RULE 61G15-23.004, F.A.C.



XX

POND SITE

EXISTING RIGHT-OF-WAY

PROPOSED RIGHT-OF-WAY

CONCRETE

SHARED USE PATH

PARCEL BOUNDARIES

SODDED AREA

ASPHALT PAVEMENT

WETLANDS & SURFACE WATERS

PUBLIC RECREATIONAL PROPERTIES

GGGGG

FLORIDA GAS TRANSMISSION (FGT)

OE OE OE

FLORIDA POWER & LIGHT (FPL)

BFOT BFOT

CENTURYLINK

FGT EASEMENT

●

FPL DISTRIBUTION POLE


●

FPL TRANSMISSION POLE

POTENTIAL MED./HIGH CONTAMINATION SITE

REVISIONS				ENGINEER OF RECORD	STATE OF FLORIDA DEPARTMENT OF TRANSPORTATION			ALTERNATIVE 1 CONCEPT PLAN	SHEET NO.
DATE	DESCRIPTION	DATE	DESCRIPTION	NICHOLAS JOHN CLAVELO P.E. LICENSE NUMBER: 84366 SCALAR CONSULTING GROUP, LLC. 5713 CORPORATE WAY, SUITE 200 WEST PALM BEACH, FLORIDA 33407	ROAD NO.	COUNTY	FINANCIAL PROJECT ID		4
					SR 70	HIGHLANDS OKEECHOBEE	450334-1-22-01		

THE OFFICIAL RECORD OF THIS SHEET IS THE ELECTRONIC FILE DIGITALLY SIGNED AND SEALED UNDER RULE 61G15-23.004, F.A.C.

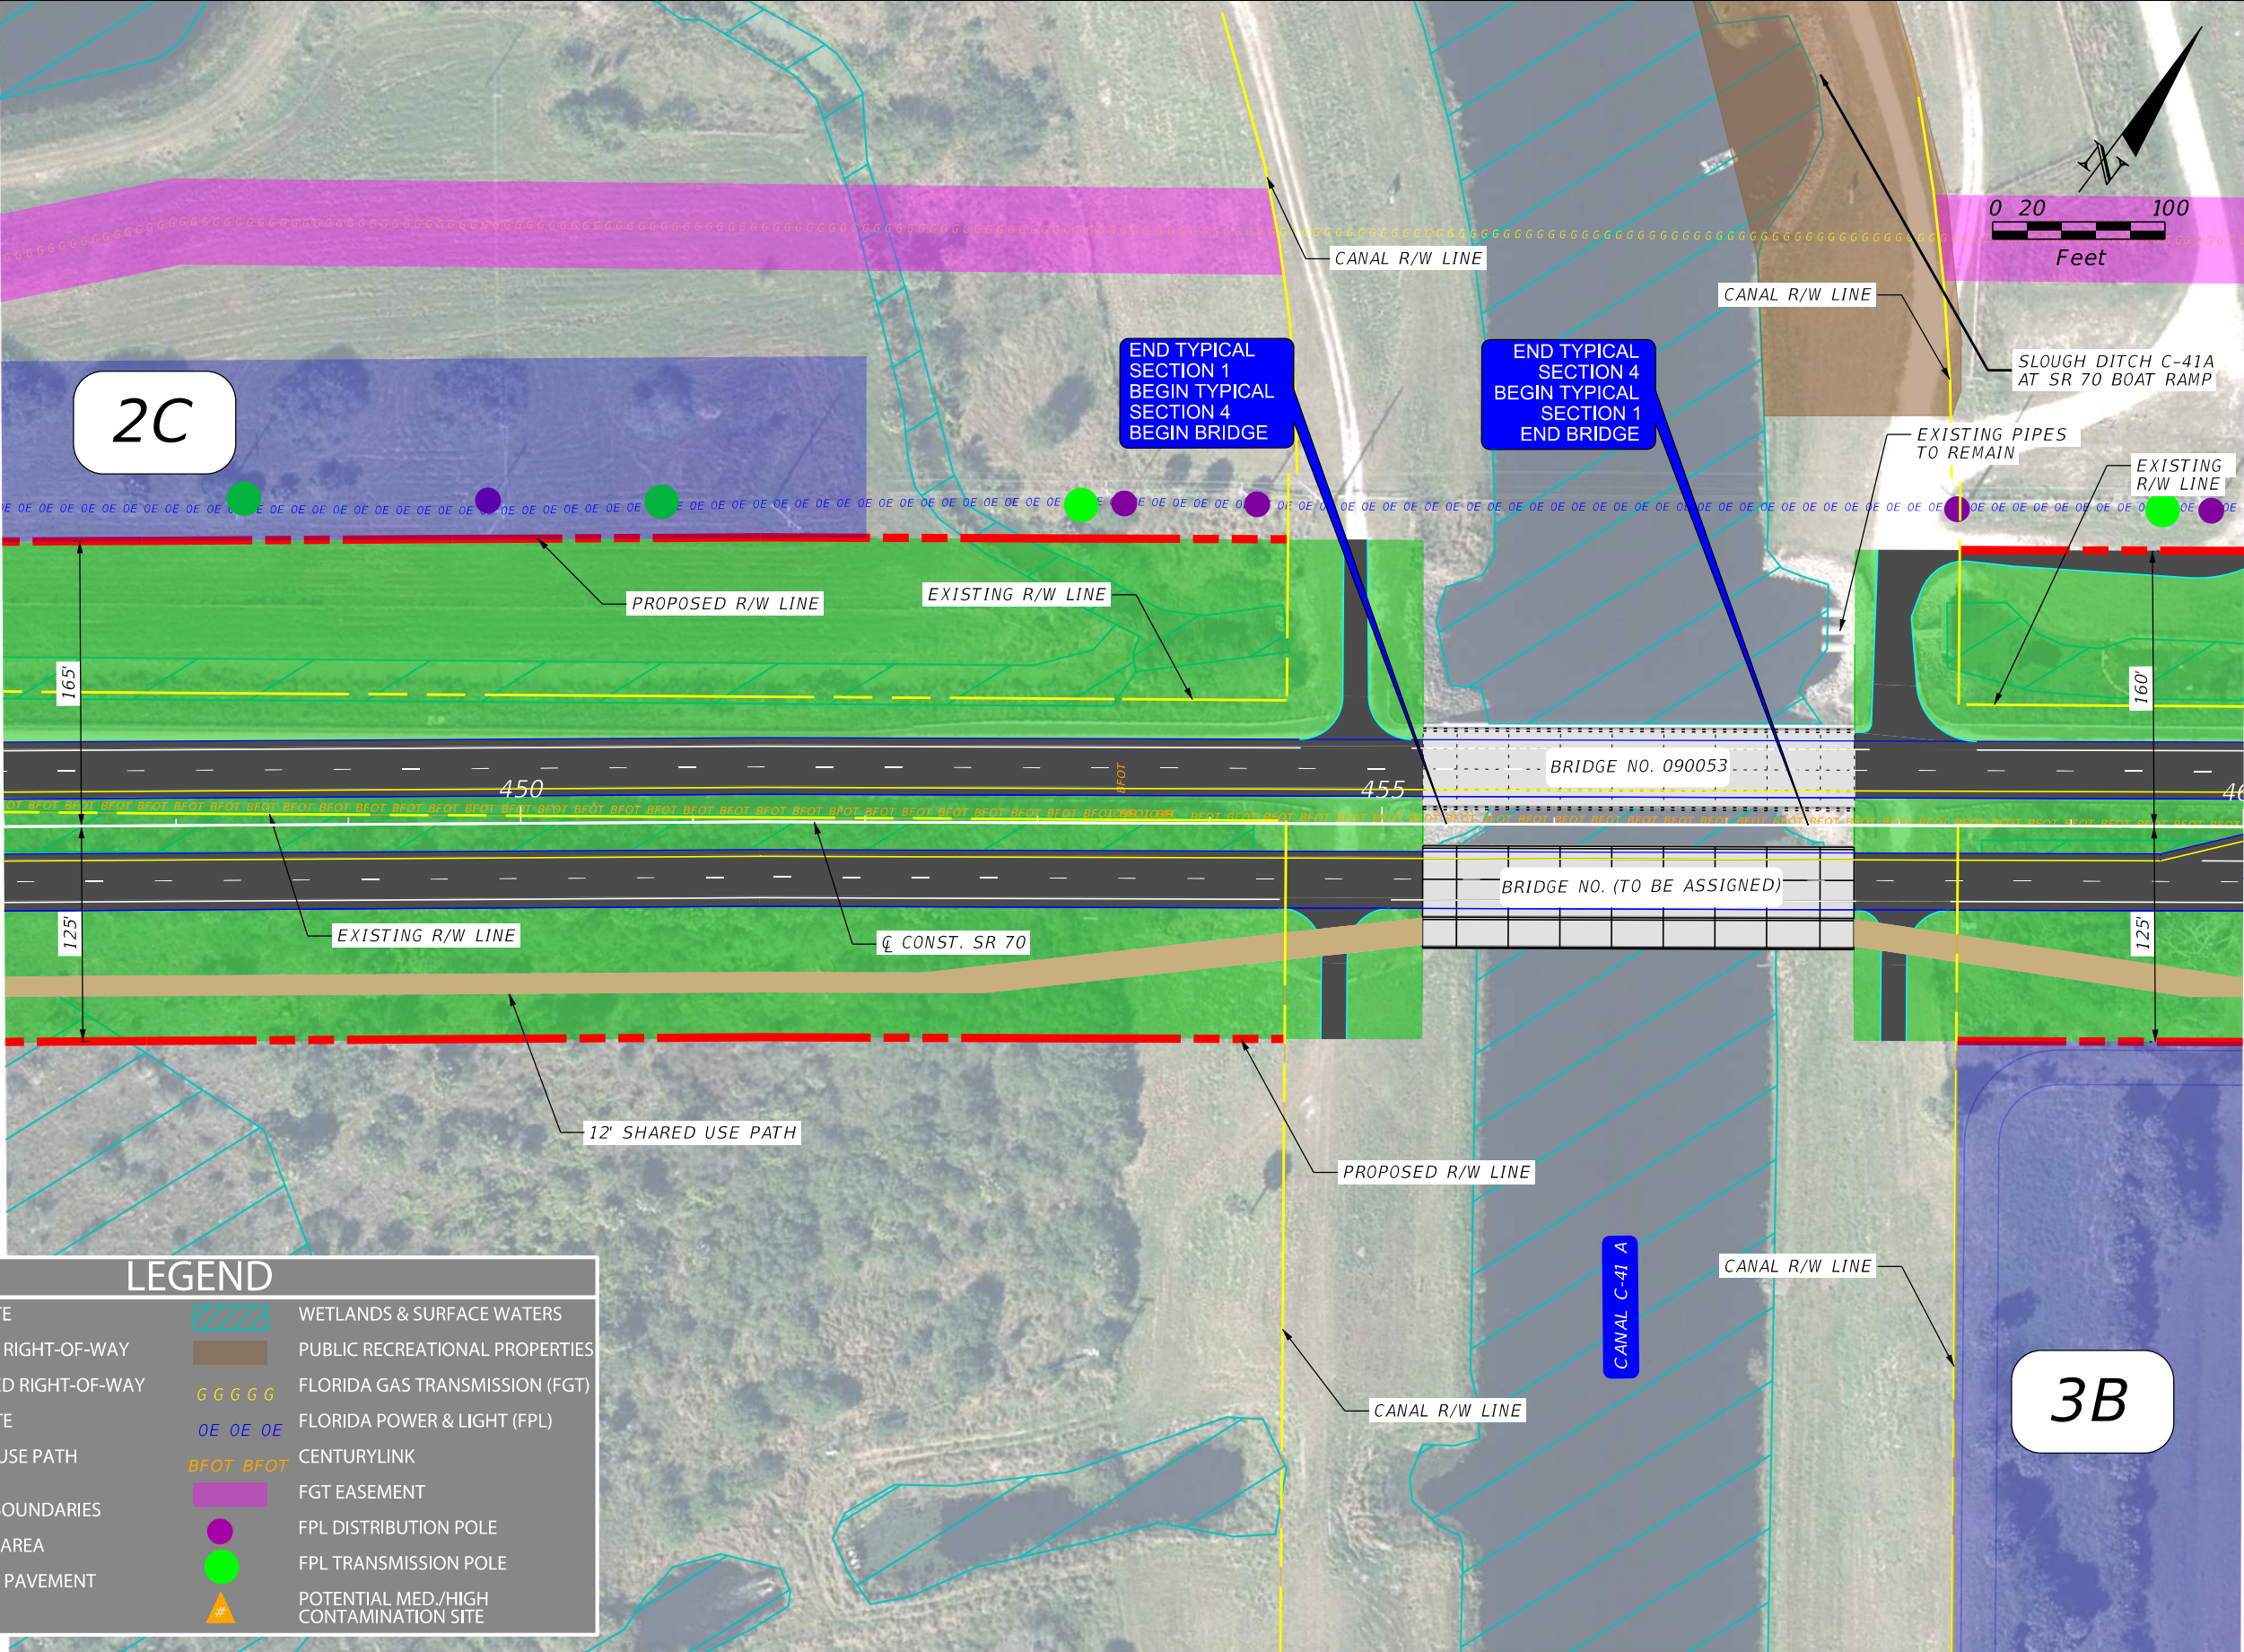

XX

POND SITE

EXISTING RIGHT-OF-WAY

PROPOSED RIGHT-OF-WAY

■

CONCRETE

■

SHARED USE PATH

PARCEL BOUNDARIES

■

SODDED AREA

■

ASPHALT PAVEMENT

WETLANDS & SURFACE WATERS

PUBLIC RECREATIONAL PROPERTIES

FGT

FPL

CENTURYLINK


FGT EASEMENT

FPL DISTRIBUTION POLE

FPL TRANSMISSION POLE

POTENTIAL MED/HIGH CONTAMINATION SITE

REVISIONS				ENGINEER OF RECORD		STATE OF FLORIDA DEPARTMENT OF TRANSPORTATION		ALTERNATIVE 1 CONCEPT PLAN	SHEET NO. 5
DATE	DESCRIPTION	DATE	DESCRIPTION	NICHOLAS JOHN CLAVELLO P.E. LICENSE NUMBER: 84366 SCALAR CONSULTING GROUP, LLC. 5713 CORPORATE WAY, SUITE 200 WEST PALM BEACH, FLORIDA 33407		ROAD NO.	COUNTY		
						SR 70	HIGHLANDS OKEECHOBEE	FINANCIAL PROJECT ID 450334-1-22-01	

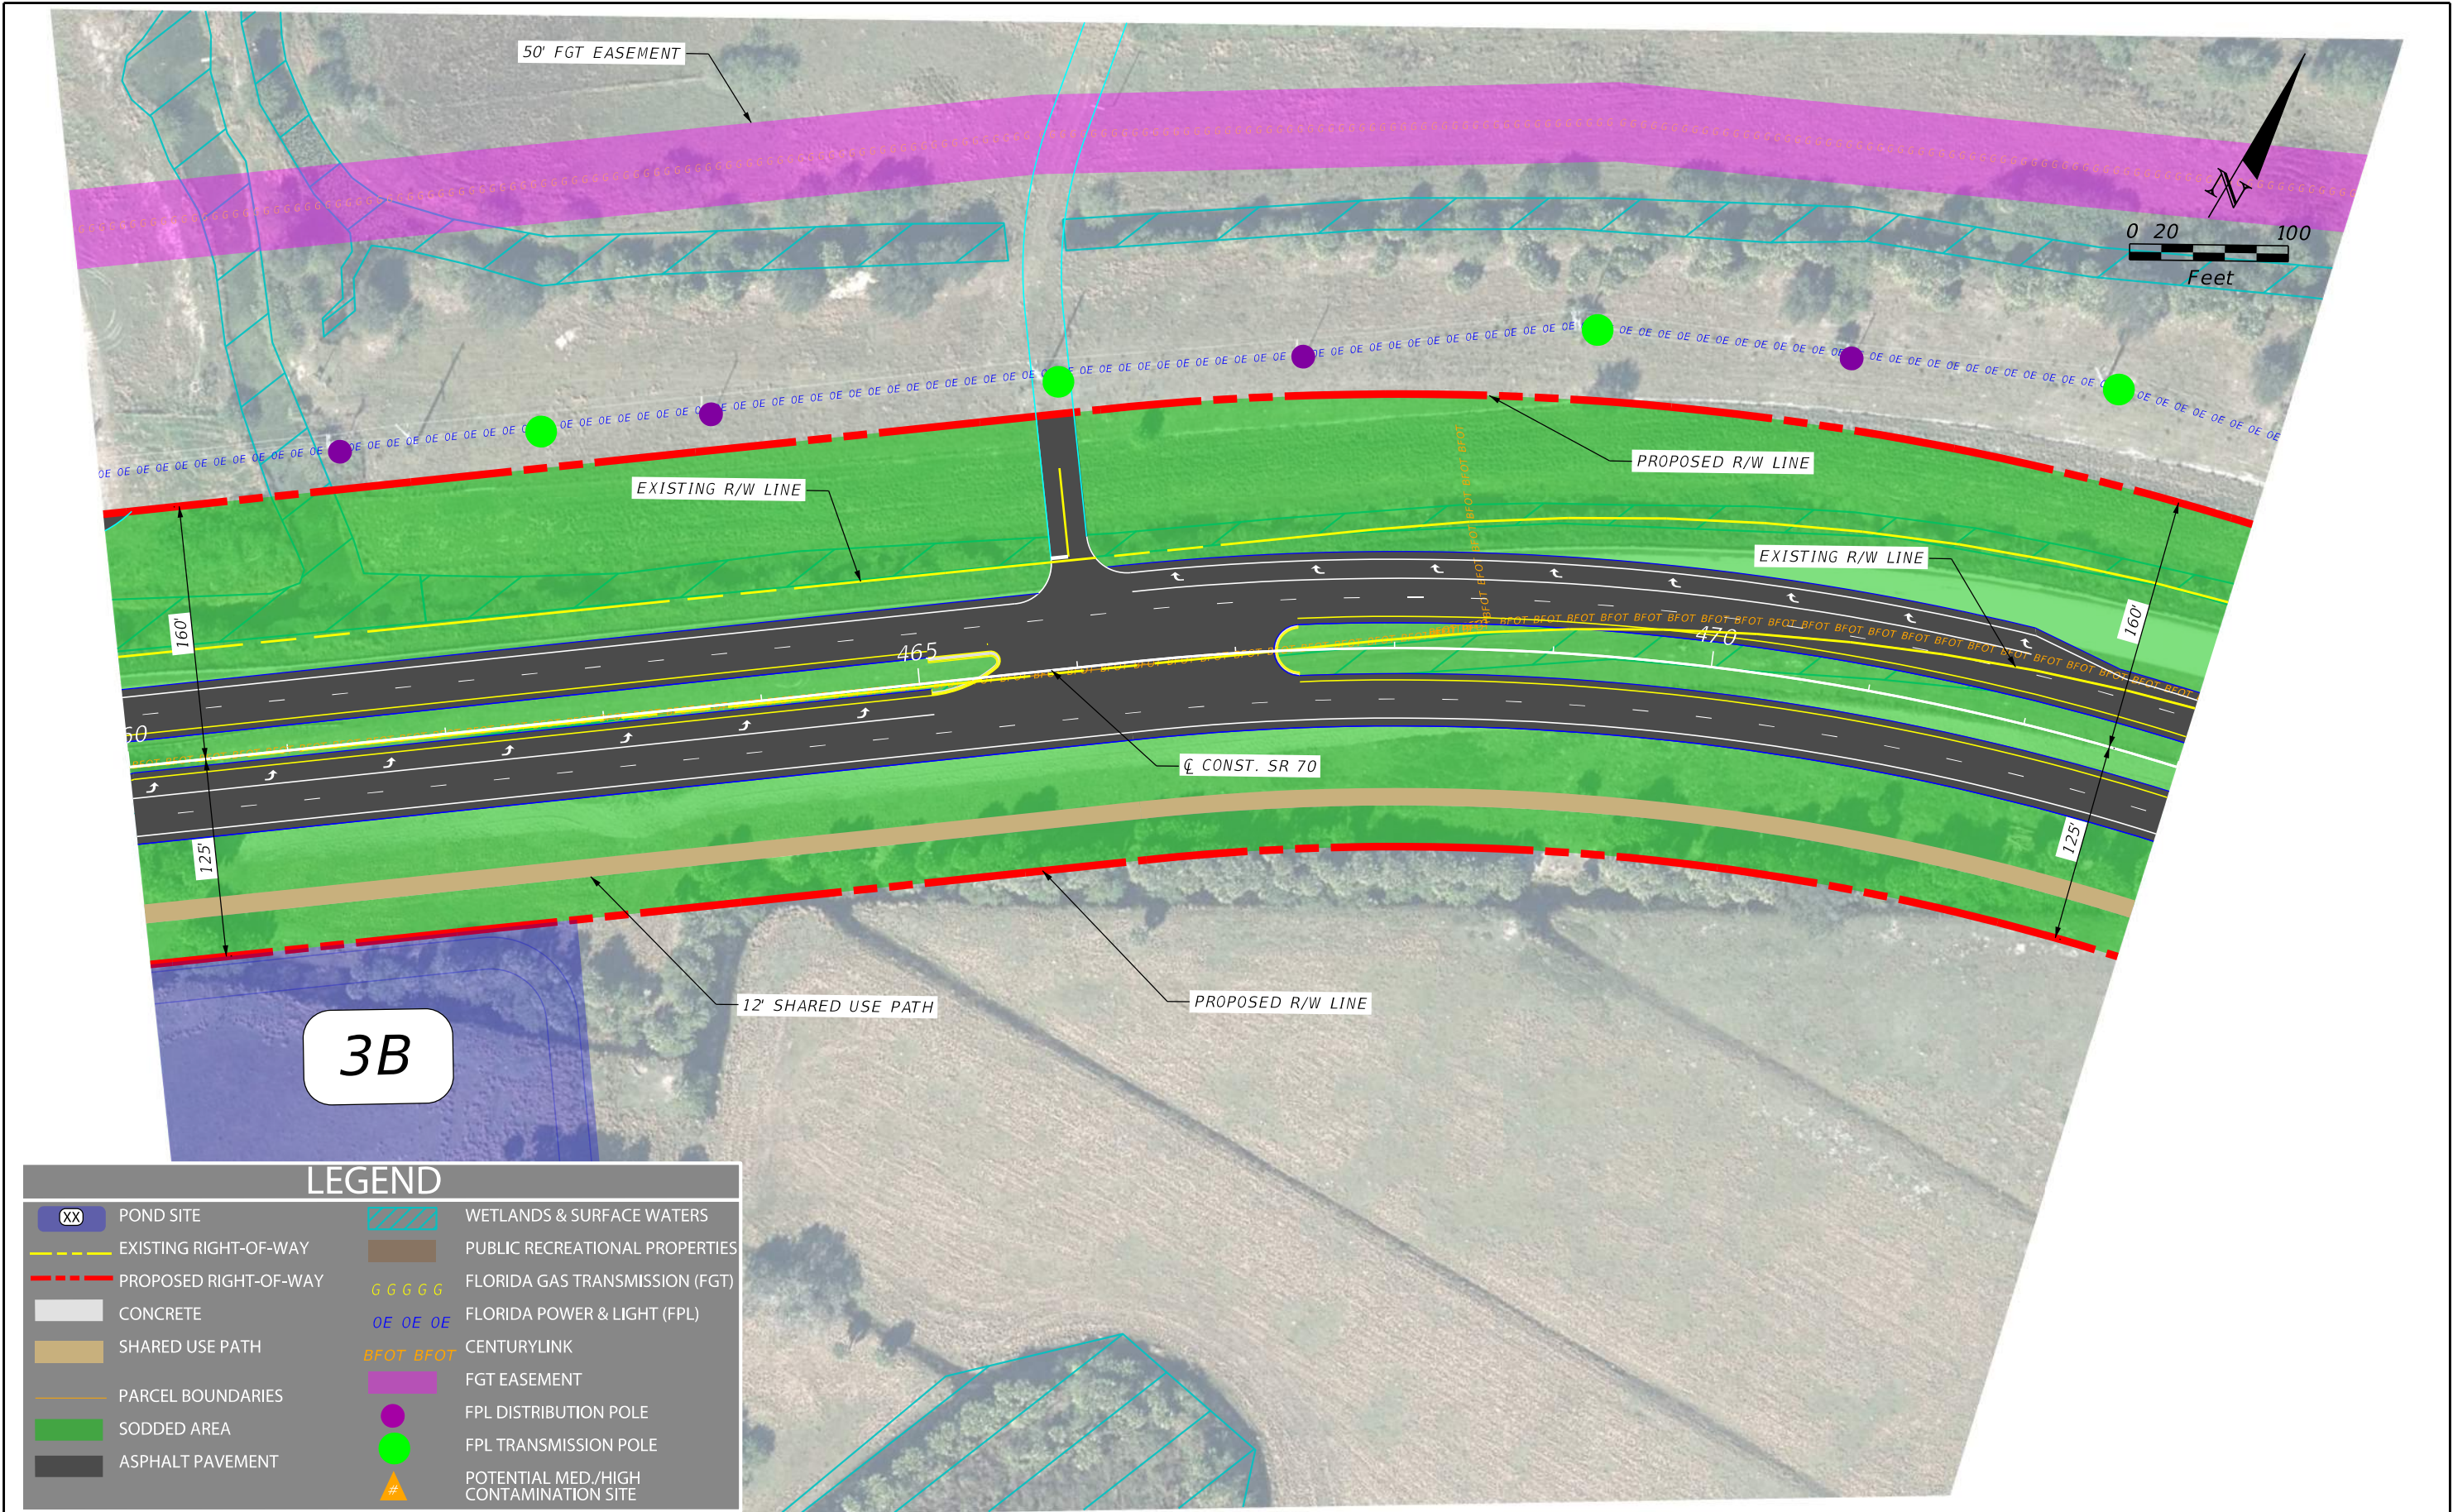

XX

POND SITE

EXISTING RIGHT-OF-WAY

PROPOSED RIGHT-OF-WAY

CONCRETE

SHARED USE PATH

PARCEL BOUNDARIES

SODDED AREA

ASPHALT PAVEMENT

WETLANDS & SURFACE WATERS

PUBLIC RECREATIONAL PROPERTIES

GGGGG

FLORIDA GAS TRANSMISSION (FGT)

OE OE OE

FLORIDA POWER & LIGHT (FPL)

BFOT BFOT

CENTURYLINK

FGT EASEMENT

●

FPL DISTRIBUTION POLE

●


FPL TRANSMISSION POLE

▲







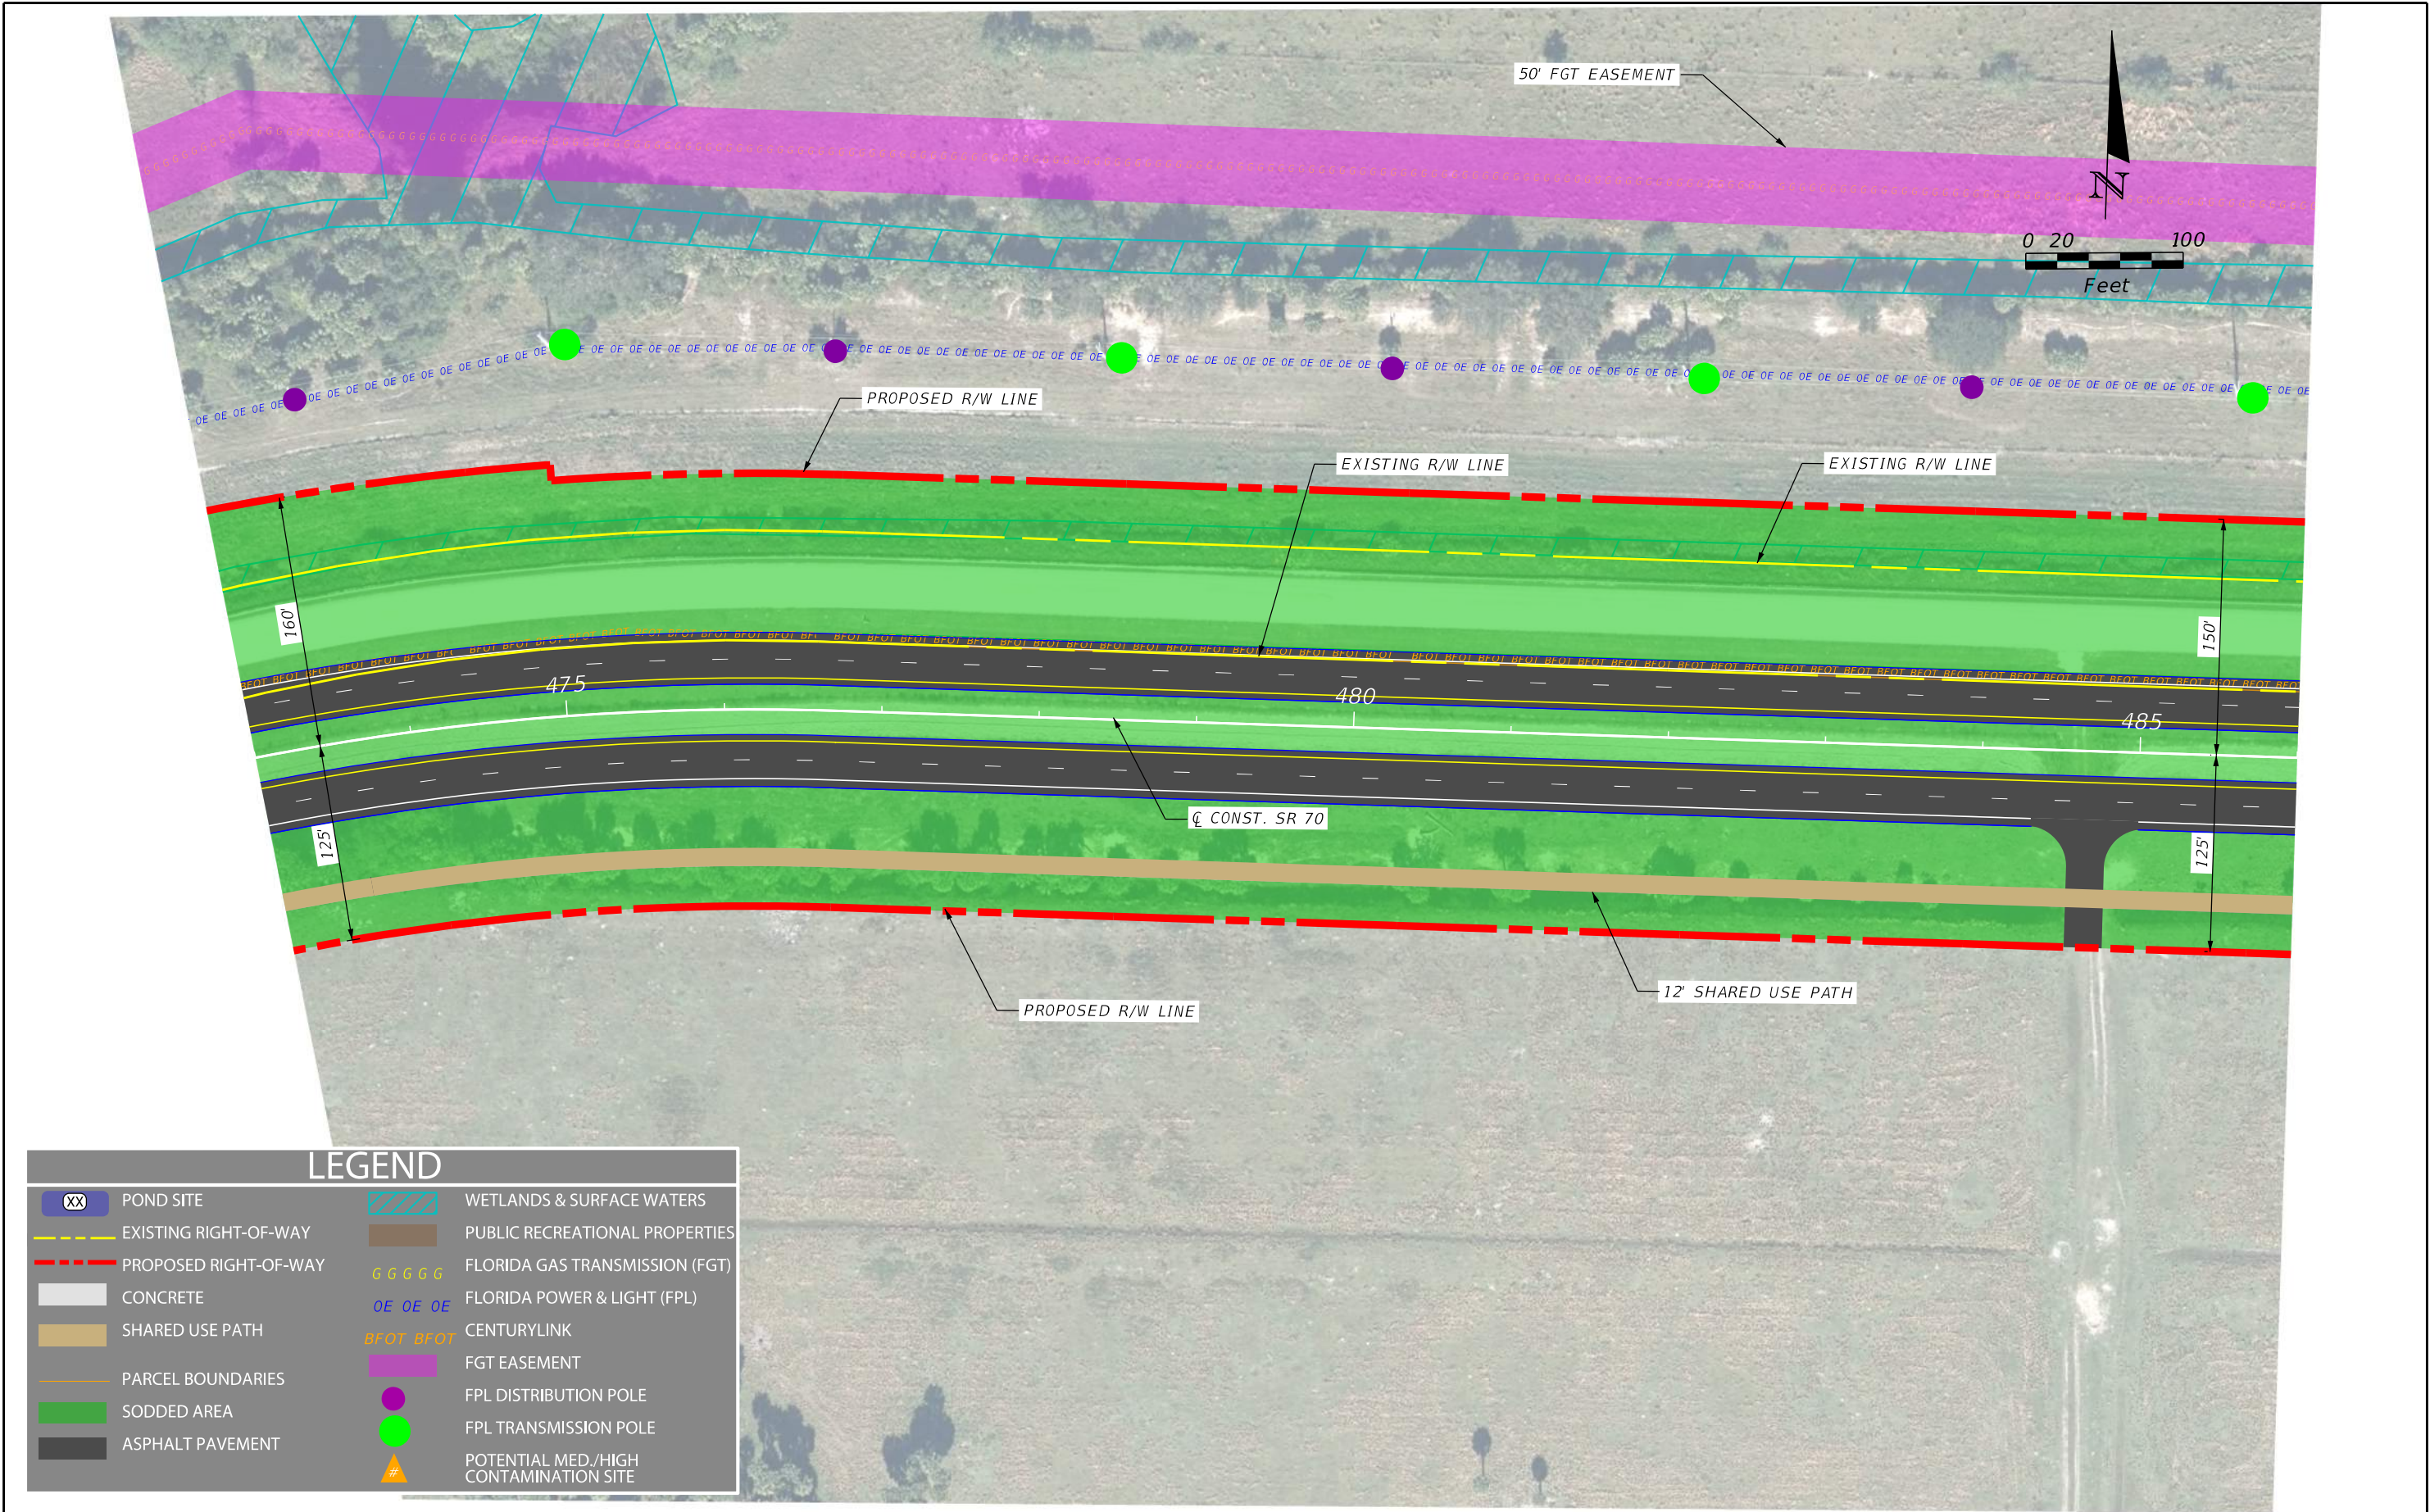










POTENTIAL MED/HIGH CONTAMINATION SITE

REVISIONS				ENGINEER OF RECORD		STATE OF FLORIDA DEPARTMENT OF TRANSPORTATION		ALTERNATIVE 1 CONCEPT PLAN	SHEET NO. 6
DATE	DESCRIPTION	DATE	DESCRIPTION	NICHOLAS JOHN CLAVELLO P.E. LICENSE NUMBER: 84366 SCALAR CONSULTING GROUP, LLC. 5713 CORPORATE WAY, SUITE 200 WEST PALM BEACH, FLORIDA 33407		ROAD NO.	COUNTY		
						SR 70	HIGHLANDS OKEECHOBEE	FINANCIAL PROJECT ID 450334-1-22-01	


THE OFFICIAL RECORD OF THIS SHEET IS THE ELECTRONIC FILE DIGITALLY SIGNED AND SEALED UNDER RULE 61G15-23.004, F.A.C.



LEGEND

	POND SITE		WETLANDS & SURFACE WATERS
	EXISTING RIGHT-OF-WAY		PUBLIC RECREATIONAL PROPERTIES
	PROPOSED RIGHT-OF-WAY		FLORIDA GAS TRANSMISSION (FGT)
	CONCRETE		FLORIDA POWER & LIGHT (FPL)
	SHARED USE PATH		CENTURYLINK
	PARCEL BOUNDARIES		FGT EASEMENT
	SODDED AREA		FPL DISTRIBUTION POLE
	ASPHALT PAVEMENT		FPL TRANSMISSION POLE
			POTENTIAL MED./HIGH CONTAMINATION SITE

REVISIONS				ENGINEER OF RECORD			STATE OF FLORIDA DEPARTMENT OF TRANSPORTATION			ALTERNATIVE 1 CONCEPT PLAN	SHEET NO. 7
DATE	DESCRIPTION	DATE	DESCRIPTION	NICHOLAS JOHN CLAVELO P.E. LICENSE NUMBER: 84366 SCALAR CONSULTING GROUP, LLC. 5713 CORPORATE WAY, SUITE 200 WEST PALM BEACH, FLORIDA 33407			ROAD NO.	COUNTY	FINANCIAL PROJECT ID		
							SR 70	HIGHLANDS OKEECHOBEE	450334-1-22-01		

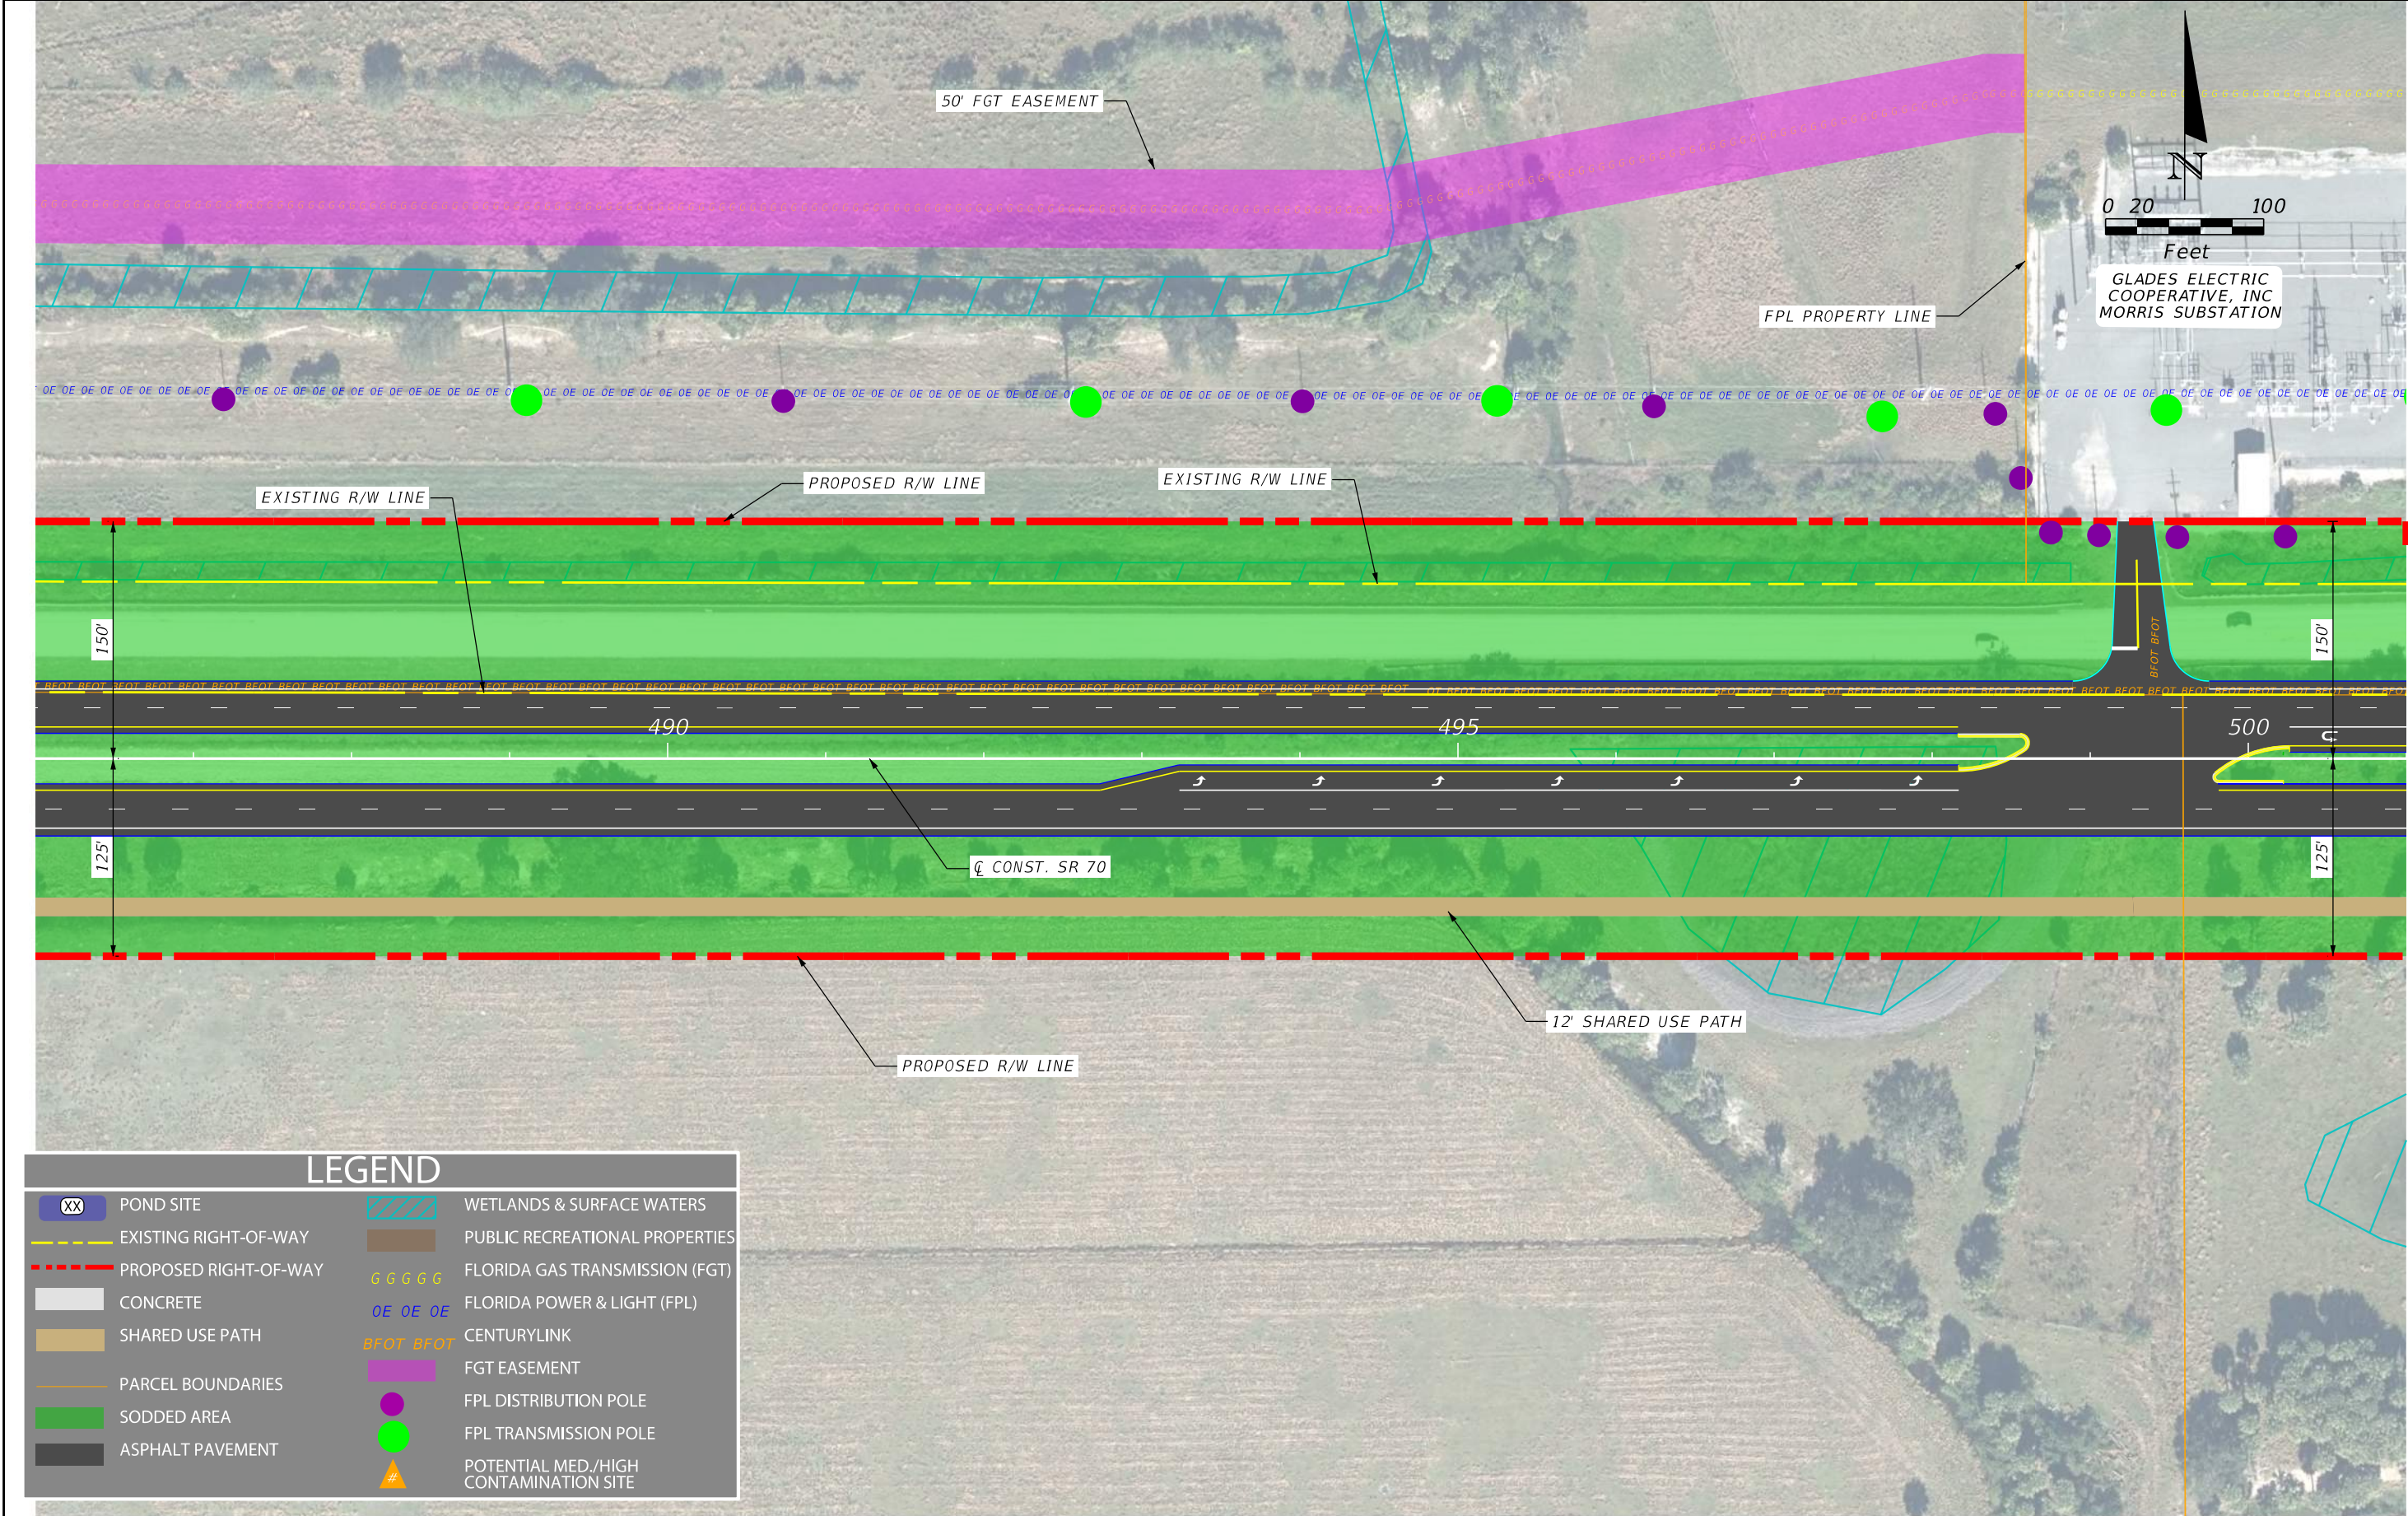

XX

POND SITE

EXISTING RIGHT-OF-WAY

PROPOSED RIGHT-OF-WAY

CONCRETE

SHARED USE PATH

PARCEL BOUNDARIES

SODDED AREA

ASPHALT PAVEMENT

WETLANDS & SURFACE WATERS

PUBLIC RECREATIONAL PROPERTIES

GGGGG

FLORIDA GAS TRANSMISSION (FGT)

OE OE OE

FLORIDA POWER & LIGHT (FPL)

BFOT BFOT

CENTURYLINK

FGT EASEMENT

●

FPL DISTRIBUTION POLE

●



FPL TRANSMISSION POLE

#

POTENTIAL MED./HIGH CONTAMINATION SITE

REVISIONS				ENGINEER OF RECORD	STATE OF FLORIDA DEPARTMENT OF TRANSPORTATION			ALTERNATIVE 1 CONCEPT PLAN	SHEET NO.
DATE	DESCRIPTION	DATE	DESCRIPTION	NICHOLAS JOHN CLAVELO P.E. LICENSE NUMBER: 84366 SCALAR CONSULTING GROUP, LLC. 5713 CORPORATE WAY, SUITE 200 WEST PALM BEACH, FLORIDA 33407	ROAD NO.	COUNTY	FINANCIAL PROJECT ID		8
					SR 70	HIGHLANDS OKEECHOBEE	450334-1-22-01		

THE OFFICIAL RECORD OF THIS SHEET IS THE ELECTRONIC FILE DIGITALLY SIGNED AND SEALED UNDER RULE 61G15-23.004, F.A.C.

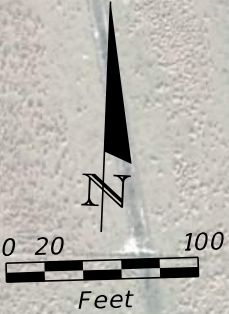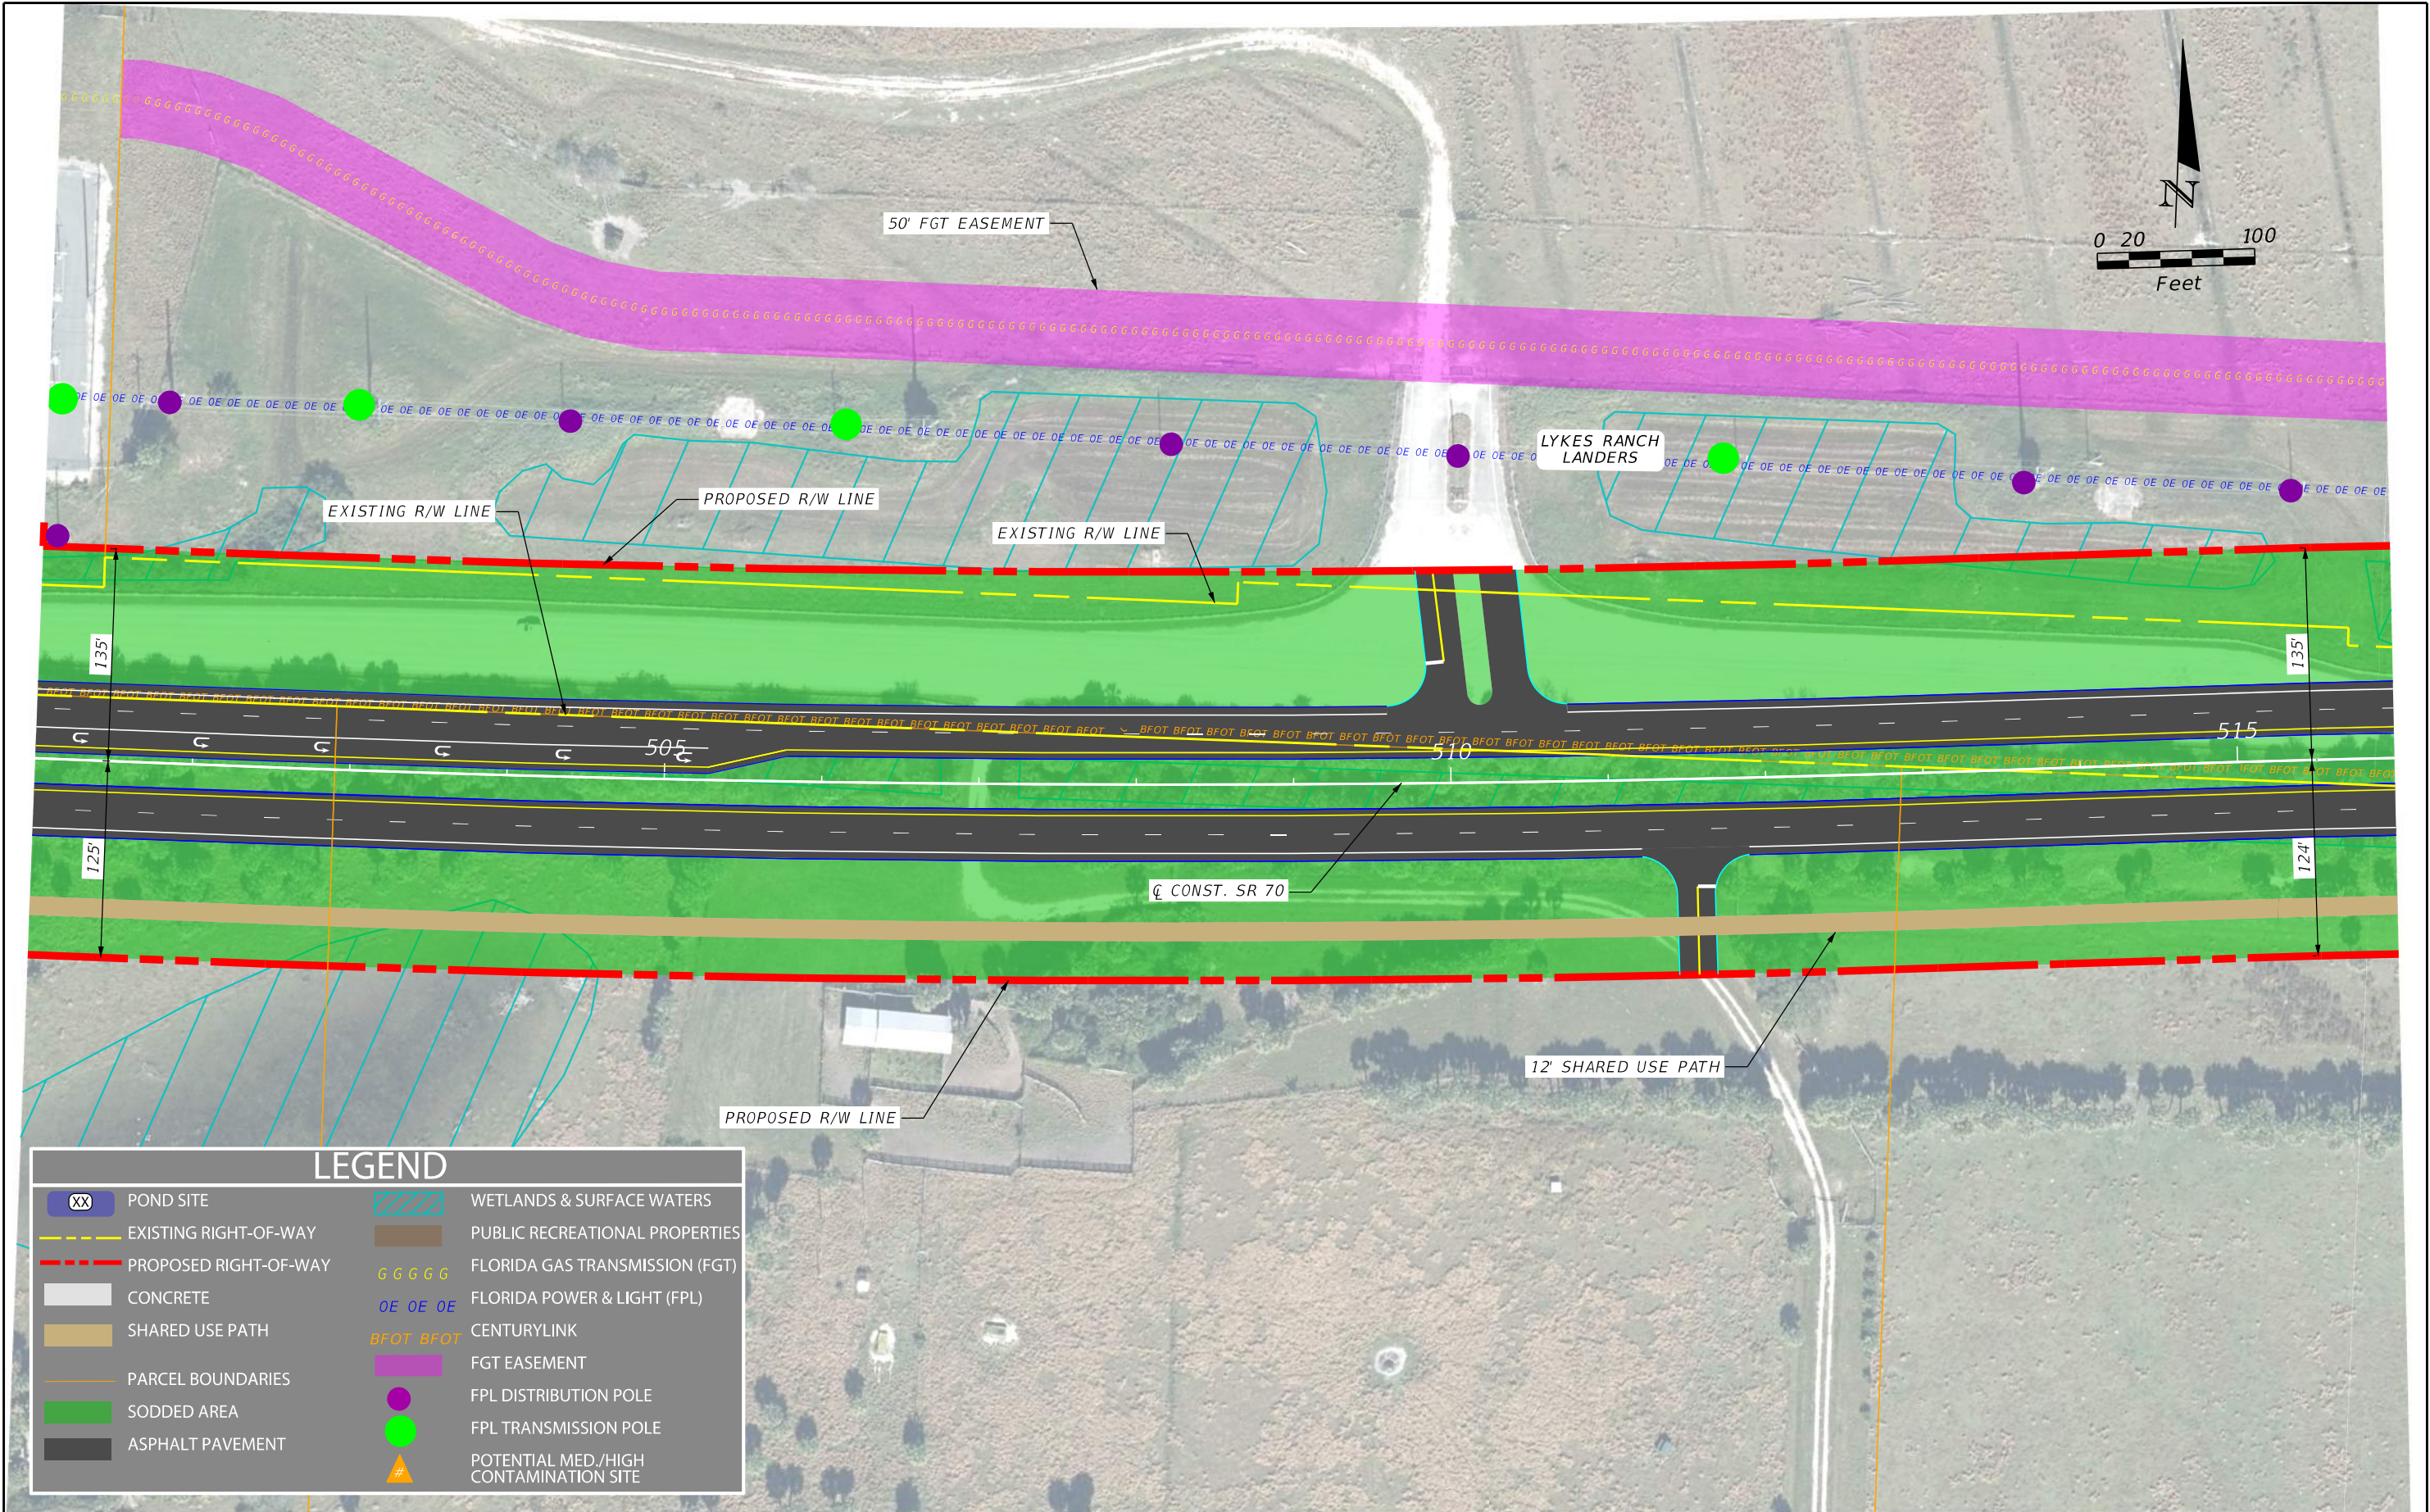

LEGEND

XX

POND SITE

EXISTING RIGHT-OF-WAY

PROPOSED RIGHT-OF-WAY

CONCRETE

SHARED USE PATH

PARCEL BOUNDARIES

SODDED AREA

ASPHALT PAVEMENT

WETLANDS & SURFACE WATERS

PUBLIC RECREATIONAL PROPERTIES

GGGGG

FLORIDA GAS TRANSMISSION (FGT)

OE OE OE

FLORIDA POWER & LIGHT (FPL)

BFOT BFOT

CENTURYLINK

FGT EASEMENT


FPL DISTRIBUTION POLE

FPL TRANSMISSION POLE

#


POTENTIAL MED./HIGH CONTAMINATION SITE

REVISIONS				ENGINEER OF RECORD		STATE OF FLORIDA DEPARTMENT OF TRANSPORTATION		ALTERNATIVE 1 CONCEPT PLAN	SHEET NO. 9
DATE	DESCRIPTION	DATE	DESCRIPTION	NICHOLAS JOHN CLAVEL0 P.E. LICENSE NUMBER: 84366 SCALAR CONSULTING GROUP, LLC. 5713 CORPORATE WAY, SUITE 200 WEST PALM BEACH, FLORIDA 33407		ROAD NO.	COUNTY		
						SR 70	HIGHLANDS OKEECHOBEE	FINANCIAL PROJECT ID 450334-1-22-01	

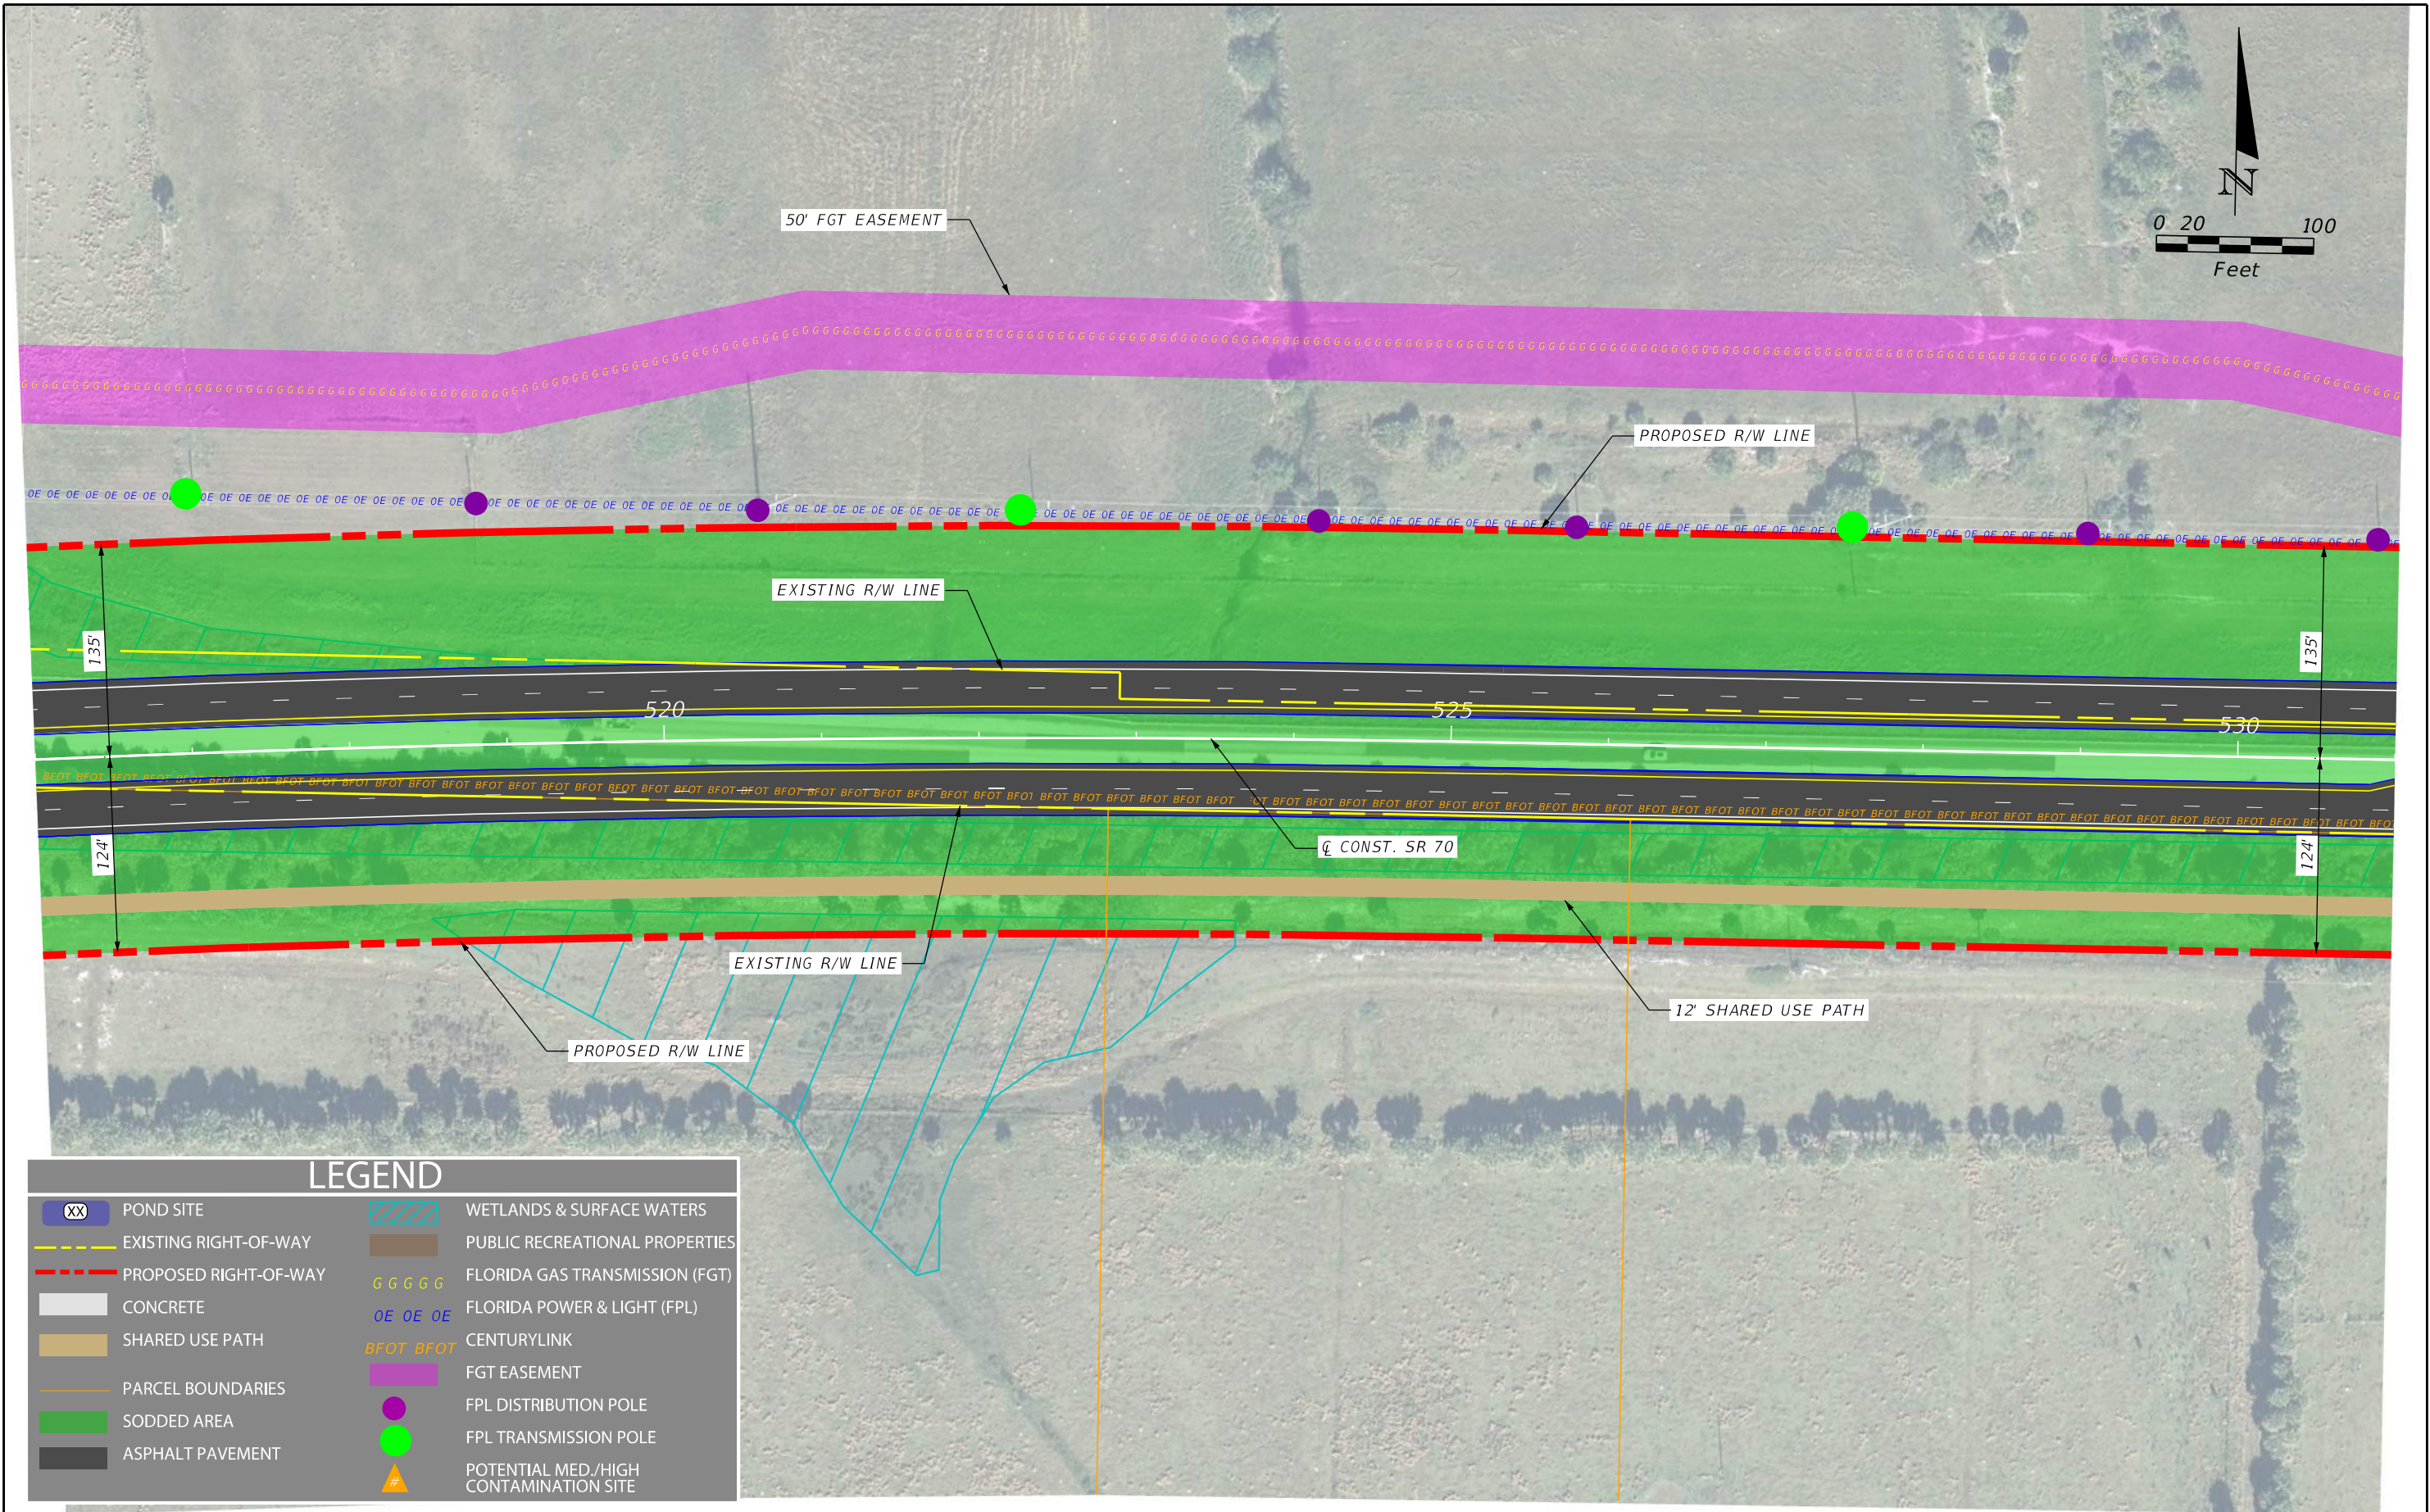

LEGEND			
	POND SITE		WETLANDS & SURFACE WATERS
	EXISTING RIGHT-OF-WAY		PUBLIC RECREATIONAL PROPERTIES
	PROPOSED RIGHT-OF-WAY		FLORIDA GAS TRANSMISSION (FGT)
	CONCRETE		FLORIDA POWER & LIGHT (FPL)
	SHARED USE PATH		CENTURYLINK
	PARCEL BOUNDARIES		FGT EASEMENT
	SODDED AREA		FPL DISTRIBUTION POLE
	ASPHALT PAVEMENT		FPL TRANSMISSION POLE
			POTENTIAL MED./HIGH CONTAMINATION SITE


REVISIONS				ENGINEER OF RECORD	STATE OF FLORIDA DEPARTMENT OF TRANSPORTATION			SHEET NO. 10
DATE	DESCRIPTION	DATE	DESCRIPTION		ROAD NO.	COUNTY	FINANCIAL PROJECT ID	
					SR 70	HIGHLANDS OKEECHOBEE	450334-1-22-01	
				NICHOLAS JOHN CLAVELLO P.E. LICENSE NUMBER: 84366 SCALAR CONSULTING GROUP, LLC. 5713 CORPORATE WAY, SUITE 200 WEST PALM BEACH, FLORIDA 33407	ALTERNATIVE 1 CONCEPT PLAN			

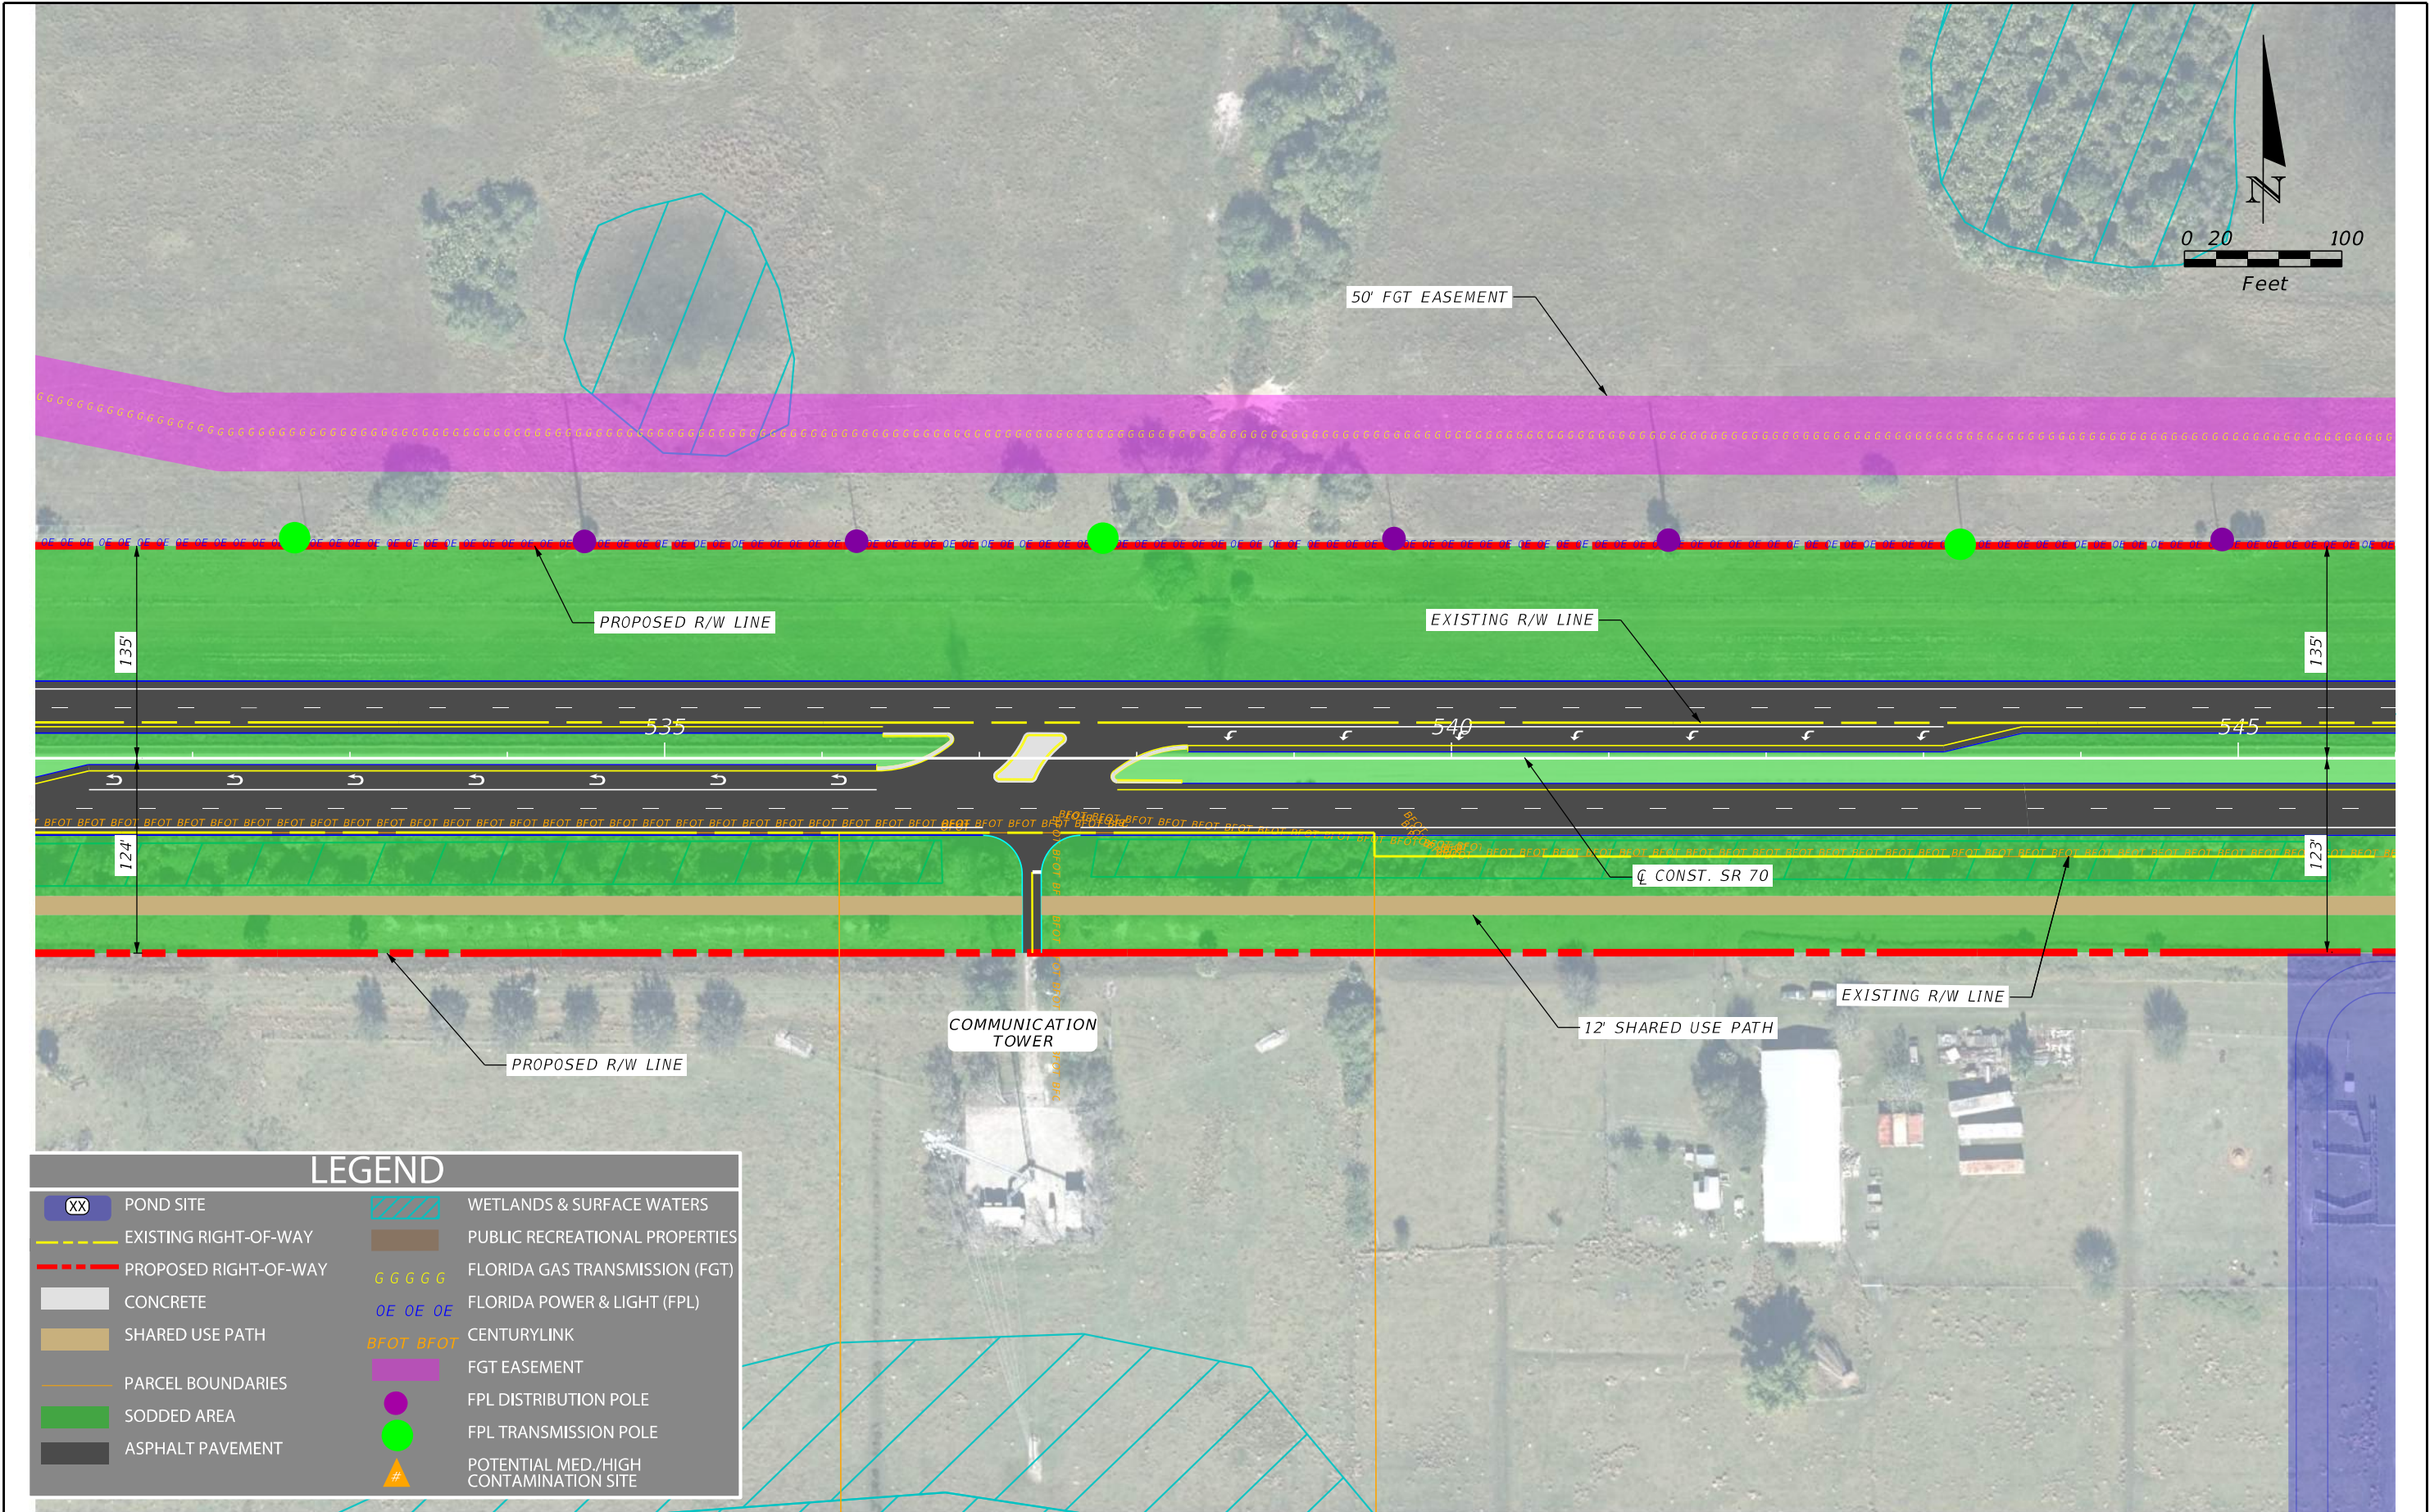

REVISIONS				ENGINEER OF RECORD		STATE OF FLORIDA DEPARTMENT OF TRANSPORTATION			SHEET NO.
DATE	DESCRIPTION	DATE	DESCRIPTION	NICHOLAS JOHN CLAVELLO P.E. LICENSE NUMBER: 84366 SCALAR CONSULTING GROUP, LLC. 5713 CORPORATE WAY, SUITE 200 WEST PALM BEACH, FLORIDA 33407		ROAD NO.	COUNTY	FINANCIAL PROJECT ID	
						SR 70	HIGHLANDS OKEECHOBEE	450334-1-22-01	


ALTERNATIVE 1
CONCEPT PLAN

THE OFFICIAL RECORD OF THIS SHEET IS THE ELECTRONIC FILE DIGITALLY SIGNED AND SEALED UNDER RULE 61G15-23.004, F.A.C.

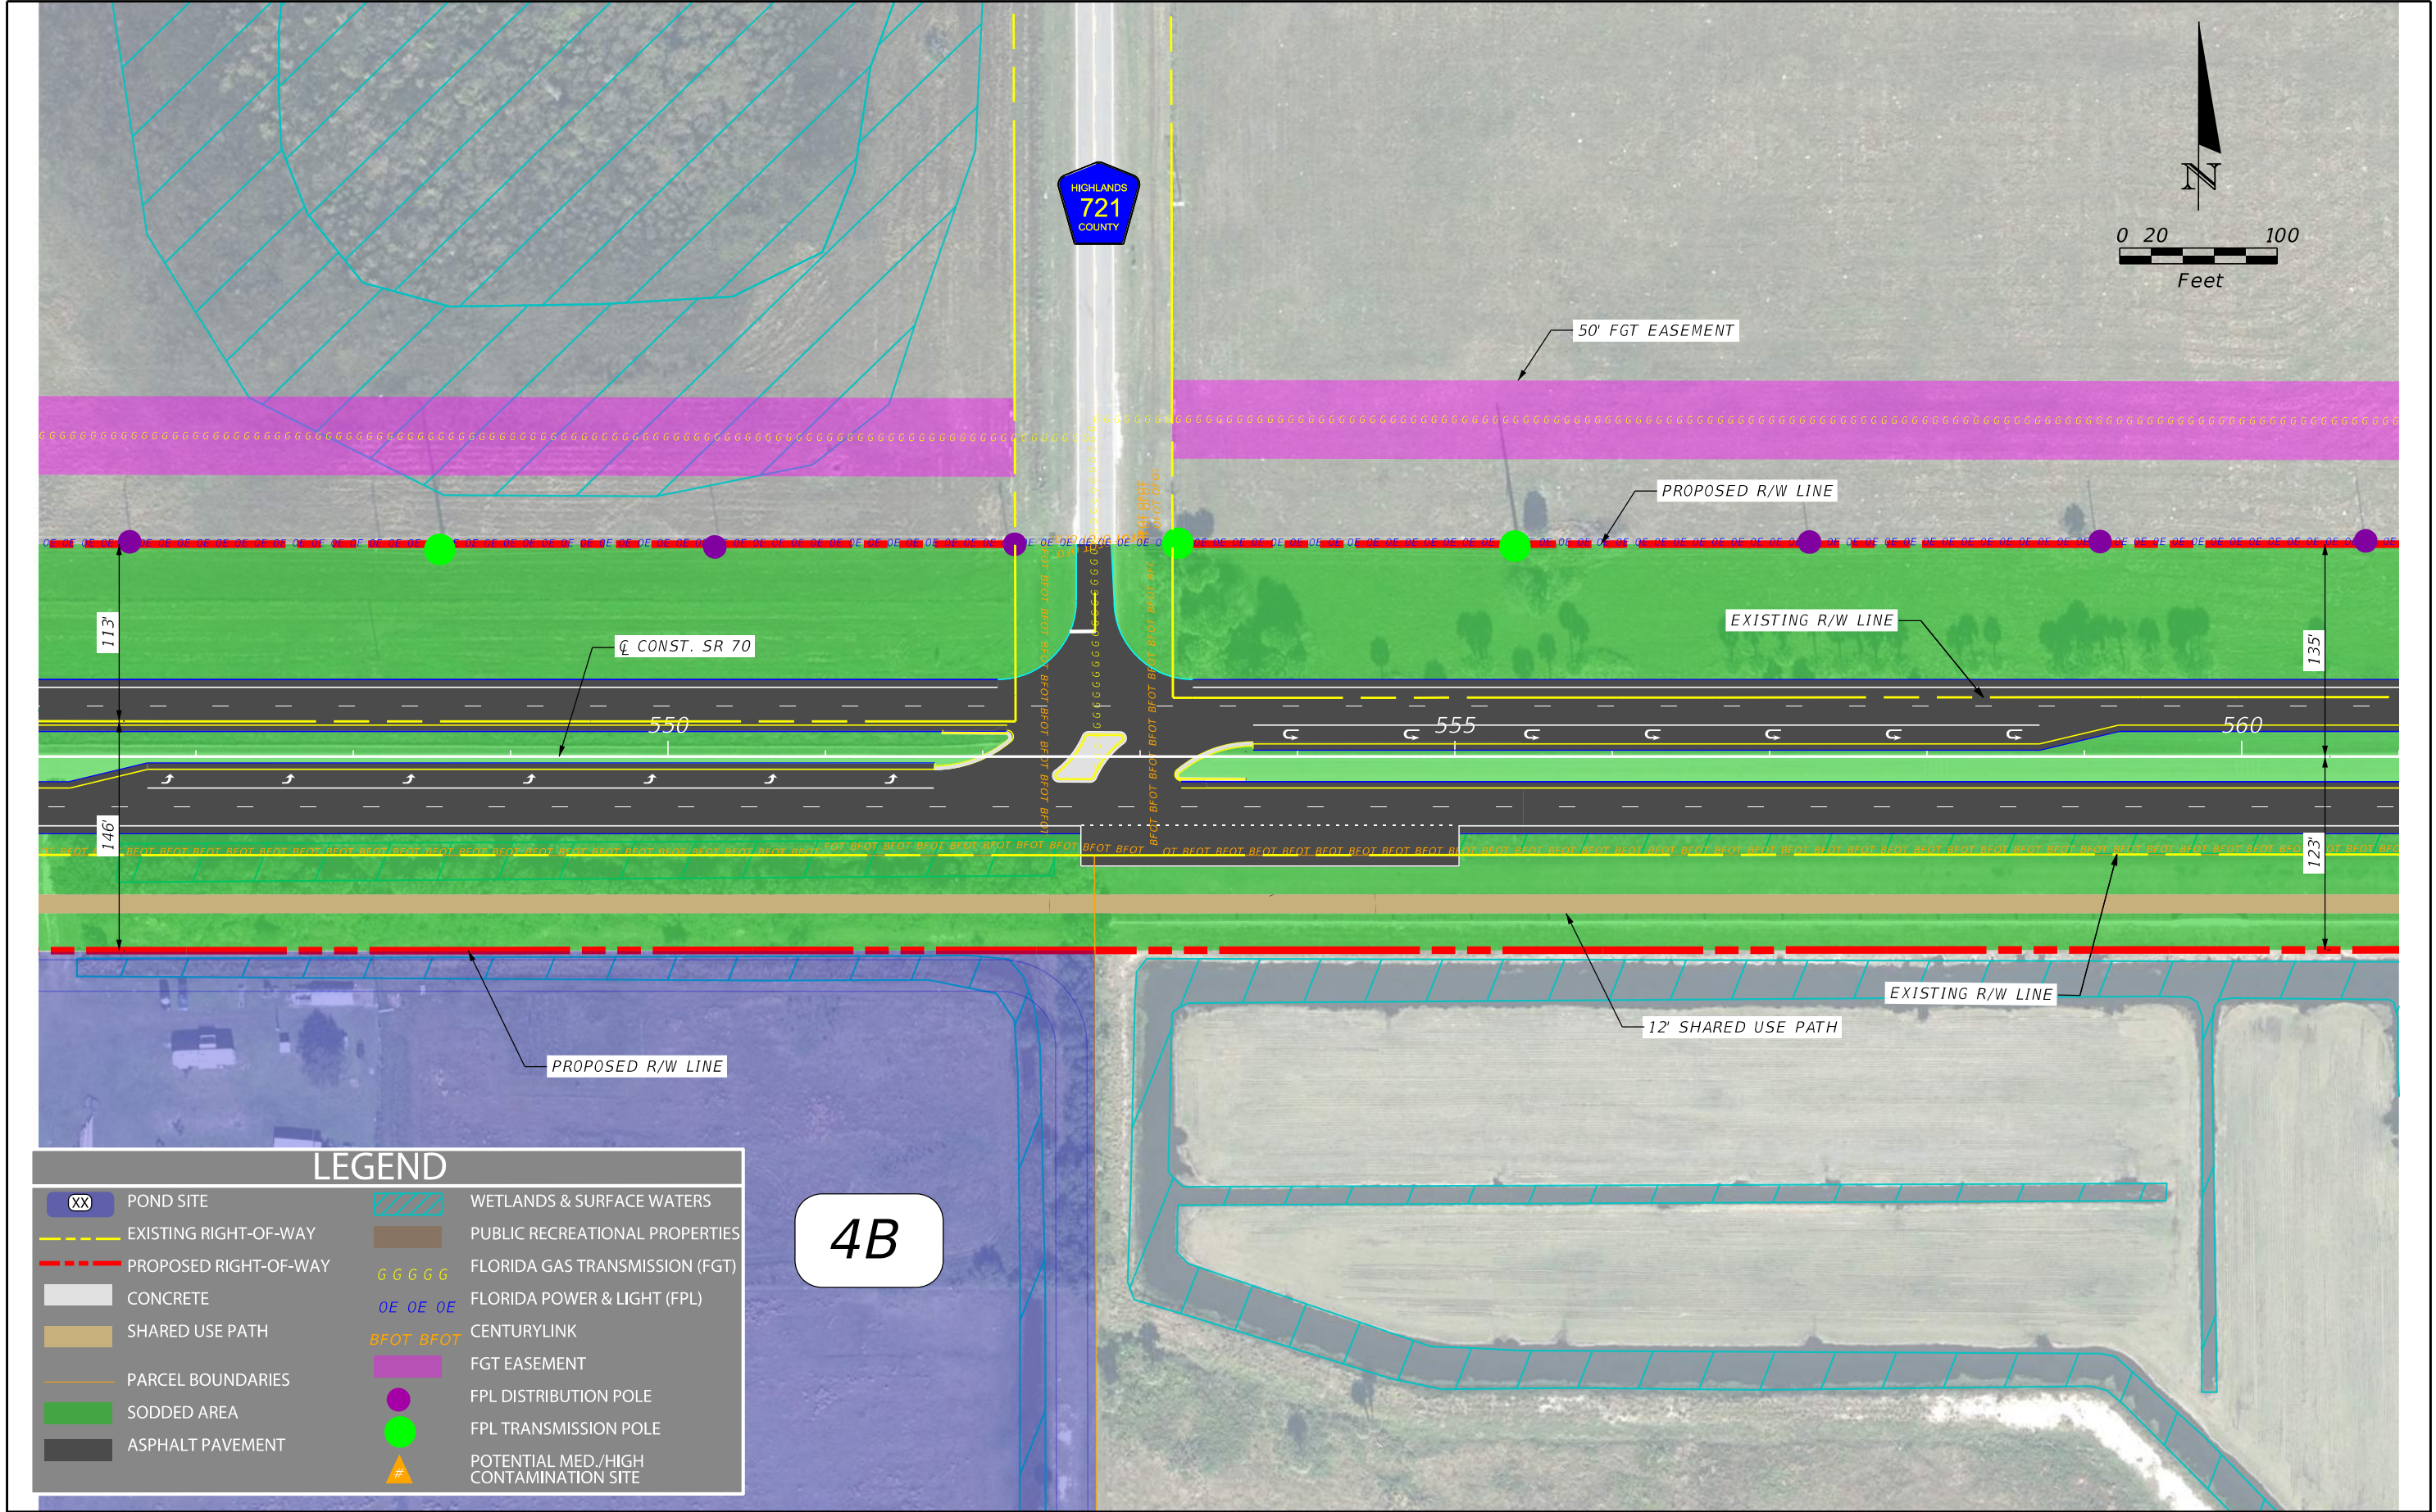

REVISIONS				ENGINEER OF RECORD		STATE OF FLORIDA DEPARTMENT OF TRANSPORTATION		ALTERNATIVE 1 CONCEPT PLAN	SHEET NO. 12
DATE	DESCRIPTION	DATE	DESCRIPTION	NICHOLAS JOHN CLAVELLO P.E. LICENSE NUMBER: 84366 SCALAR CONSULTING GROUP, LLC. 5713 CORPORATE WAY, SUITE 200 WEST PALM BEACH, FLORIDA 33407		ROAD NO.	COUNTY		
						SR 70	HIGHLANDS OKEECHOBEE	FINANCIAL PROJECT ID 450334-1-22-01	

THE OFFICIAL RECORD OF THIS SHEET IS THE ELECTRONIC FILE DIGITALLY SIGNED AND SEALED UNDER RULE 61G15-23.004, F.A.C.

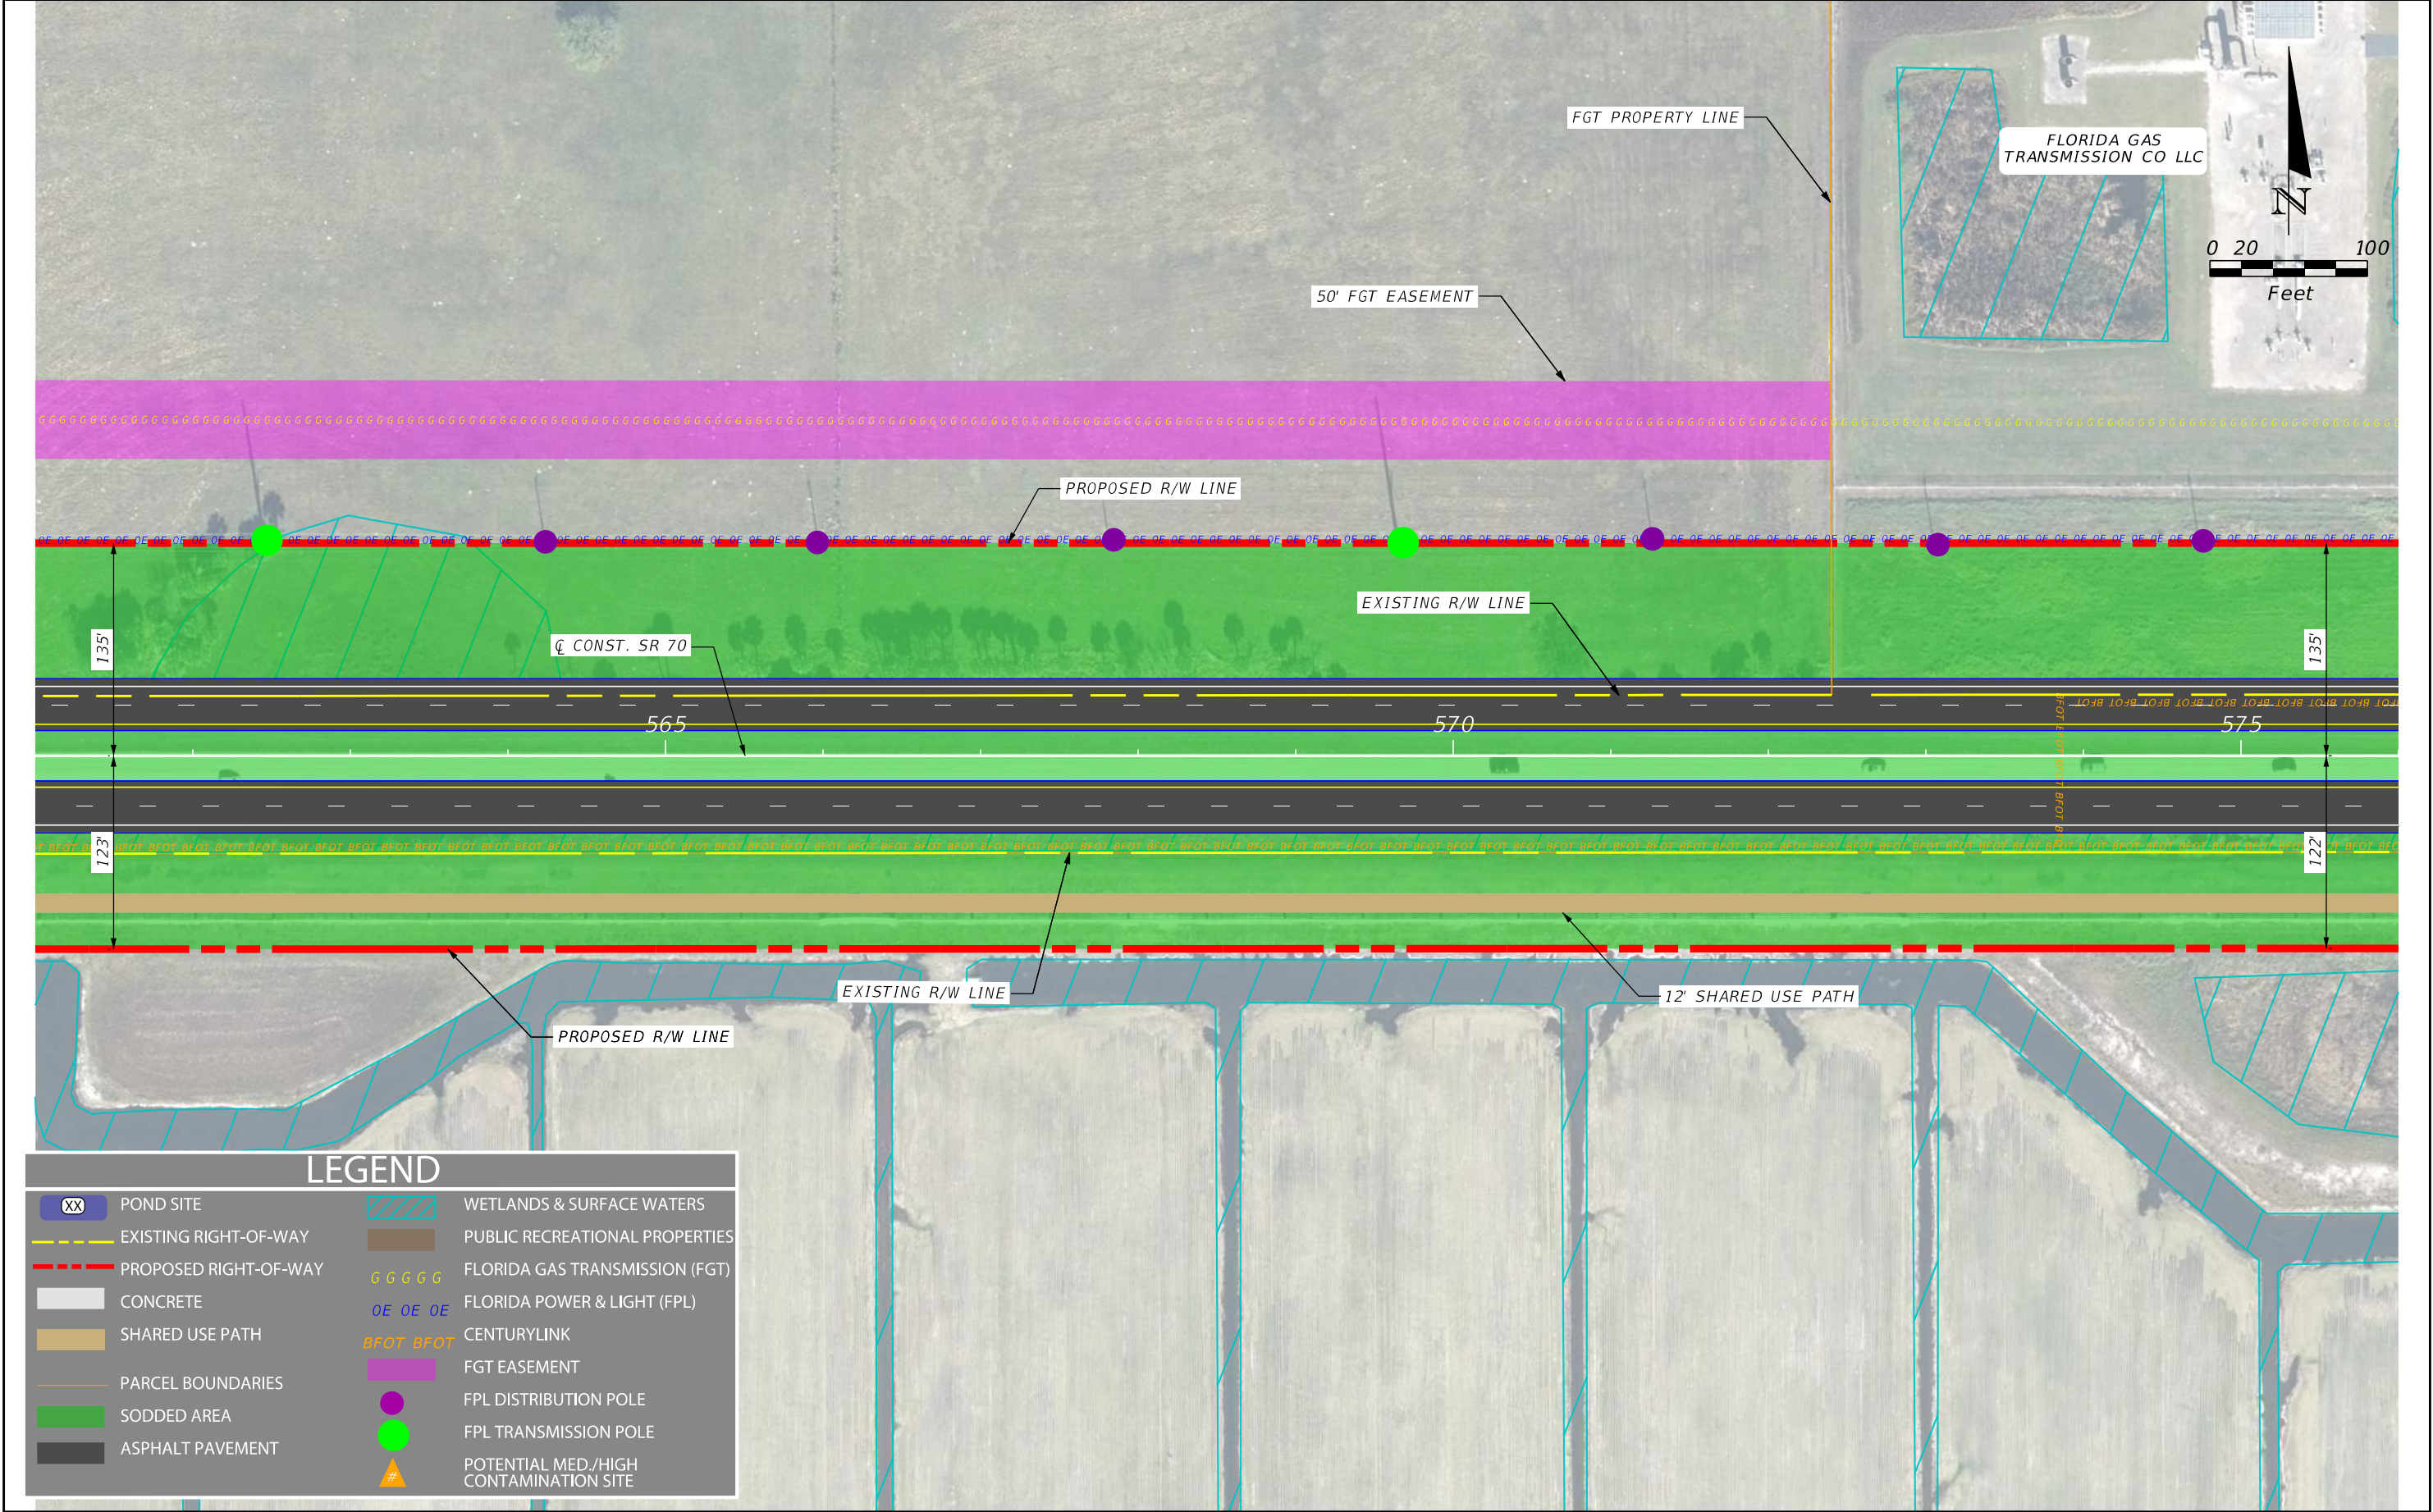


LEGEND

- | | |
|-----------------------|---------------------------------------|
| POND SITE | WETLANDS & SURFACE WATERS |
| EXISTING RIGHT-OF-WAY | PUBLIC RECREATIONAL PROPERTIES |
| PROPOSED RIGHT-OF-WAY | FLORIDA GAS TRANSMISSION (FGT) |
| CONCRETE | FLORIDA POWER & LIGHT (FPL) |
| SHARED USE PATH | CENTURYLINK |
| PARCEL BOUNDARIES | FGT EASEMENT |
| SODDED AREA | FPL DISTRIBUTION POLE |
| ASPHALT PAVEMENT | FPL TRANSMISSION POLE |
| | POTENTIAL MED/HIGH CONTAMINATION SITE |


REVISIONS				ENGINEER OF RECORD			STATE OF FLORIDA DEPARTMENT OF TRANSPORTATION			SHEET NO.
DATE	DESCRIPTION	DATE	DESCRIPTION	NICHOLAS JOHN CLAVELO P.E. LICENSE NUMBER: 84366 SCALAR CONSULTING GROUP, LLC. 5713 CORPORATE WAY, SUITE 200 WEST PALM BEACH, FLORIDA 33407			ROAD NO.	COUNTY	FINANCIAL PROJECT ID	
							SR 70	HIGHLANDS OKEECHOBEE	450334-1-22-01	

ALTERNATIVE 1
CONCEPT PLAN

THE OFFICIAL RECORD OF THIS SHEET IS THE ELECTRONIC FILE DIGITALLY SIGNED AND SEALED UNDER RULE 61G15-23.004, F.A.C.

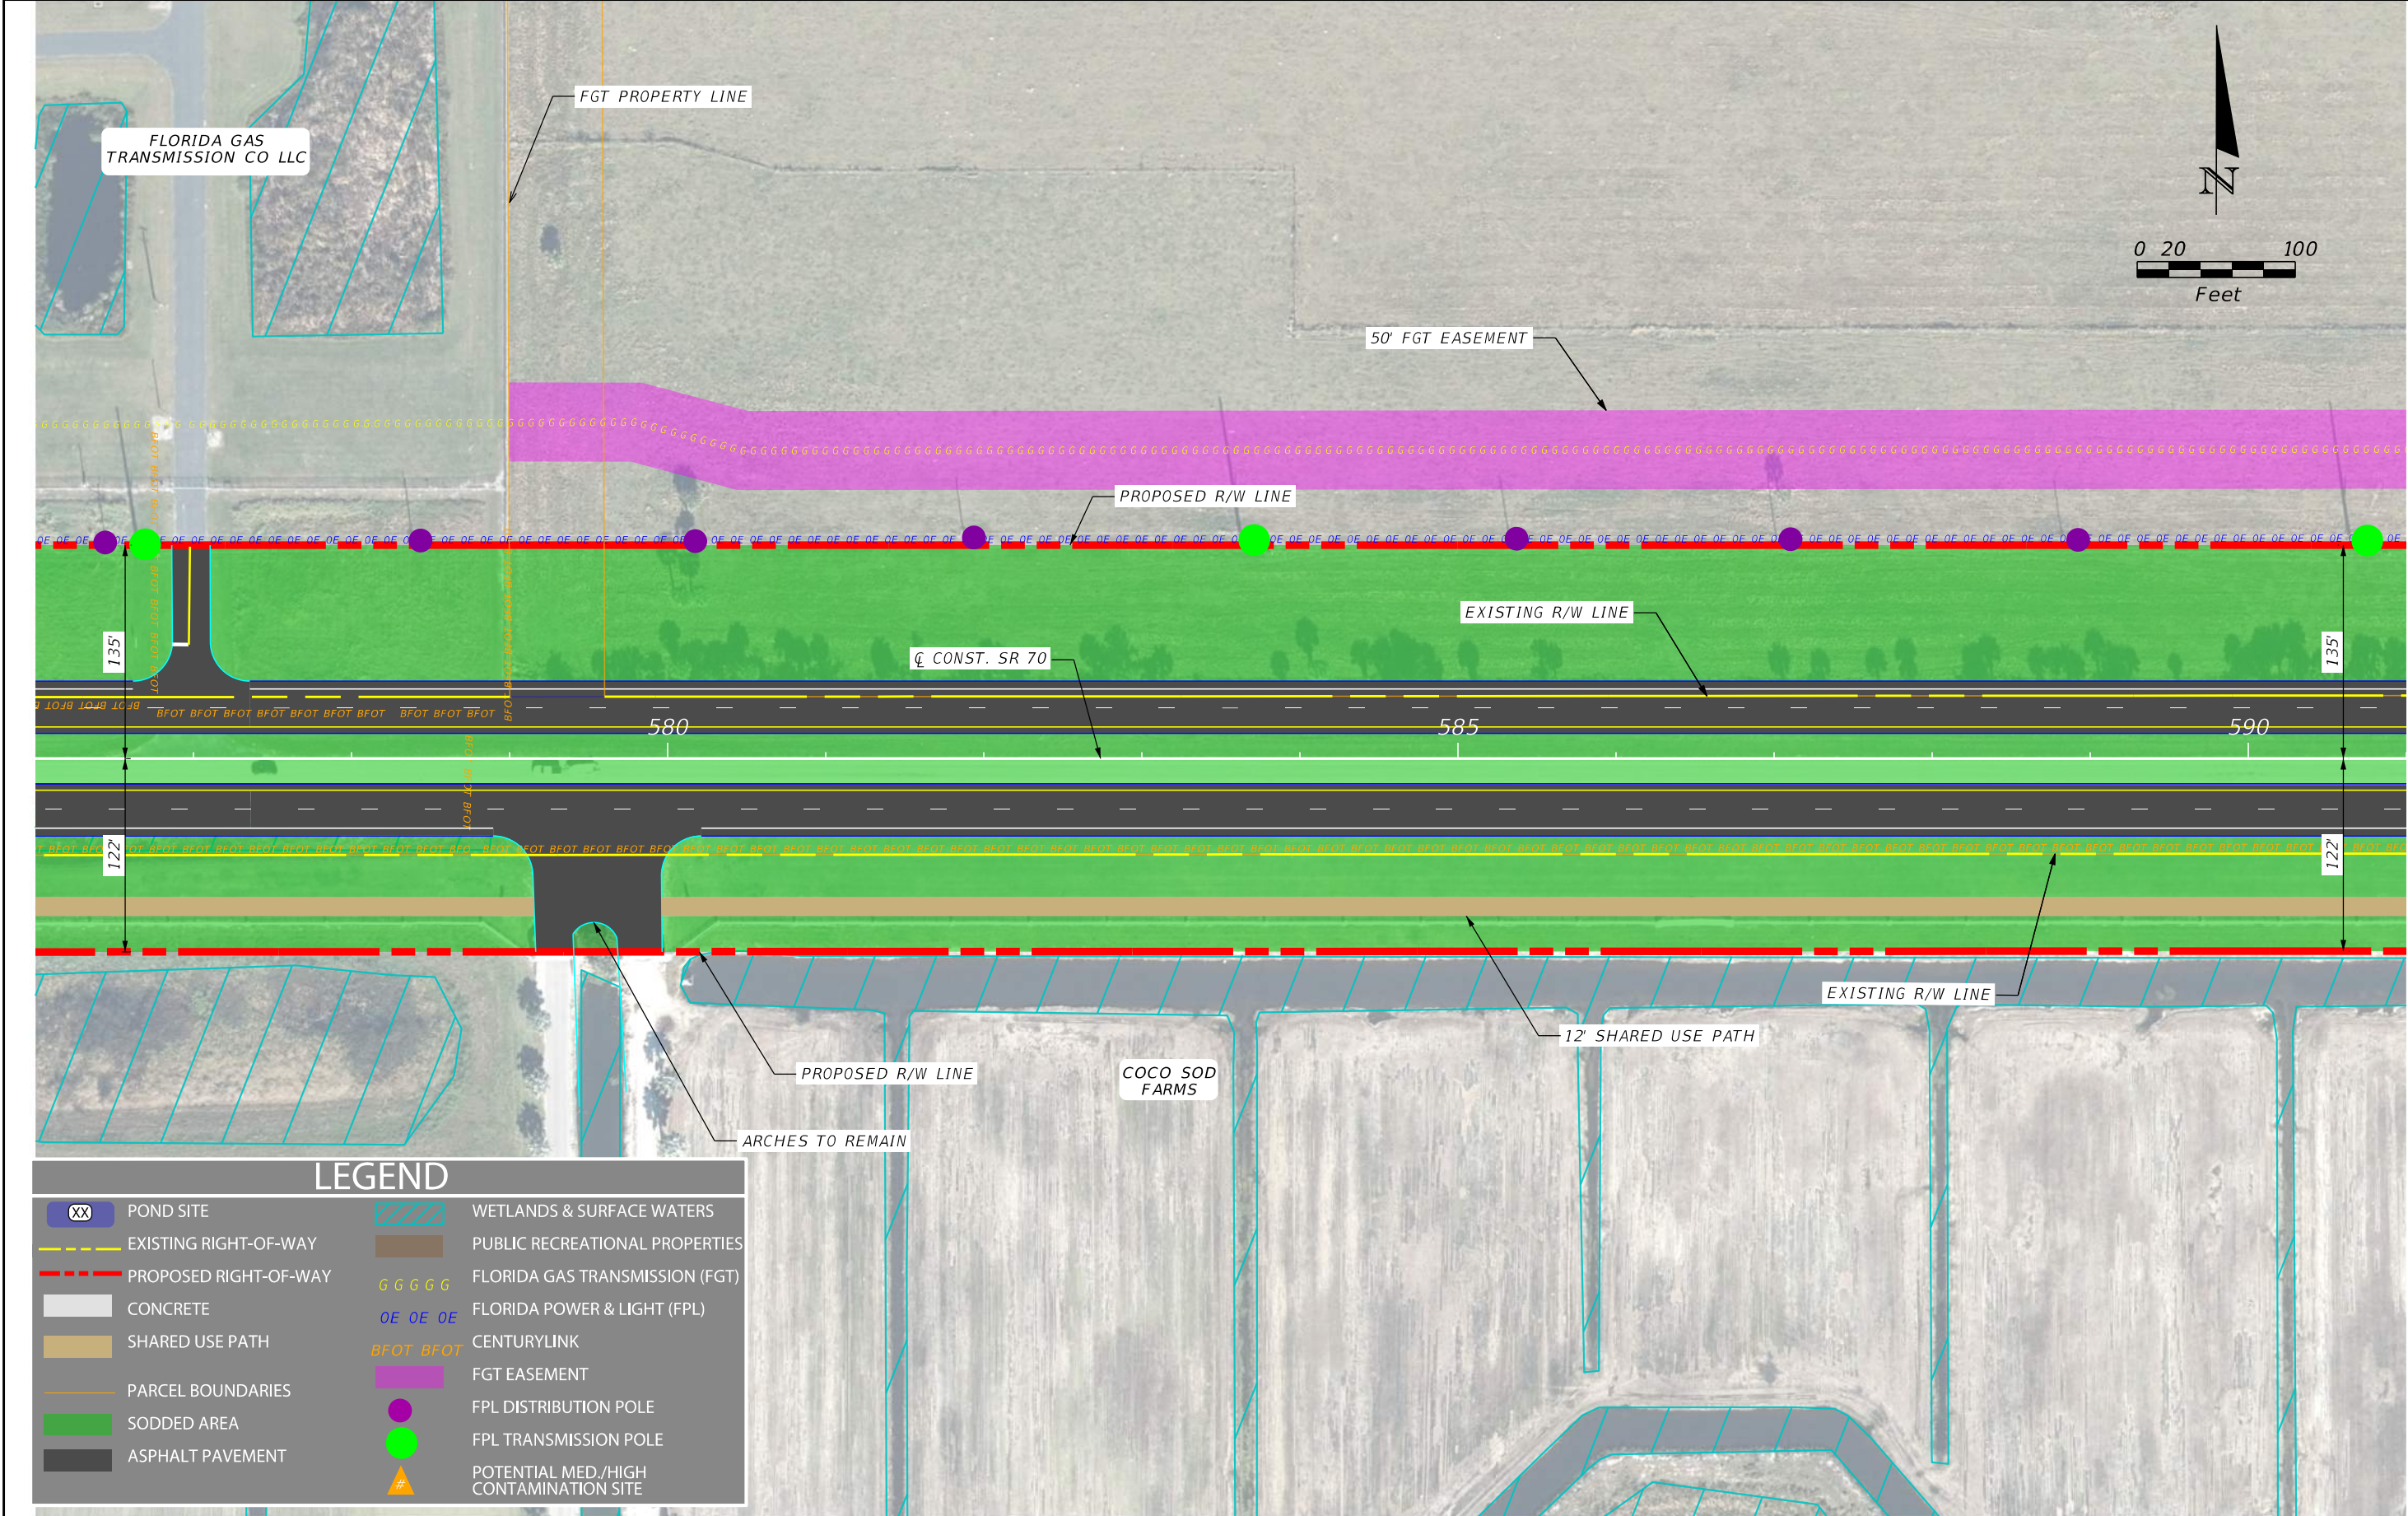

REVISIONS				ENGINEER OF RECORD		STATE OF FLORIDA DEPARTMENT OF TRANSPORTATION		ALTERNATIVE 1 CONCEPT PLAN	SHEET NO. 14
DATE	DESCRIPTION	DATE	DESCRIPTION	NICHOLAS JOHN CLAVELO P.E. LICENSE NUMBER: 84366 SCALAR CONSULTING GROUP, LLC. 5713 CORPORATE WAY, SUITE 200 WEST PALM BEACH, FLORIDA 33407		ROAD NO.	COUNTY		
						SR 70	HIGHLANDS OKEECHOBEE	FINANCIAL PROJECT ID 450334-1-22-01	

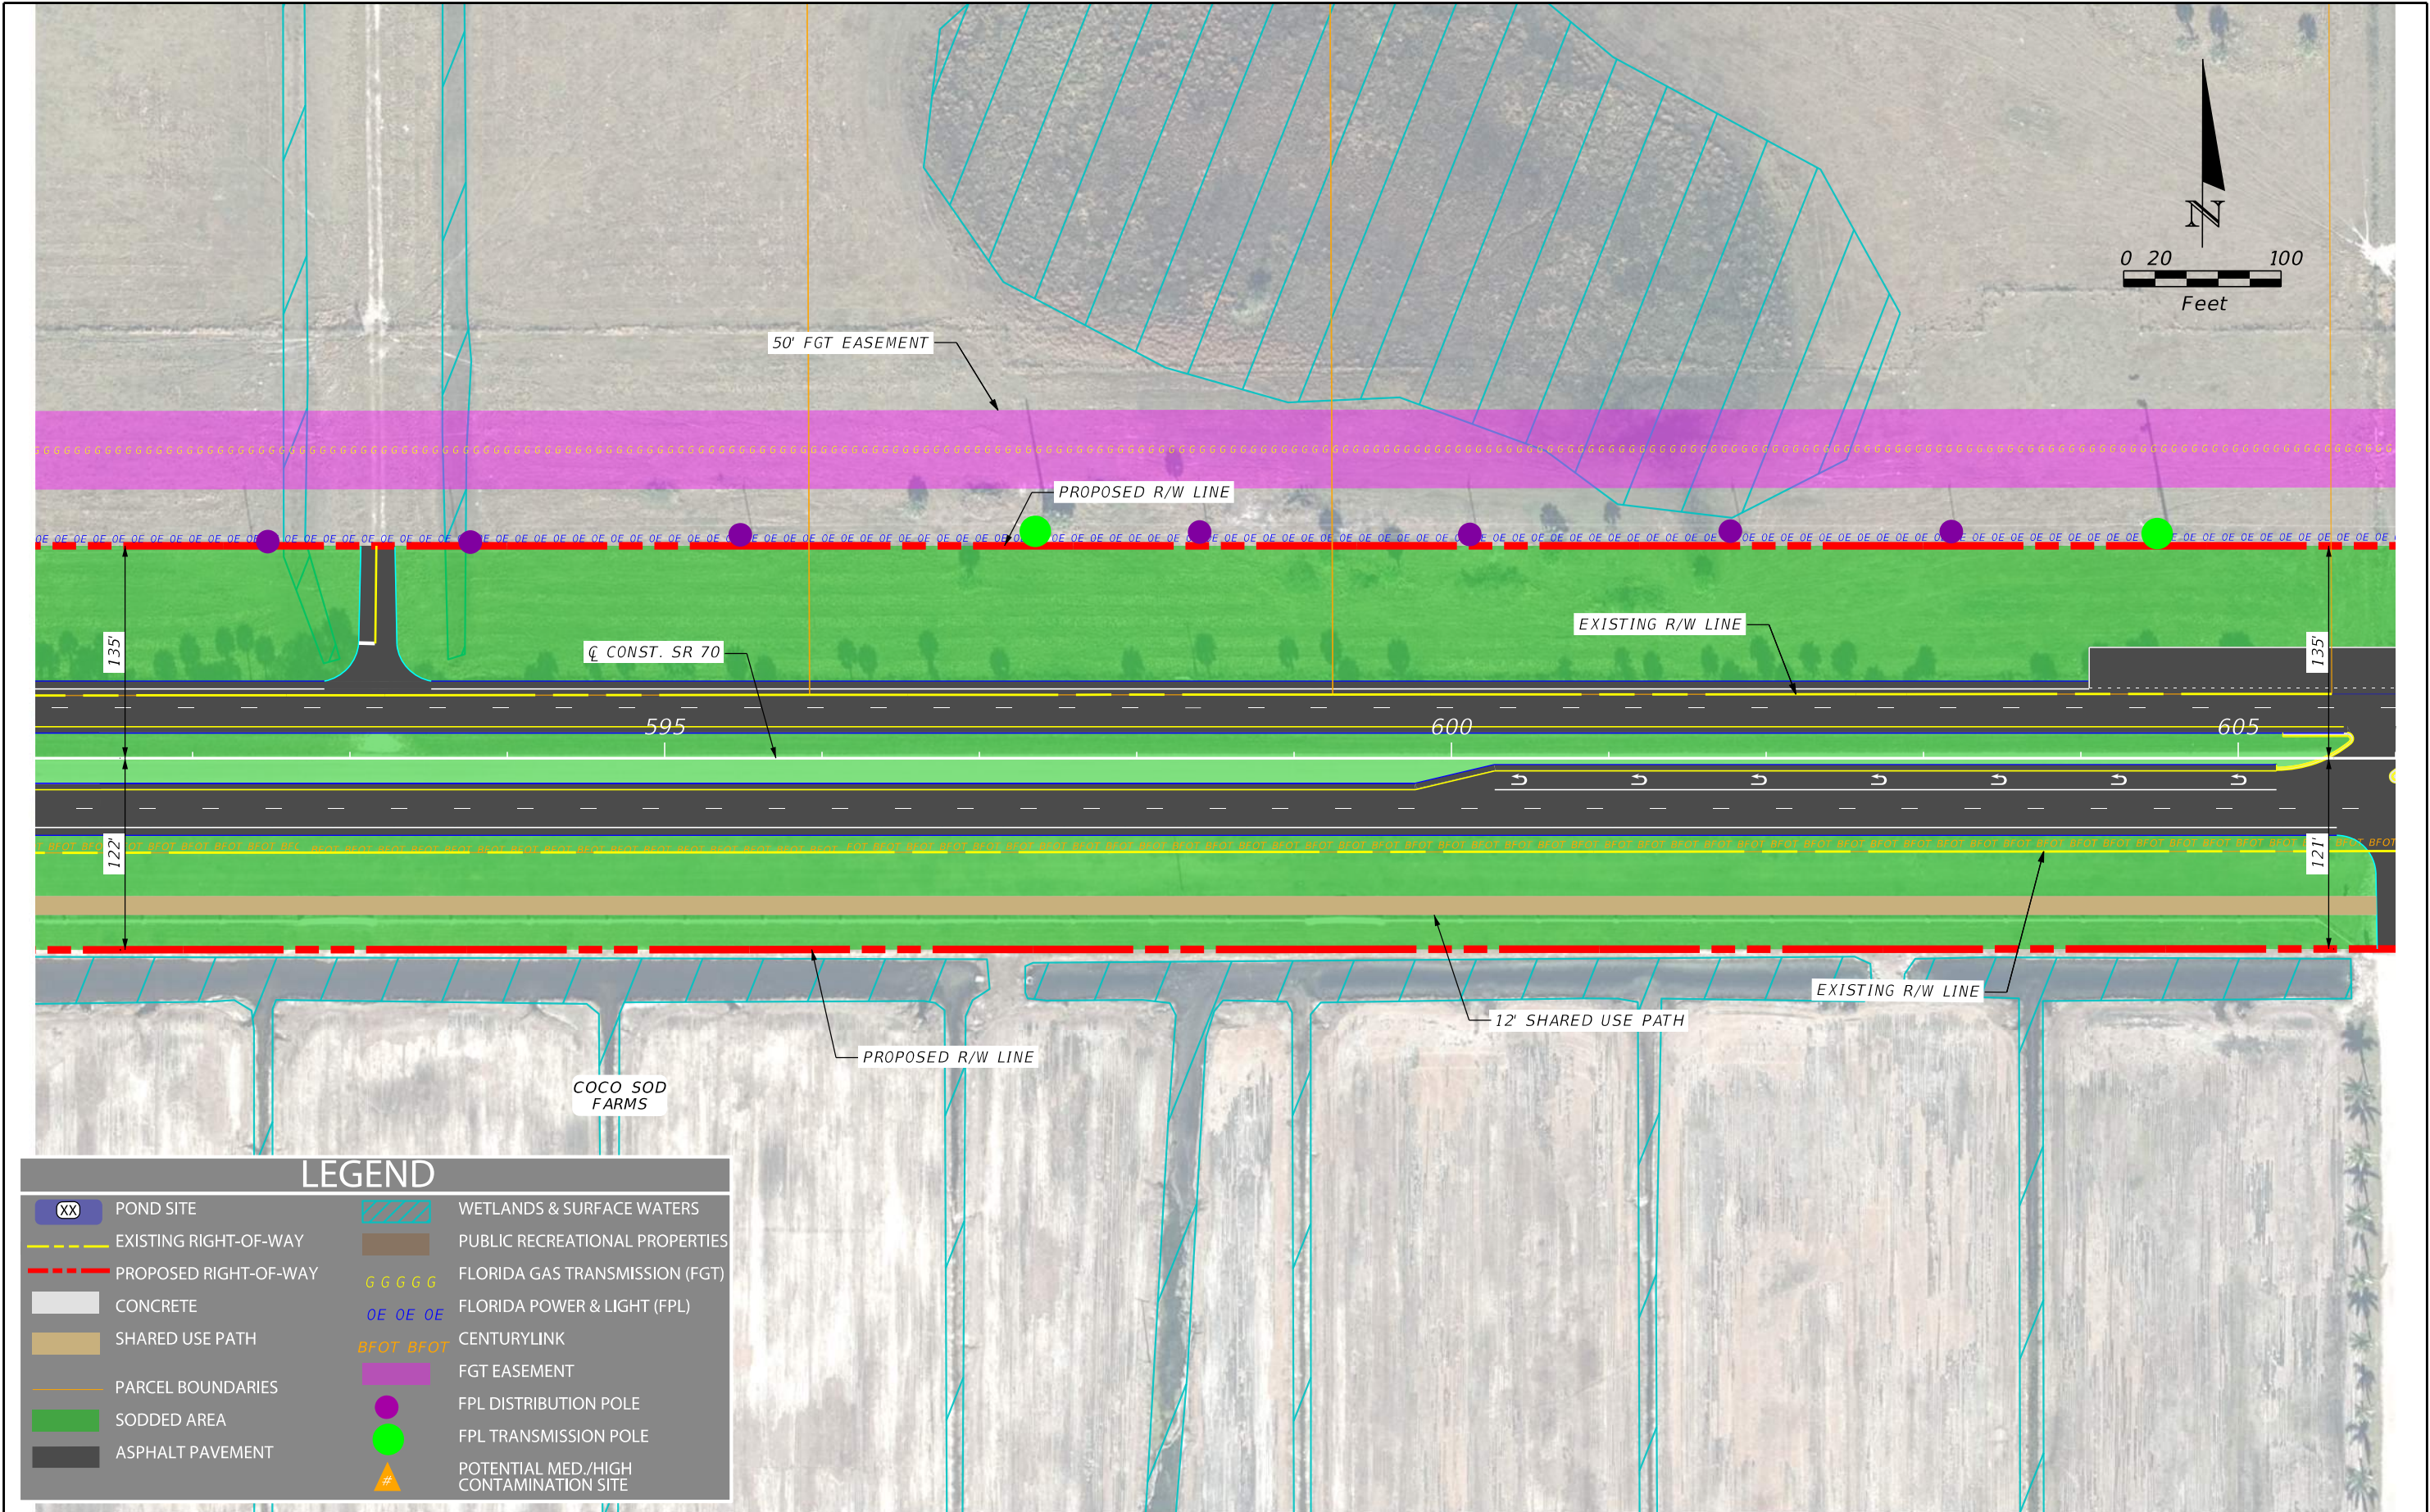


LEGEND



POND SITE	WETLANDS & SURFACE WATERS
EXISTING RIGHT-OF-WAY	PUBLIC RECREATIONAL PROPERTIES
PROPOSED RIGHT-OF-WAY	FLORIDA GAS TRANSMISSION (FGT)
CONCRETE	FLORIDA POWER & LIGHT (FPL)
SHARED USE PATH	CENTURYLINK
PARCEL BOUNDARIES	FGT EASEMENT
SODDED AREA	FPL DISTRIBUTION POLE
ASPHALT PAVEMENT	FPL TRANSMISSION POLE
	POTENTIAL MED./HIGH CONTAMINATION SITE

REVISIONS				ENGINEER OF RECORD		STATE OF FLORIDA DEPARTMENT OF TRANSPORTATION		ALTERNATIVE 1 CONCEPT PLAN	SHEET NO. 15
DATE	DESCRIPTION	DATE	DESCRIPTION	NICHOLAS JOHN CLAVELLO P.E. LICENSE NUMBER: 84366 SCALAR CONSULTING GROUP, LLC. 5713 CORPORATE WAY, SUITE 200 WEST PALM BEACH, FLORIDA 33407		ROAD NO.	COUNTY		
						SR 70	HIGHLANDS OKEECHOBEE	FINANCIAL PROJECT ID 450334-1-22-01	

THE OFFICIAL RECORD OF THIS SHEET IS THE ELECTRONIC FILE DIGITALLY SIGNED AND SEALED UNDER RULE 61G15-23.004, F.A.C.

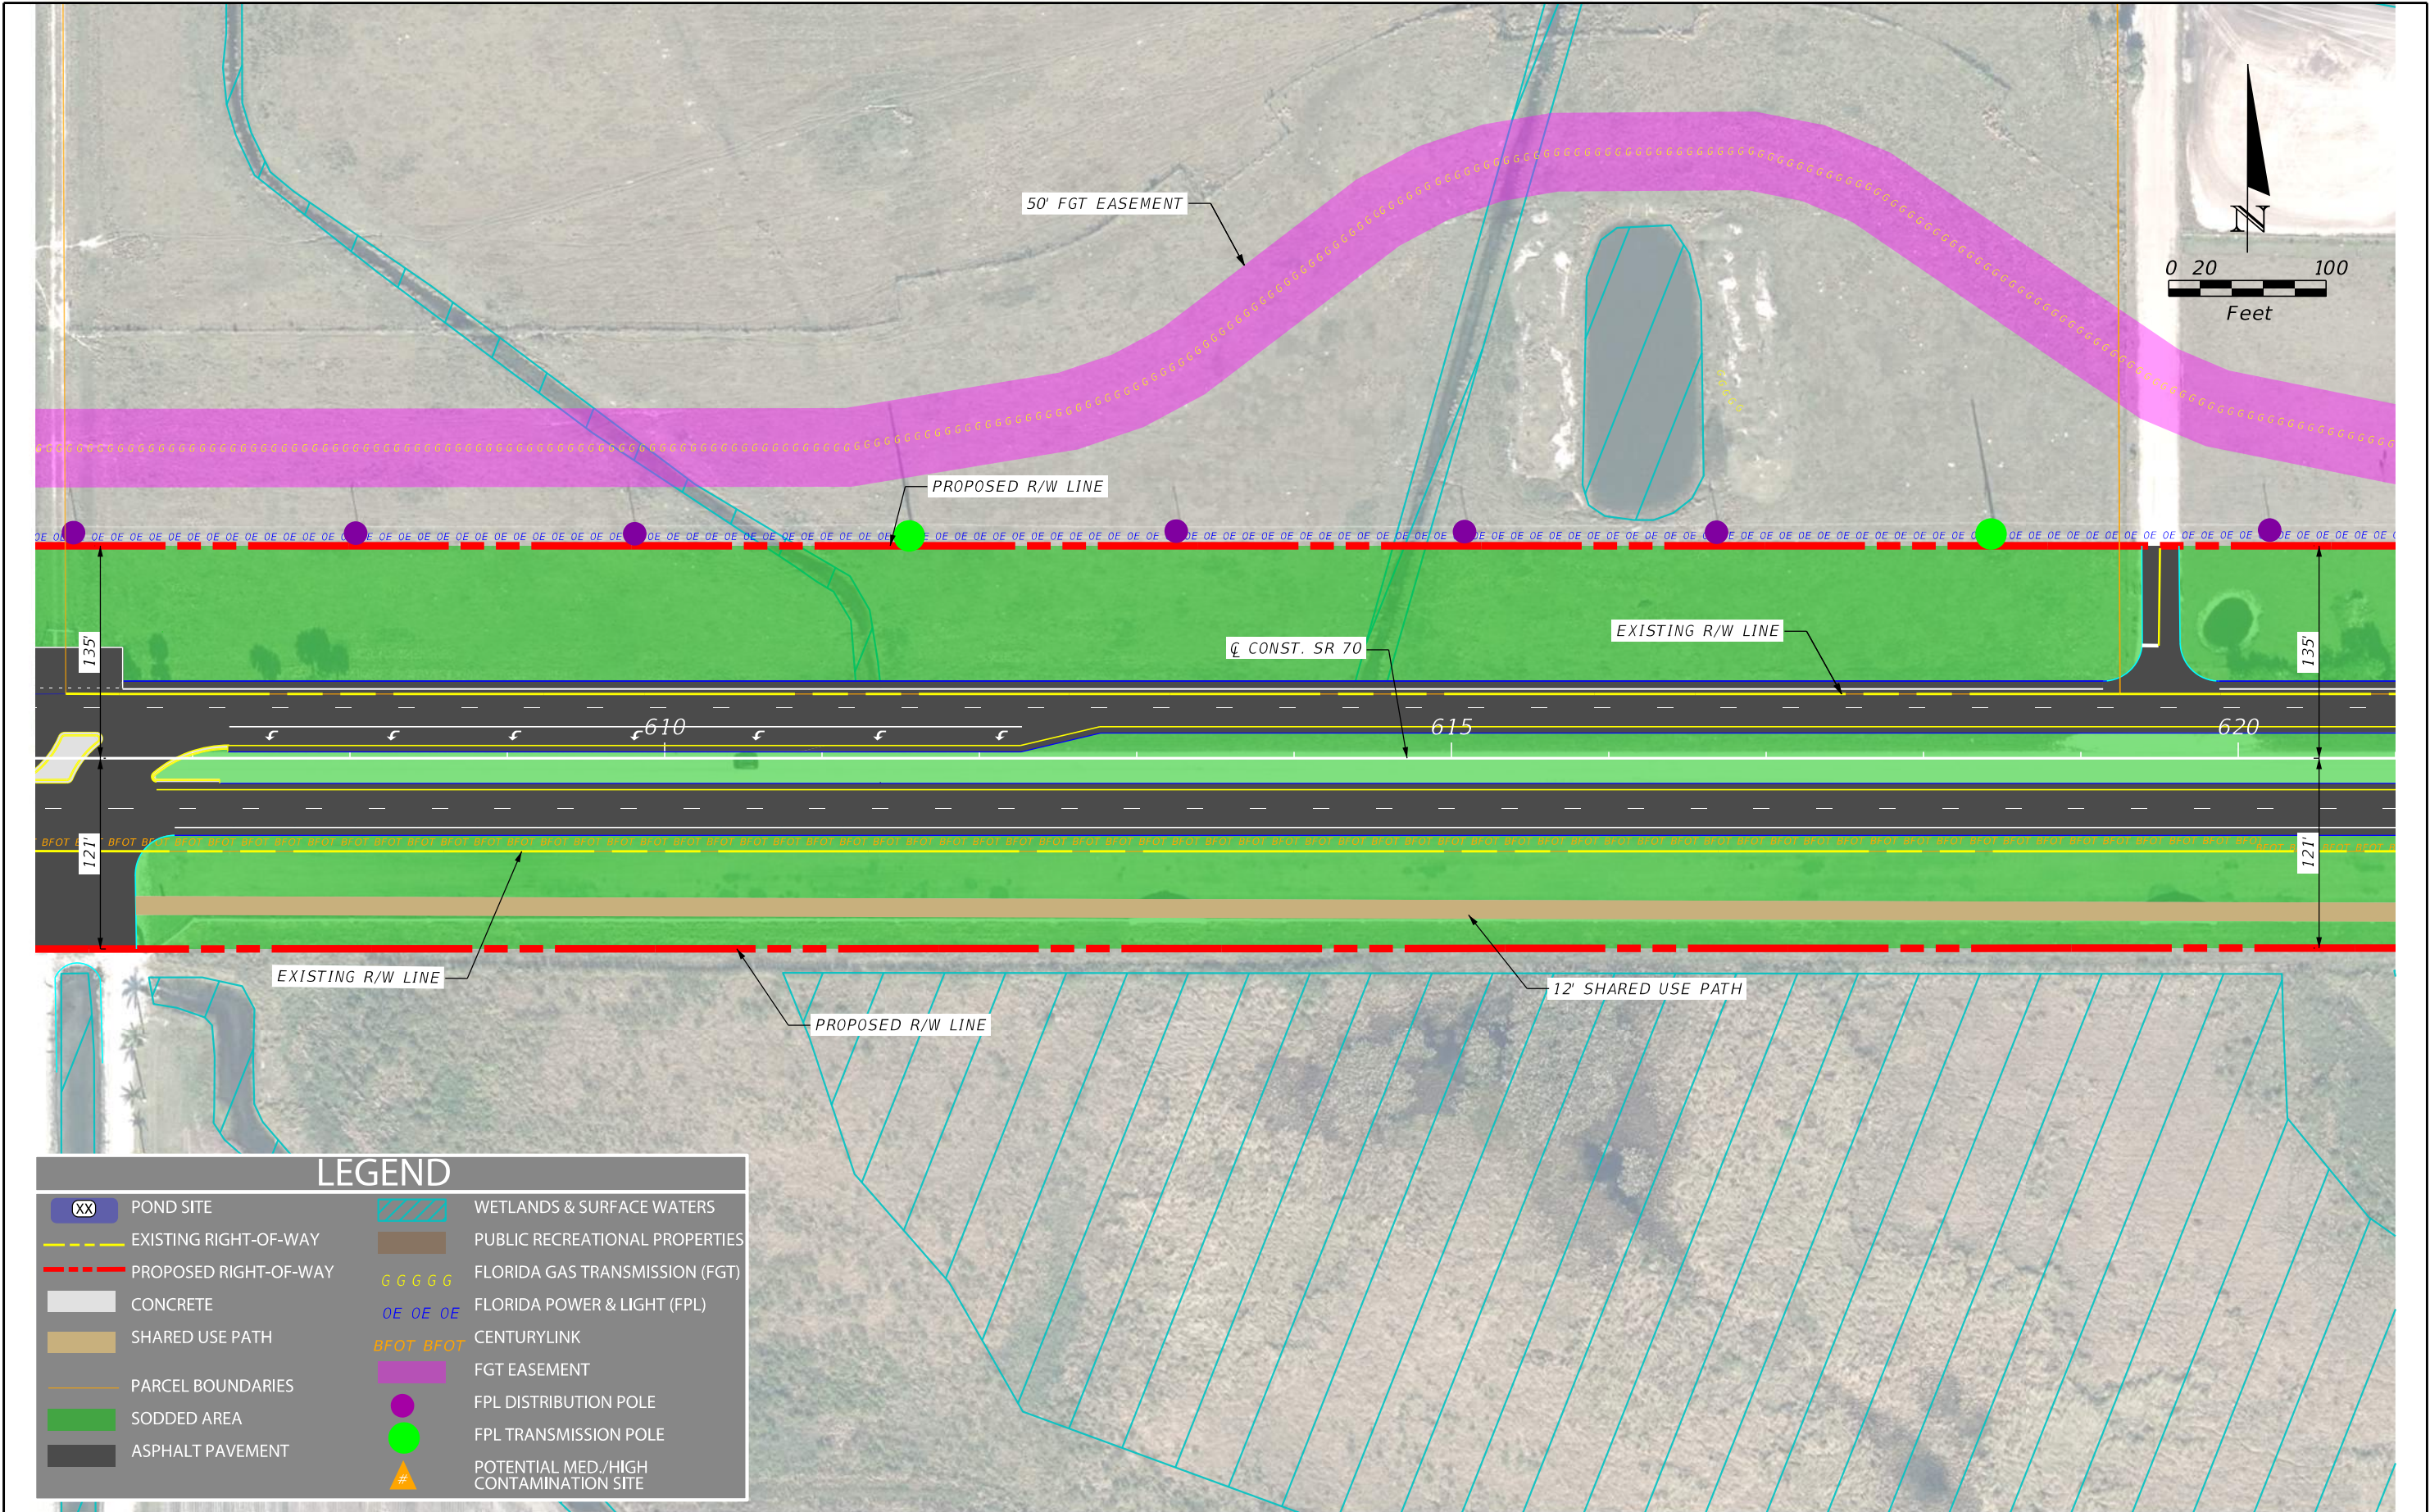


REVISIONS				ENGINEER OF RECORD		STATE OF FLORIDA DEPARTMENT OF TRANSPORTATION		ALTERNATIVE 1 CONCEPT PLAN	SHEET NO. 16
DATE	DESCRIPTION	DATE	DESCRIPTION	NICHOLAS JOHN CLAVELLO P.E. LICENSE NUMBER: 84366 SCALAR CONSULTING GROUP, LLC. 5713 CORPORATE WAY, SUITE 200 WEST PALM BEACH, FLORIDA 33407		ROAD NO.	COUNTY		
						SR 70	HIGHLANDS OKEECHOBEE	FINANCIAL PROJECT ID 450334-1-22-01	

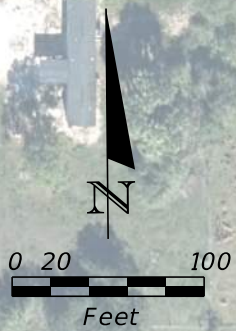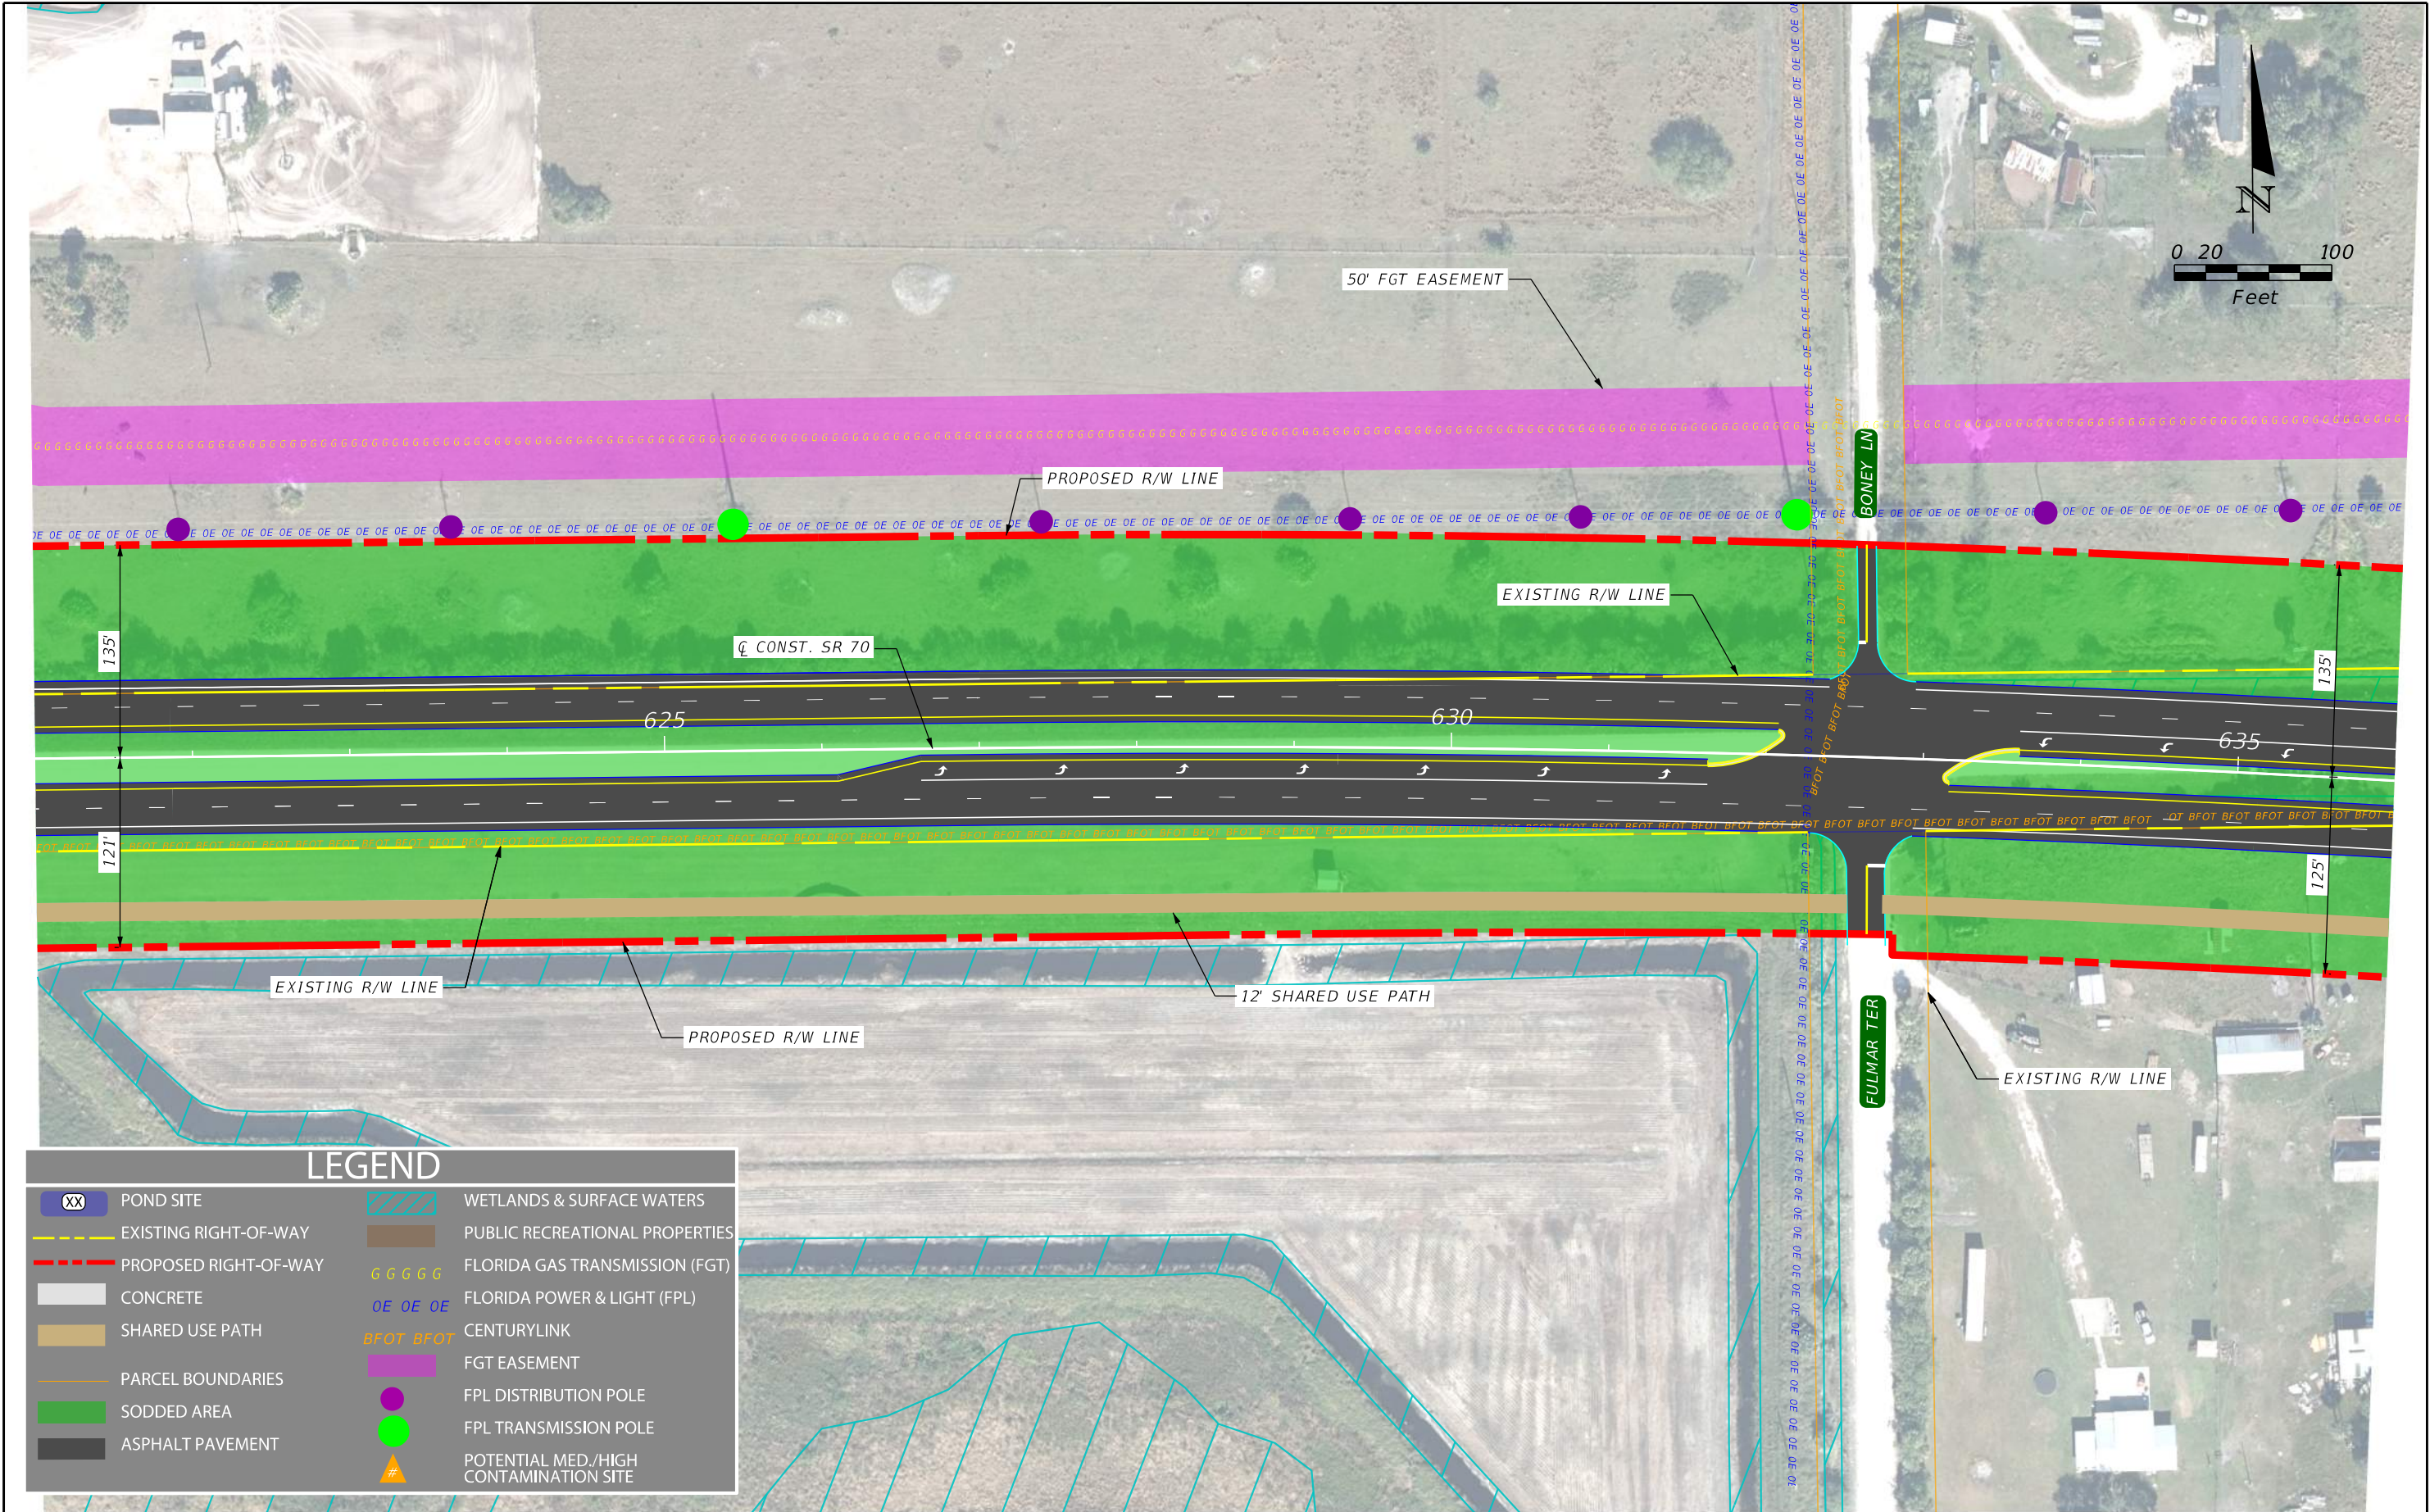


LEGEND			
	POND SITE		WETLANDS & SURFACE WATERS
	EXISTING RIGHT-OF-WAY		PUBLIC RECREATIONAL PROPERTIES
	PROPOSED RIGHT-OF-WAY		FLORIDA GAS TRANSMISSION (FGT)
	CONCRETE		FLORIDA POWER & LIGHT (FPL)
	SHARED USE PATH		CENTURYLINK
	PARCEL BOUNDARIES		FGT EASEMENT
	SODDED AREA		FPL DISTRIBUTION POLE
	ASPHALT PAVEMENT		FPL TRANSMISSION POLE
			POTENTIAL MED./HIGH CONTAMINATION SITE

REVISIONS				ENGINEER OF RECORD		STATE OF FLORIDA DEPARTMENT OF TRANSPORTATION		ALTERNATIVE 1 CONCEPT PLAN	SHEET NO. 17
DATE	DESCRIPTION	DATE	DESCRIPTION	NICHOLAS JOHN CLAVELO P.E. LICENSE NUMBER: 84366 SCALAR CONSULTING GROUP, LLC. 5713 CORPORATE WAY, SUITE 200 WEST PALM BEACH, FLORIDA 33407		ROAD NO.	COUNTY		
						SR 70	HIGHLANDS OKEECHOBEE	FINANCIAL PROJECT ID 450334-1-22-01	

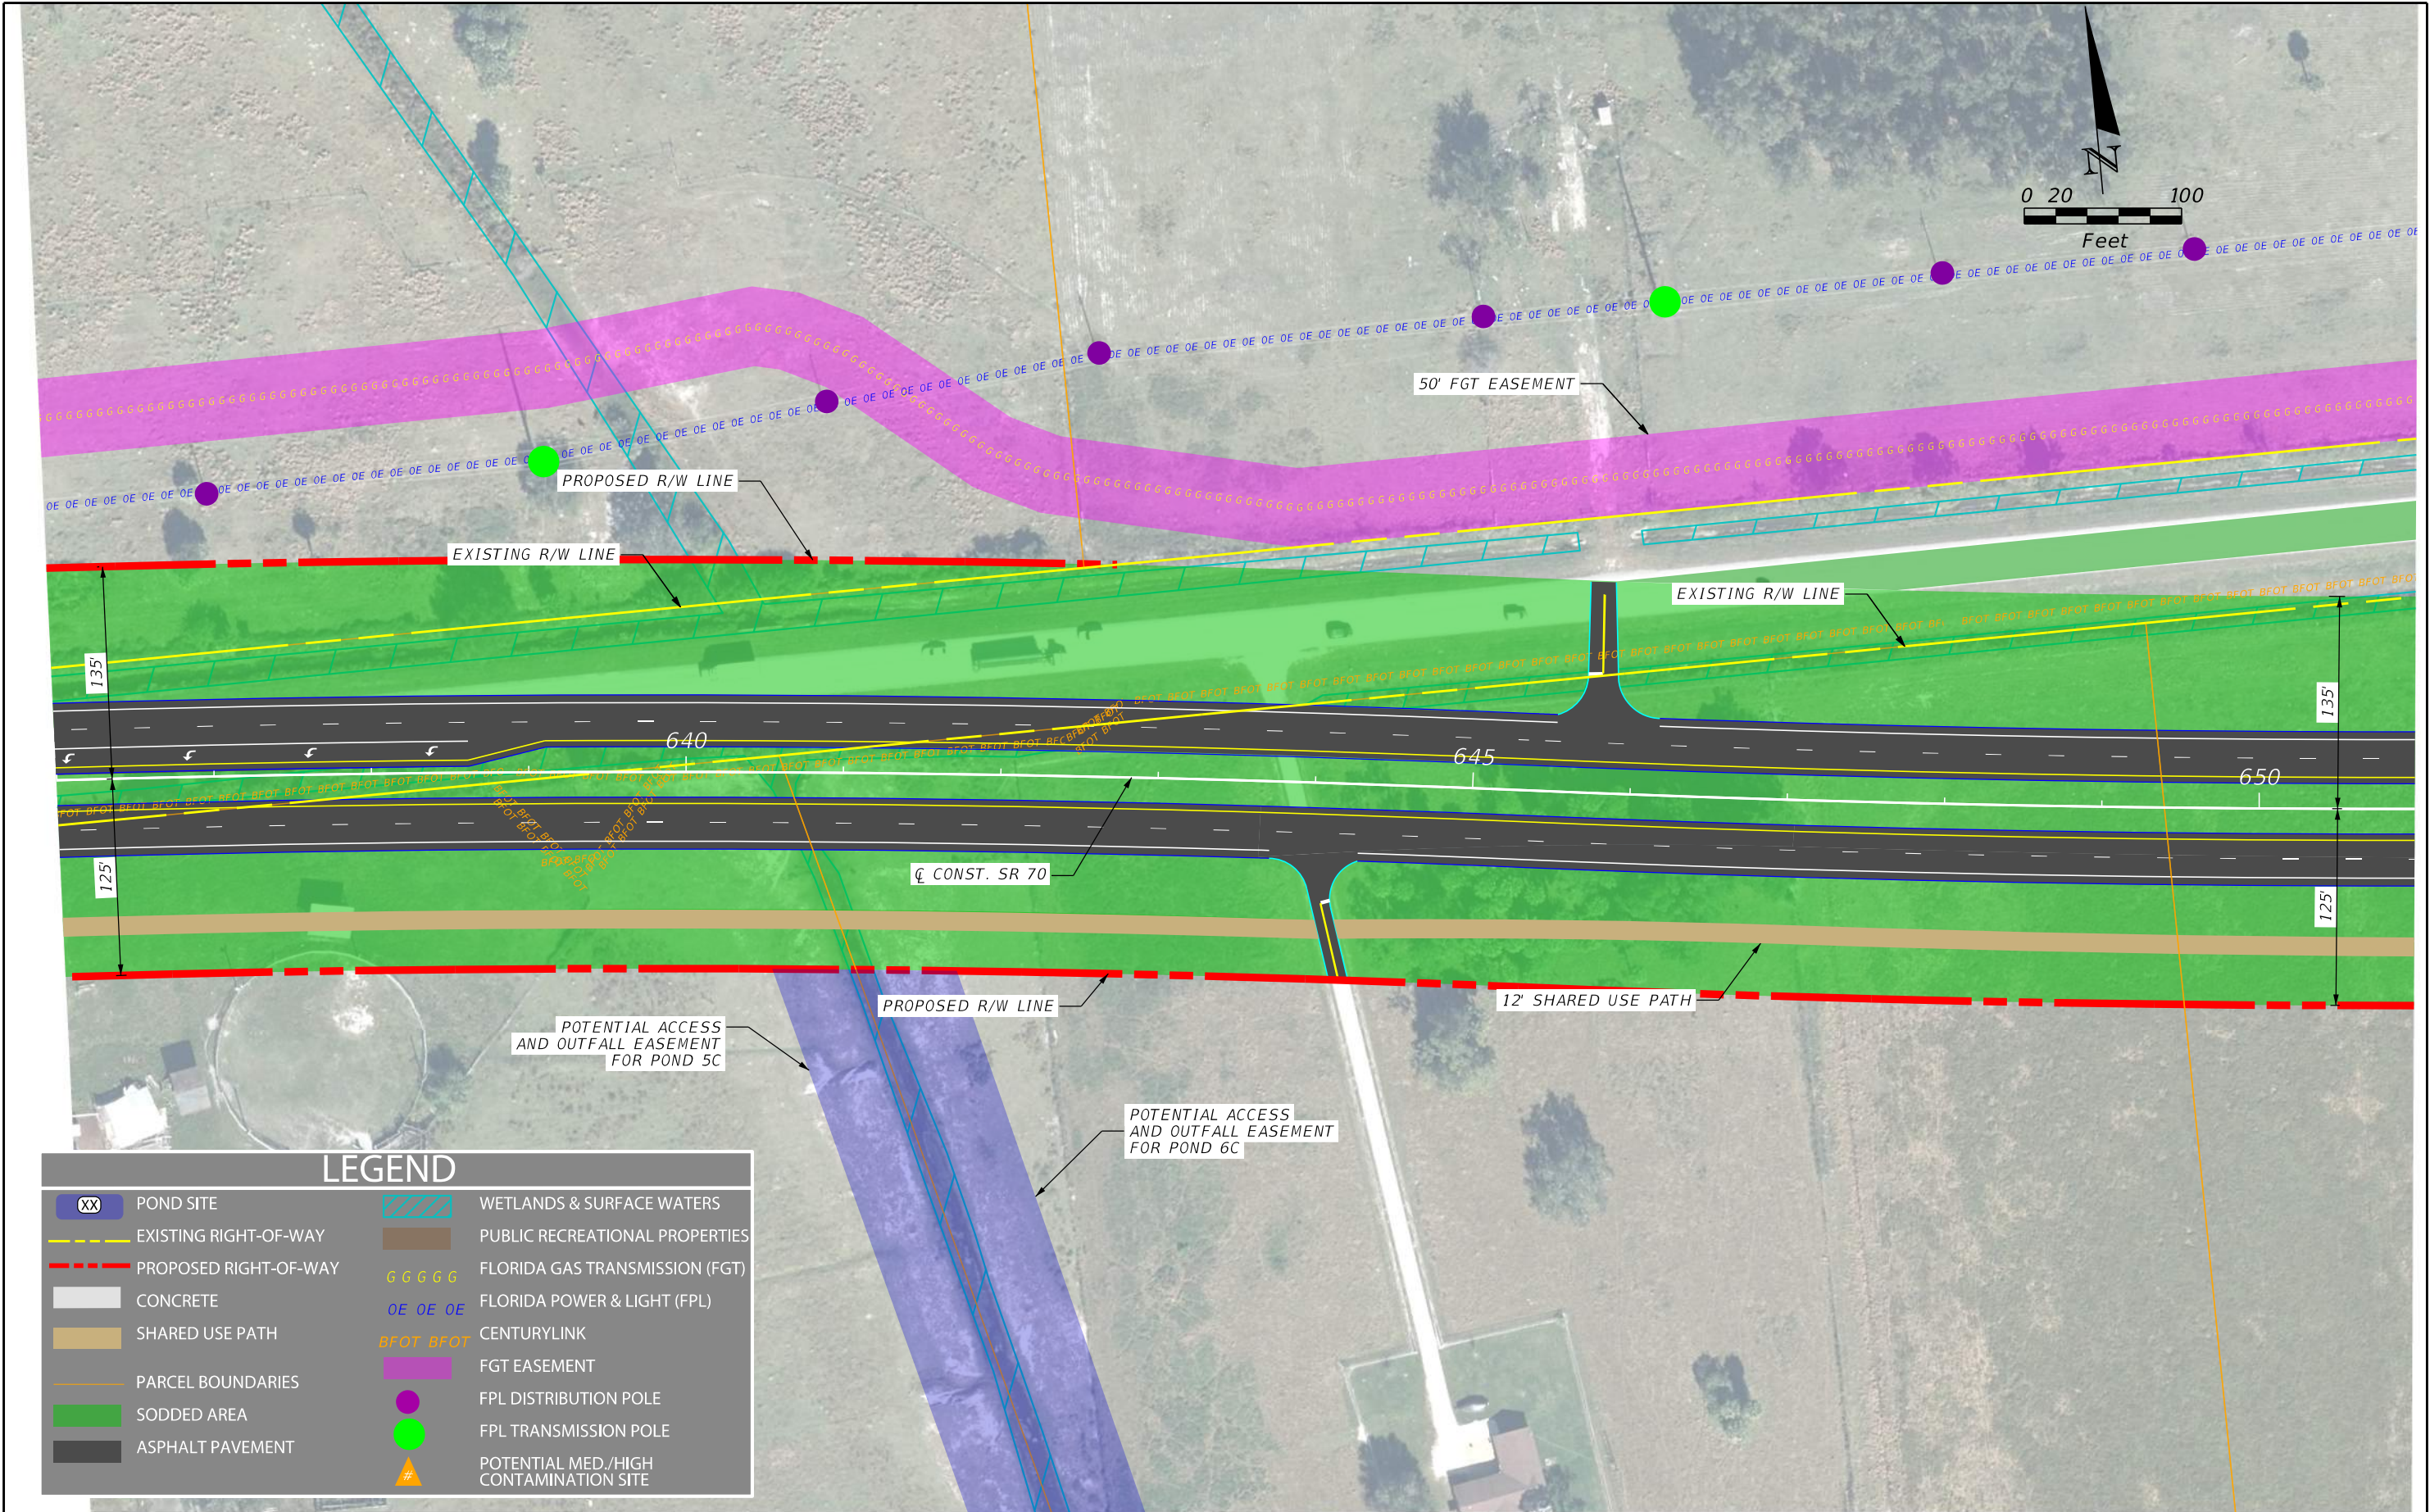


REVISIONS				ENGINEER OF RECORD		STATE OF FLORIDA DEPARTMENT OF TRANSPORTATION		ALTERNATIVE 1 CONCEPT PLAN	SHEET NO. 18
DATE	DESCRIPTION	DATE	DESCRIPTION	NICHOLAS JOHN CLAVELLO P.E. LICENSE NUMBER: 84366 SCALAR CONSULTING GROUP, LLC. 5713 CORPORATE WAY, SUITE 200 WEST PALM BEACH, FLORIDA 33407		ROAD NO.	COUNTY		
						SR 70	HIGHLANDS OKEECHOBEE	FINANCIAL PROJECT ID 450334-1-22-01	

THE OFFICIAL RECORD OF THIS SHEET IS THE ELECTRONIC FILE DIGITALLY SIGNED AND SEALED UNDER RULE 61G15-23.004, F.A.C.

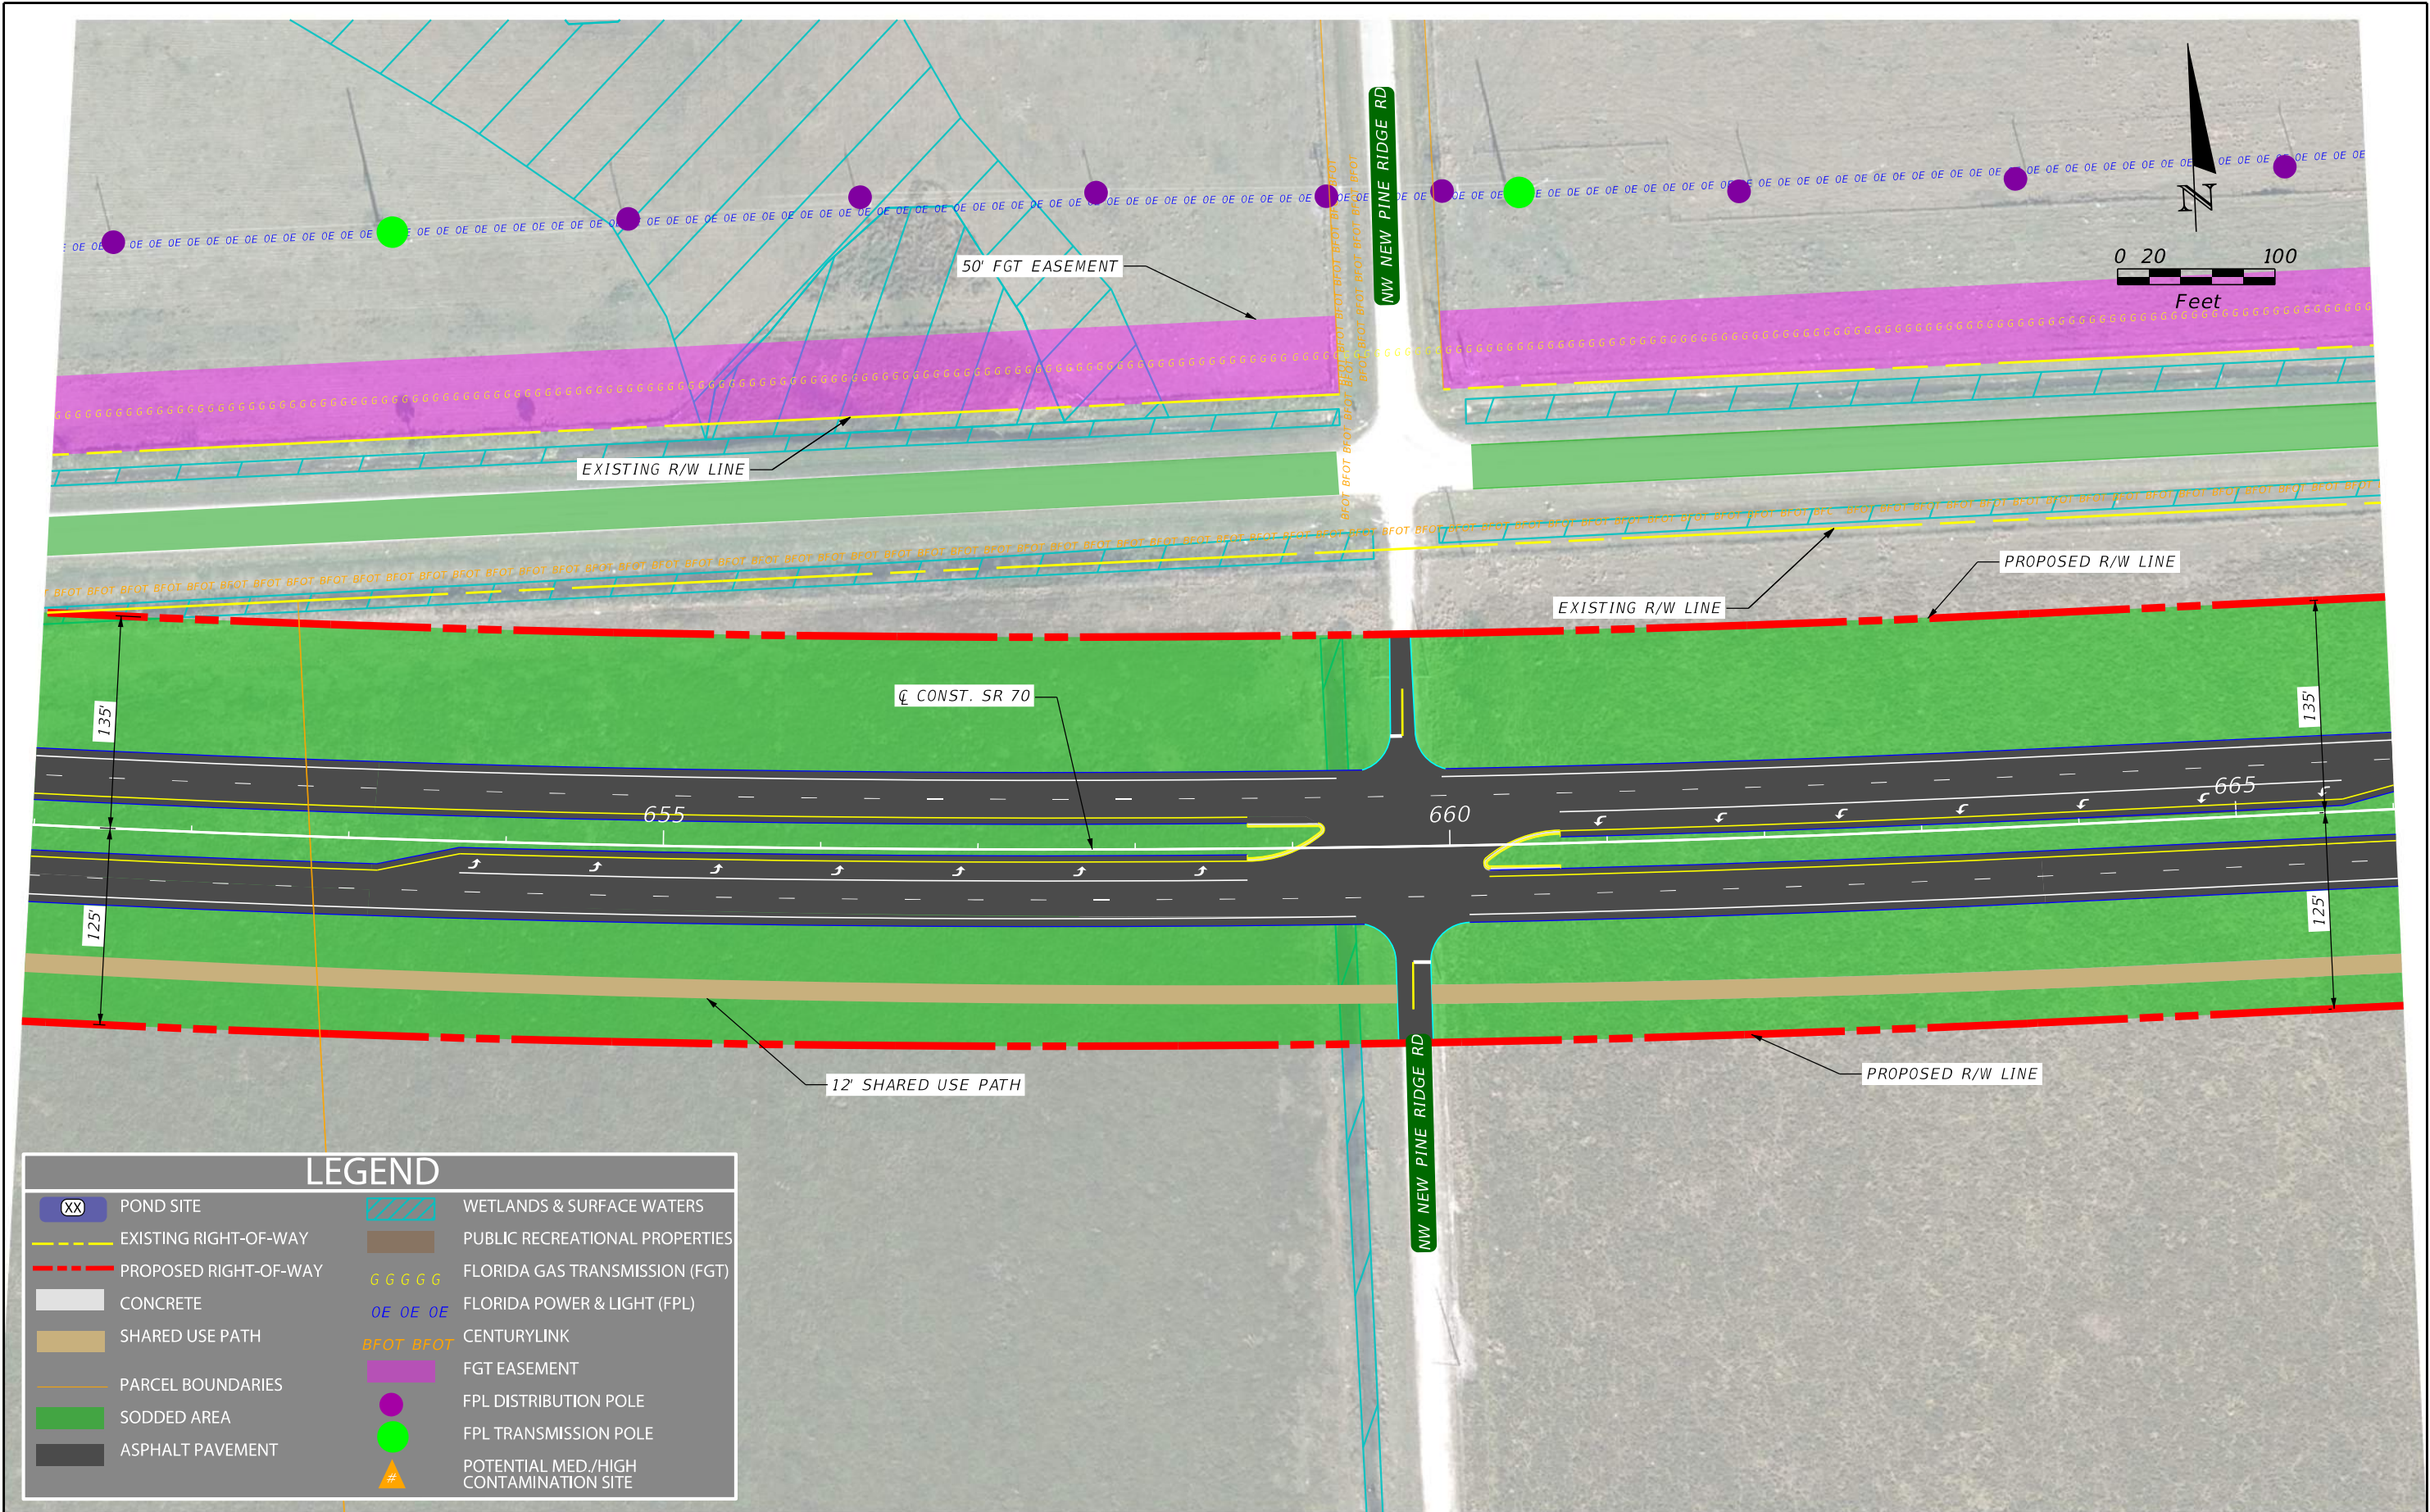

REVISIONS				ENGINEER OF RECORD	STATE OF FLORIDA DEPARTMENT OF TRANSPORTATION			SHEET NO.
DATE	DESCRIPTION	DATE	DESCRIPTION		ROAD NO.	COUNTY	FINANCIAL PROJECT ID	
					SR 70	HIGHLANDS OKEECHOBEE	450334-1-22-01	

ALTERNATIVE 1
CONCEPT PLAN

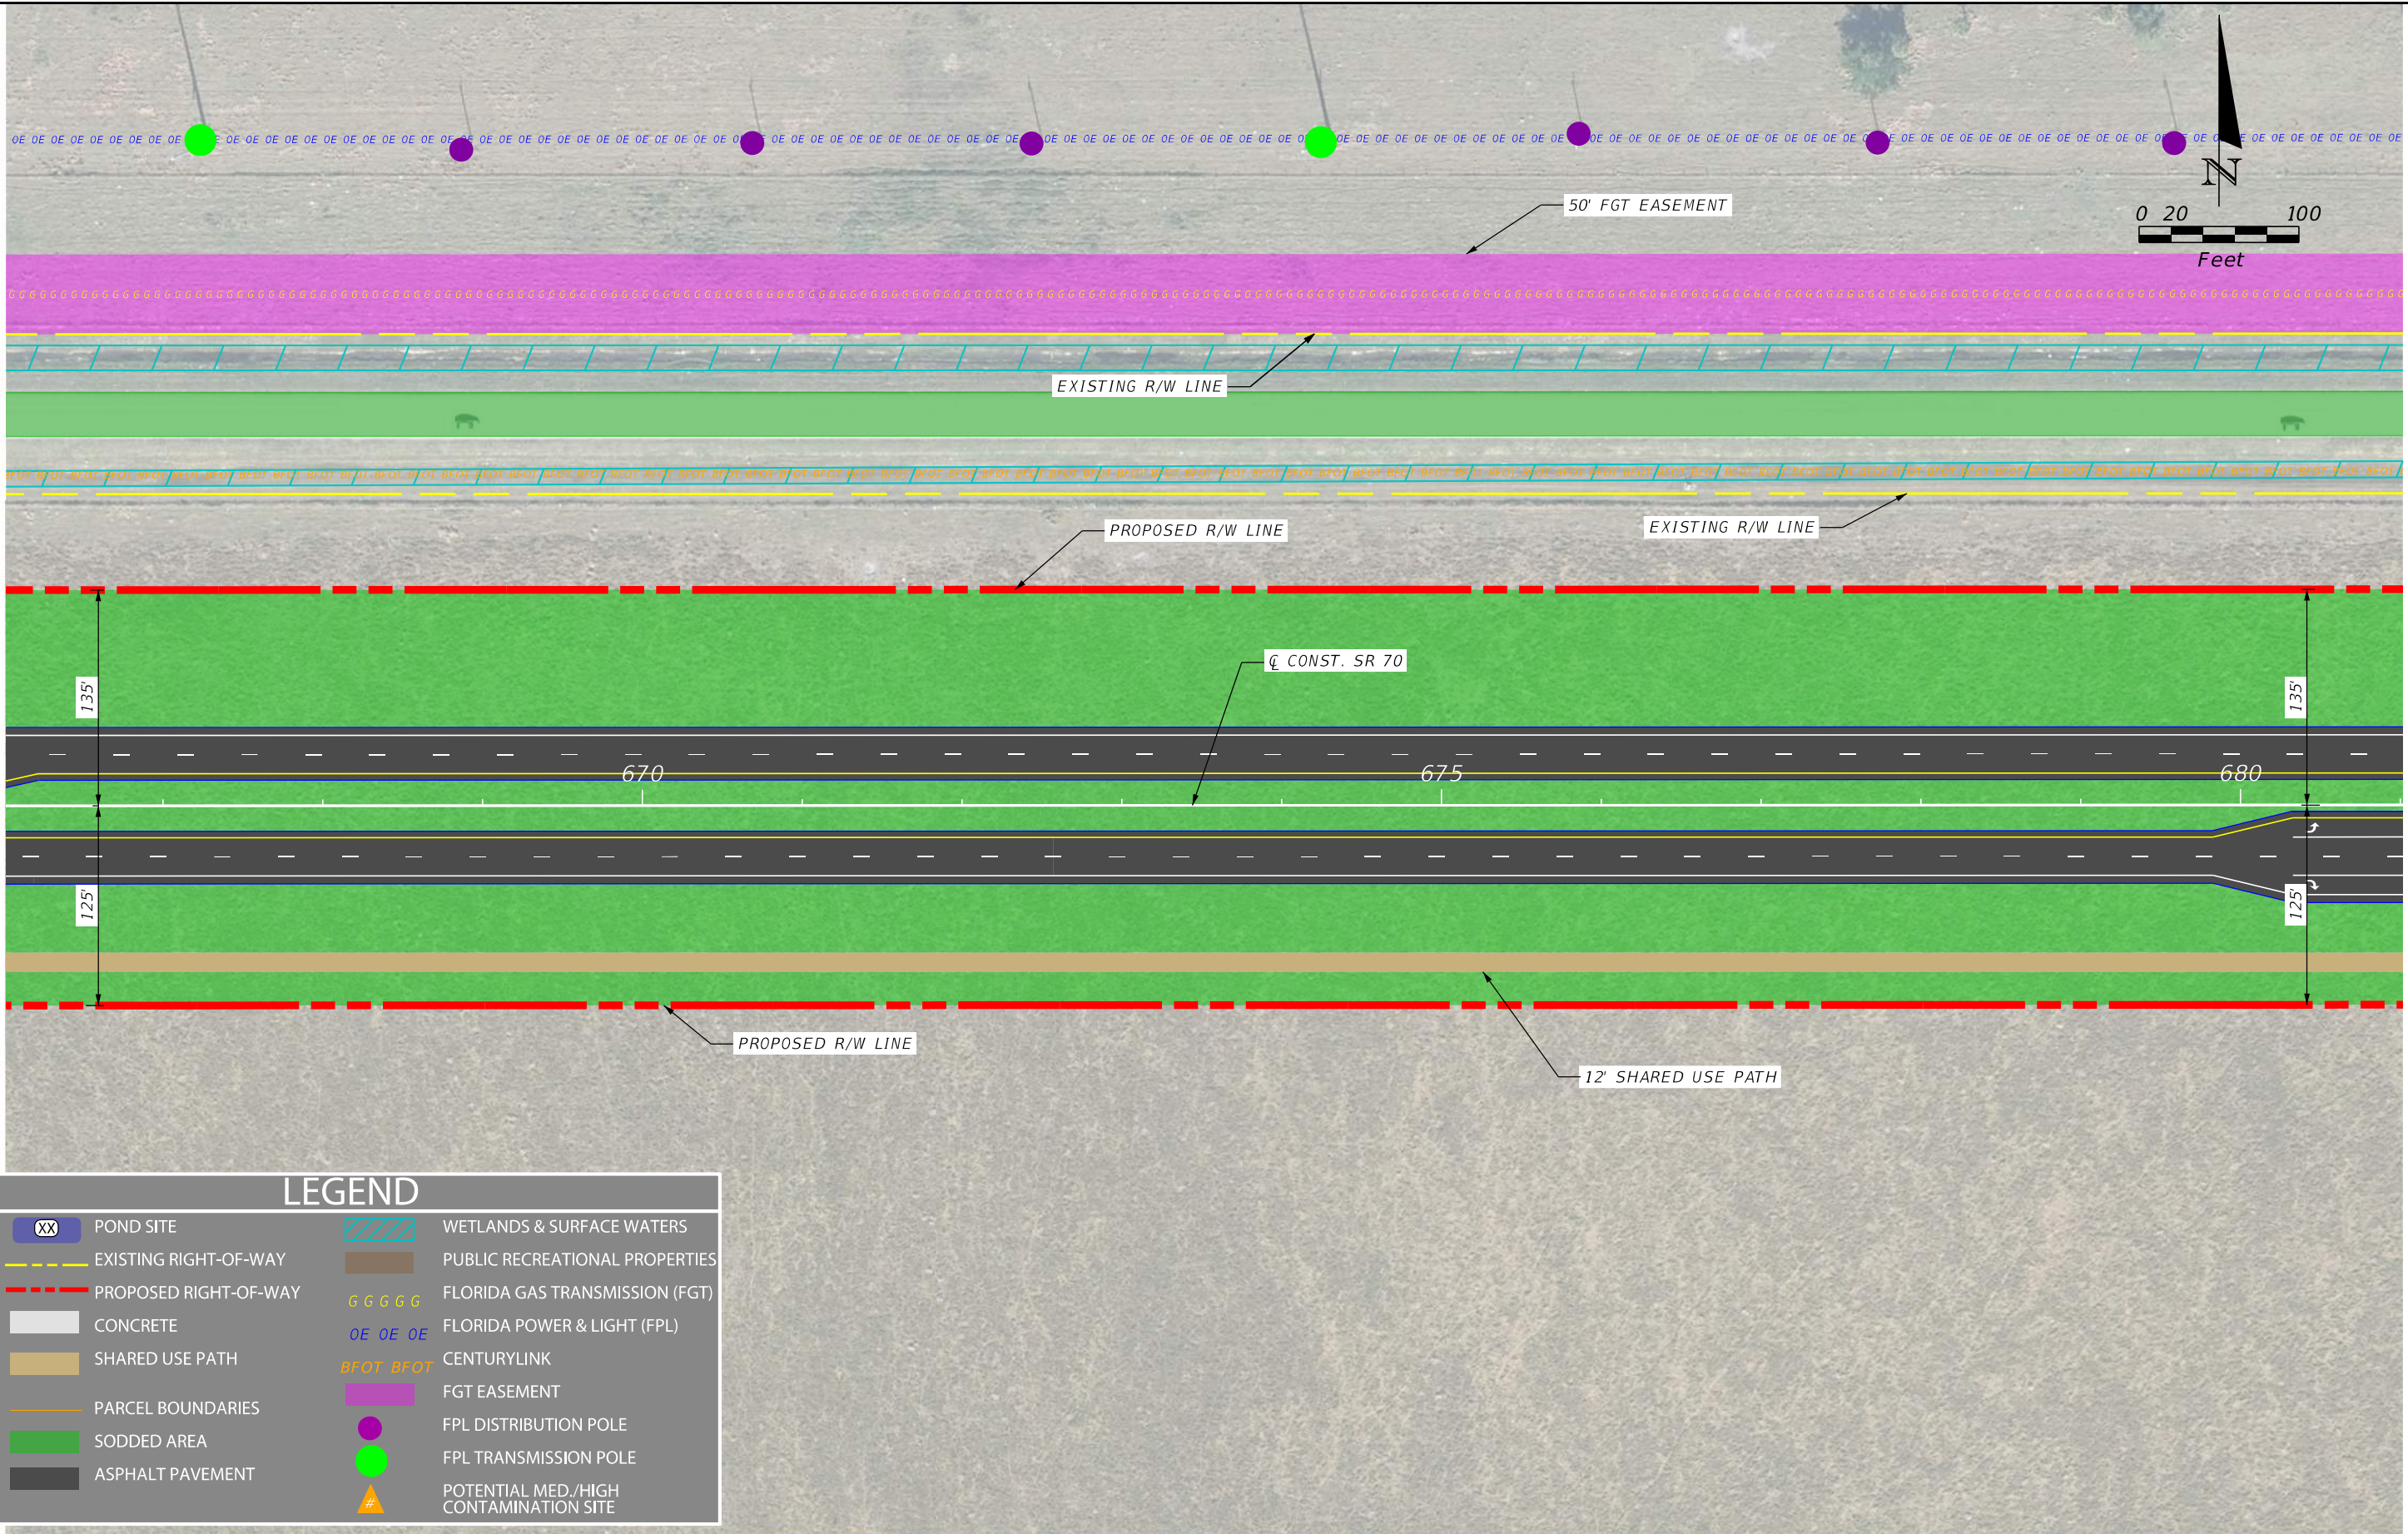

XX

POND SITE

EXISTING RIGHT-OF-WAY

PROPOSED RIGHT-OF-WAY

CONCRETE

SHARED USE PATH

PARCEL BOUNDARIES

SODDED AREA

ASPHALT PAVEMENT

WETLANDS & SURFACE WATERS

PUBLIC RECREATIONAL PROPERTIES

GGGG

FLORIDA GAS TRANSMISSION (FGT)

OE OE OE

FLORIDA POWER & LIGHT (FPL)

BFOI BFOI

CENTURYLINK

FGT EASEMENT

●

FPL DISTRIBUTION POLE

●

FPL TRANSMISSION POLE


▲

POTENTIAL MED./HIGH CONTAMINATION SITE


REVISIONS				ENGINEER OF RECORD			STATE OF FLORIDA DEPARTMENT OF TRANSPORTATION			SHEET NO.
DATE	DESCRIPTION	DATE	DESCRIPTION	NICHOLAS JOHN CLAVELLO P.E. LICENSE NUMBER: 84366 SCALAR CONSULTING GROUP, LLC. 5713 CORPORATE WAY, SUITE 200 WEST PALM BEACH, FLORIDA 33407			ROAD NO.	COUNTY	FINANCIAL PROJECT ID	
							SR 70	HIGHLANDS OKEECHOBEE	450334-1-22-01	

ALTERNATIVE 1
CONCEPT PLAN


THE OFFICIAL RECORD OF THIS SHEET IS THE ELECTRONIC FILE DIGITALLY SIGNED AND SEALED UNDER RULE 61G15-23.004, F.A.C.

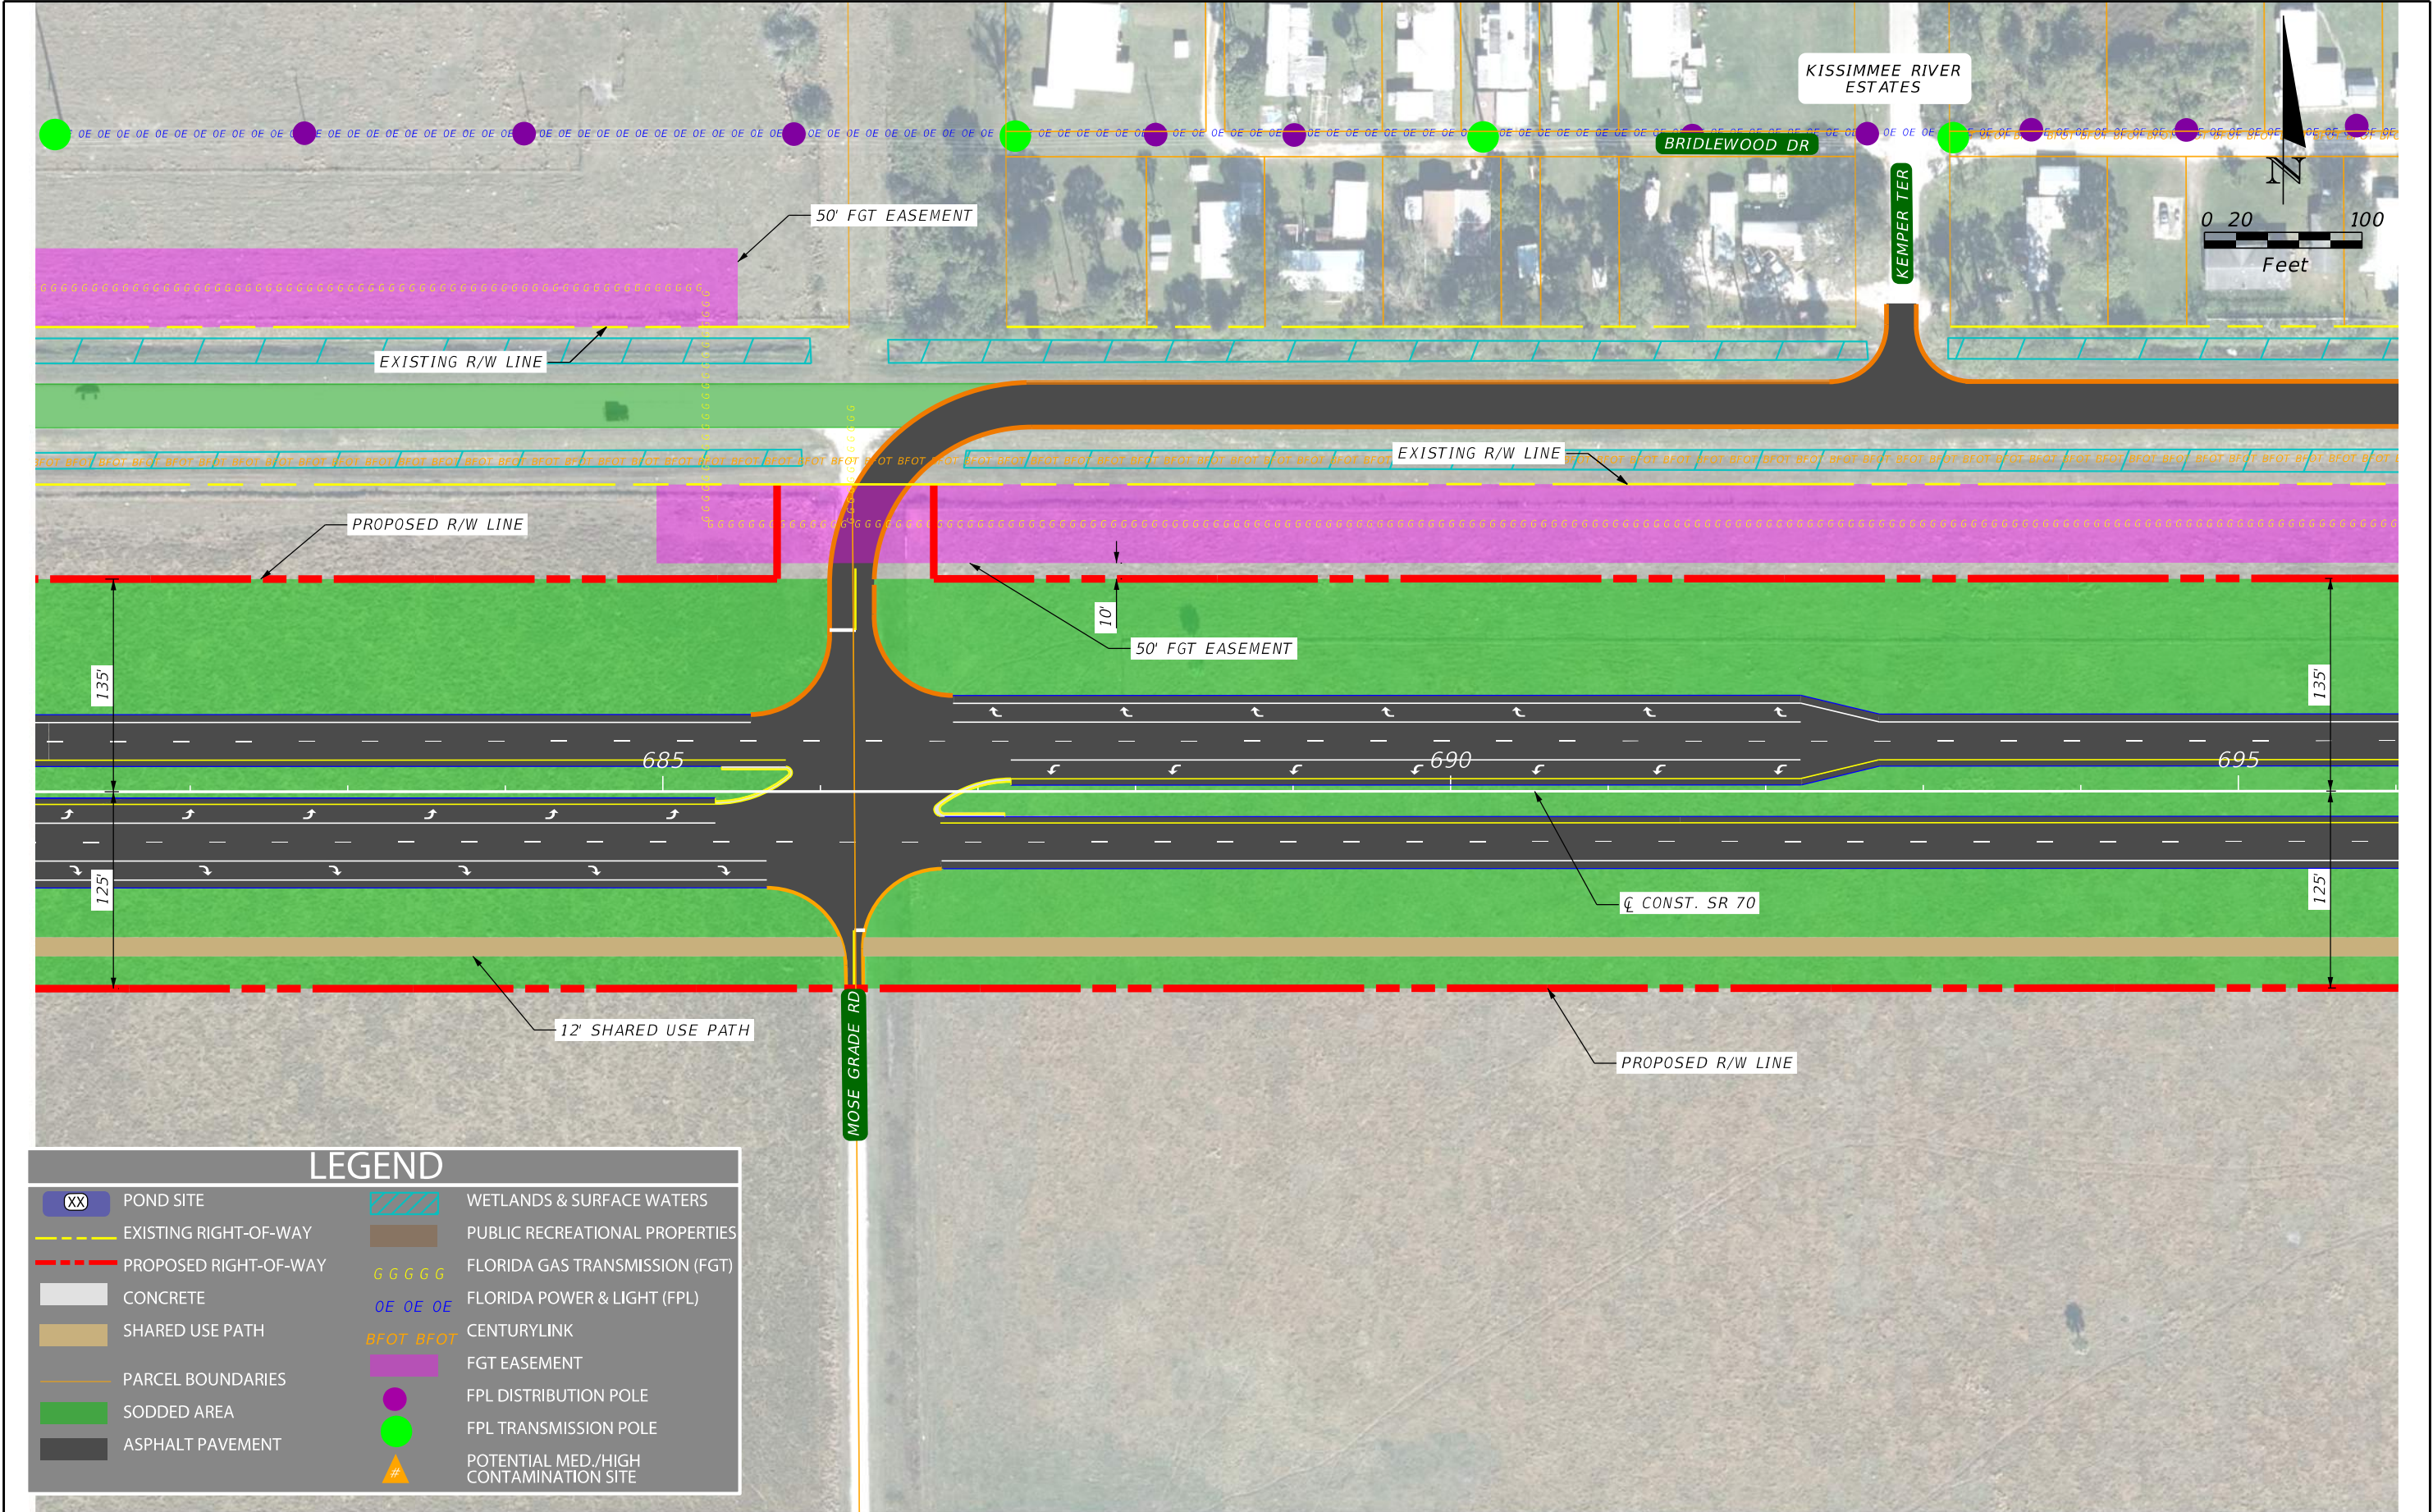

REVISIONS				ENGINEER OF RECORD		STATE OF FLORIDA DEPARTMENT OF TRANSPORTATION		ALTERNATIVE 1 CONCEPT PLAN	SHEET NO. 21
DATE	DESCRIPTION	DATE	DESCRIPTION	NICHOLAS JOHN CLAVELLO P.E. LICENSE NUMBER: 84366 SCALAR CONSULTING GROUP, LLC. 5713 CORPORATE WAY, SUITE 200 WEST PALM BEACH, FLORIDA 33407		ROAD NO.	COUNTY		
						SR 70	HIGHLANDS OKEECHOBEE	FINANCIAL PROJECT ID 450334-1-22-01	

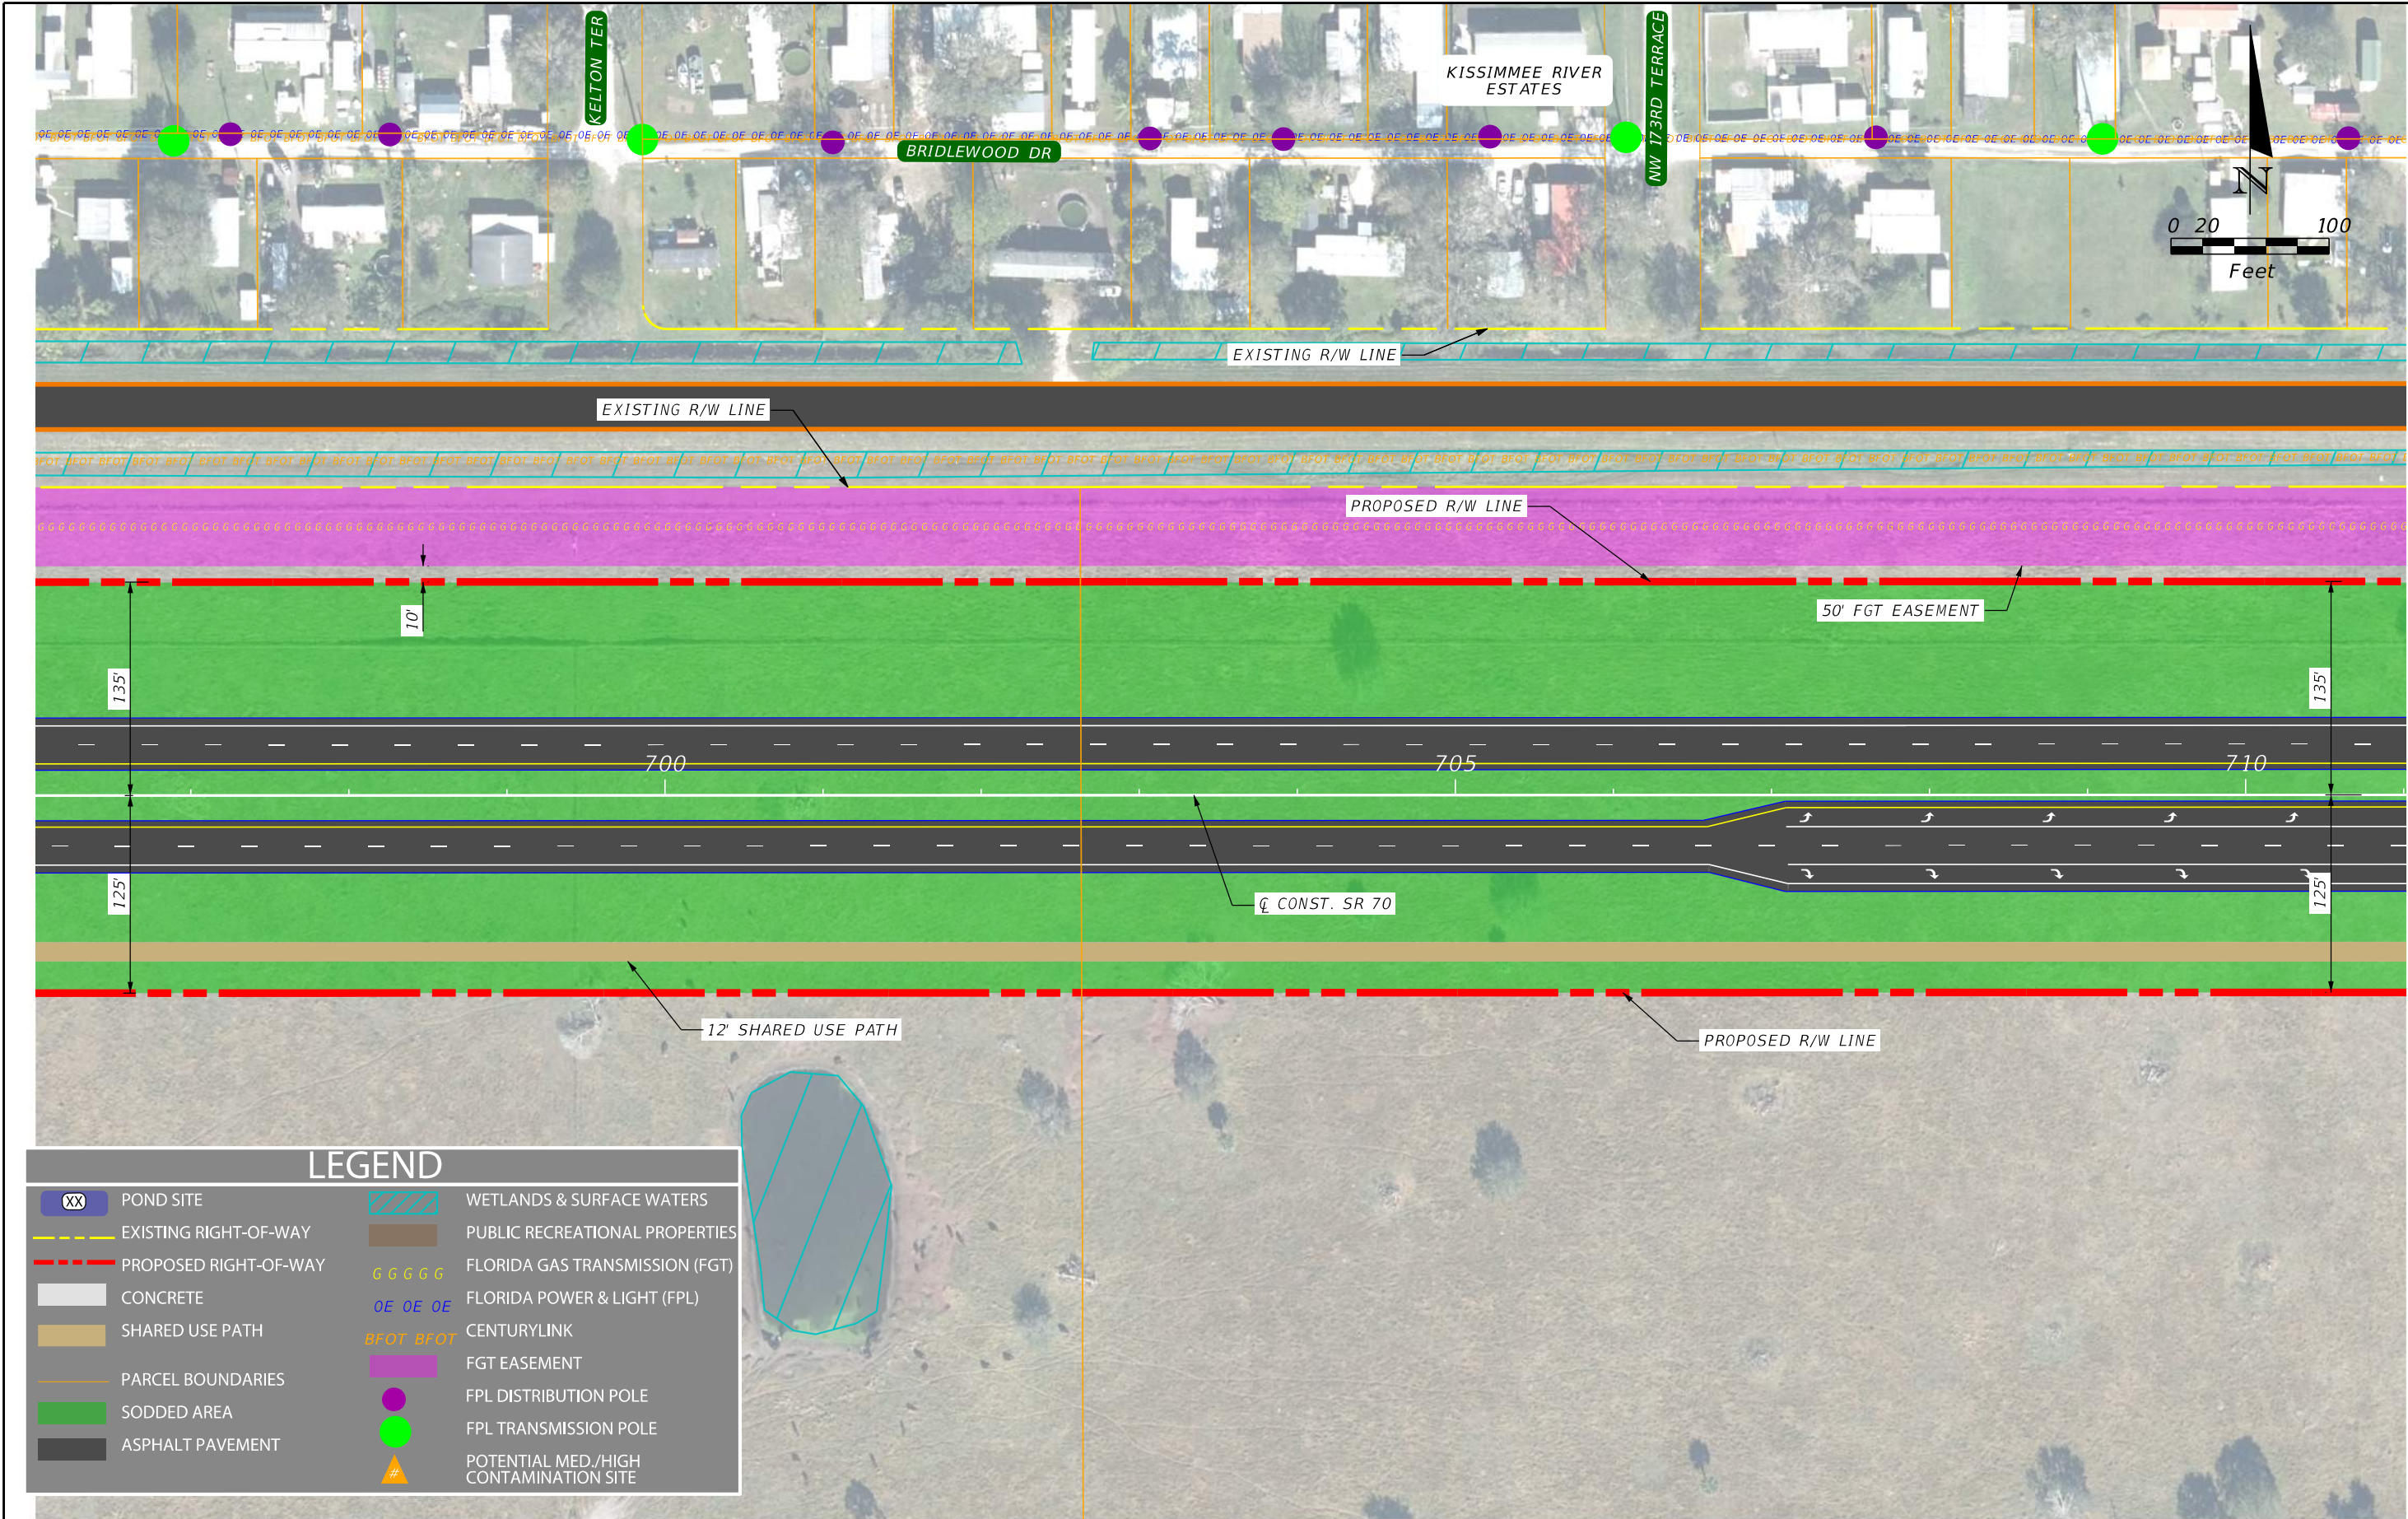

REVISIONS				ENGINEER OF RECORD		STATE OF FLORIDA DEPARTMENT OF TRANSPORTATION		ALTERNATIVE 1 CONCEPT PLAN	SHEET NO. 22
DATE	DESCRIPTION	DATE	DESCRIPTION	NICHOLAS JOHN CLAVEL0 P.E. LICENSE NUMBER: 84366 SCALAR CONSULTING GROUP, LLC. 5713 CORPORATE WAY, SUITE 200 WEST PALM BEACH, FLORIDA 33407		ROAD NO.	COUNTY		
						SR 70	HIGHLANDS OKEECHOBEE	FINANCIAL PROJECT ID 450334-1-22-01	

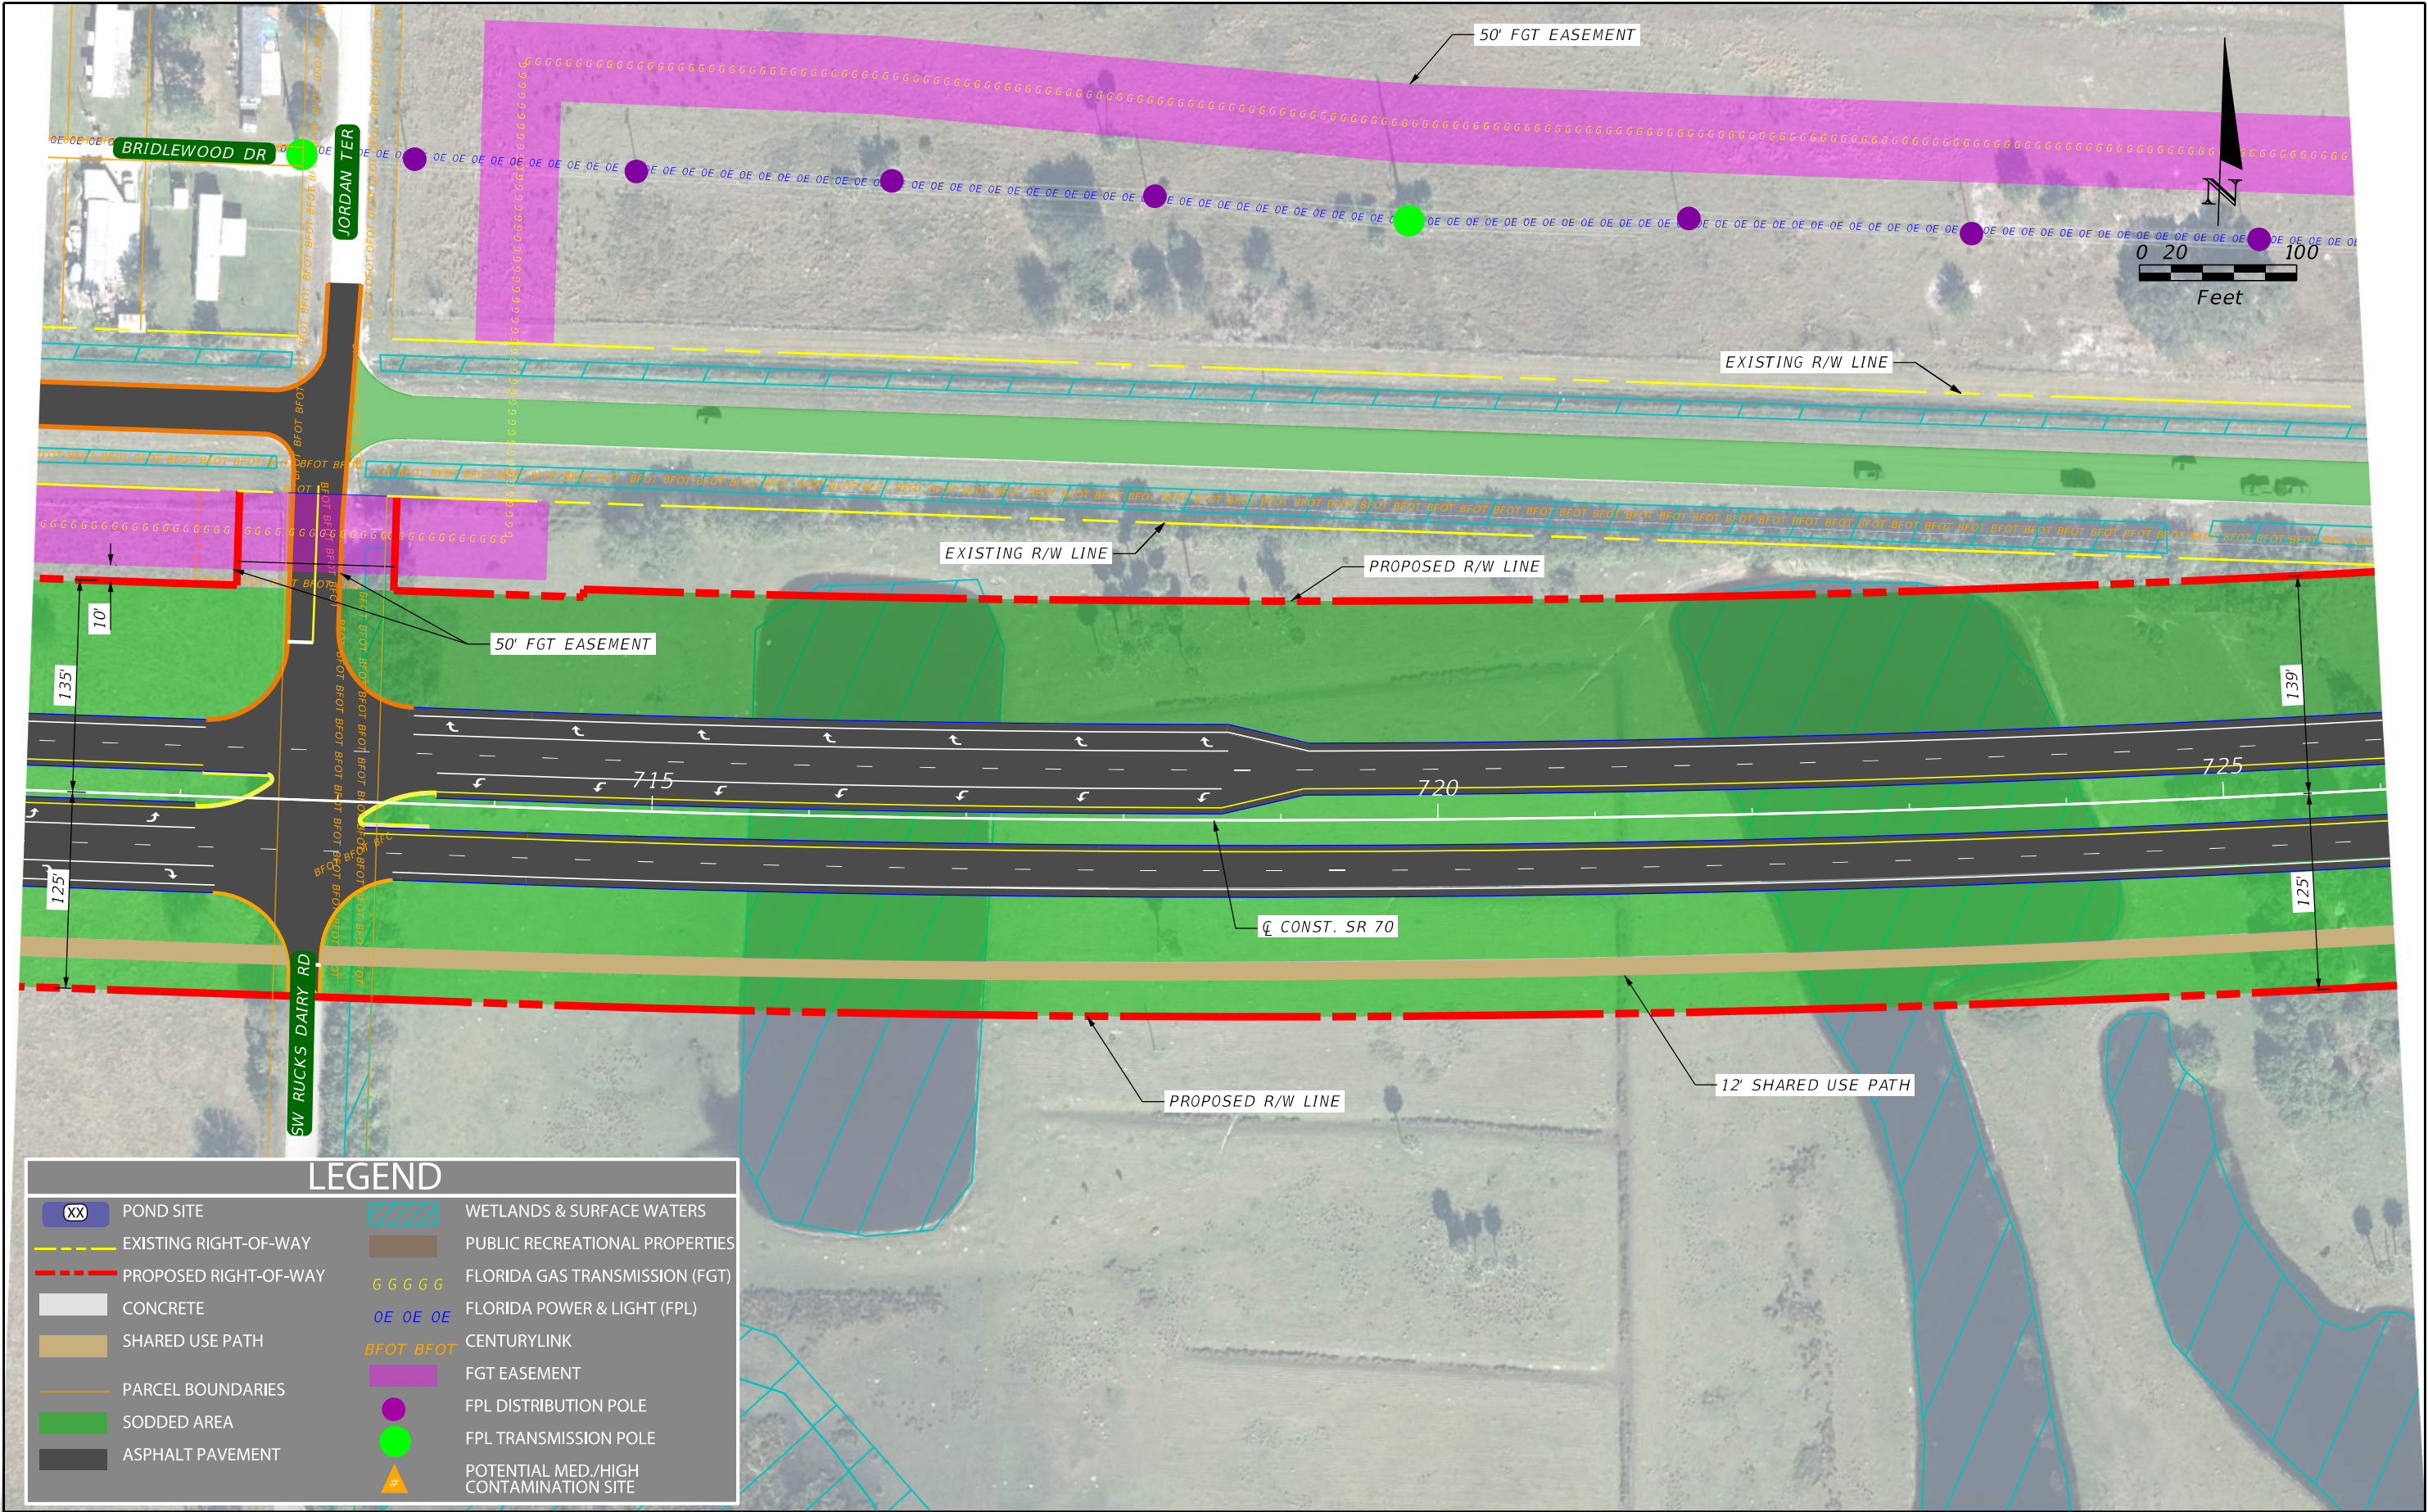

LEGEND

XX

POND SITE

EXISTING RIGHT-OF-WAY

PROPOSED RIGHT-OF-WAY

CONCRETE

SHARED USE PATH

PARCEL BOUNDARIES

SODDED AREA

ASPHALT PAVEMENT

WETLANDS & SURFACE WATERS

PUBLIC RECREATIONAL PROPERTIES

GGGGG

FLORIDA GAS TRANSMISSION (FGT)

OE OE OE

FLORIDA POWER & LIGHT (FPL)

BFOT BFOT

CENTURYLINK

FGT EASEMENT

FPL DISTRIBUTION POLE



FPL TRANSMISSION POLE

POTENTIAL MED./HIGH CONTAMINATION SITE

REVISIONS				ENGINEER OF RECORD		STATE OF FLORIDA DEPARTMENT OF TRANSPORTATION		ALTERNATIVE 1 CONCEPT PLAN	SHEET NO. 23
DATE	DESCRIPTION	DATE	DESCRIPTION	NICHOLAS JOHN CLAVELO P.E. LICENSE NUMBER: 84366 SCALAR CONSULTING GROUP, LLC. 5713 CORPORATE WAY, SUITE 200 WEST PALM BEACH, FLORIDA 33407		ROAD NO.	COUNTY		
						SR 70	HIGHLANDS OKEECHOBEE	FINANCIAL PROJECT ID 450334-1-22-01	

P:\FL23010.00 SR 70 PD&E Study\45033412201\roadway\PLANRD01.dgn : CL11 - PLAN 23 [SHEET]
Jarechavaleta 10/7/2025 8:35:07 AM

THE OFFICIAL RECORD OF THIS SHEET IS THE ELECTRONIC FILE DIGITALLY SIGNED AND SEALED UNDER RULE 61G15-23.004, F.A.C.

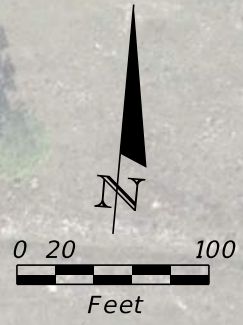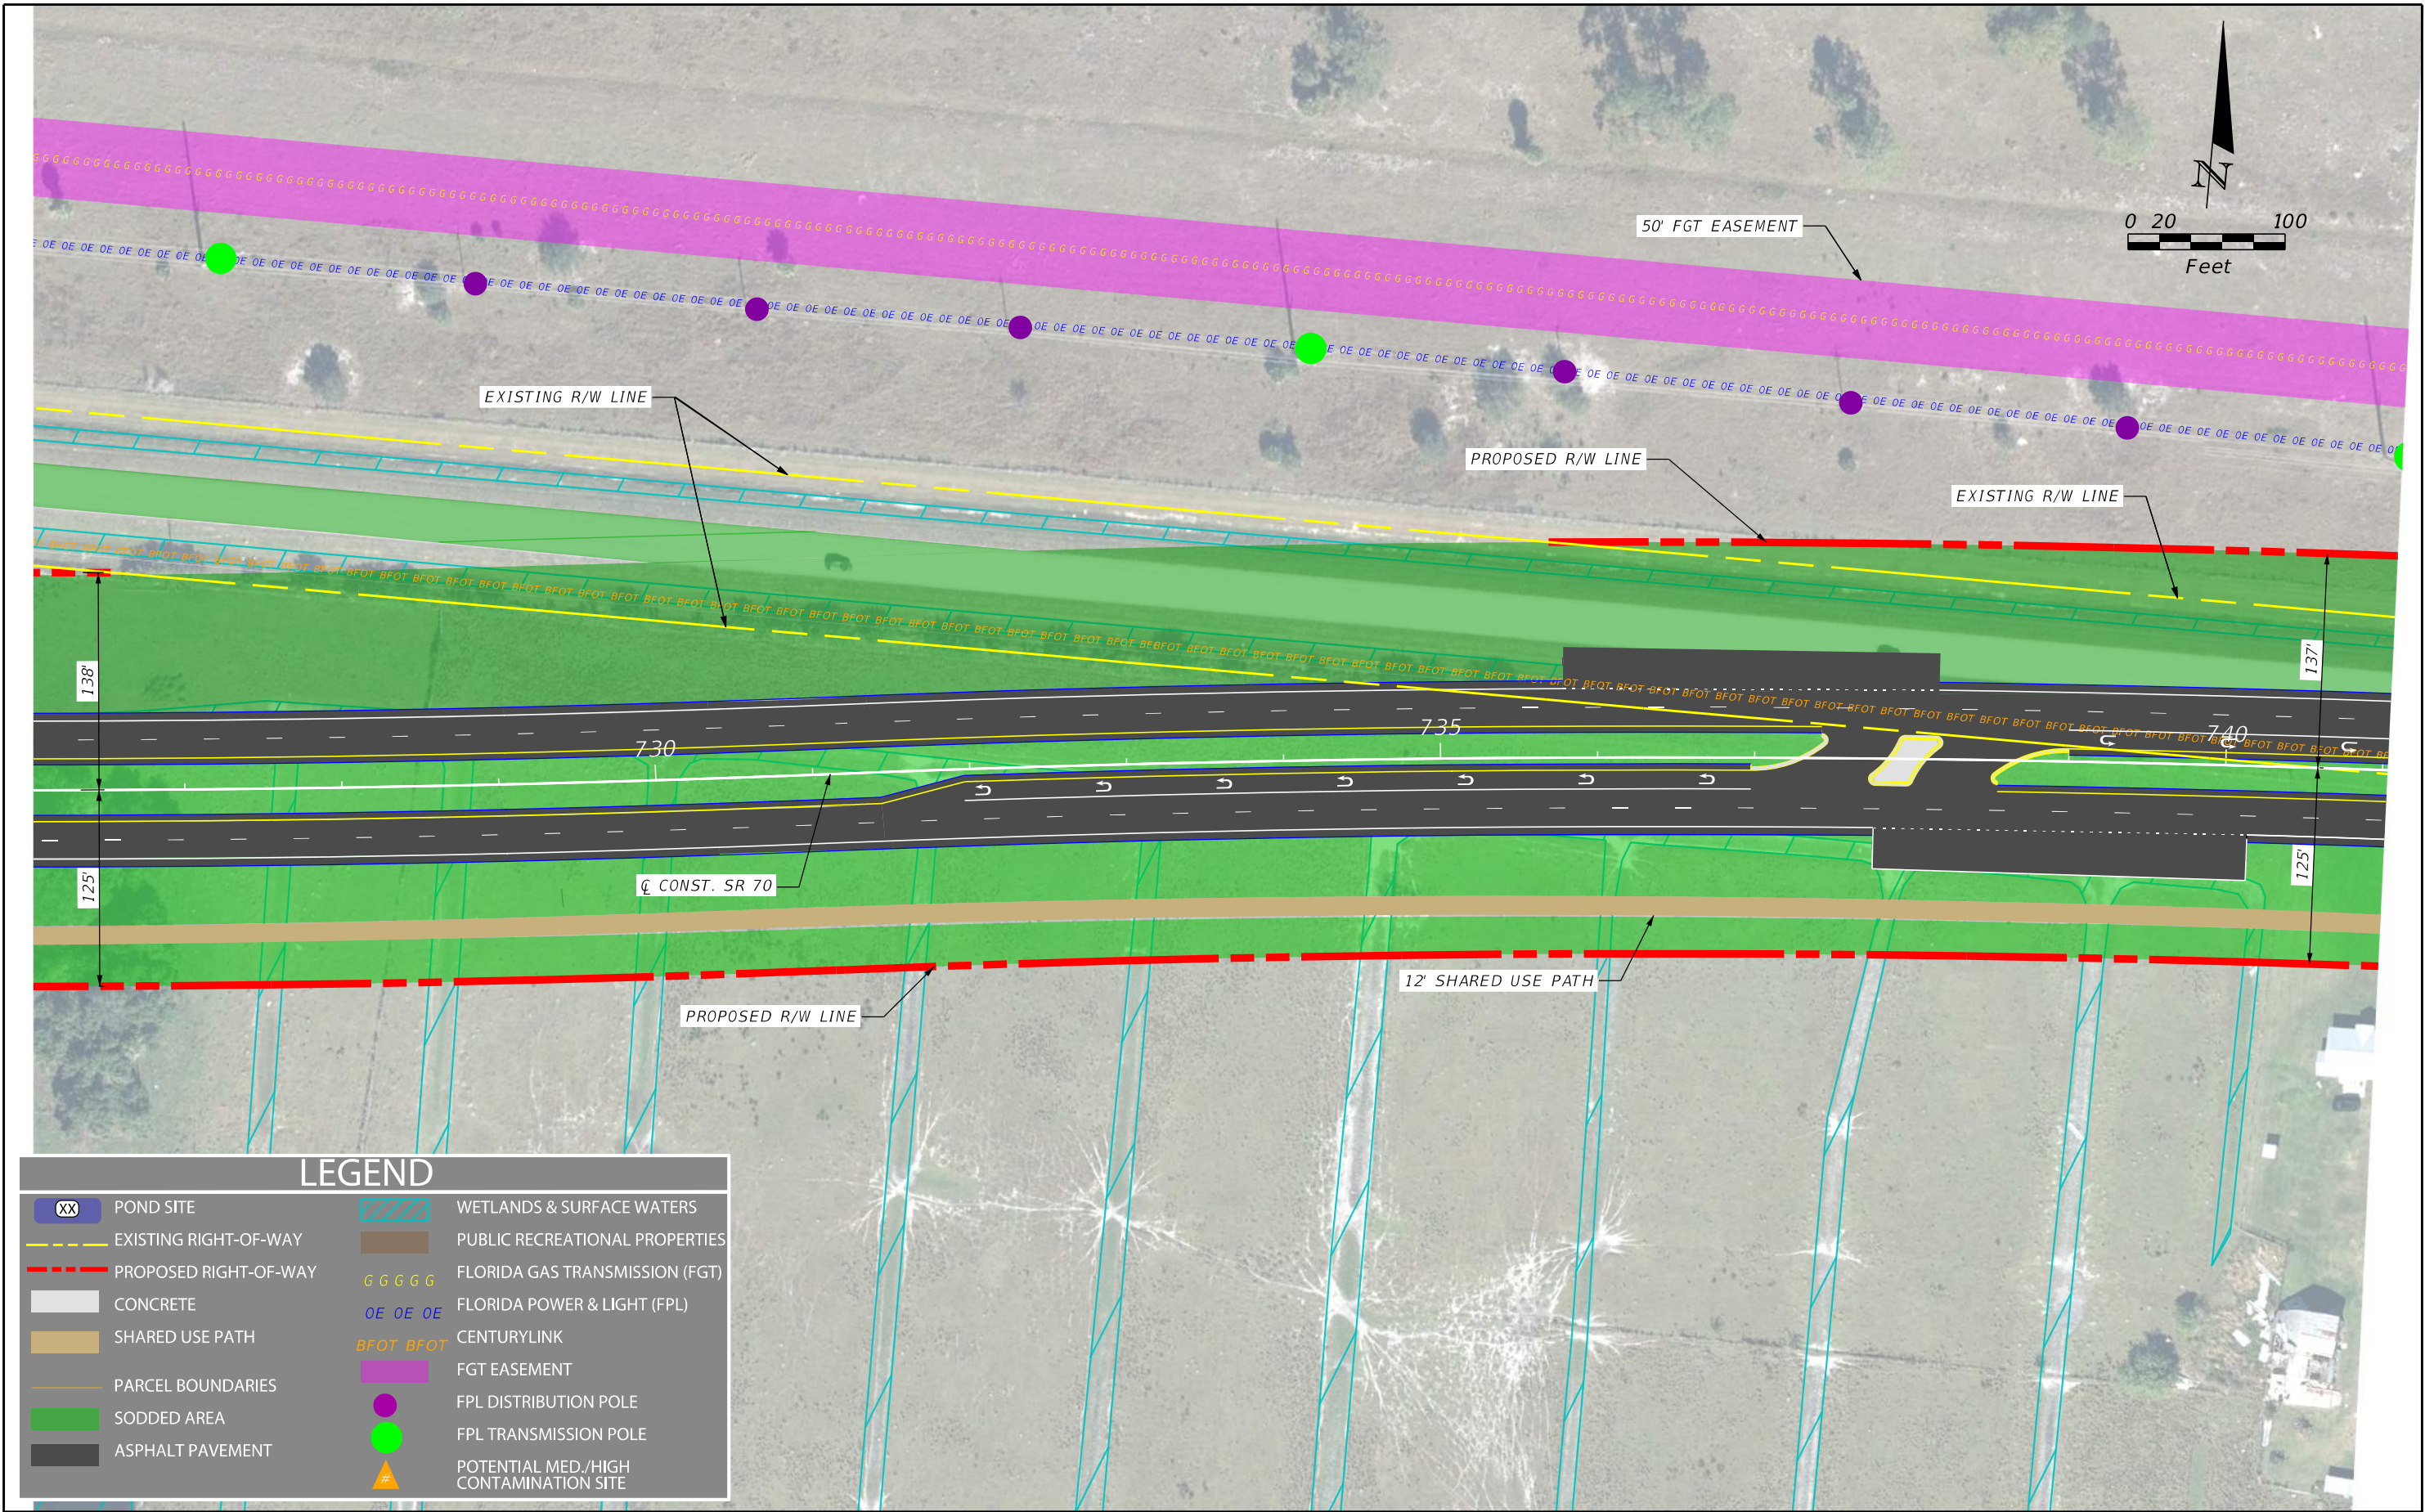

LEGEND

XX

POND SITE

EXISTING RIGHT-OF-WAY

PROPOSED RIGHT-OF-WAY

CONCRETE

SHARED USE PATH

PARCEL BOUNDARIES

SODDED AREA

ASPHALT PAVEMENT

WETLANDS & SURFACE WATERS

PUBLIC RECREATIONAL PROPERTIES

FLORIDA GAS TRANSMISSION (FGT)

FLORIDA POWER & LIGHT (FPL)

CENTURYLINK

FGT EASEMENT

●

FPL DISTRIBUTION POLE

●

FPL TRANSMISSION POLE

▲

POTENTIAL MED./HIGH CONTAMINATION SITE


REVISIONS				ENGINEER OF RECORD	STATE OF FLORIDA DEPARTMENT OF TRANSPORTATION			ALTERNATIVE 1 CONCEPT PLAN	SHEET NO.
DATE	DESCRIPTION	DATE	DESCRIPTION		ROAD NO.	COUNTY	FINANCIAL PROJECT ID		
					SR 70	HIGHLANDS OKEECHOBEE	450334-1-22-01	24	

NICHOLAS JOHN CLAVELO P.E.
LICENSE NUMBER: 84366
SCALAR CONSULTING GROUP, LLC.
5713 CORPORATE WAY, SUITE 200
WEST PALM BEACH, FLORIDA 33407

P:\FL23010.00 SR 70 PD&E Study\45033412201\roadway\PLANRD01.dgn : CL11 - PLAN 24 [SHEET]
Jarechavaleta 10/7/2025 8:35:22 AM

THE OFFICIAL RECORD OF THIS SHEET IS THE ELECTRONIC FILE DIGITALLY SIGNED AND SEALED UNDER RULE 61G15-23.004, F.A.C.

7A

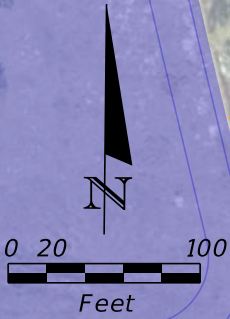

POTENTIAL ACCESS
AND OUTFALL EASEMENT
FOR POND 7A

50' FGT EASEMENT

PROPOSED R/W LINE

EXISTING R/W LINE

CL CONST. SR 70

EXISTING R/W LINE


12' SHARED USE PATH

END TYPICAL
SECTION 1
BEGIN TYPICAL
SECTION 2

LEGEND

POND SITE	WETLANDS & SURFACE WATERS
EXISTING RIGHT-OF-WAY	PUBLIC RECREATIONAL PROPERTIES
PROPOSED RIGHT-OF-WAY	FLORIDA GAS TRANSMISSION (FGT)
CONCRETE	FLORIDA POWER & LIGHT (FPL)
SHARED USE PATH	CENTURYLINK
PARCEL BOUNDARIES	FGT EASEMENT
SODDED AREA	FPL DISTRIBUTION POLE
ASPHALT PAVEMENT	FPL TRANSMISSION POLE
	POTENTIAL MED./HIGH CONTAMINATION SITE

REVISIONS				ENGINEER OF RECORD			STATE OF FLORIDA DEPARTMENT OF TRANSPORTATION			ALTERNATIVE 1 CONCEPT PLAN	SHEET NO. 25
DATE	DESCRIPTION	DATE	DESCRIPTION	NICHOLAS JOHN CLAVELO P.E. LICENSE NUMBER: 84366 SCALAR CONSULTING GROUP, LLC. 5713 CORPORATE WAY, SUITE 200 WEST PALM BEACH, FLORIDA 33407			ROAD NO.	COUNTY	FINANCIAL PROJECT ID		
							SR 70	HIGHLANDS OKEECHOBEE	450334-1-22-01		

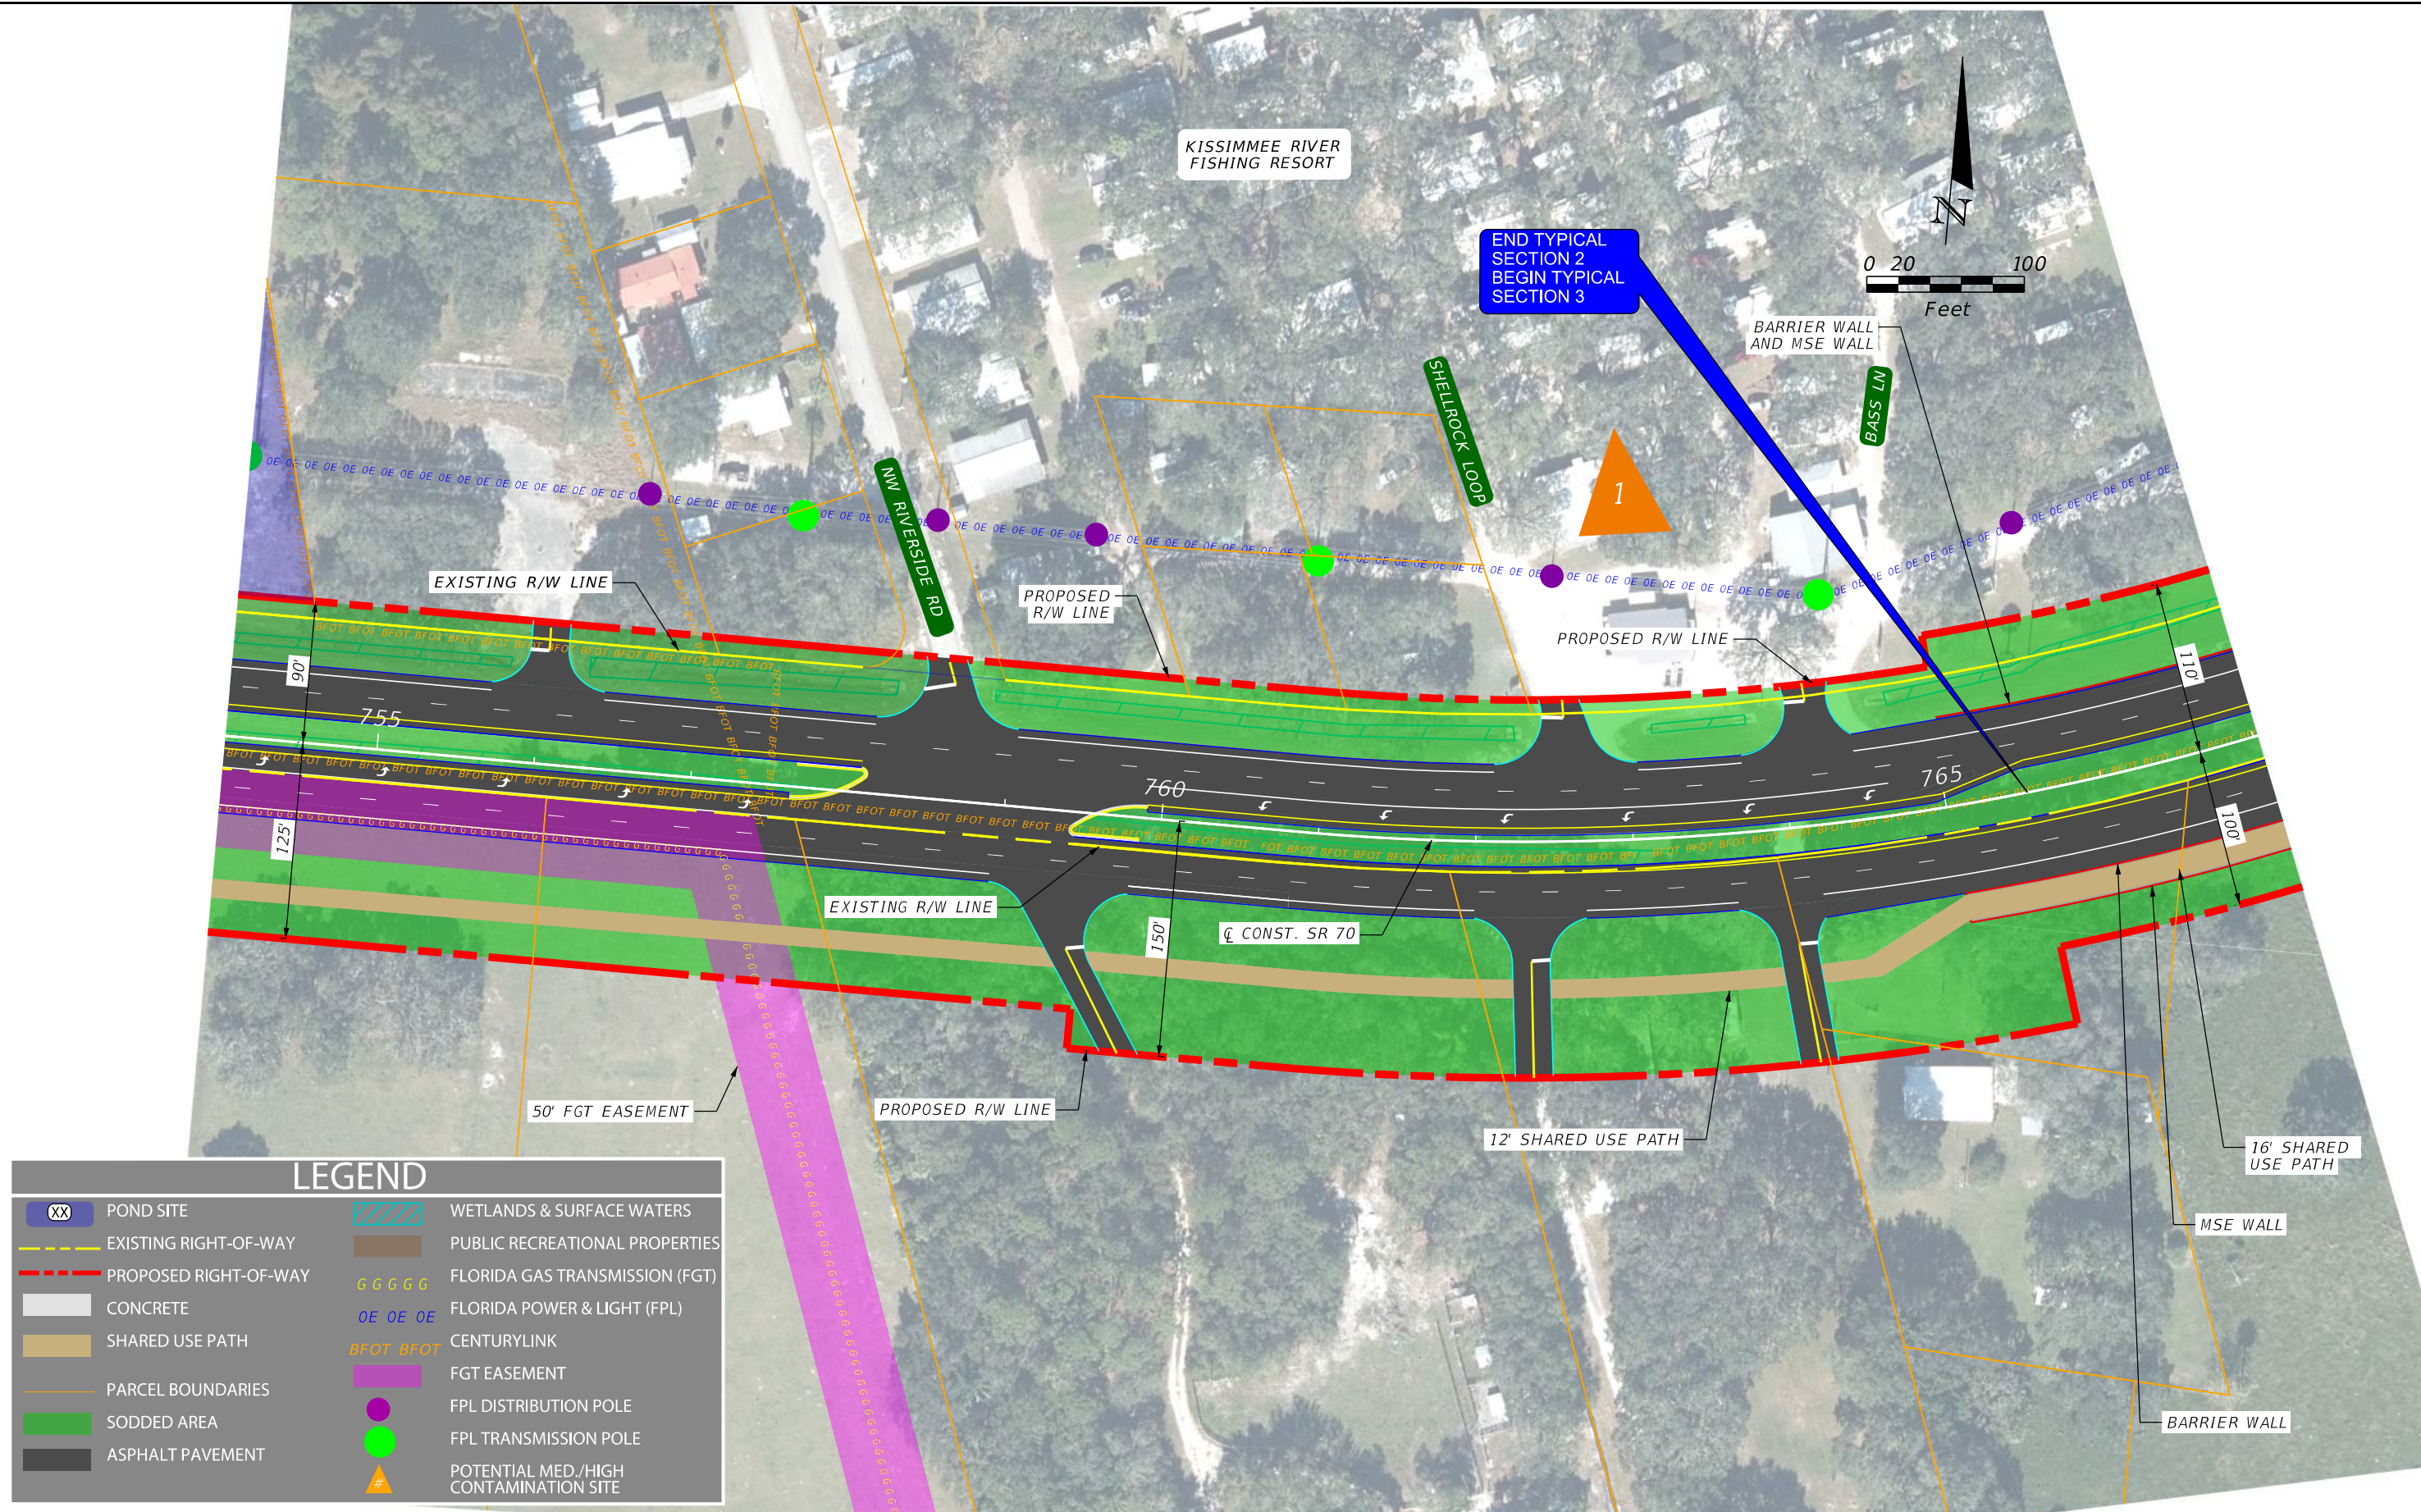

LEGEND

XX

POND SITE

EXISTING RIGHT-OF-WAY

PROPOSED RIGHT-OF-WAY

CONCRETE

SHARED USE PATH

PARCEL BOUNDARIES

SODDED AREA

ASPHALT PAVEMENT

WETLANDS & SURFACE WATERS

PUBLIC RECREATIONAL PROPERTIES

GGGGG

FLORIDA GAS TRANSMISSION (FGT)

OE OE OE

FLORIDA POWER & LIGHT (FPL)

BFOT BFOT

CENTURYLINK

FGT EASEMENT

FPL DISTRIBUTION POLE

FPL TRANSMISSION POLE

#


POTENTIAL MED./HIGH CONTAMINATION SITE

REVISIONS				ENGINEER OF RECORD	STATE OF FLORIDA DEPARTMENT OF TRANSPORTATION			SHEET NO.
DATE	DESCRIPTION	DATE	DESCRIPTION		ROAD NO.	COUNTY	FINANCIAL PROJECT ID	
				NICHOLAS JOHN CLAVELO P.E. LICENSE NUMBER: 84366 SCALAR CONSULTING GROUP, LLC. 5713 CORPORATE WAY, SUITE 200 WEST PALM BEACH, FLORIDA 33407	SR 70	HIGHLANDS OKEECHOBEE	450334-1-22-01	26

ALTERNATIVE 1
CONCEPT PLAN


P:\FL23010.00 SR 70 PD&E Study\45033412201\roadway\PLANRD01.dgn : CL12 - PLAN 26 [SHEET]
Jarechavaleta 10/7/2025 8:35:47 AM

THE OFFICIAL RECORD OF THIS SHEET IS THE ELECTRONIC FILE DIGITALLY SIGNED AND SEALED UNDER RULE 61G15-23.004, F.A.C.

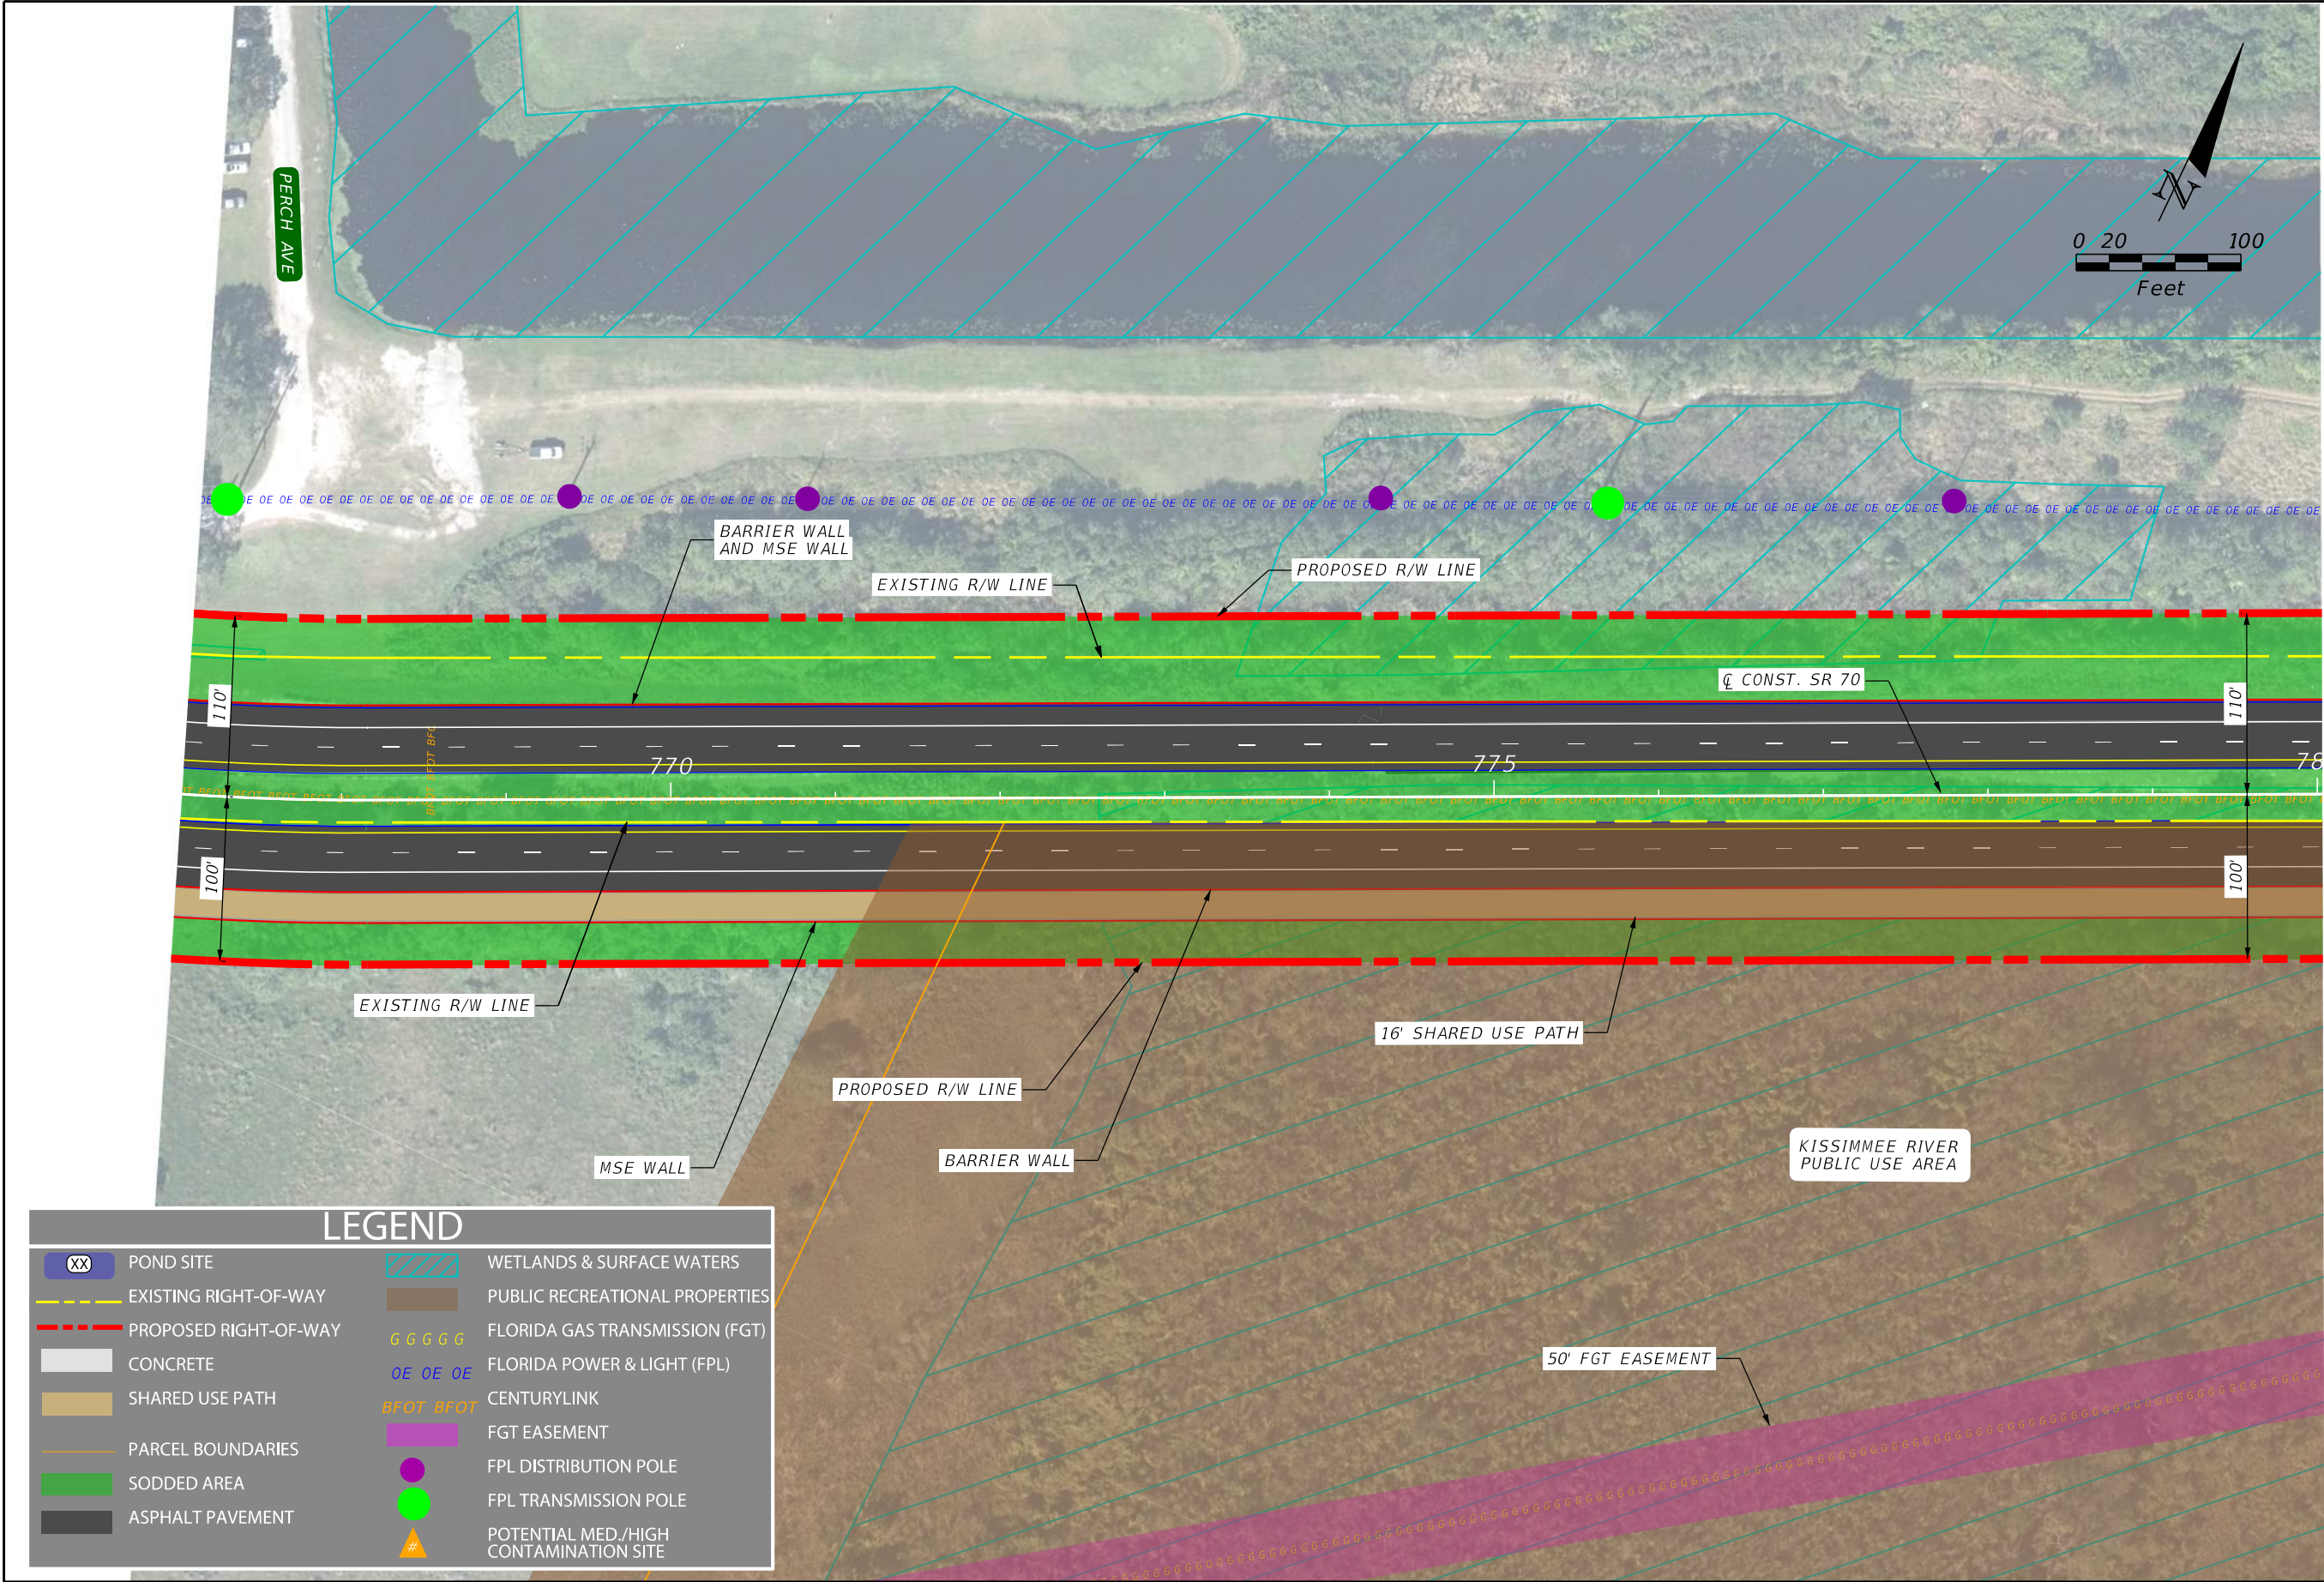

REVISIONS				ENGINEER OF RECORD		STATE OF FLORIDA DEPARTMENT OF TRANSPORTATION		ALTERNATIVE 1 CONCEPT PLAN	SHEET NO.
DATE	DESCRIPTION	DATE	DESCRIPTION	NICHOLAS JOHN CLAVELLO P.E. LICENSE NUMBER: 84366 SCALAR CONSULTING GROUP, LLC. 5713 CORPORATE WAY, SUITE 200 WEST PALM BEACH, FLORIDA 33407		ROAD NO.	COUNTY		
						SR 70	HIGHLANDS OKEECHOBEE	FINANCIAL PROJECT ID 450334-1-22-01	27

THE OFFICIAL RECORD OF THIS SHEET IS THE ELECTRONIC FILE DIGITALLY SIGNED AND SEALED UNDER RULE 61G15-23.004, F.A.C.

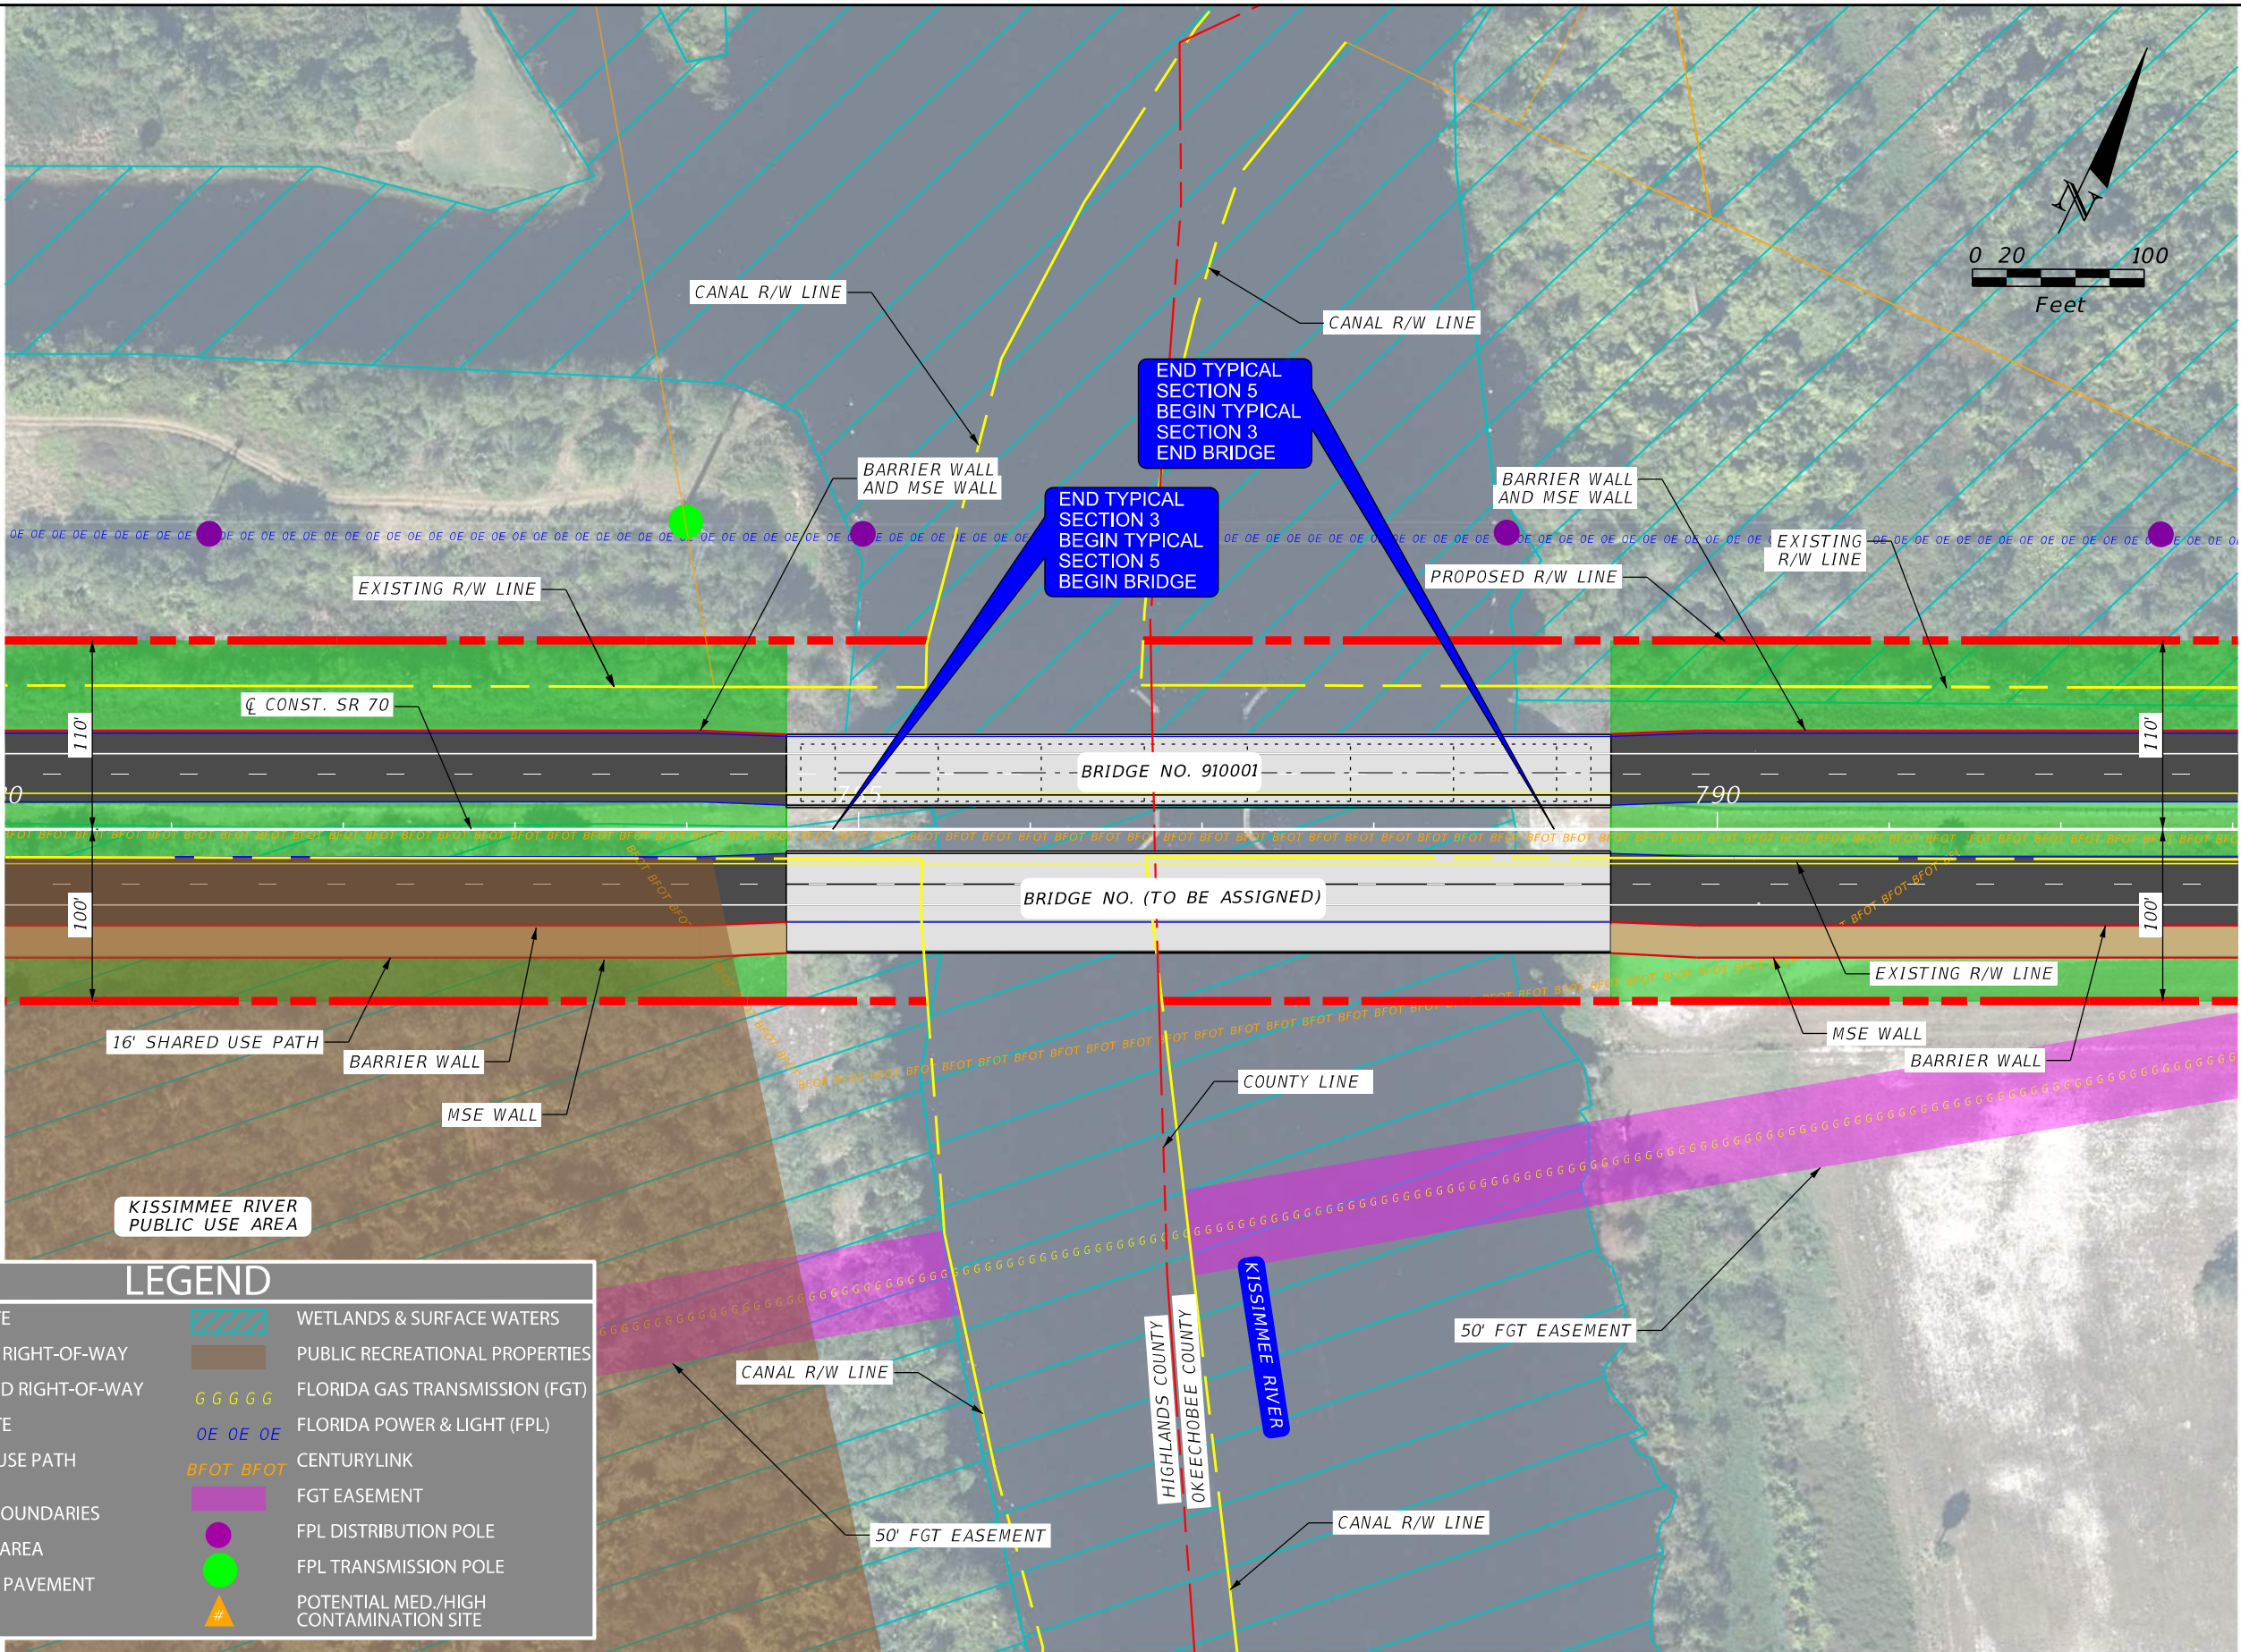

XX

POND SITE

EXISTING RIGHT-OF-WAY

PROPOSED RIGHT-OF-WAY

■

CONCRETE

■

SHARED USE PATH

PARCEL BOUNDARIES

■

SODDED AREA

■

ASPHALT PAVEMENT

WETLANDS & SURFACE WATERS

PUBLIC RECREATIONAL PROPERTIES

GGGGG

FLORIDA GAS TRANSMISSION (FGT)

OE OE OE

FLORIDA POWER & LIGHT (FPL)

BFOT BFOT

CENTURYLINK

FGT EASEMENT


FPL DISTRIBUTION POLE

FPL TRANSMISSION POLE

#

POTENTIAL MED./HIGH CONTAMINATION SITE

REVISIONS				ENGINEER OF RECORD		STATE OF FLORIDA DEPARTMENT OF TRANSPORTATION		ALTERNATIVE 1 CONCEPT PLAN	SHEET NO. 28
DATE	DESCRIPTION	DATE	DESCRIPTION	NICHOLAS JOHN CLAVELLO P.E. LICENSE NUMBER: 84366 SCALAR CONSULTING GROUP, LLC. 5713 CORPORATE WAY, SUITE 200 WEST PALM BEACH, FLORIDA 33407		ROAD NO.	COUNTY		
						SR 70	HIGHLANDS OKEECHOBEE	FINANCIAL PROJECT ID 450334-1-22-01	

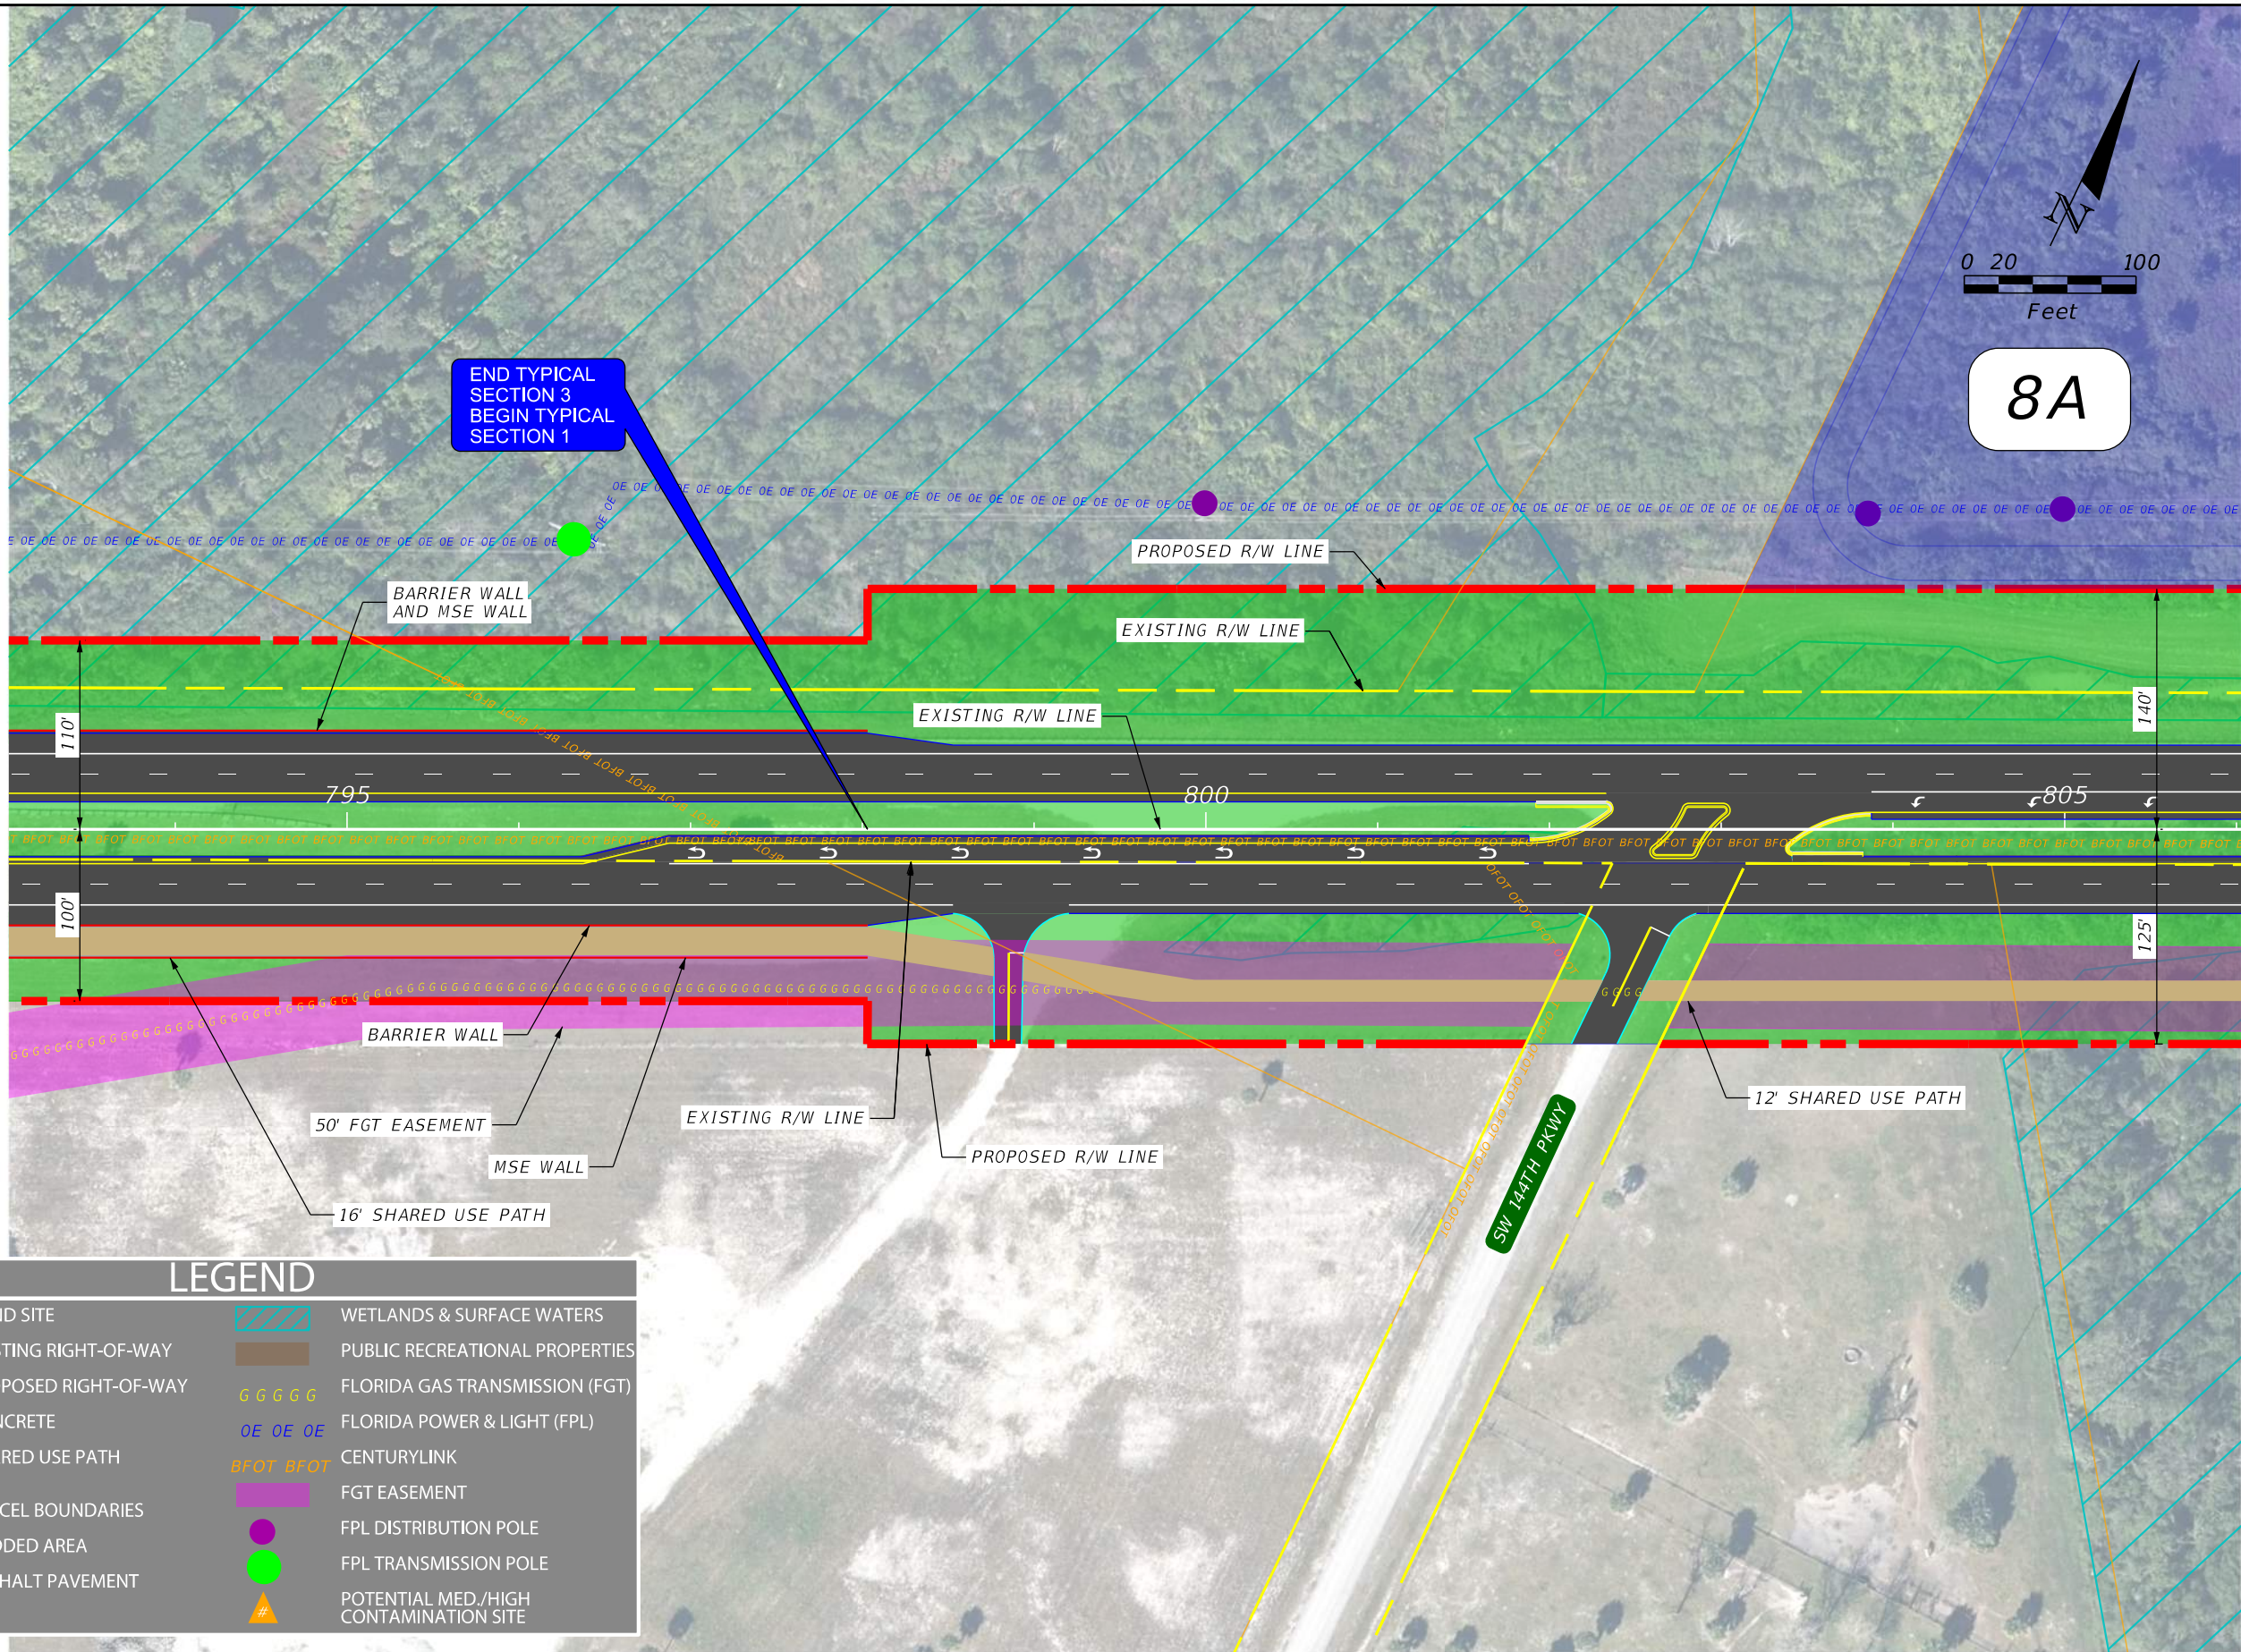


LEGEND

	POND SITE		WETLANDS & SURFACE WATERS
	EXISTING RIGHT-OF-WAY		PUBLIC RECREATIONAL PROPERTIES
	PROPOSED RIGHT-OF-WAY		FLORIDA GAS TRANSMISSION (FGT)
	CONCRETE		FLORIDA POWER & LIGHT (FPL)
	SHARED USE PATH		CENTURYLINK
	PARCEL BOUNDARIES		FGT EASEMENT
	SODDED AREA		FPL DISTRIBUTION POLE
	ASPHALT PAVEMENT		FPL TRANSMISSION POLE
			POTENTIAL MED./HIGH CONTAMINATION SITE

REVISIONS				ENGINEER OF RECORD	STATE OF FLORIDA DEPARTMENT OF TRANSPORTATION			ALTERNATIVE 1 CONCEPT PLAN	SHEET NO.
DATE	DESCRIPTION	DATE	DESCRIPTION	NICHOLAS JOHN CLAVELLO P.E. LICENSE NUMBER: 84366 SCALAR CONSULTING GROUP, LLC, 5713 CORPORATE WAY, SUITE 200 WEST PALM BEACH, FLORIDA 33407	ROAD NO.	COUNTY	FINANCIAL PROJECT ID		29
					SR 70	HIGHLANDS OKEECHOBEE	450334-1-22-01		

NICHOLAS JOHN CLAVELO P.E.
LICENSE NUMBER: 84366
SCALAR CONSULTING GROUP, LLC.
5713 CORPORATE WAY, SUITE 200
WEST PALM BEACH, FLORIDA 33407

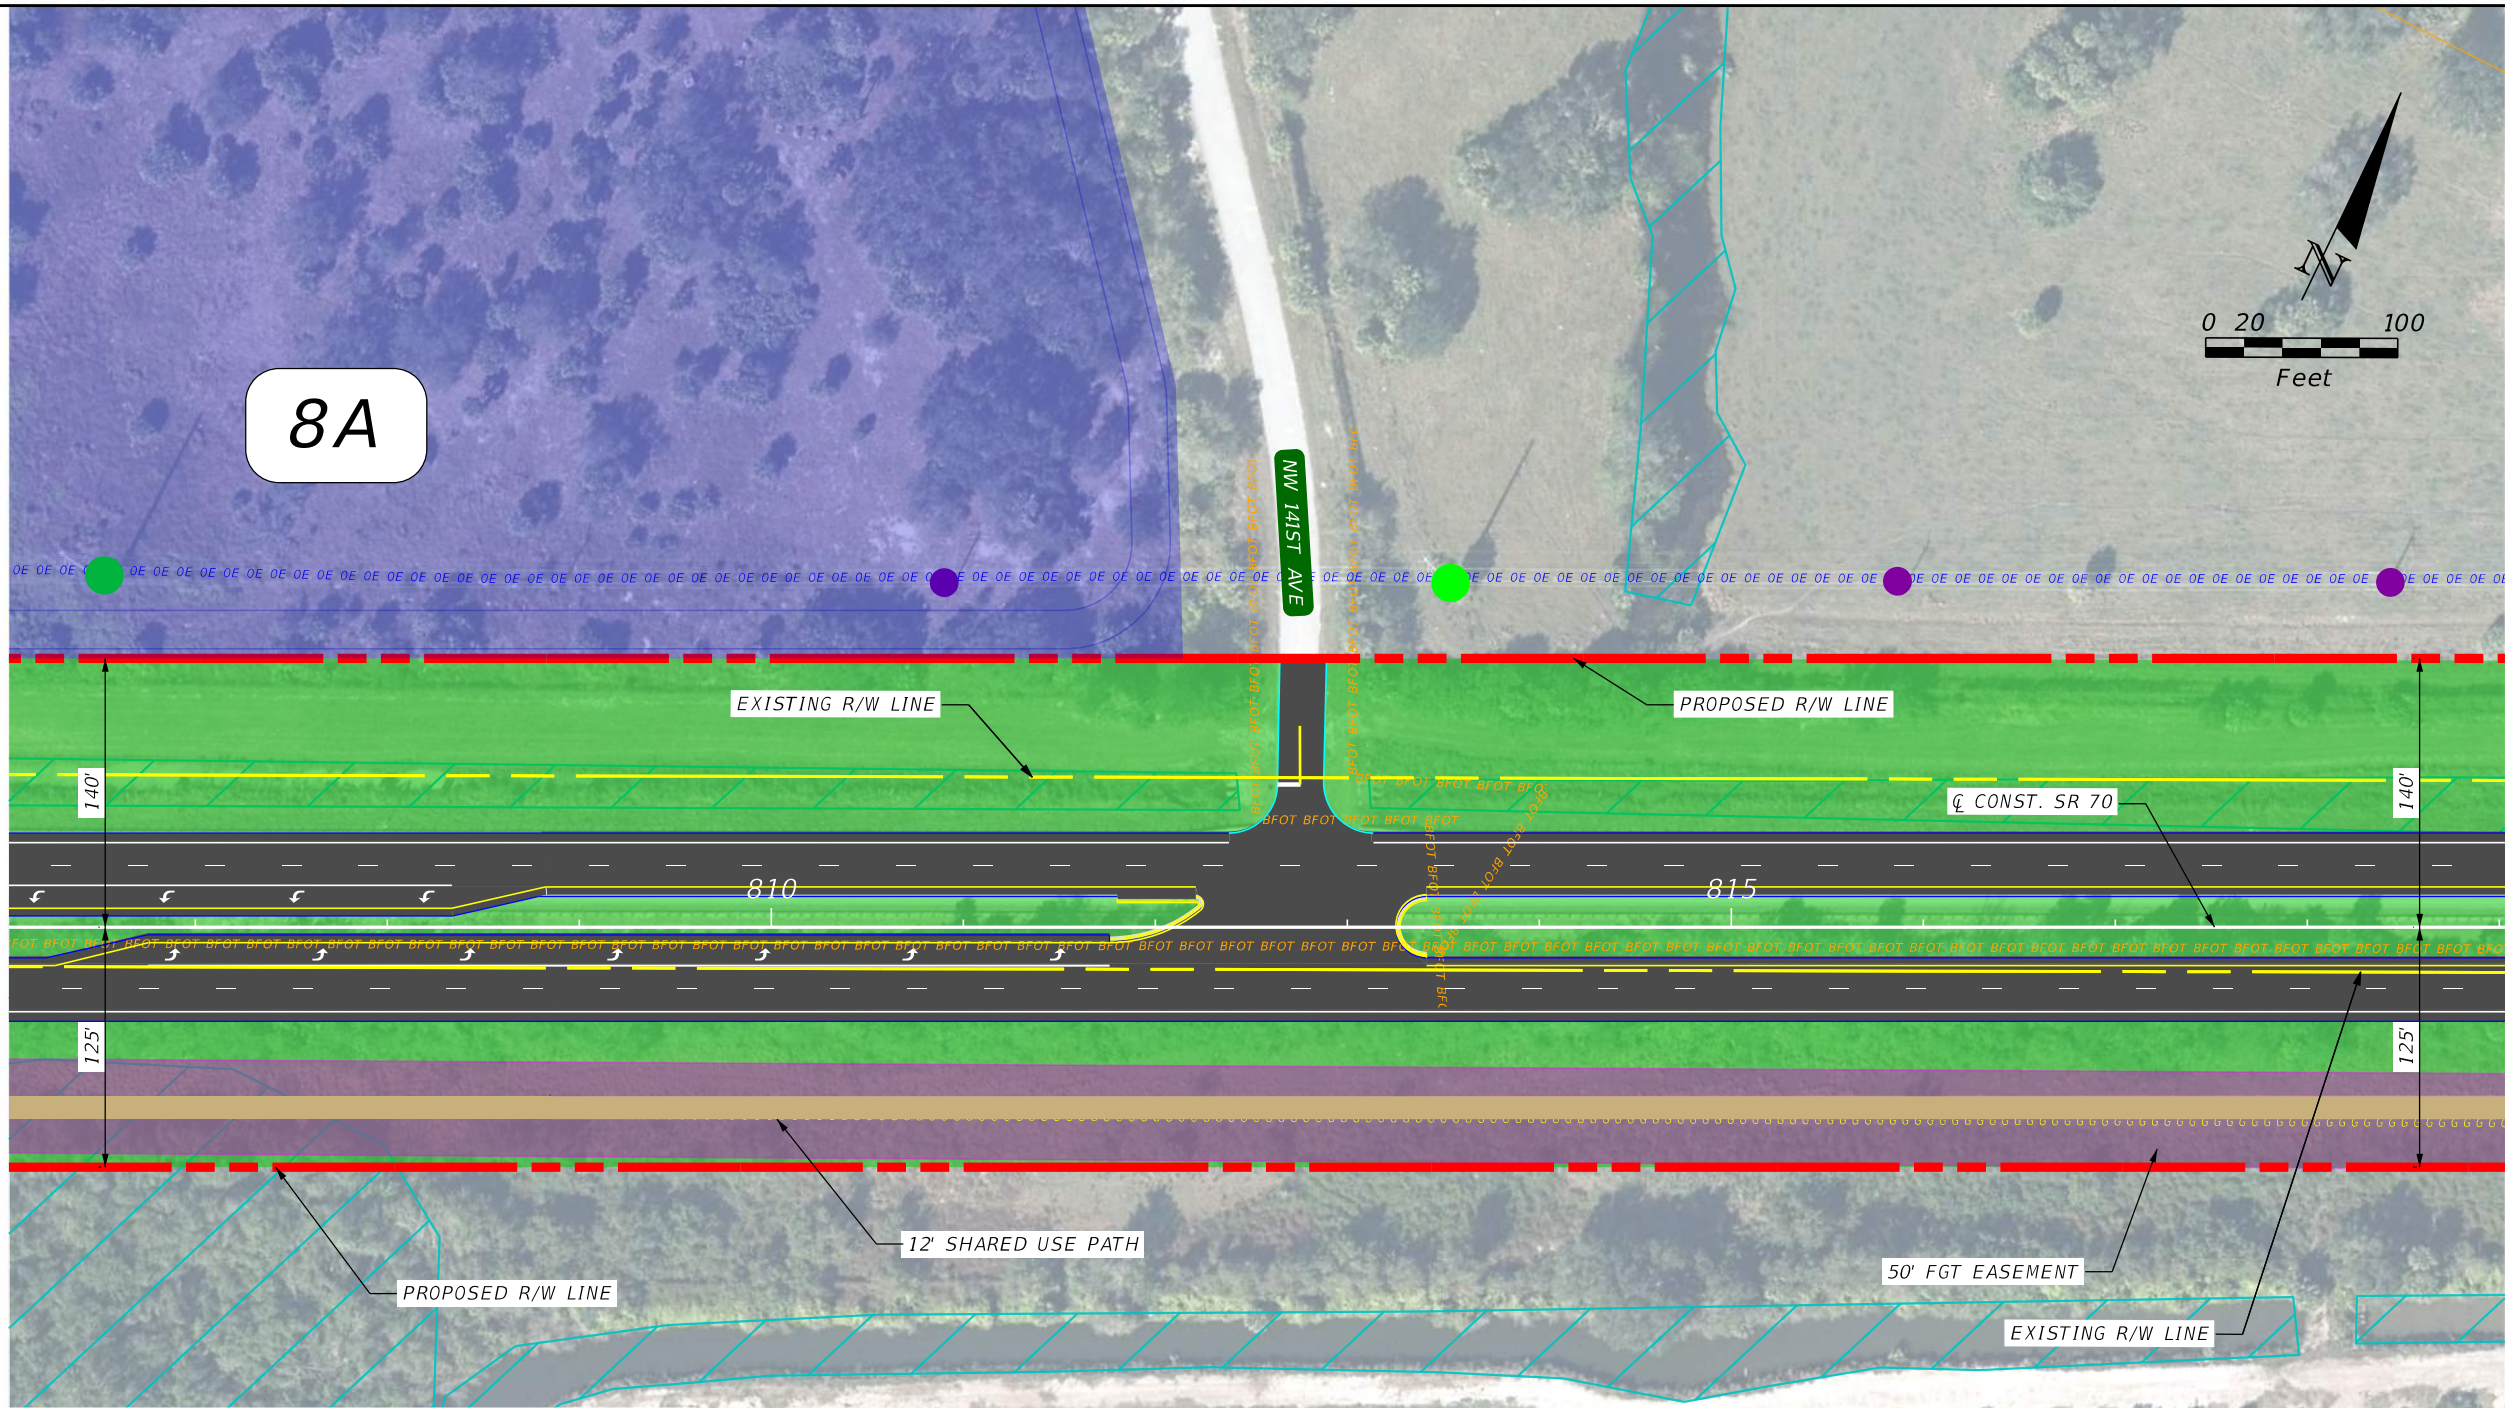

XX

POND SITE

EXISTING RIGHT-OF-WAY

PROPOSED RIGHT-OF-WAY

CONCRETE

SHARED USE PATH

PARCEL BOUNDARIES

SODDED AREA

ASPHALT PAVEMENT

WETLANDS & SURFACE WATERS

PUBLIC RECREATIONAL PROPERTIES

GGGG

FLORIDA GAS TRANSMISSION (FGT)

OE OE OE

FLORIDA POWER & LIGHT (FPL)

BFOT BFOT

CENTURYLINK

FGT EASEMENT

●

FPL DISTRIBUTION POLE


●

FPL TRANSMISSION POLE

#

POTENTIAL MED./HIGH CONTAMINATION SITE

REVISIONS				ENGINEER OF RECORD	STATE OF FLORIDA DEPARTMENT OF TRANSPORTATION			ALTERNATIVE 1 CONCEPT PLAN	SHEET NO.	
DATE	DESCRIPTION		DATE	DESCRIPTION		ROAD NO.	COUNTY		FINANCIAL PROJECT ID	30
						SR 70	HIGHLANDS OKEECHOBEE		450334-1-22-01	
				NICHOLAS JOHN CLAVELLO P.E. LICENSE NUMBER: 84366 SCALAR CONSULTING GROUP, LLC. 5713 CORPORATE WAY, SUITE 200 WEST PALM BEACH, FLORIDA 33407						

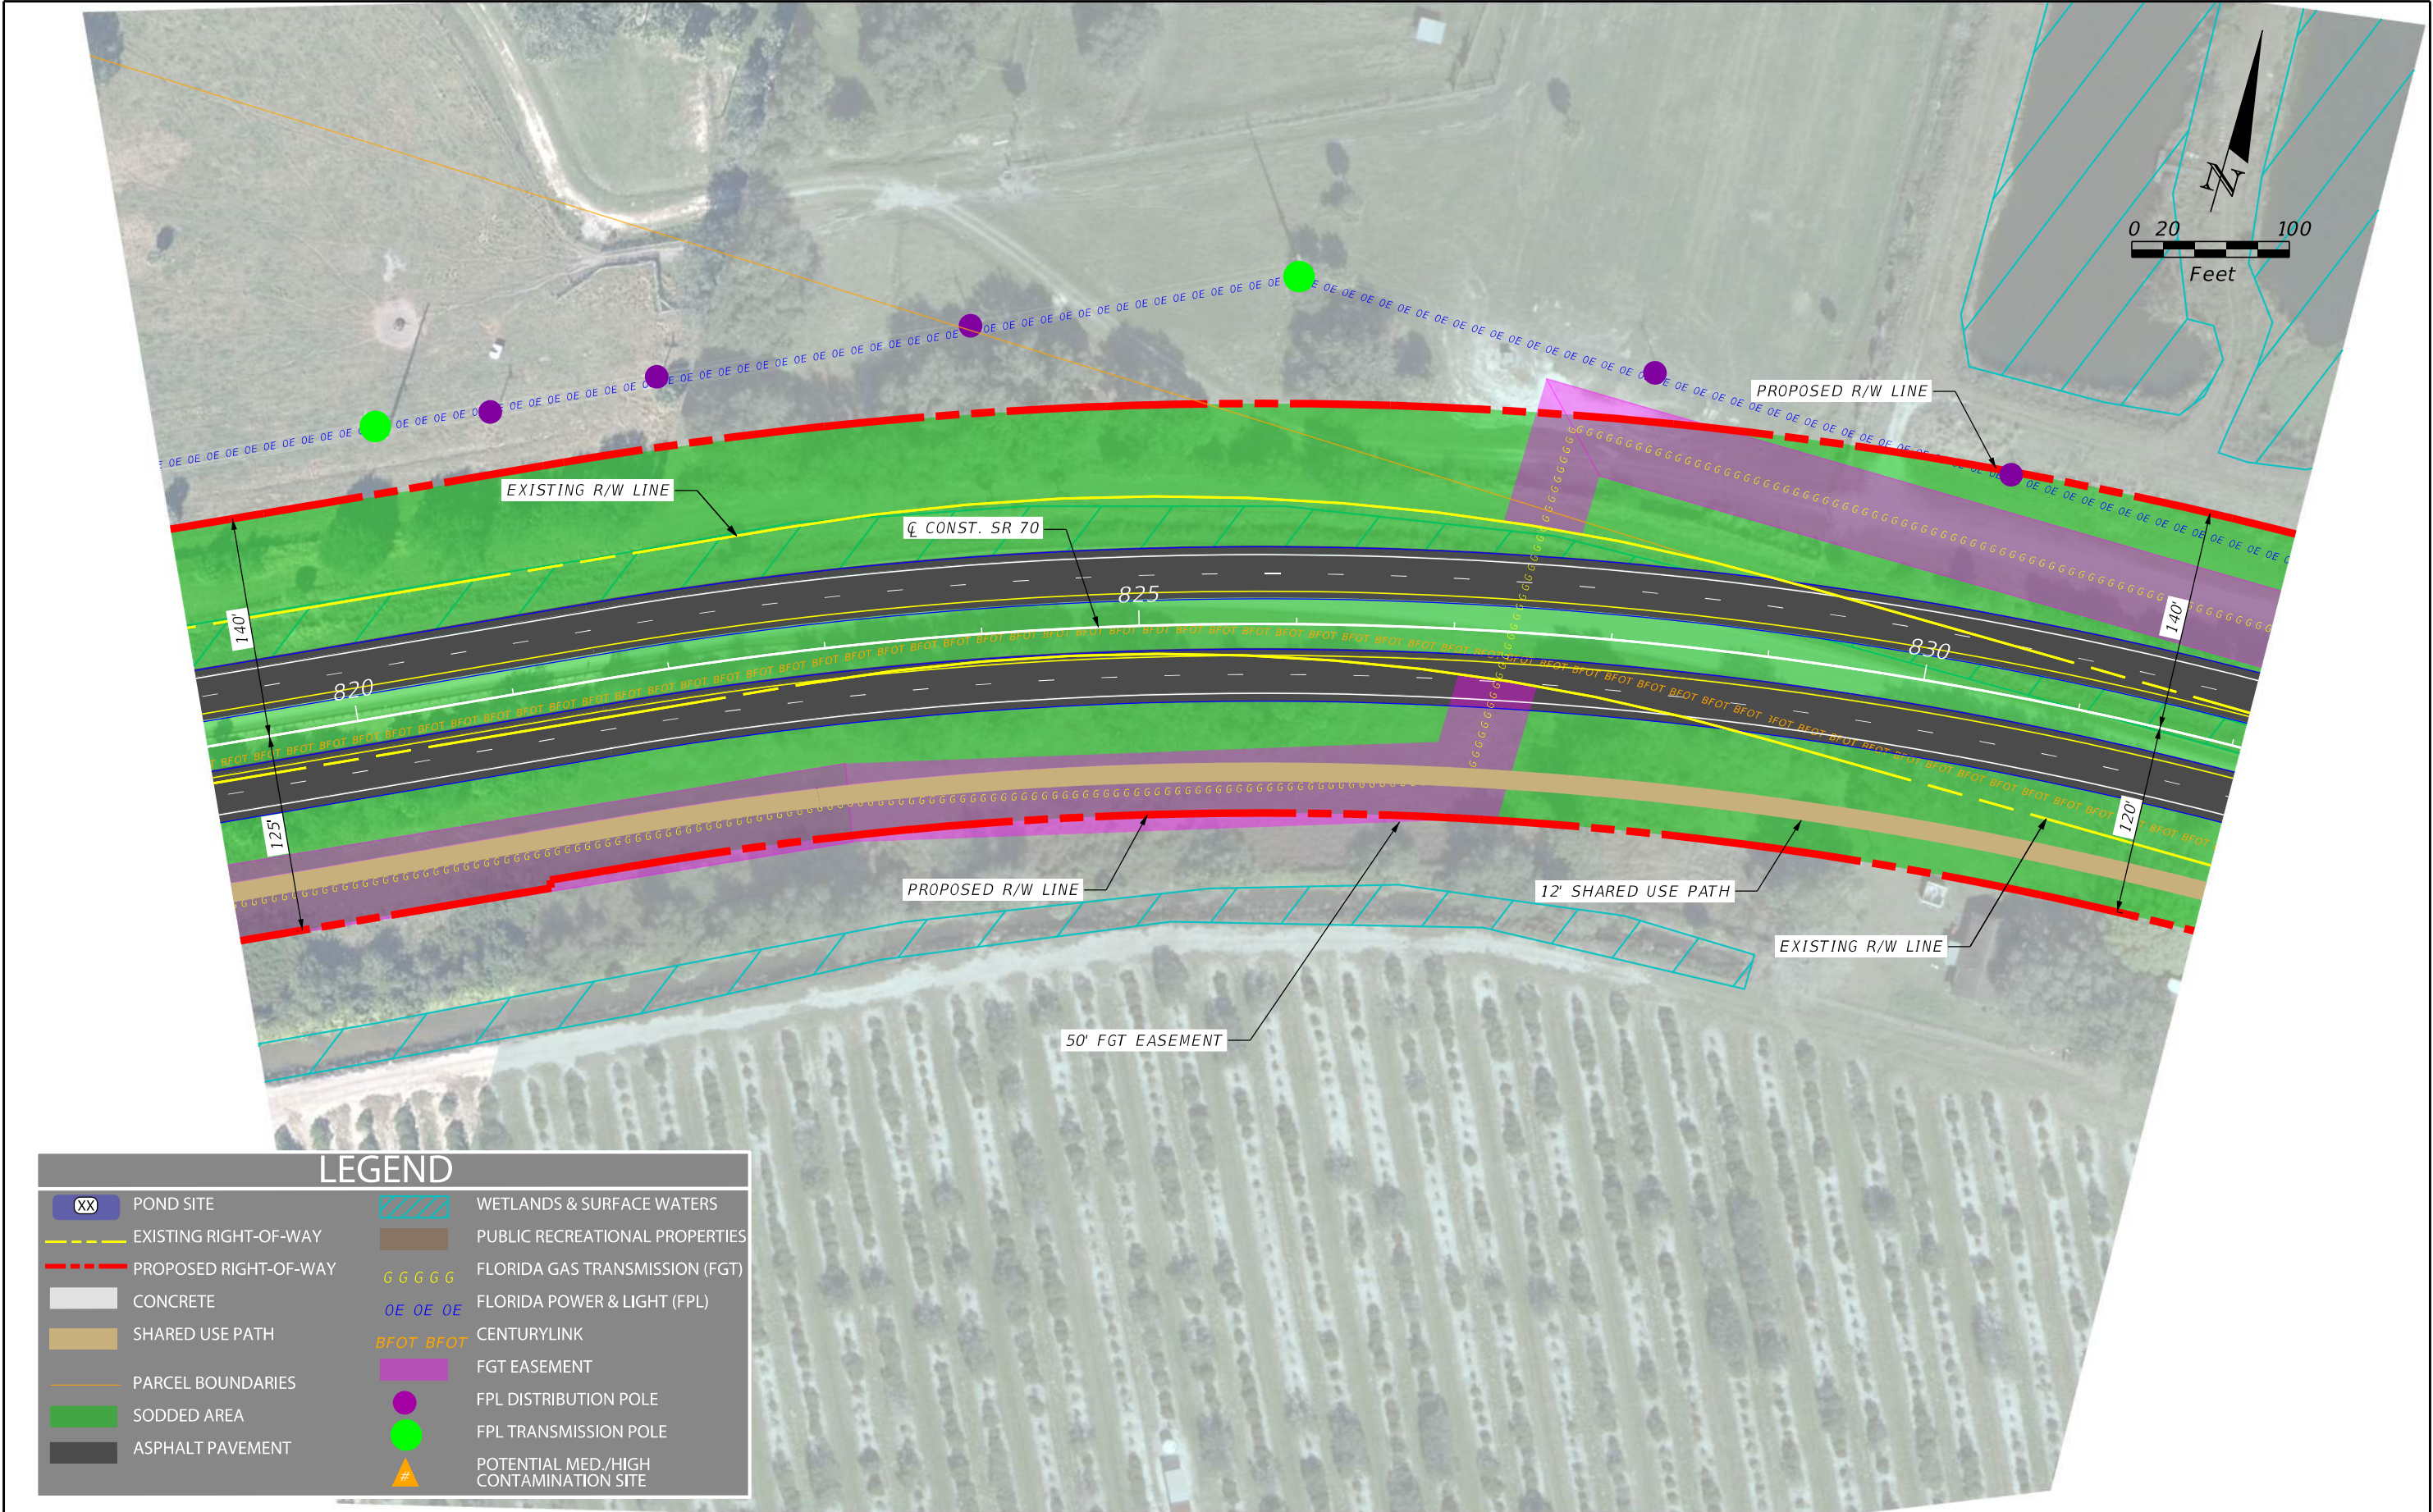

XX

POND SITE

EXISTING RIGHT-OF-WAY

PROPOSED RIGHT-OF-WAY

CONCRETE

SHARED USE PATH

PARCEL BOUNDARIES

SODDED AREA

ASPHALT PAVEMENT

WETLANDS & SURFACE WATERS

PUBLIC RECREATIONAL PROPERTIES

GGGG

FLORIDA GAS TRANSMISSION (FGT)

OE OE OE

FLORIDA POWER & LIGHT (FPL)

BFOT BFOT

CENTURYLINK

FGT EASEMENT

●

FPL DISTRIBUTION POLE

●


FPL TRANSMISSION POLE

▲

POTENTIAL MED./HIGH CONTAMINATION SITE

REVISIONS				ENGINEER OF RECORD			STATE OF FLORIDA DEPARTMENT OF TRANSPORTATION			ALTERNATIVE 1 CONCEPT PLAN	SHEET NO. 31
DATE	DESCRIPTION	DATE	DESCRIPTION	NICHOLAS JOHN CLAVELLO P.E. LICENSE NUMBER: 84366 SCALAR CONSULTING GROUP, LLC. 5713 CORPORATE WAY, SUITE 200 WEST PALM BEACH, FLORIDA 33407			ROAD NO.	COUNTY	FINANCIAL PROJECT ID		
							SR 70	HIGHLANDS OKEECHOBEE	450334-1-22-01		


THE OFFICIAL RECORD OF THIS SHEET IS THE ELECTRONIC FILE DIGITALLY SIGNED AND SEALED UNDER RULE 61G15-23.004, F.A.C.

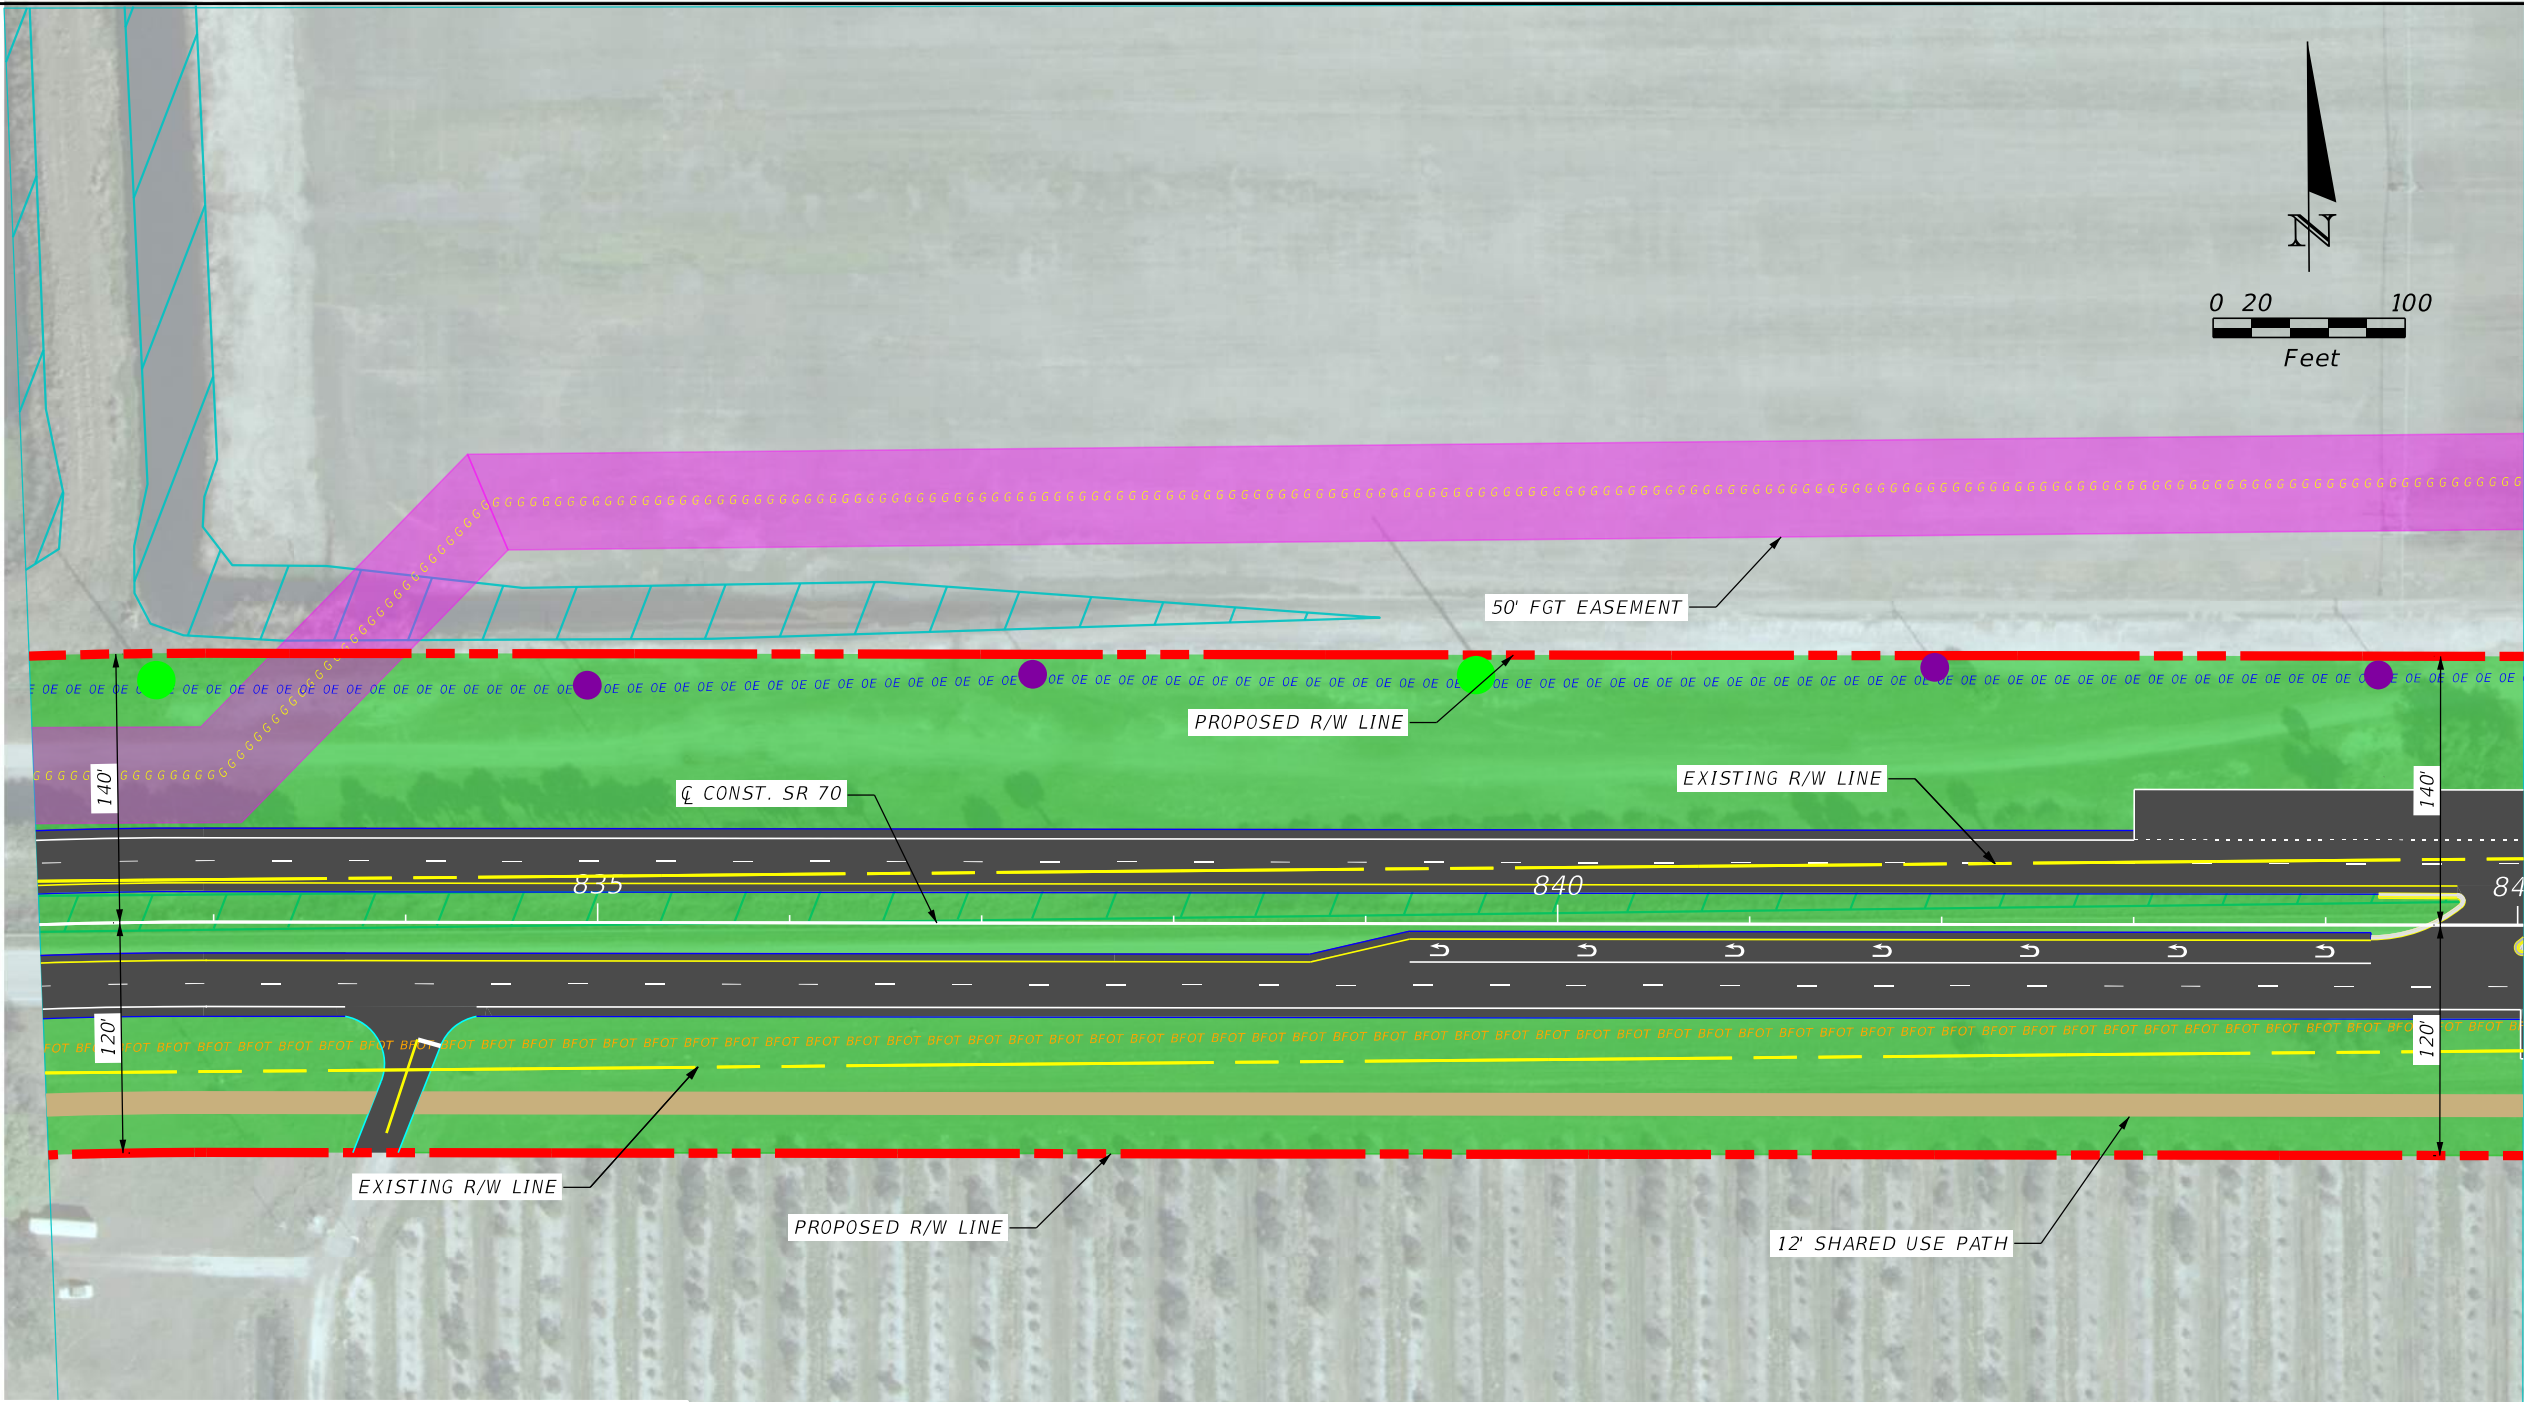

LEGEND

POND SITE	WETLANDS & SURFACE WATERS
EXISTING RIGHT-OF-WAY	PUBLIC RECREATIONAL PROPERTIES
PROPOSED RIGHT-OF-WAY	FLORIDA GAS TRANSMISSION (FGT)
CONCRETE	FLORIDA POWER & LIGHT (FPL)
SHARED USE PATH	CENTURYLINK
PARCEL BOUNDARIES	FGT EASEMENT
SODDED AREA	FPL DISTRIBUTION POLE
ASPHALT PAVEMENT	FPL TRANSMISSION POLE
	POTENTIAL MED./HIGH CONTAMINATION SITE

REVISIONS				ENGINEER OF RECORD	STATE OF FLORIDA DEPARTMENT OF TRANSPORTATION			ALTERNATIVE 1 CONCEPT PLAN	SHEET NO.
DATE	DESCRIPTION	DATE	DESCRIPTION	NICHOLAS JOHN CLAVELO P.E. LICENSE NUMBER: 84366 SCALAR CONSULTING GROUP, LLC. 5713 CORPORATE WAY, SUITE 200 WEST PALM BEACH, FLORIDA 33407	ROAD NO.	COUNTY	FINANCIAL PROJECT ID		32
					SR 70	HIGHLANDS OKEECHOBEE	450334-1-22-01		

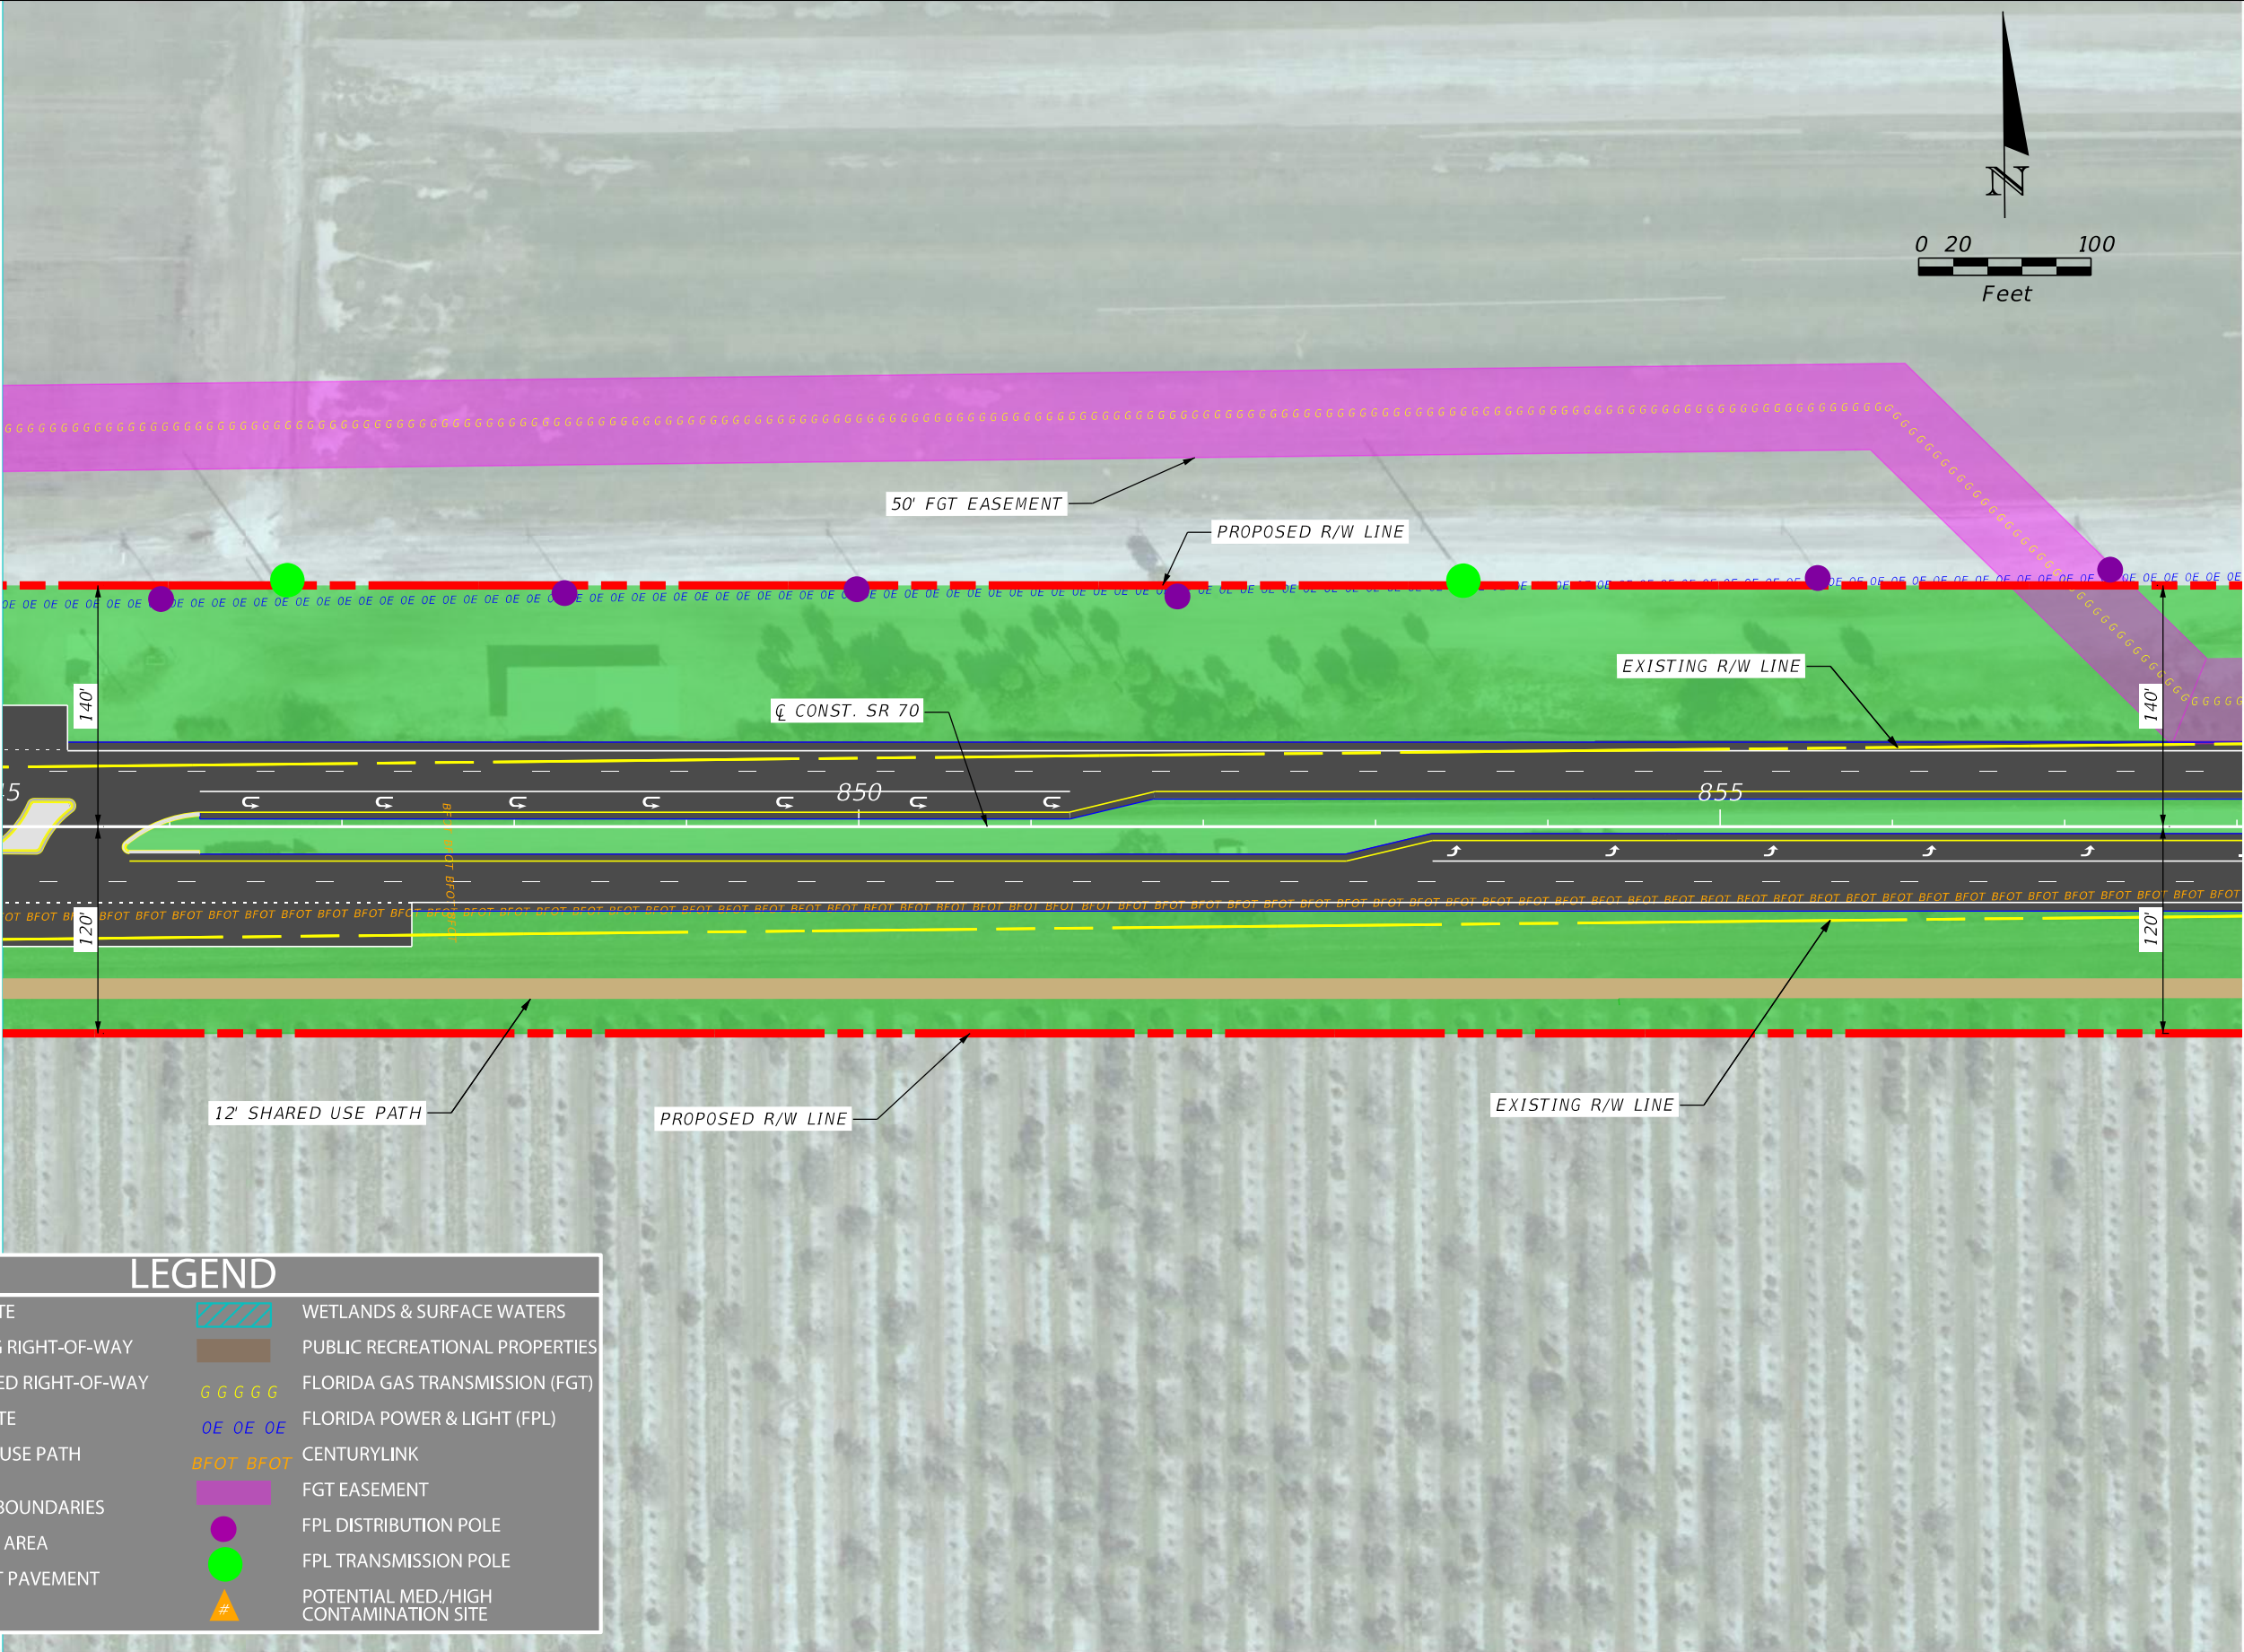

XX

POND SITE

EXISTING RIGHT-OF-WAY

PROPOSED RIGHT-OF-WAY

CONCRETE

SHARED USE PATH

PARCEL BOUNDARIES

SODDED AREA

ASPHALT PAVEMENT

WETLANDS & SURFACE WATERS

PUBLIC RECREATIONAL PROPERTIES

GGGG

FLORIDA GAS TRANSMISSION (FGT)

OE OE OE

FLORIDA POWER & LIGHT (FPL)

BFOT BFOT

CENTURYLINK

FGT EASEMENT

FPL DISTRIBUTION POLE


FPL TRANSMISSION POLE

#

POTENTIAL MED./HIGH CONTAMINATION SITE

REVISIONS				ENGINEER OF RECORD	STATE OF FLORIDA DEPARTMENT OF TRANSPORTATION			ALTERNATIVE 1 CONCEPT PLAN	SHEET NO.
DATE	DESCRIPTION	DATE	DESCRIPTION	NICHOLAS JOHN CLAVELLO P.E. LICENSE NUMBER: 84366 SCALAR CONSULTING GROUP, LLC. 5713 CORPORATE WAY, SUITE 200 WEST PALM BEACH, FLORIDA 33407	ROAD NO.	COUNTY	FINANCIAL PROJECT ID		33
					SR 70	HIGHLANDS OKEECHOBEE	450334-1-22-01		

THE OFFICIAL RECORD OF THIS SHEET IS THE ELECTRONIC FILE DIGITALLY SIGNED AND SEALED UNDER RULE 61G15-23.004, F.A.C.

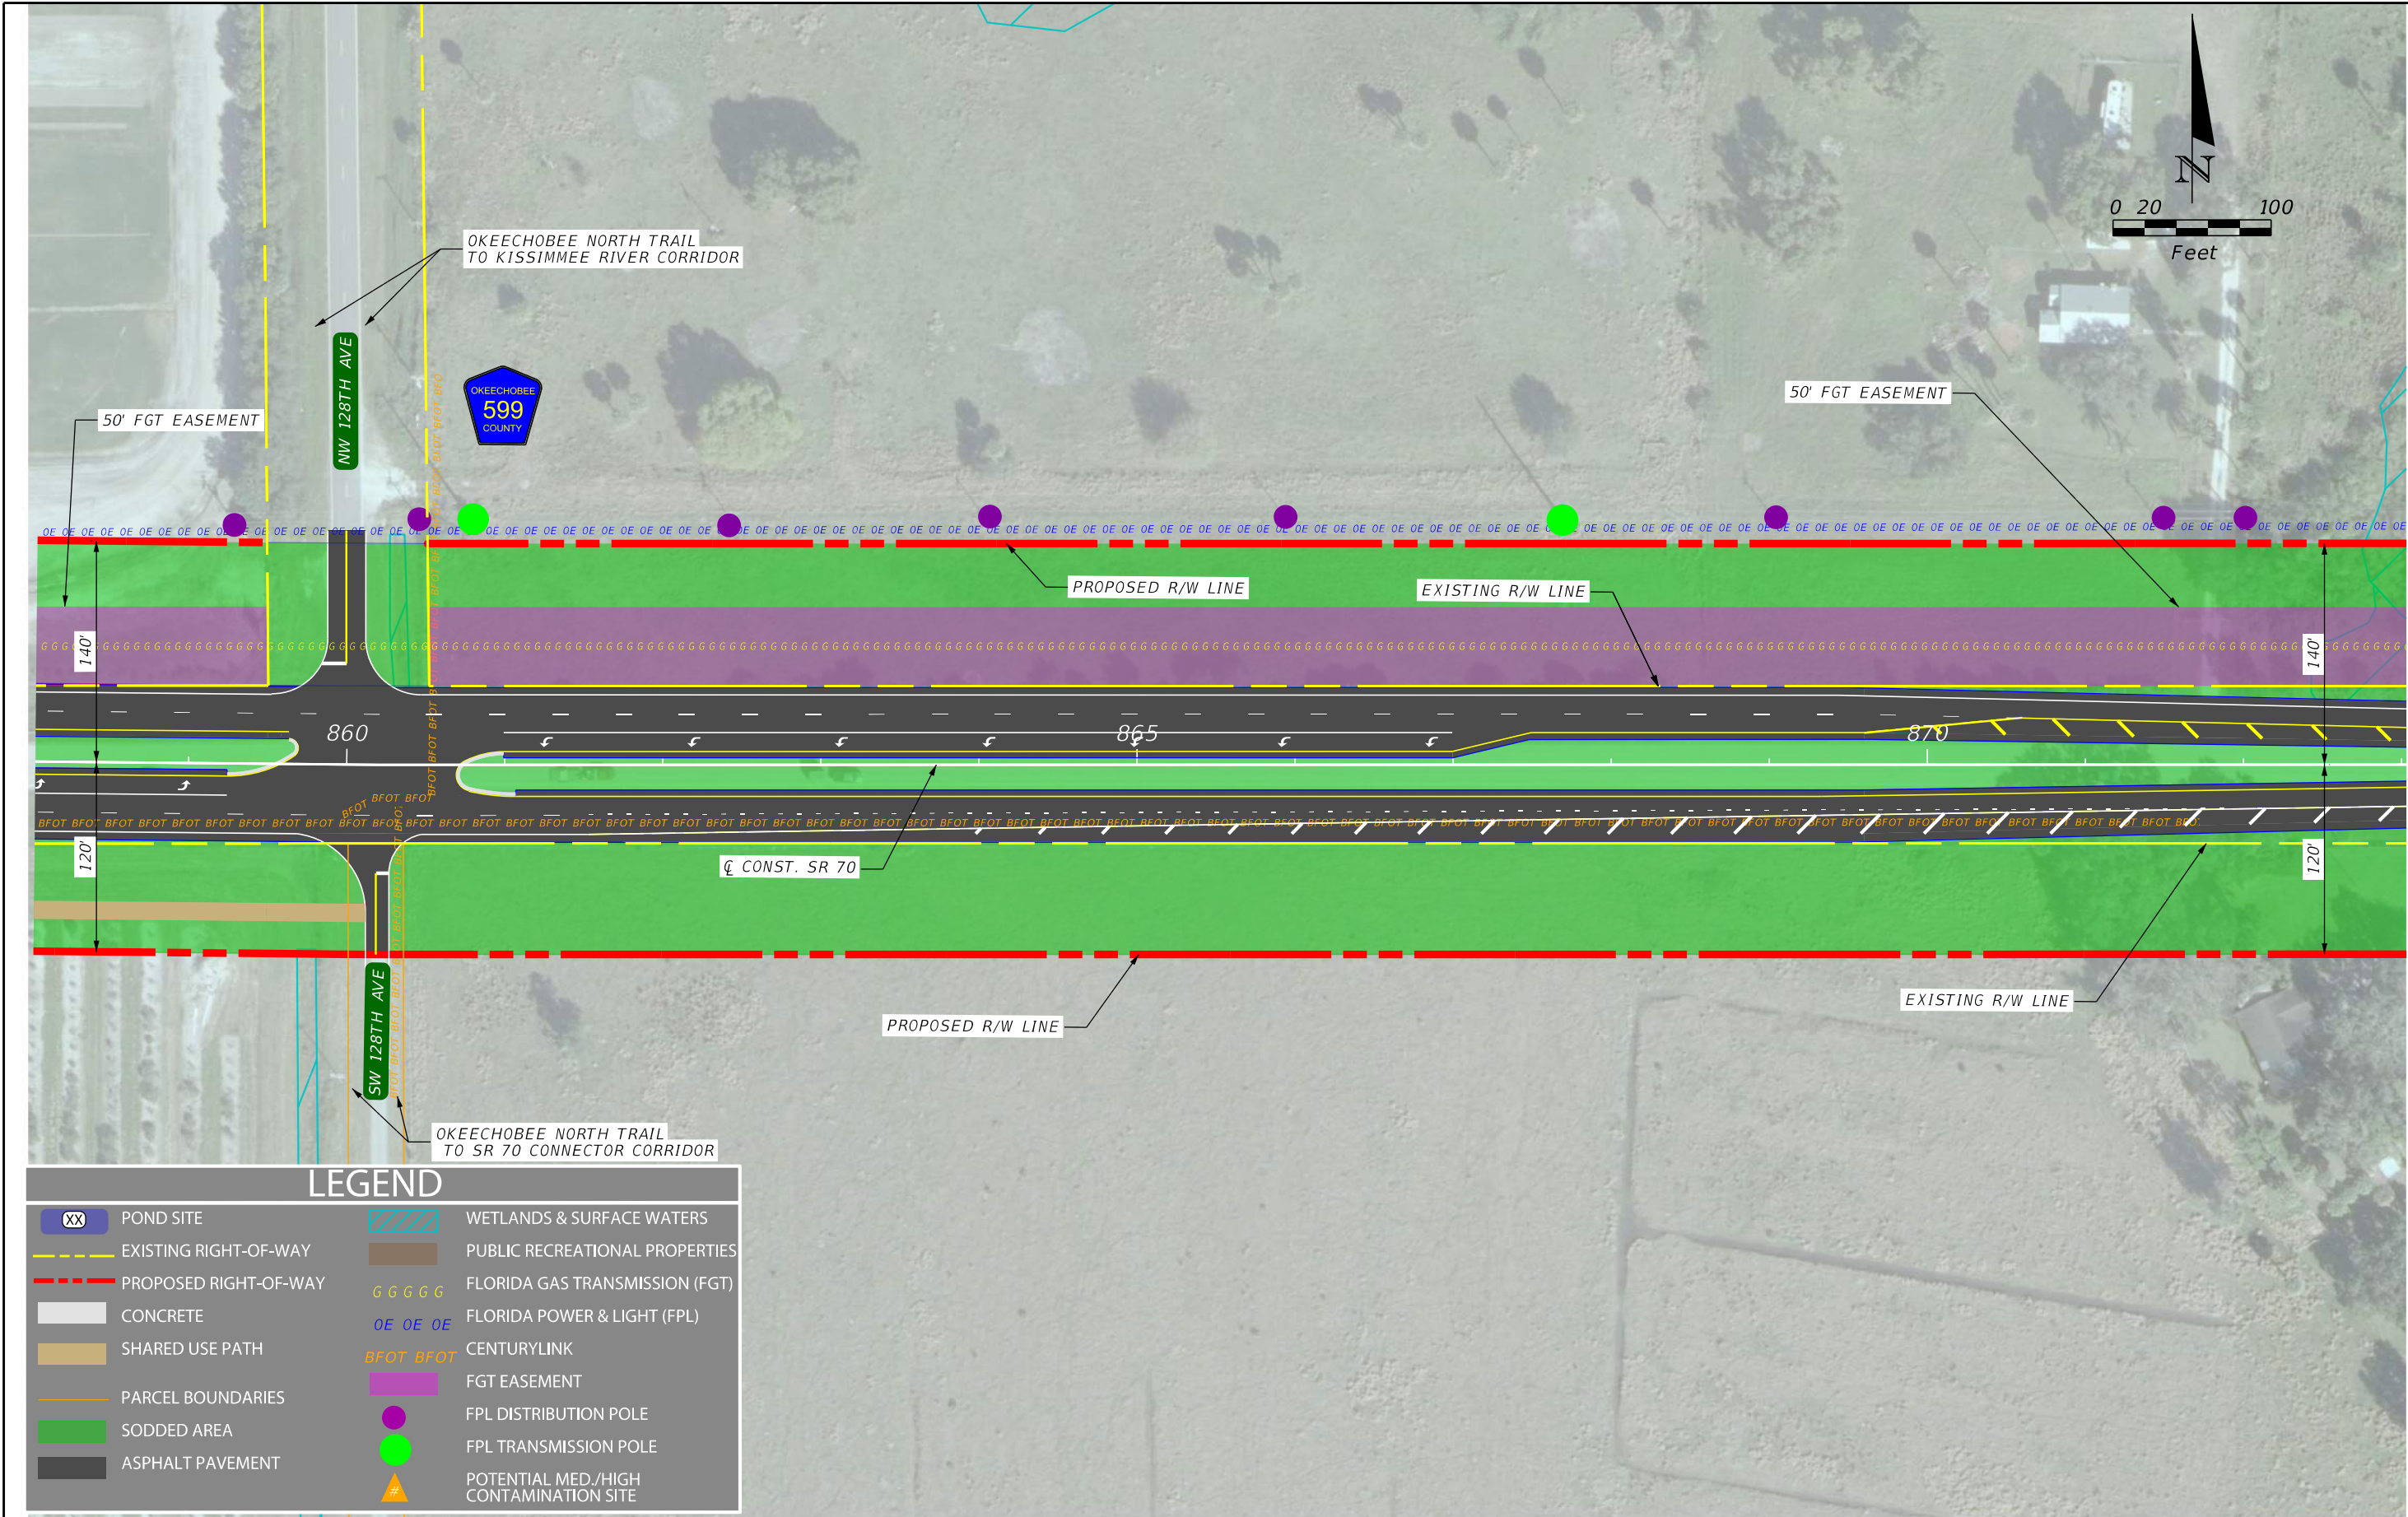

LEGEND

XX

POND SITE

EXISTING RIGHT-OF-WAY

PROPOSED RIGHT-OF-WAY

CONCRETE

SHARED USE PATH

PARCEL BOUNDARIES

SODDED AREA

ASPHALT PAVEMENT

WETLANDS & SURFACE WATERS

PUBLIC RECREATIONAL PROPERTIES

GGGGG

FLORIDA GAS TRANSMISSION (FGT)

OE OE OE

FLORIDA POWER & LIGHT (FPL)

BFOT BFOT

CENTURYLINK

FGT EASEMENT

●

FPL DISTRIBUTION POLE


●

FPL TRANSMISSION POLE

#

POTENTIAL MED./HIGH CONTAMINATION SITE

REVISIONS				ENGINEER OF RECORD			STATE OF FLORIDA DEPARTMENT OF TRANSPORTATION			ALTERNATIVE 1 CONCEPT PLAN	SHEET NO. 34
DATE	DESCRIPTION	DATE	DESCRIPTION	NICHOLAS JOHN CLAVELO P.E. LICENSE NUMBER: 84366 SCALAR CONSULTING GROUP, LLC. 5713 CORPORATE WAY, SUITE 200 WEST PALM BEACH, FLORIDA 33407			ROAD NO.	COUNTY	FINANCIAL PROJECT ID		
							SR 70	HIGHLANDS OKEECHOBEE	450334-1-22-01		

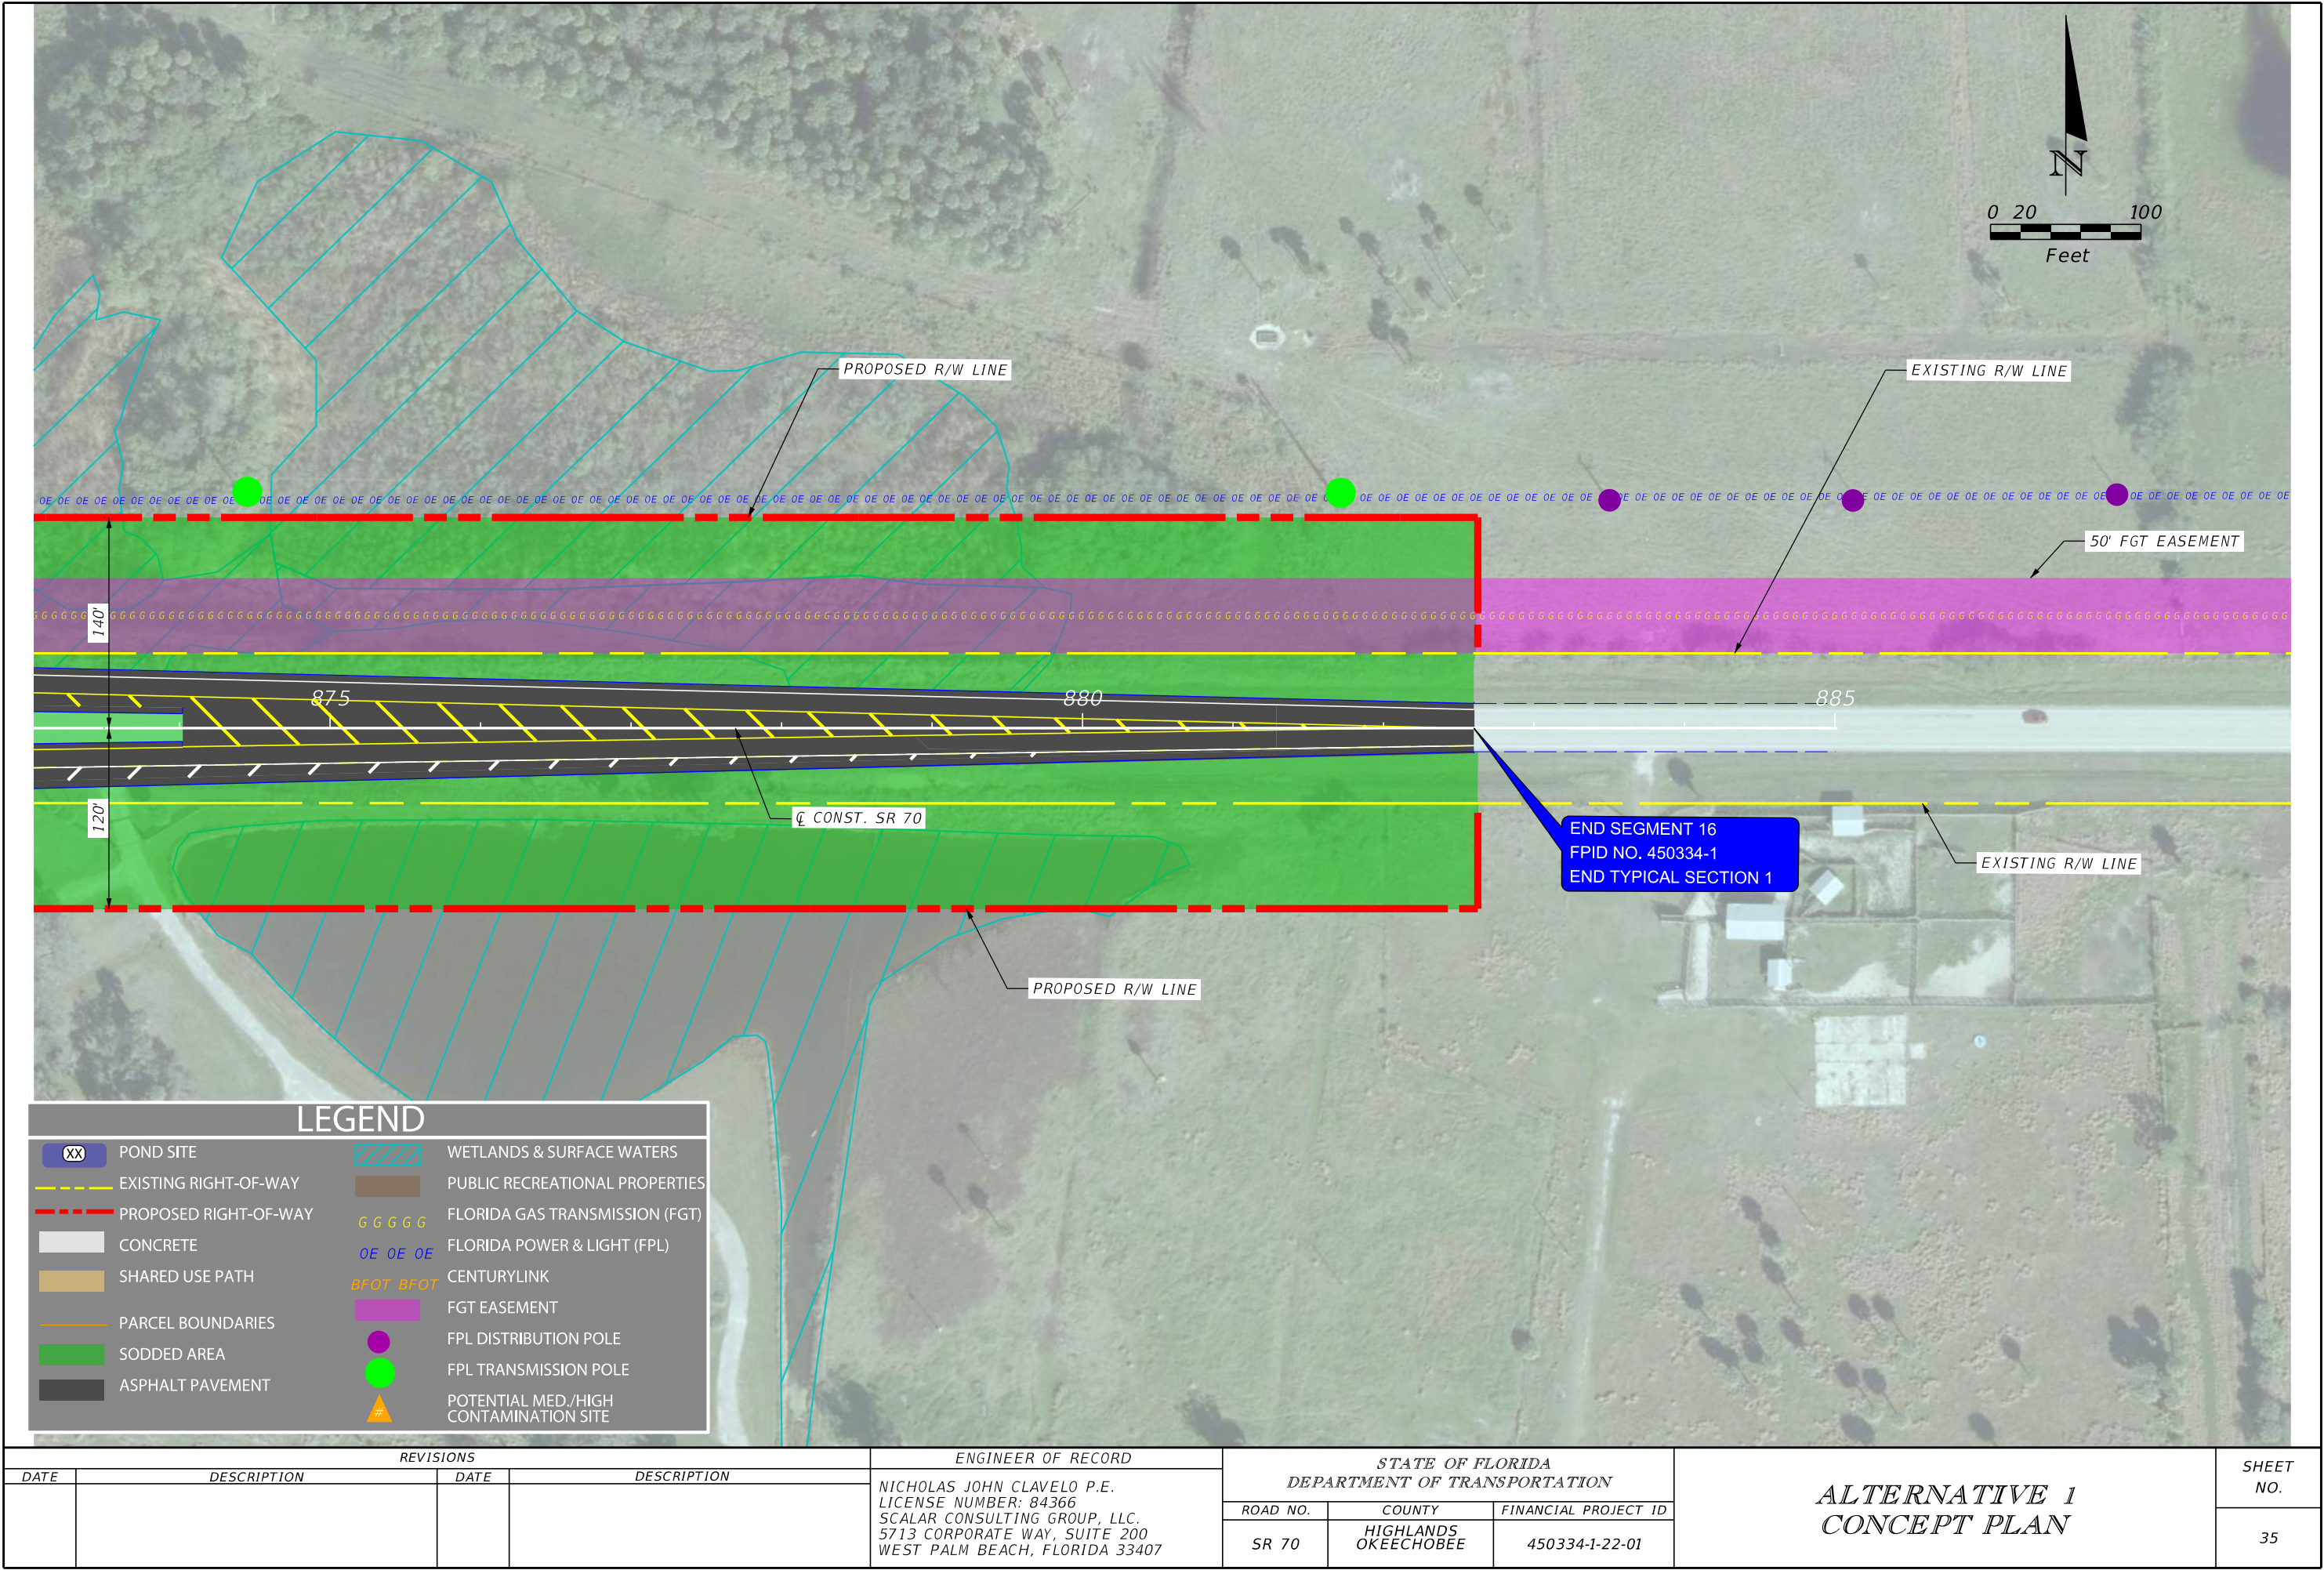

XX

POND SITE

EXISTING RIGHT-OF-WAY

PROPOSED RIGHT-OF-WAY

CONCRETE

SHARED USE PATH

PARCEL BOUNDARIES

SODDED AREA

ASPHALT PAVEMENT

WETLANDS & SURFACE WATERS

PUBLIC RECREATIONAL PROPERTIES

GGGGG

FLORIDA GAS TRANSMISSION (FGT)

OE OE OE

FLORIDA POWER & LIGHT (FPL)

BFOT BFOT

CENTURYLINK

FGT EASEMENT

FPL DISTRIBUTION POLE

FPL TRANSMISSION POLE

#

POTENTIAL MED./HIGH CONTAMINATION SITE

REVISIONS				ENGINEER OF RECORD			STATE OF FLORIDA DEPARTMENT OF TRANSPORTATION			SHEET NO. 35
DATE	DESCRIPTION	DATE	DESCRIPTION	NICHOLAS JOHN CLAVELLO P.E. LICENSE NUMBER: 84366 SCALAR CONSULTING GROUP, LLC. 5713 CORPORATE WAY, SUITE 200 WEST PALM BEACH, FLORIDA 33407			ROAD NO.	COUNTY	FINANCIAL PROJECT ID	
							SR 70	HIGHLANDS OKEECHOBEE	450334-1-22-01	

ALTERNATIVE 1
CONCEPT PLAN

THE OFFICIAL RECORD OF THIS SHEET IS THE ELECTRONIC FILE DIGITALLY SIGNED AND SEALED UNDER RULE 61G15-23.004, F.A.C.